

O.D.O.T. DISTRICT 2 SURVEY OFFICE

PERSONNEL _____

REFERENCE NO. 11 A

SHEET 18 OF 32

NOTES WESTFALL

DATE 06-04-13

ROUTE S.R. 64

H.C. ROUSOS

WEATHER CLEAR

COUNTY WOOD

R.C. RHOADES

TEMP. 63° F

TOWNSHIP MIDDLETON

SECTION 34

T 6 N R 10 E

TYPE MONUMENT _____ PK _____


ON SURFACE - ~~BELOW~~ _____ YES _____

LEFT - ~~C PAV'T~~ - ~~RIGHT~~ _____ 5.1' _____

4.6' TO LT. EDGE PAVEMENT

S.L.M. 370+81


Grid: Northing: 645,179.796 Easting: 1,640,290.050

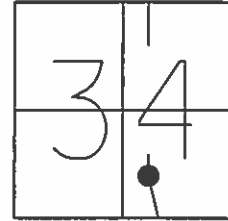

RECORD

PI 4+83.2

Δ = 07°-04' RT.

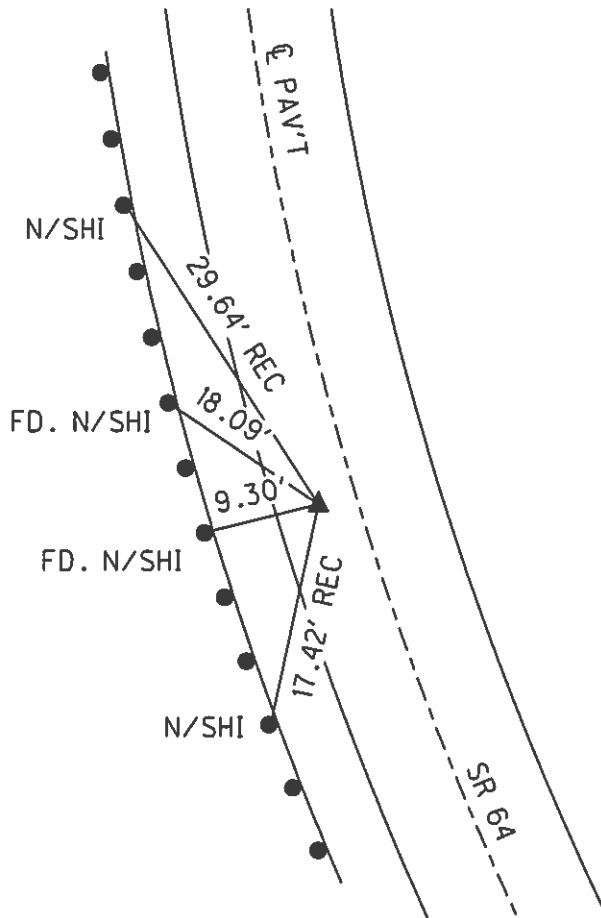

RECORD

08-25-97 BVD
FD. SM. RRSPK

12-01-97 SAH
SET PK/W

06-22-02 MC
FD. PK/W

04-23-12 SAH
FD. SHANK

09-25-13 EBW
SET MAG/W

PREVENTIVE MAINTENANCE
MICROSURFACED 2002
EXISTING POINT UNCOVERED
DATE 12-09-02

O.D.O.T. DISTRICT 2 SURVEY OFFICE

PERSONNEL

REFERENCE NO. 11-A

SHEET 14 OF 27

NOTES K. MOSER

H.C. B. VANDUSEN

R.G. K. MOSER

DATE 8-25-97

WEATHER PARTLY SUNNY

TEMP. +75°F

ROUTE S.R. 65

COUNTY WOOD

TOWNSHIP MIDDLETON

SECTION 34

T. 6 N R. 10 E


TYPE MONUMENT SMALL R.R. SPIKE

ON SURFACE - ~~BELOW~~ ON SURFACE

LEFT - ~~C PAV'T.~~ RIGHT S. 1 LT


4.6 TO LT. EDGE PAVEMENT

S.L.M. SLK = 11+314 370+81

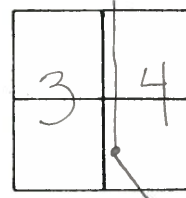

RECORD
P.I. 4+83.2
 $\Delta = 72.04' RT.$

SET PK/WASHER
12-01-97
SAH

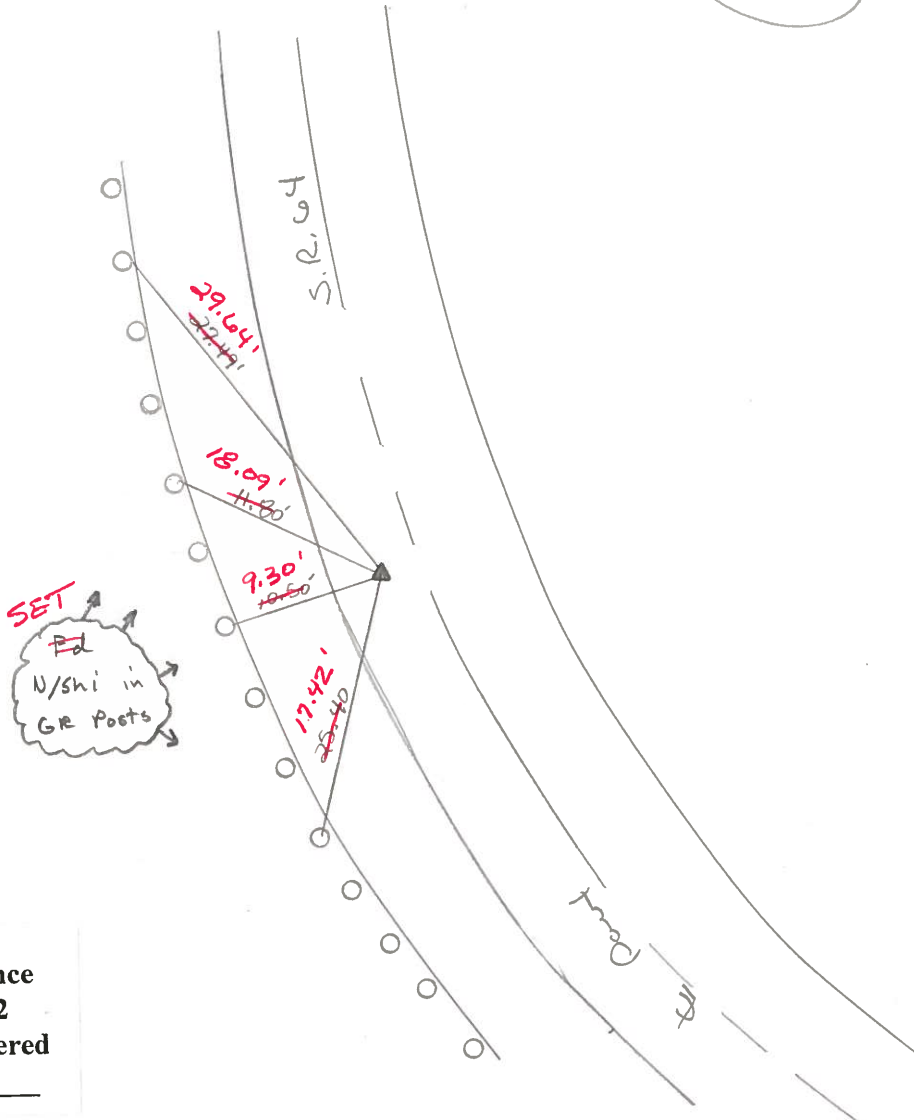

Fd PK/Washer
6-22-02
MC

Preventive Maintenance
Microsurfaced 2002
Existing Point Uncovered
Date 12-09-01

O.D.O.T. DISTRICT 2 SURVEY OFFICE

PERSONNEL

REFERENCE NO. 11-A

SHEET OF

NOTES Hoffman

H.C. Loehrk

DATE 4-20-88

ROUTE SR 64

R.C. Barnissel

WEATHER Windy - cloudy

COUNTY WOOD

Reed

TEMP. 52°

TOWNSHIP MIDDLETON

SECTION 34

T 6 N R 10 E

TYPE MONUMENT R.R. SPIKE


Set SMALL
RR SPIKE
6-8-88 SWK

ON SURFACE - BELOW YES


LEFT - 0 PAVT. - RIGHT 4.1

4.6 TO Lt. EDGE PAVEMENT

S.L.M. 370 +81

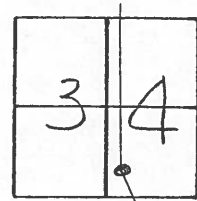

Record:
P.I. 4+83.2
 $\Delta = 7^{\circ}-04' RT.$

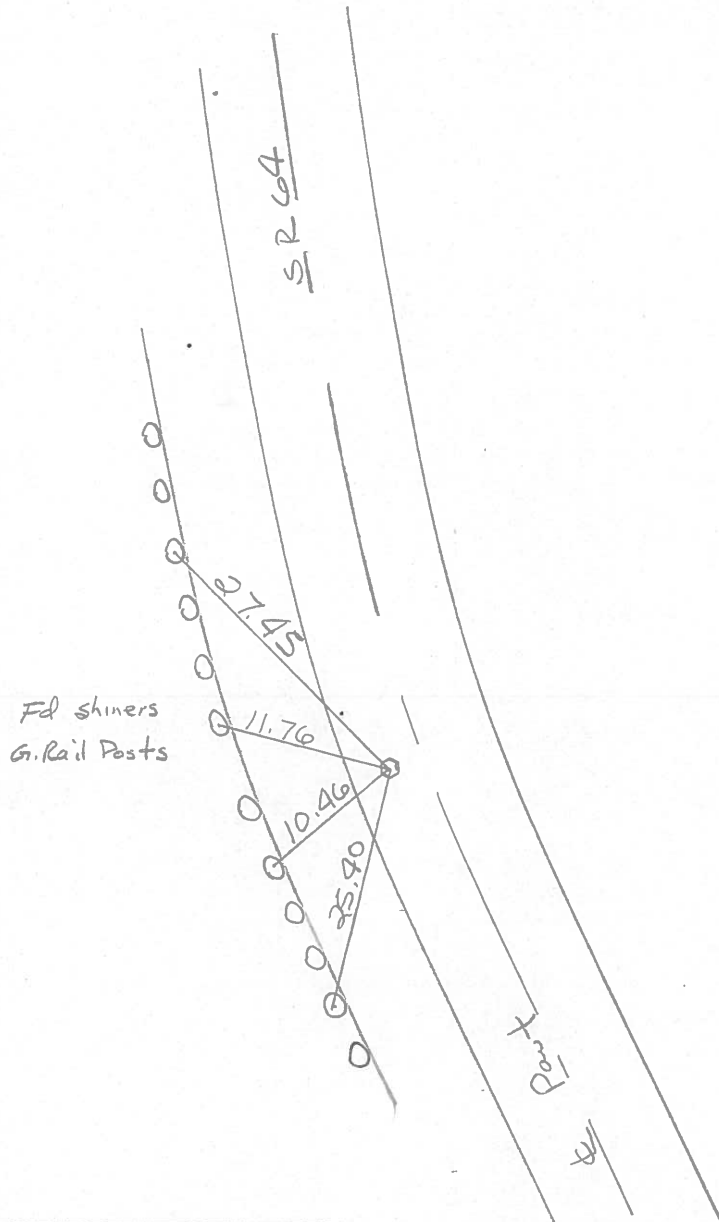

County Wood S.R. 64

Date 7-3-1979

Township Middleton

Weather Clear

Section 34

Temp. +70°


T6N, R10E

Personnel Smith

Knape

Bowers


Mead

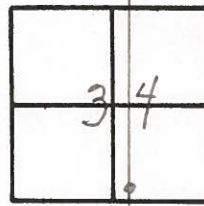

35A

11-A


P. I. Sta 4+83.2
 $\Delta = 7^{\circ}04'$ Rt.
Fd. R.R. Spike
@ Surface

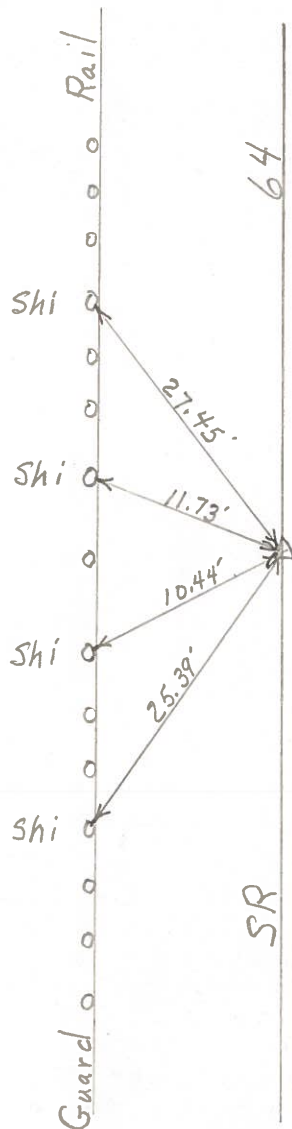

RE-COPIED
2-2-71

PERSONNEL	TITLE	PERSONNEL	TITLE	COUNTY	DATE
CK. BY				Wood	11-13-70
BURNSIDE				S. R. #64	WEATHER
SMITH				SEC.	TEMP.
Kijowski					

DESCRIPTION B.G. WATER LINE TIES JOB NO.

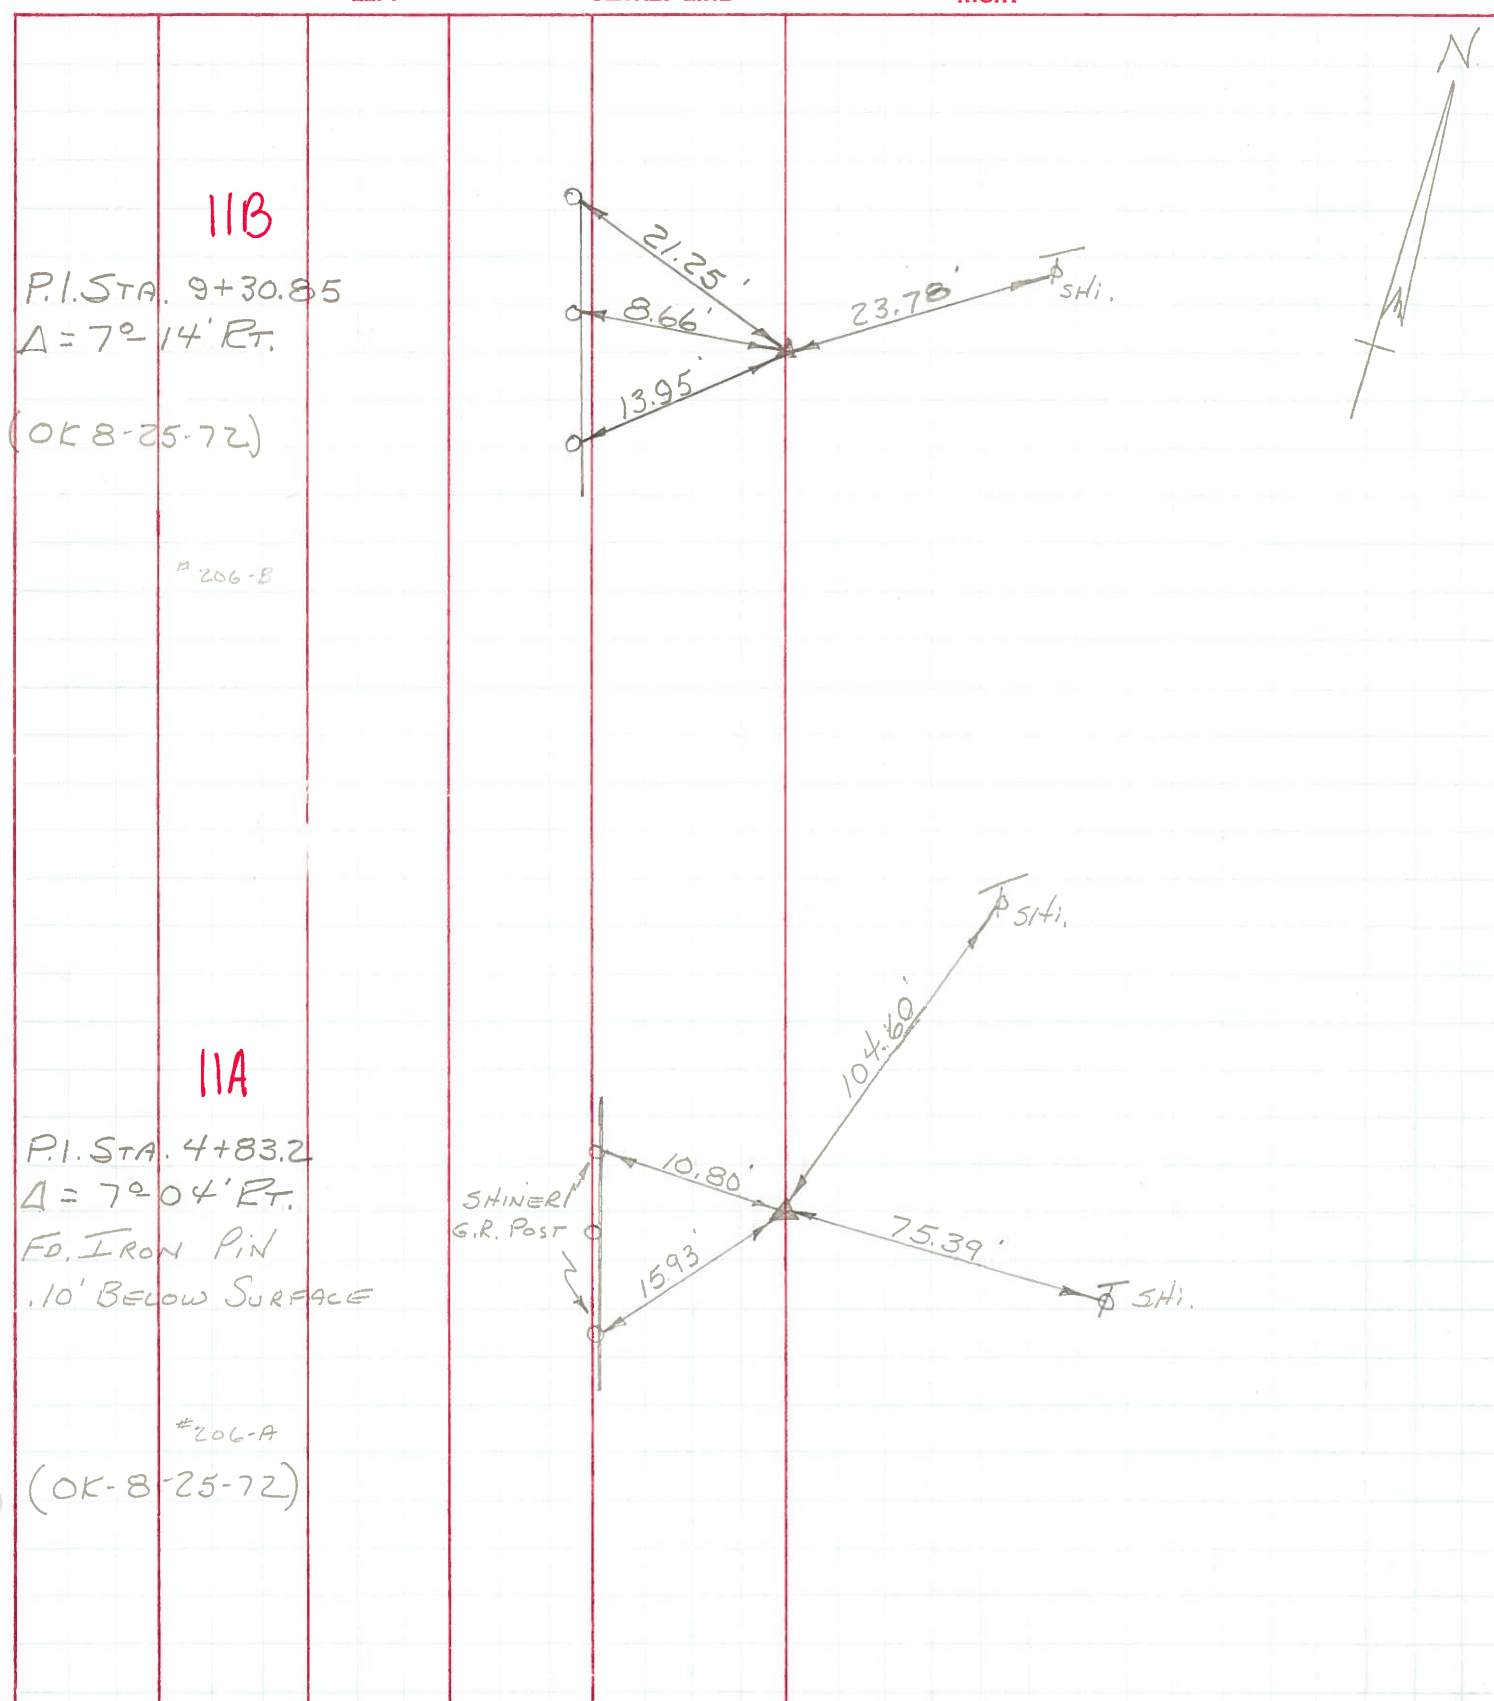

PERSONNEL	TITLE	PERSONNEL	TITLE	COUNTY	DATE	WEATHER	TEMP.
Burnside		Drury		Wood	1-10-66		
Smith				S. R. # 64			
Ketchum				SEC.			
Hoffman							

DESCRIPTION _____ LEFT _____ CENTER LINE _____ RIGHT _____ JOB NO. _____

