
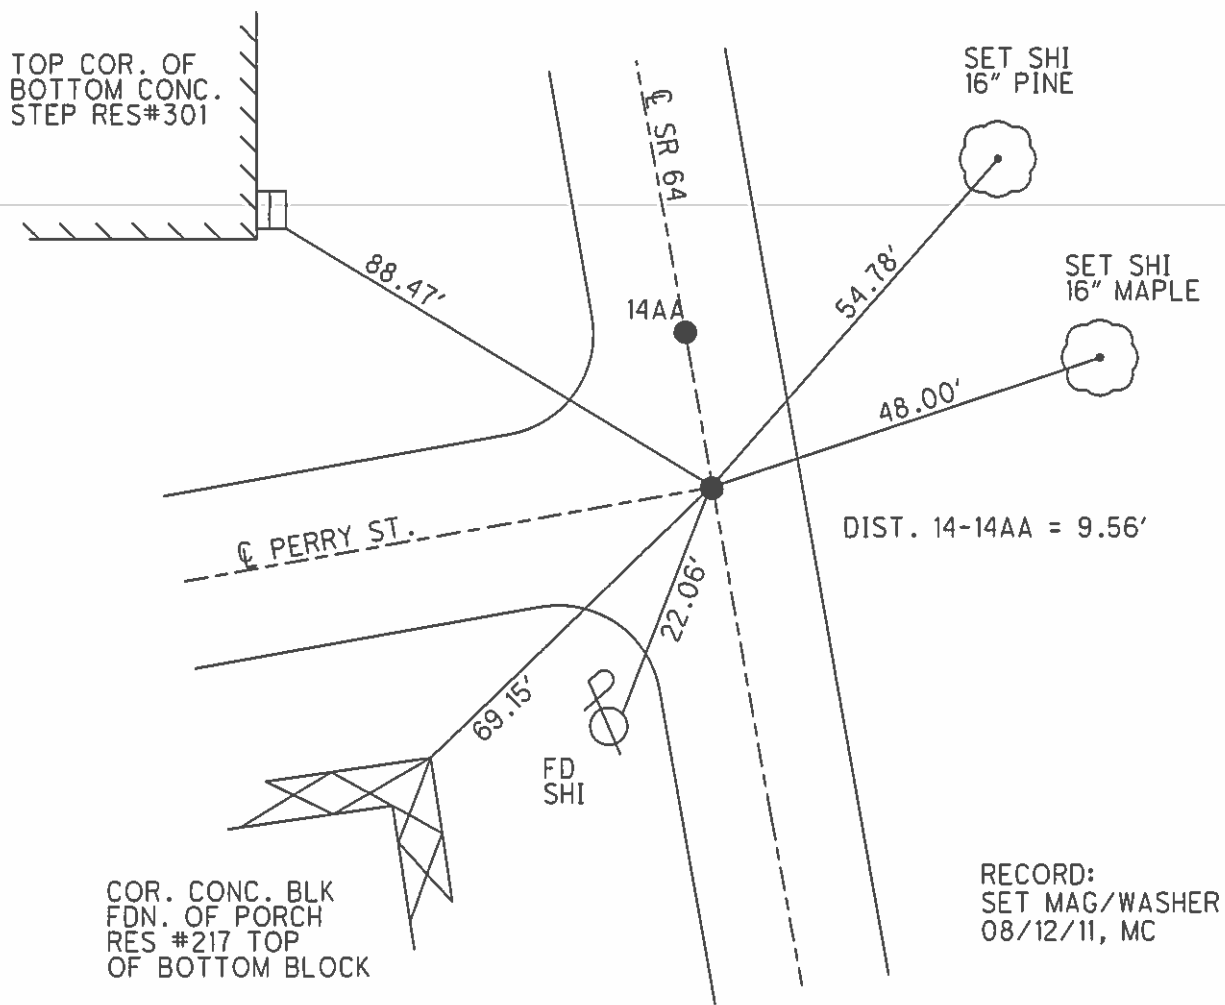


O.D.O.T. DISTRICT 2 SURVEY OFFICE (USE ONLY)

PERSONNEL _____ REFERENCE NO. 14 SHEET 7 OF 22

NOTES FINGER DATE 5-16-11 ROUTE SR 64
 H.C. HUSS WEATHER CLOUDY COUNTY WOOD
 R.C. CANTERBURY TEMP. 45° TOWNSHIP MIDDLETON
 _____ SECTION 22
 _____ T 6 N R 10 E

TYPE MONUMENT _____ P.K.SHANK
 ON SURFACE - ~~BELOW~~ ON _____
 LEFT - ☉ PAV'T - RIGHT _____ ON _____
14.5' TO RT. EDGE PAVEMENT
 S.L.M. _____ 506+96.03
 Grid: Northing: 658307.602 Easting: 1637993.743

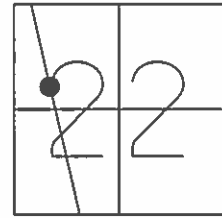

O.D.O.T. DISTRICT 2 SURVEY OFFICE

PERSONNEL

REFERENCE NO. 14

SHEET OF

NOTES BAENHISEL

H.C. HOFFMAN

R.C. Loehke

DATE 9-7 89

WEATHER cloudy

TEMP. +80°

ROUTE S.R. 64

COUNTY Wood

TOWNSHIP Middleton

SECTION 22

T 6 N R 10 E



TYPE MONUMENT P.K. NAIL PT "A" & PT "B"

ON SURFACE - ~~BELOW~~ yes (BOTH)

LEFT - & PAV'T. - RIGHT yes (BOTH)

14.7 TO RT EDGE PAVEMENT - CHEB (BOTH)

S.L.M. 507+04 (PT "A")

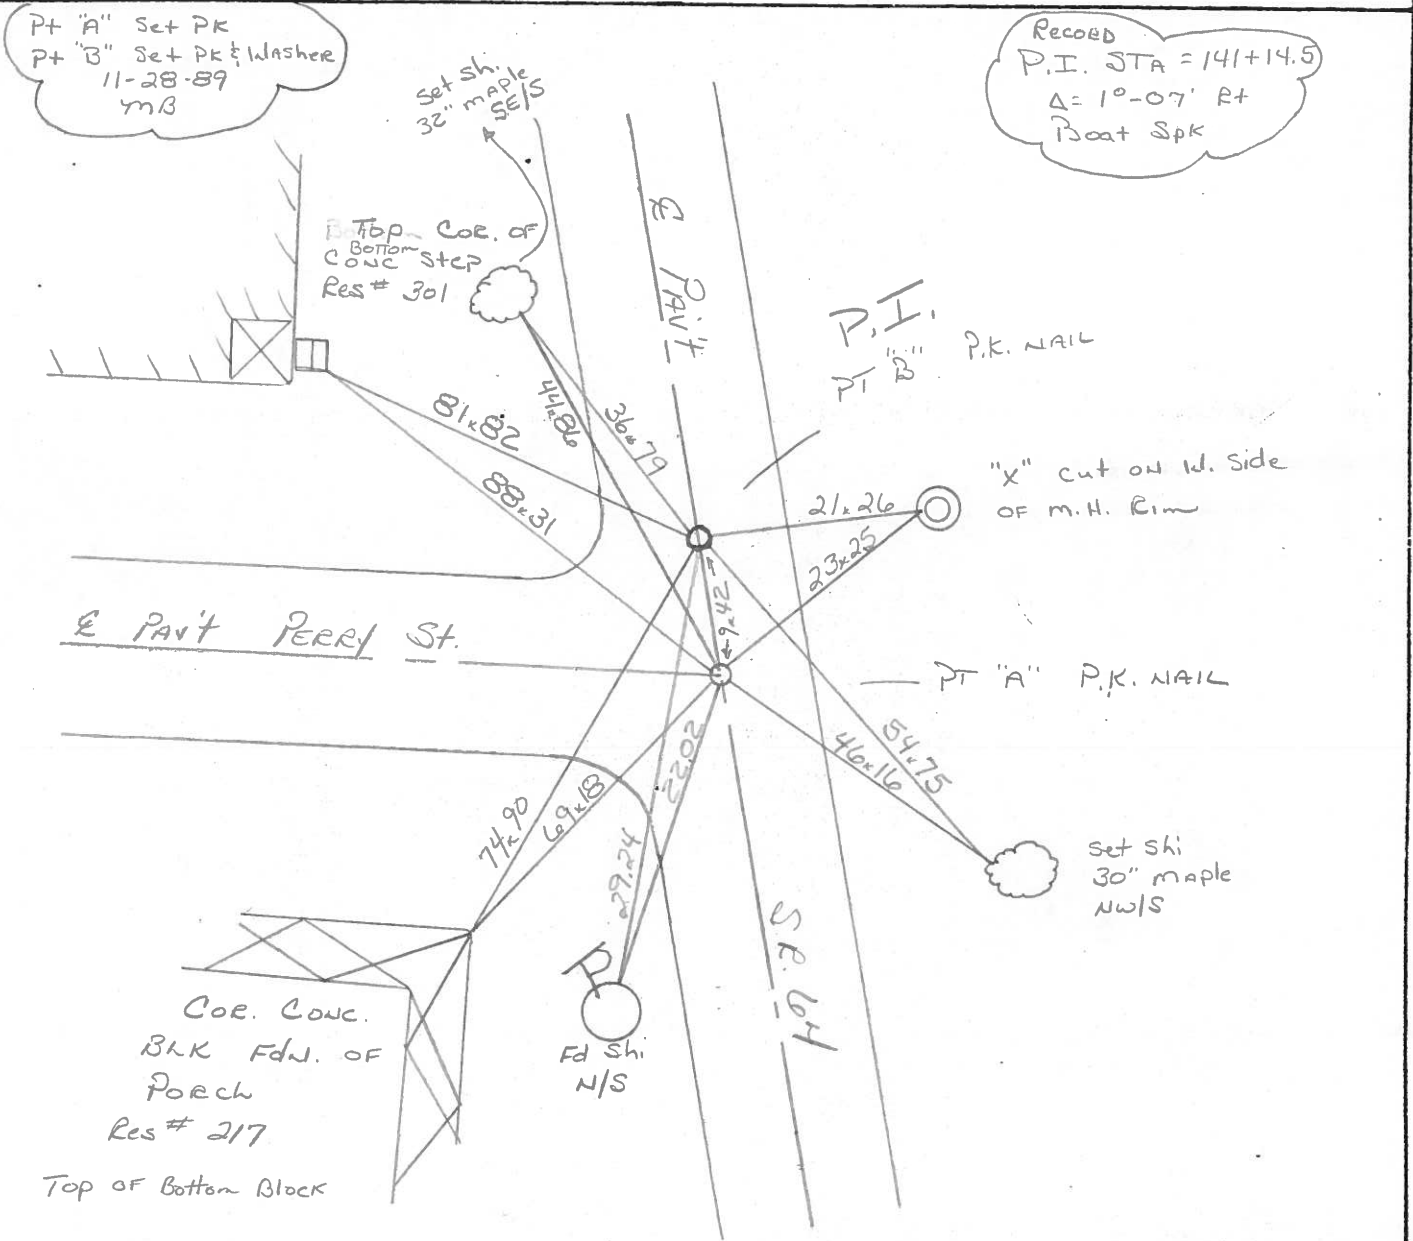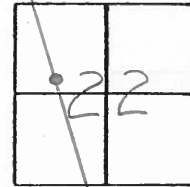

County WOOD S.R. 64

Date 7-17-79

Township MIDDLETON

Weather CLEAR

Section 22

Temp. +74°


T6N, R1E

Personnel BURNSIDE

BOWERS


KNAPE

MEAD

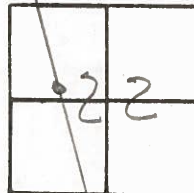

14

64

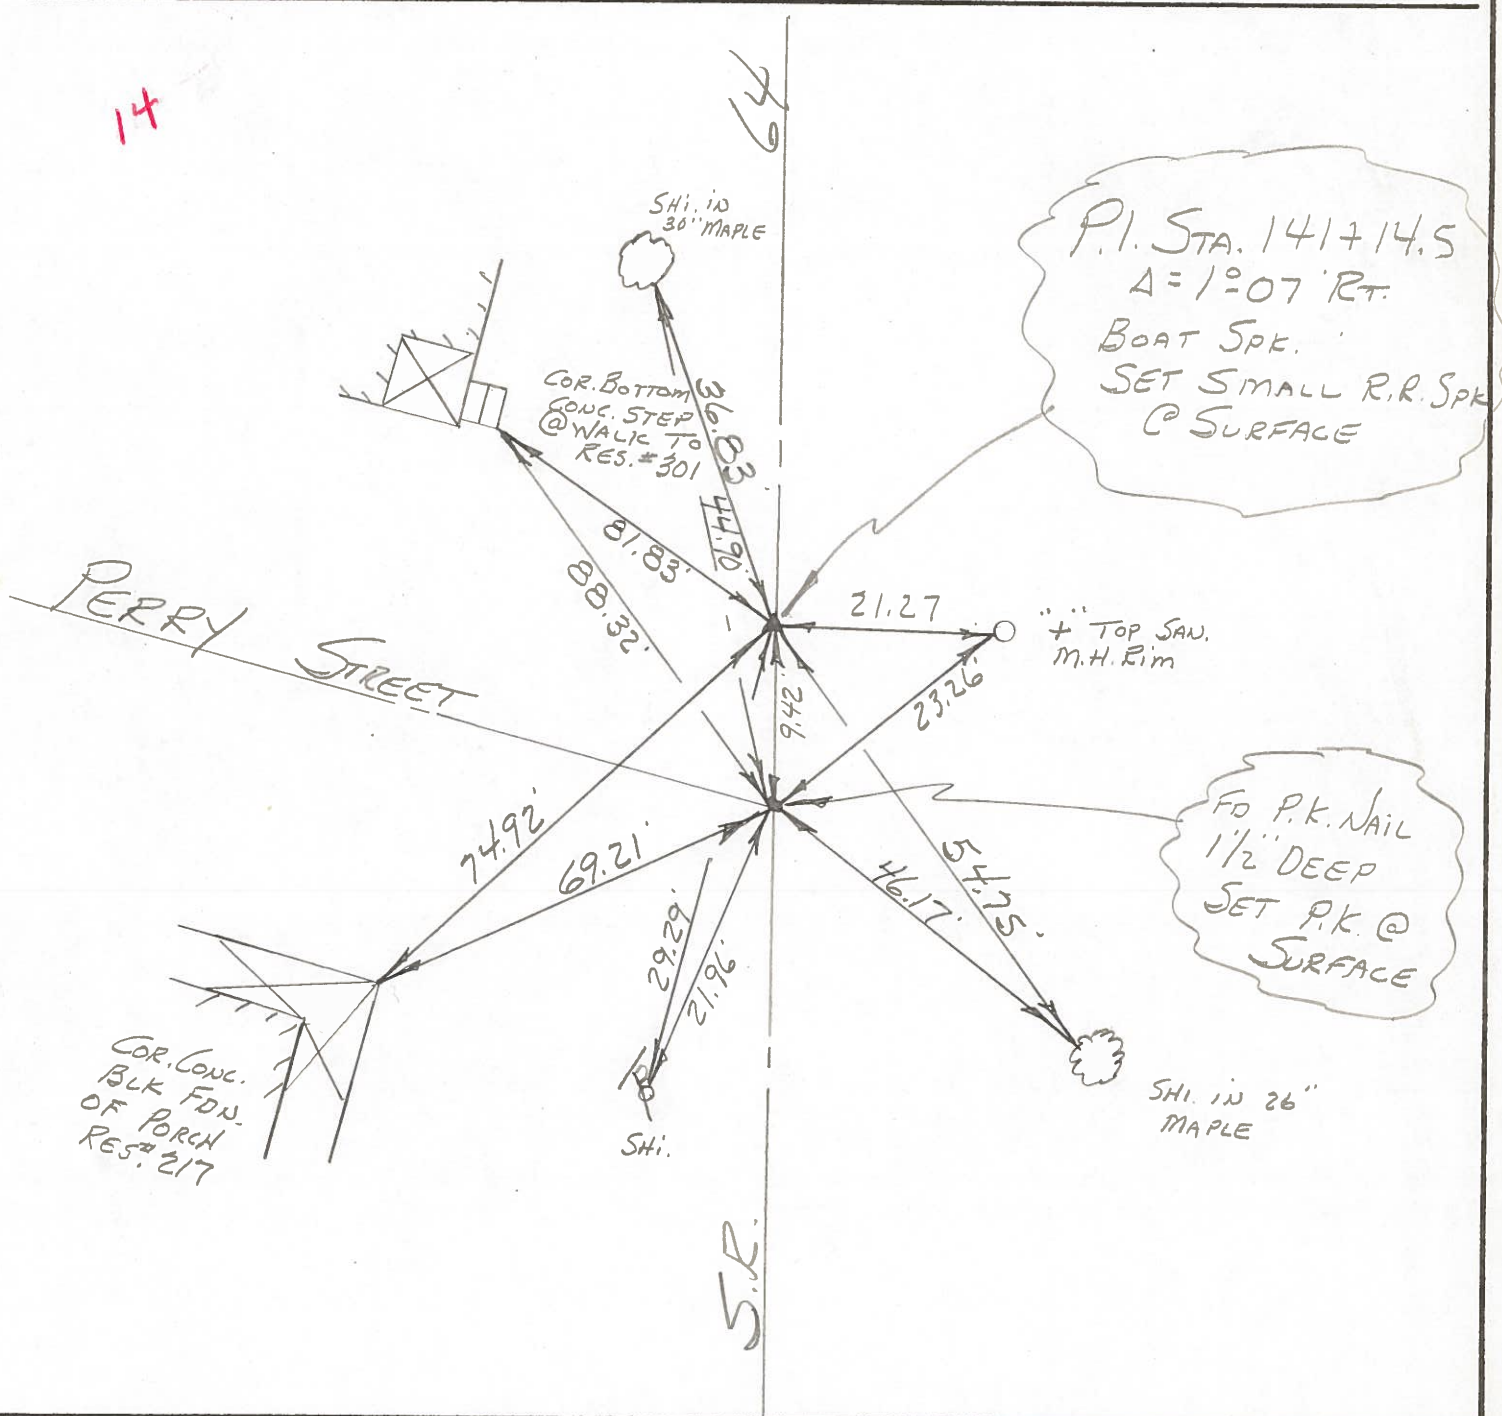

PERSONNEL	TITLE	PERSONNEL	TITLE	COUNTY	DATE	WEATHER	TEMP.
BURNSIDE		ROCCINI		WOOD	6-15-71	CLEAR	+72°
SMITH				S. R. 64			
BOWERS				SEC. HASKINS			
HOLCOMBE							

DESCRIPTION _____ LEFT _____ CENTER LINE _____ RIGHT _____ JOB NO. _____

