


O.D.O.T. DISTRICT 2 SURVEY OFFICE (USE ONLY)

PERSONNEL _____ REFERENCE NO. 15 G SHEET 22 OF 22


NOTES FINGER _____ DATE 5/17/11 ROUTE SR 64
 H.C. HUSS WEATHER CLOUDY COUNTY WOOD
 R.C. CANTERBURY TEMP. 49° TOWNSHIP MIDDLETON
 _____ SECTION 33
 _____ T 6 N R 10 E

TYPE MONUMENT _____ P.K./WASHER _____
 ON SURFACE - ~~BELOW~~ ON _____
 LEFT - \odot PAV'T - ~~RIGHT~~ 0.9' _____
 _____ TO _____ EDGE PAVEMENT
 S.L.M. 573+34.63

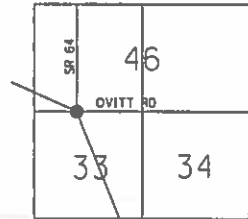

Grid: Northing: 659273.909 Easting: 1637757.785

RECORD:
 SET PK/WASHER
 11-30-89, MB
 FD PK/WASHER
 GPS, SV24
 4-8-10, SAH
 SET MAG/WASHER
 7/29/11, MC

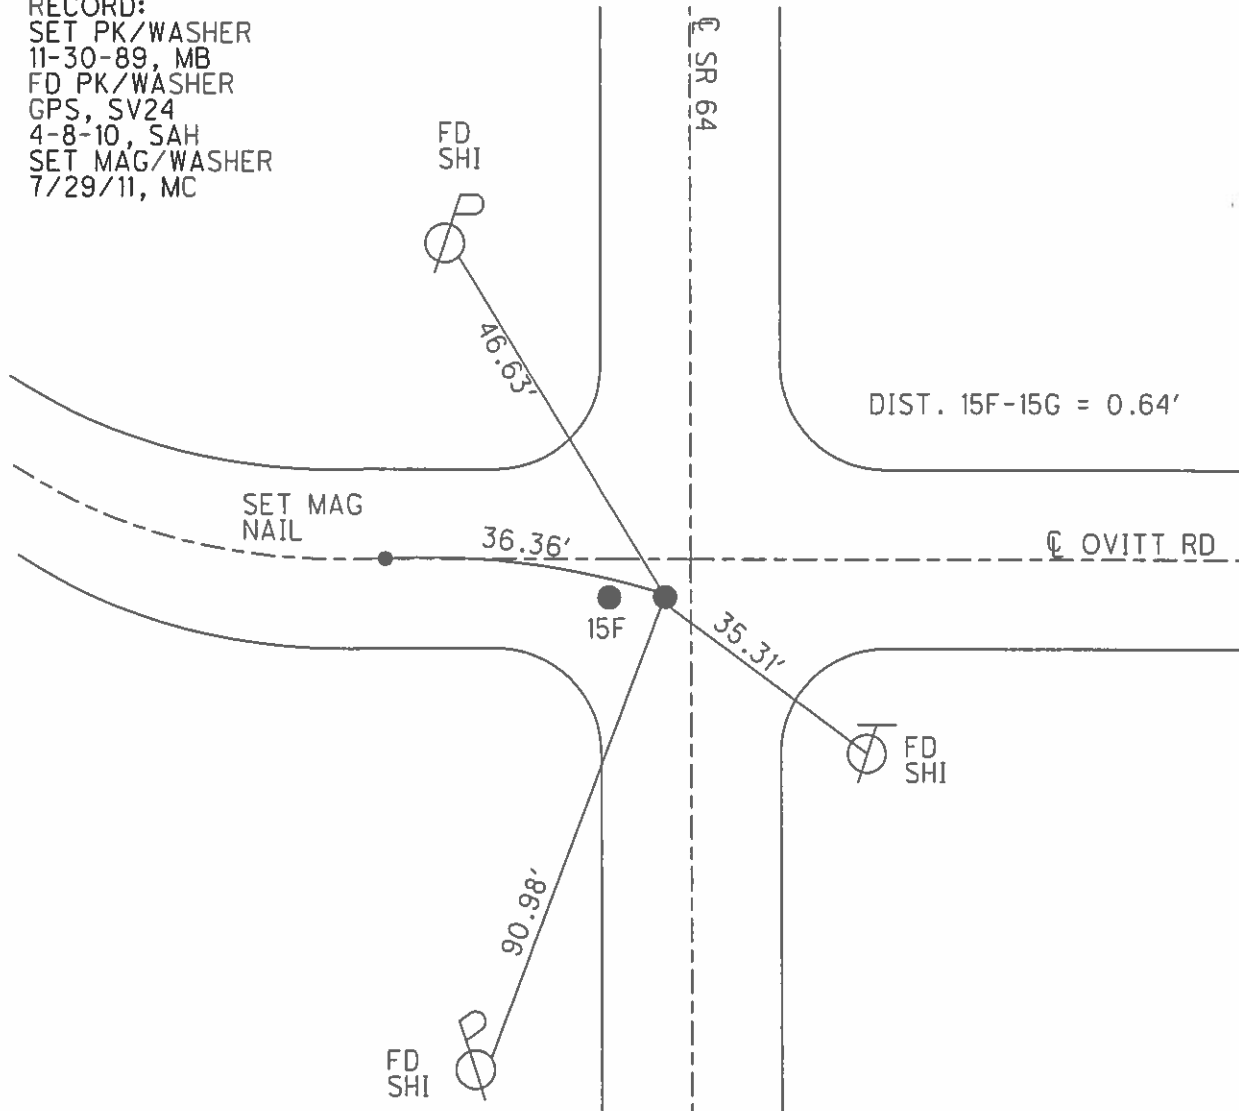


O.D.O.T. DISTRICT 2 SURVEY OFFICE (USE ONLY)

PERSONNEL _____ REFERENCE NO. 15 G SHEET 22 OF 22

NOTES FINGER _____ DATE 5-17-11 ROUTE SR 64
 H.C. HUSS WEATHER CLOUDY COUNTY WOOD
 R.C. CANTERBURY TEMP. 49° TOWNSHIP MIDDLETON
 _____ SECTION 33
 _____ T 6 N R 10 E

TYPE MONUMENT _____ P.K./WASHER _____
 ON SURFACE - ~~BELOW~~ ON _____
 LEFT - ☉ PAV'T - ~~RIGHT~~ 0.9' _____
 - TO - EDGE PAVEMENT _____
 S.L.M. 573+34.63 _____
 Grid: Northing: 1637757.785 Easting: 1637757.785

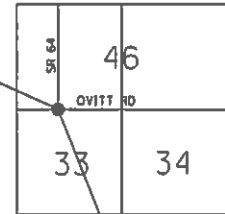

RECORD:
 SET PK/WASHER
 11-30-89, MB
 FD PK/WASHER
 GPS, SV24
 4-8-10, SAH
 SET MAG/WASHER
 7/29/11, MC

