



O.D.O.T. DISTRICT 2 SURVEY OFFICE (USE ONLY)

PERSONNEL _____ REFERENCE NO. 16 A SHEET 2 OF 5
 NOTES BURNSIDE DATE 7/20/79 ROUTE SR 64
 H.C. BOWERS WEATHER CLEAR COUNTY WOOD
 R.C. KNAPE TEMP. 78° TOWNSHIP MIDDLETON
 _____ MEAD SECTION RT 48
 DWG BY RHOADES PID 87671 T 6 N R 10 E

TYPE MONUMENT BOAT SPIKE
 ON SURFACE - ~~BELOW~~ ON
 OFFSET \varnothing PAVEMENT - _____ RT
3 1/2' TO RT EDGE PAVEMENT
 STATION: 608+15.80

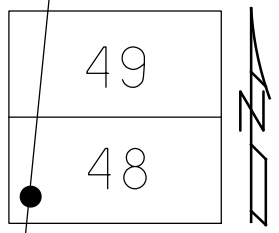

HORIZ.DATUM: NAD 83 2007 GEOID: _____
 GRID: NORTHING: 667882.787 EASTING: 1636882.391

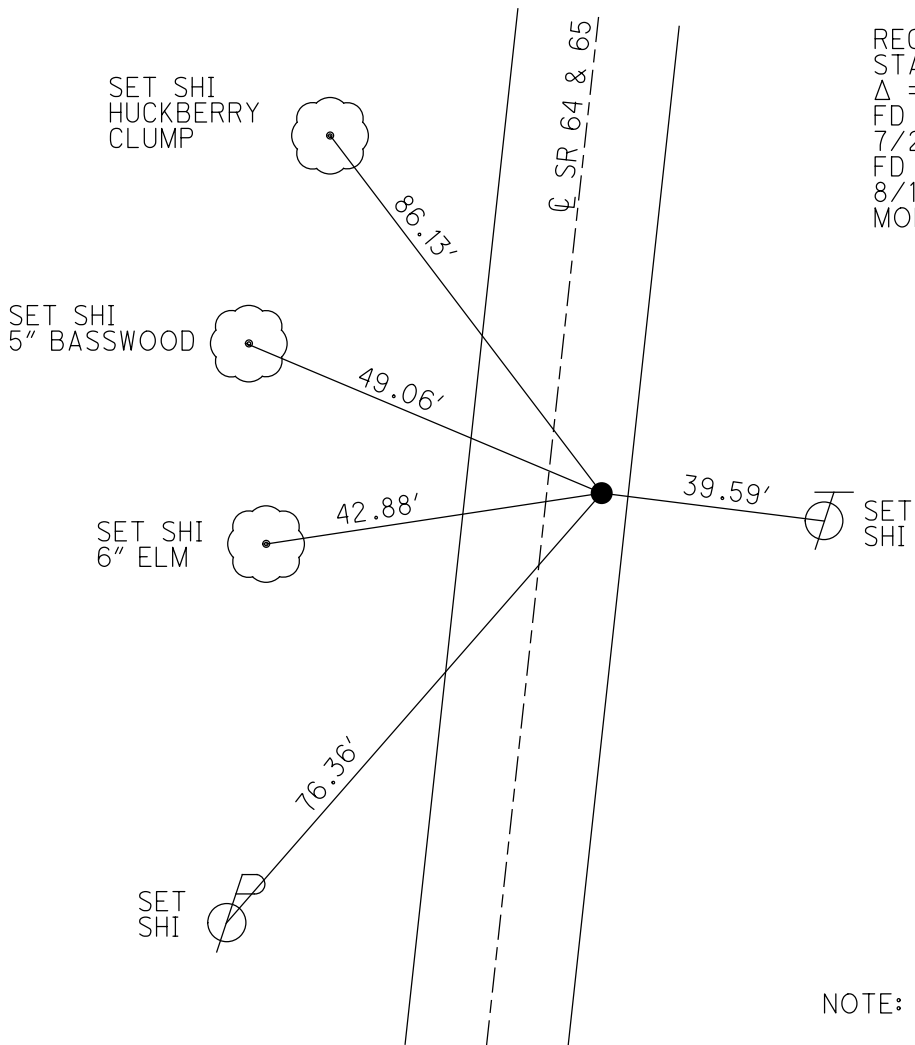

RECORD: P.I.
 STA. 608+15.85
 $\Delta = 13^\circ 33' \text{ LT}$
 FD BOAT SPIKE
 7/20/79, BURNSIDE
 FD NAIL
 8/13/14, RJL
 MONBOX SET

NOTE: SR 65 REF 20G

County WOOD S.R. 64E65

Date 7-20-79

Township MIDDLETON

Weather CLEAR

Section RIVER TRACT #48

Temp. +82°


T6N, R10E

Personnel BURNSIDE

BOWERS

KNAPE

MEAD

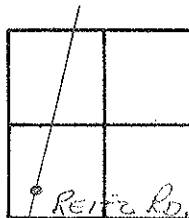

16-A

64E65



SHI. IN
Hex Leaf /
CLUMP

86.13'



SHI. IN
S BASSWOOD

49.06'


P.I. STA. 608+15.85

$\Delta = 13^{\circ}33' LT.$

FD. BOAT SPK. @

SURFACE $\frac{3}{4}$

WEST OF EAST
EDGE PAVE.

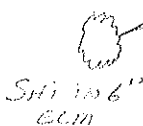

SHI. IN 6"
CLUM

42.88'

75.36'



SHI.

39.59'



SHI.

S.R.