

O.D.O.T. DISTRICT 2 SURVEY OFFICE (USE ONLY)

PERSONNEL

REFERENCE NO. 16 B

SHEET 3 OF 5

NOTES BURNSIDE

DATE 7/20/79

ROUTE SR 64

H.C. BOWERS

WEATHER CLEAR

COUNTY WOOD

R.C. KNAPE

TEMP. 80°

TOWNSHIP MIDDLETON

MEAD

DWG BY RHOADES

PID 87671

SECTION RT 48

T 6 N R 10 E

TYPE MONUMENT BOAT SPIKE

ON SURFACE - ~~BELOW~~ ON

OFFSET ☉ PAVEMENT 4 1/2' LT : ~~RT~~

- TO - EDGE PAVEMENT


STATION: 612+80.46

HORIZ.DATUM: NAD 83 2007


GEOID: \_\_\_\_\_

GRID: NORTHING: 668340.827

EASTING: 1636960.612

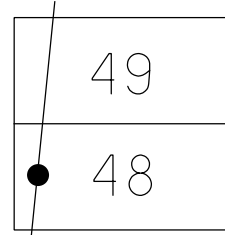

RECORD: P.I.  
 STA. 612+80.6  
 $\Delta = 0^\circ 55' RT$   
 FD BOAT SPIKE  
 7/20/79, BURNSIDE  
 FD P.K.NAIL  
 8/13/14, RJL  
 MONBOX SET

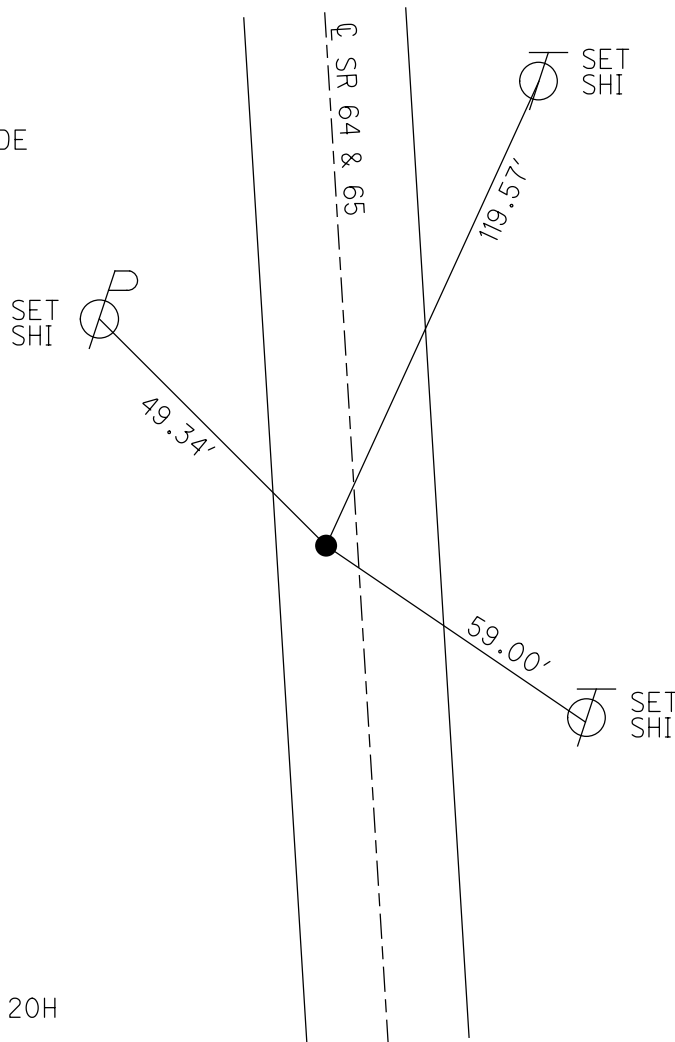

NOTE: SR 65 REF 20H

County WOOD S.R. 64 & 65

Date 7-20-79

Township MIDDLETON

Weather CLEAR

Section RIVER TRACT

Temp. +82°


T6N, R0E

Personnel BURNSIDE


BOWERS

KNAPP

MEAD

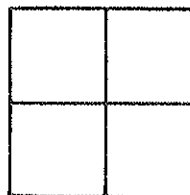

16-3

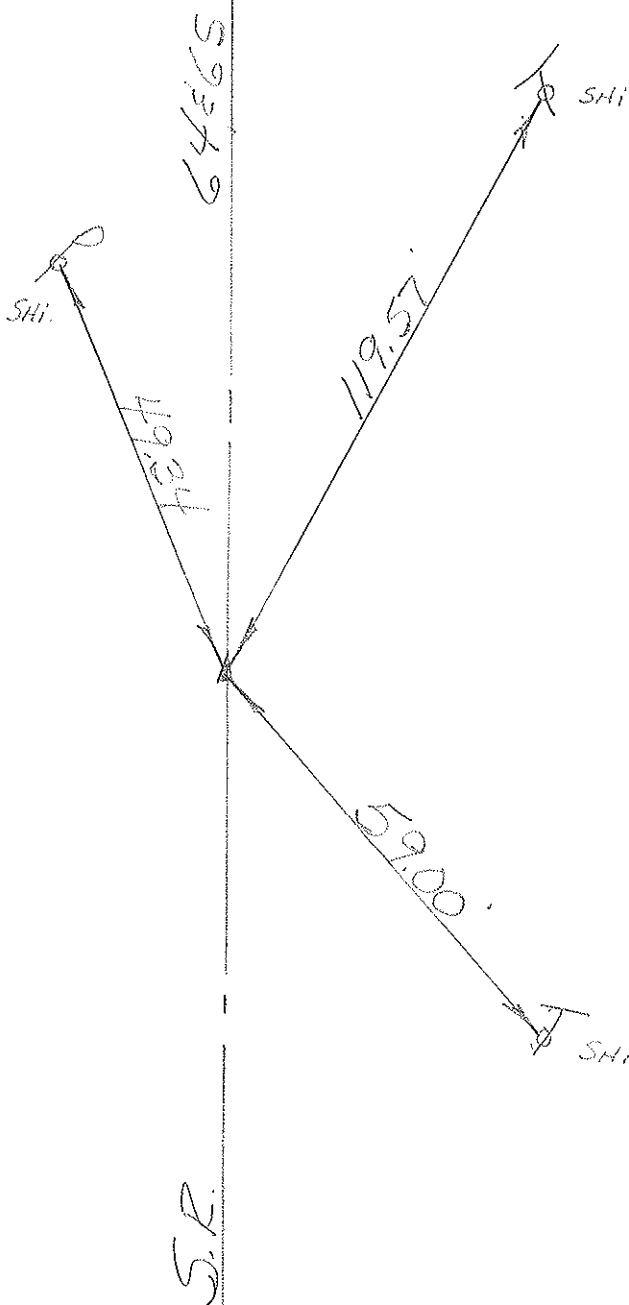

P.I. = 612 + 80.6  
 $\Delta = 0^\circ - 55'$  RT.  
 FD. BOAT SPK @  
 SURFACE  $\pm 4\frac{1}{2}'$  LT.  
 OF CTR. PAVE.