

O.D.O.T. DISTRICT 2 SURVEY OFFICE (USE ONLY)

PERSONNEL

REFERENCE NO. 16 C

SHEET 4 OF 5

NOTES BURNSIDE

DATE 7/20/79

ROUTE SR 64

H.C. BOWERS

WEATHER CLEAR

COUNTY WOOD

R.C. KNAPE

TEMP. 83°

TOWNSHIP MIDDLETON

MEAD

SECTION RT 49

DWG BY RHOADES

PID 87671

T 6 N R 10 E

TYPE MONUMENT P.K.NAIL

ON SURFACE - ~~BELOW~~ ON

OFFSET ☉ PAVEMENT 3 1/2' ~~LT~~ : RT

- TO - EDGE PAVEMENT


STATION: 624+87.76

HORZ.DATUM: NAD 83 2007


GEOID: _____

GRID: NORTHING: 669529.423

EASTING: 1637171.875

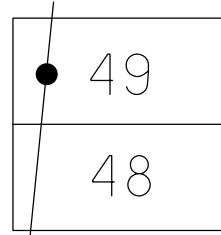

RECORD: P.I.
 STA.624+88.25
 $\Delta = 5^{\circ} 03' LT$
 FD P.K.NAIL
 7/20/79, BURNSIDE
 FD P.K.NAIL
 8/13/14, RJL

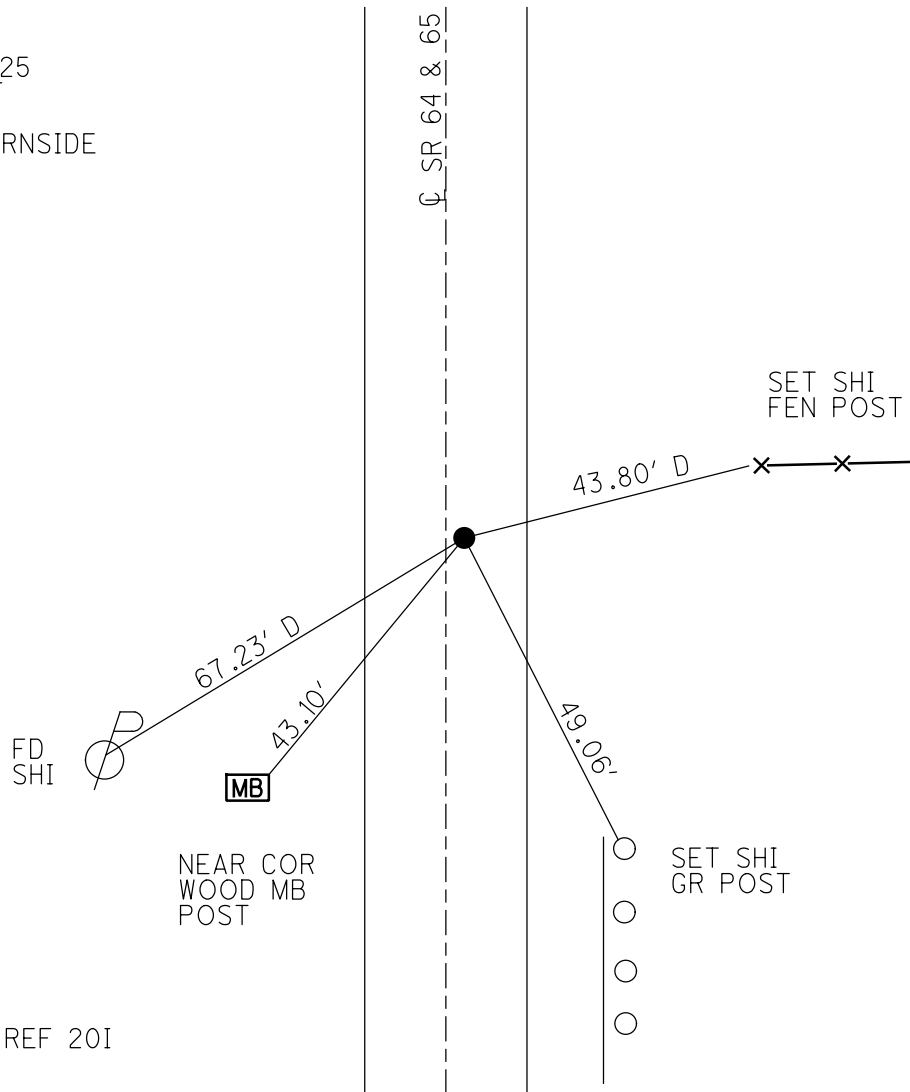

NOTE: SR 65 REF 20I

County WOOD S.R. 64865

Date 7-20-79

Township MIDDLETON


Weather CLEAR

Section RIVER TRACT

Temp. +83°

T6N, R10E


Personnel BURNSIDE
POWERS
KNAPP
MEAD

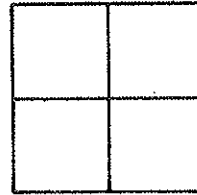

END POINT CHECK

16'-0

P.I. STA. 624+8825
 $\Delta = 5^{\circ}03' \text{LT.}$
F.D. P.K. NAIL @ SURFACE
E 3/4' EAST OF GR.
PAVE.

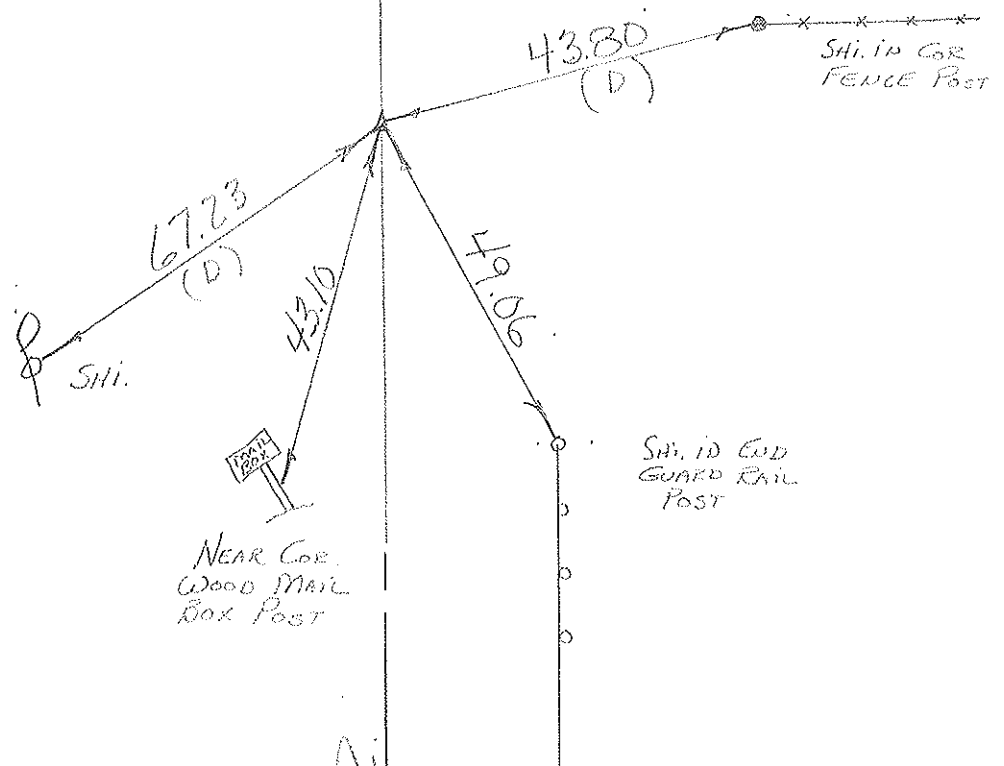

S.R.