


R.T. 68, 69, T3, U.S.R. PERRYSBURG TWP

FHWA REGION	STATE	PROJECT	19
5	OHIO		20


Woo 65-1950  
JOB NUMBER 029430  
RIGHT OF WAY PLAN

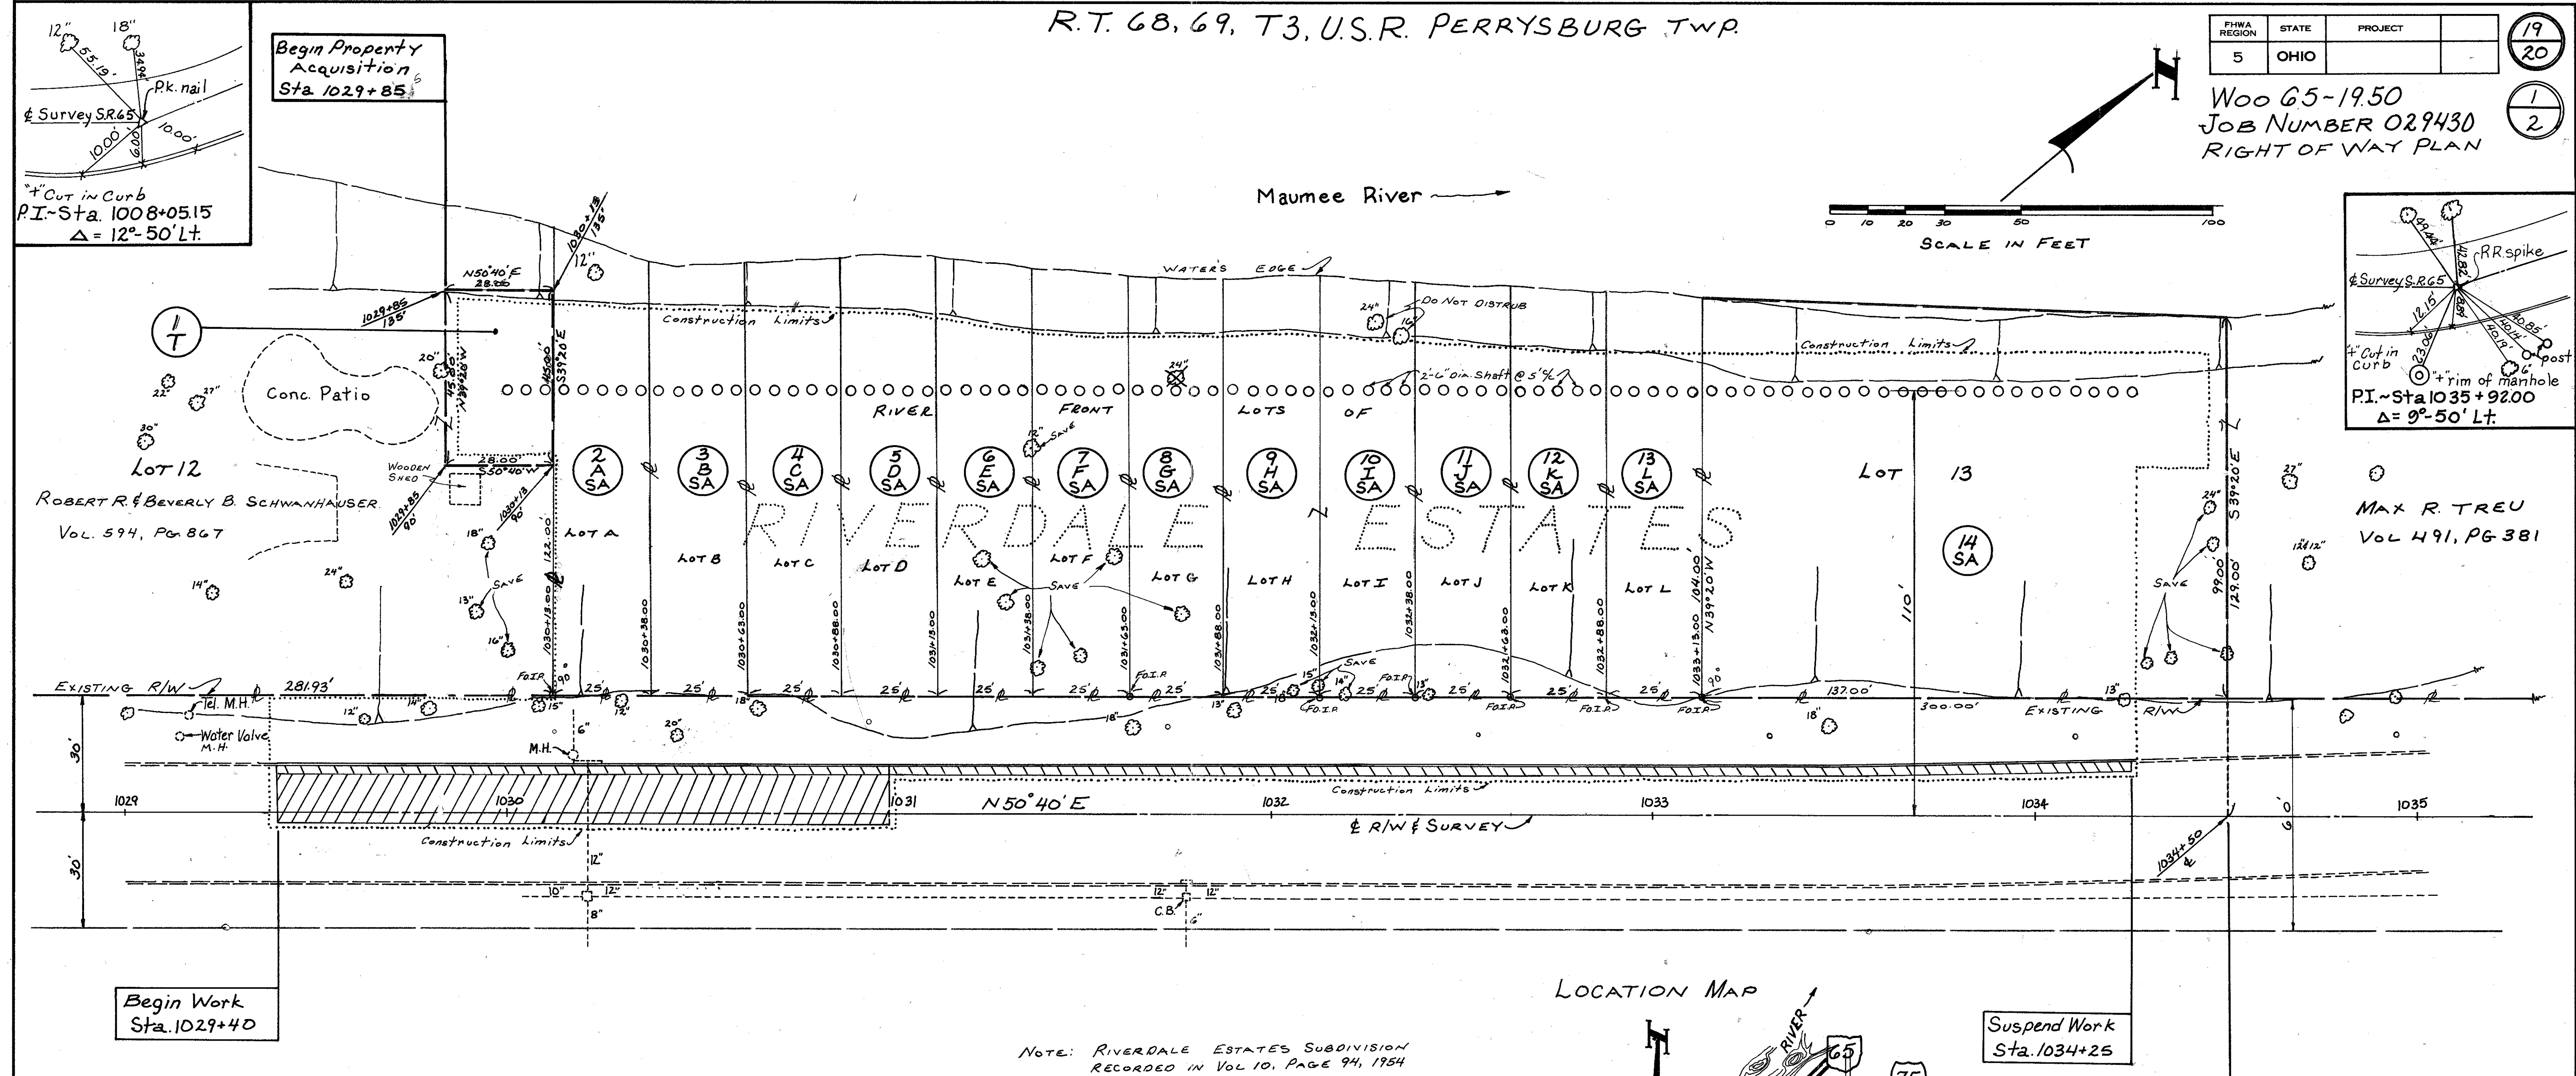

RIGHT OF WAY SUMMARY


PAR. NO.	OWNER	DEED RECORD		TOTAL PRO. AREA SQ. FT.	TOTAL TAKE SQ. FT.	PRO. IN TAKE SQ. FT.	NET TAKE SQ. FT.	RESIDUE SQ. FT.	REMARKS	AS ACQUIRED	
		VOL.	PAGE							VOL.	PAGE
1T	ROBERT R & BEVERLY B. SCHWANHAUSER	594	867	46,375	0	1,260	0	1,260	45,115		
2ASA	VIRGINIA M. NOLLENBERGER	393	347	2,925	0	2,925	2,925	2,925		617	315
3BSA	JAMES H. & CAROLYN W. McFARLAND	613	966	2,800	0	2,800	2,800	2,800		618	548
4CSA	WILLIAM L. & BARBARA A. AGOSTINI	603	825	2,825	0	2,825	2,825	2,825		617	647
5DSA	FRANK R. & JANE S. TAYLOR	607	718	2,850	0	2,850	2,850	2,850		616	802
6ESA	VERNON A. & DELORES S. WINGOLD	346	285	2,812	0	2,812	2,812	2,812		616	804
7FSA	DOROTHY W. DAM SCHROEDER	430	667	2,750	0	2,750	2,750	2,750		616	806
8GSA	BARBARA J. KOSMIDER	433	263	2,725	0	2,725	2,725	2,725		616	808
9HSA	DOROTHY R. FINKBEINER	360	42	2,725	0	2,725	2,725	2,725		617	311
10ISA	JOHN B. & LINDA L. ANDERSON JR.	615	1020	2,712	0	2,712	2,712	2,712		617	313
11JSA	A. STEPHEN MARTINDALE	542	62	2,687	0	2,687	2,687	2,687		617	651
12KSA	KATHRYN M. & FRANCIS M. CROOK	600	614	2,662	0	2,662	2,662	2,662		618	694
13LSA	A. STEPHEN MARTINDALE	542	62	2,625	0	2,625	2,625	2,625			
14-SA	MAX R. TREU	491	381	40,200	0	13,910	0	13,910	40,200		
15T	ELEANOR ROOSE	241	347		0	8,150	0	8,150			

\* NOTE: AREAS CALCULATED BY SCALING DISTANCES

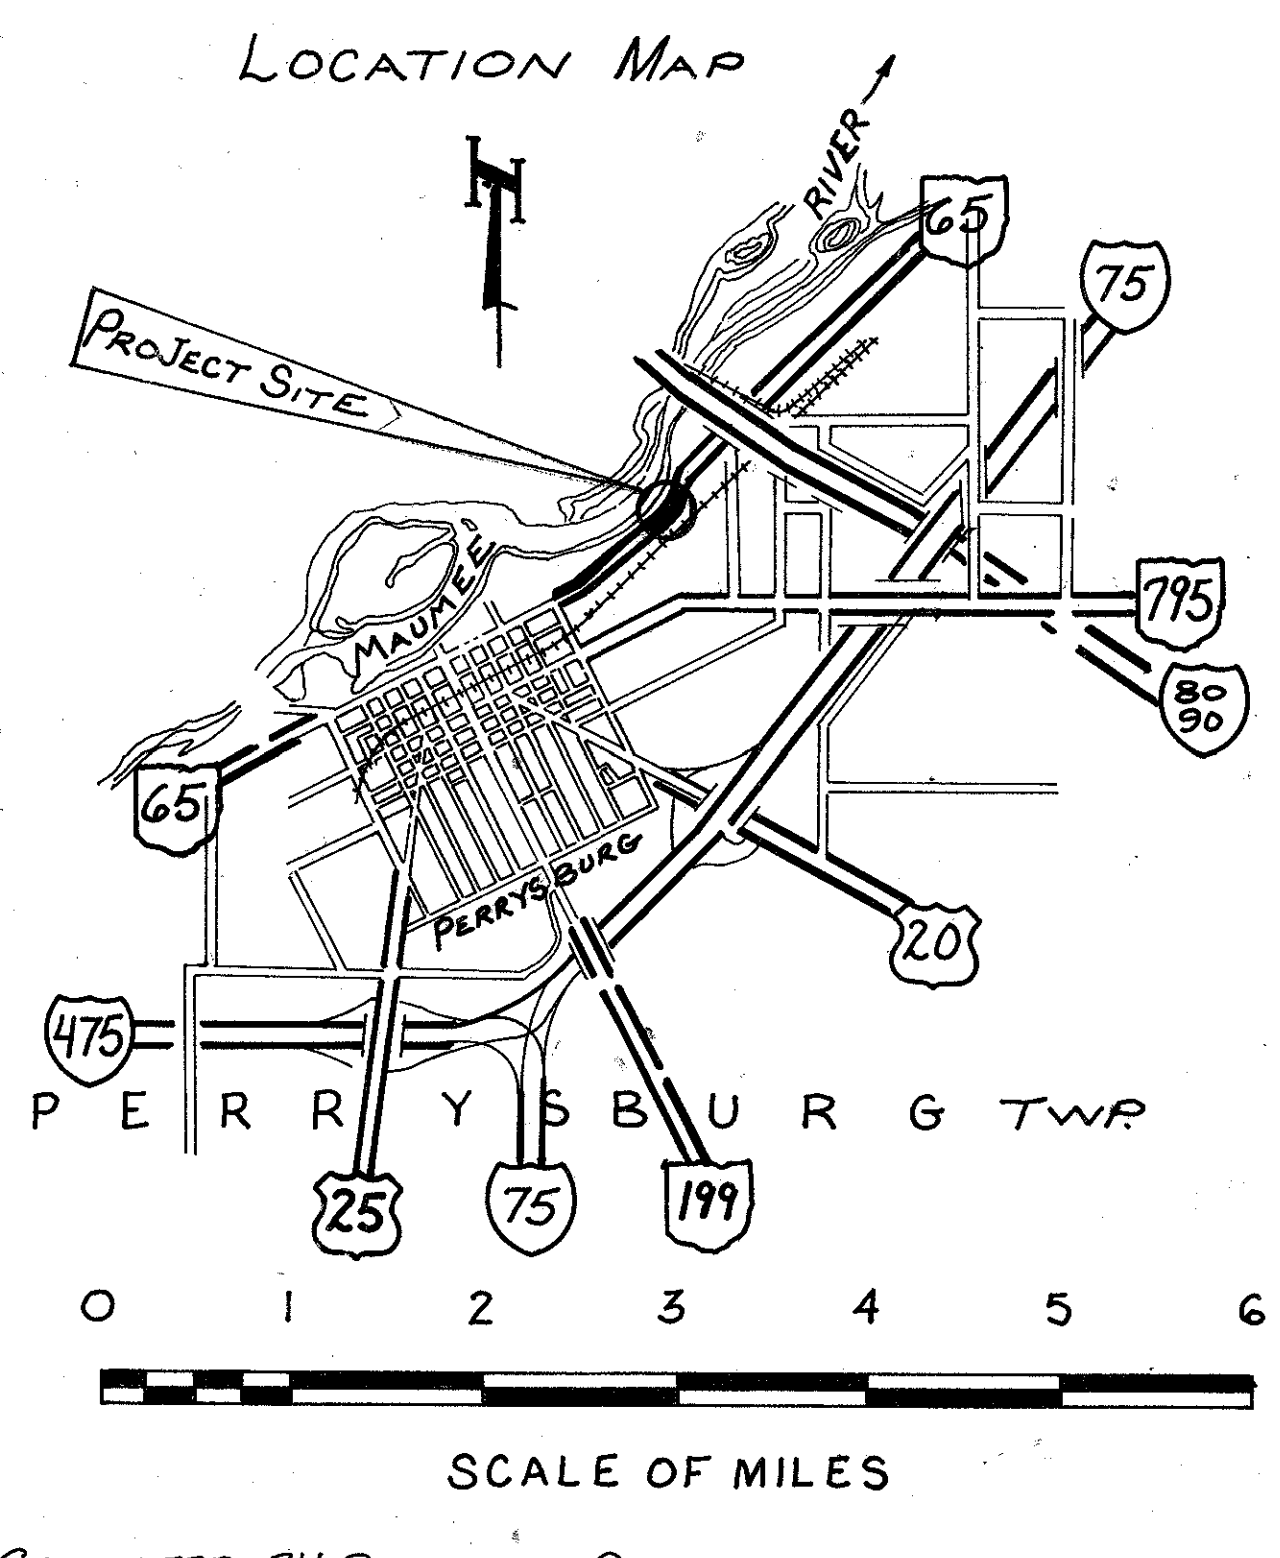

DATE	PAR.	REMARKS
3-10-87		REVISED END PROPERTY ACQUISITION
3-11-87	15A	REVISED AREA - CHANGED TO 1-T
12-10-86	10-JSA	OWNER CHANGE
10-21-86	13-KSA	OWNER CHANGE

Woo 65-1950 (1)

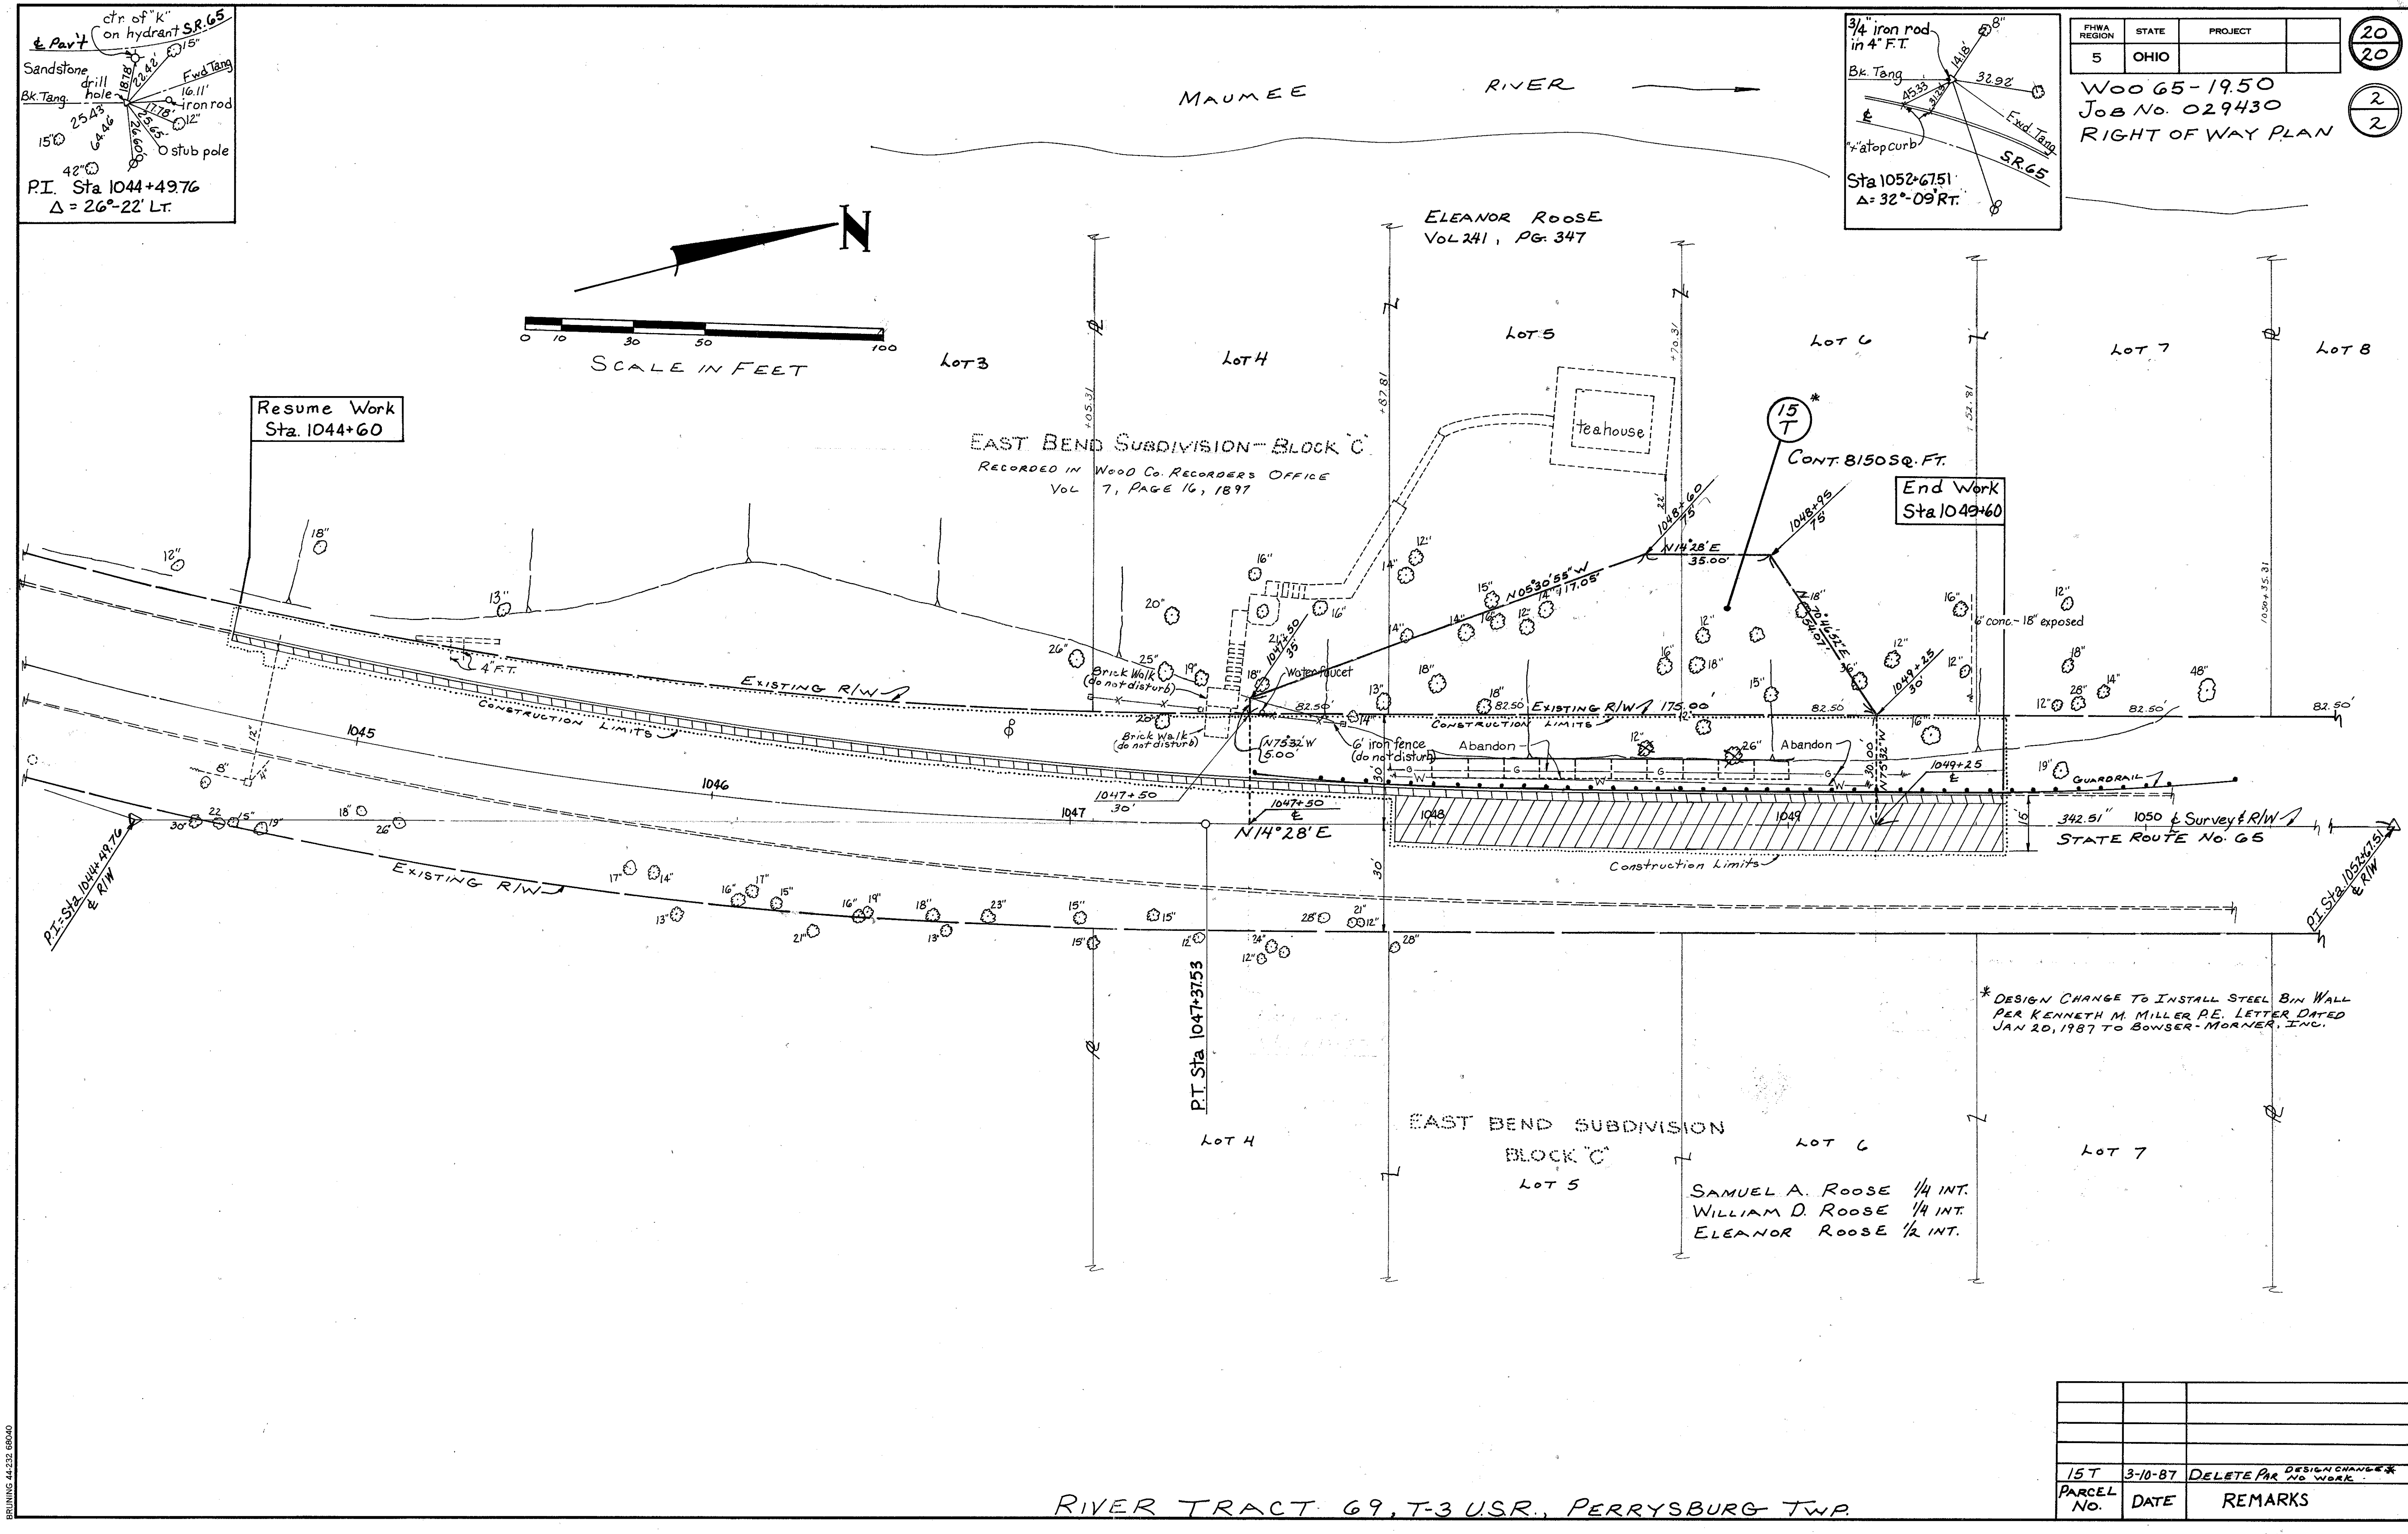

FHWA REGION	STATE	PROJECT	20
5	OHIO		20

Woo 65-1950  
JOB No. 029430  
RIGHT OF WAY PLAN

\* DESIGN CHANGE TO INSTALL STEEL BOLLARD WALL PER KENNETH M. MILLER P.E. LETTER DATED JAN. 20, 1987 TO BOWSER-MORNER, INC.

PARCEL NO.	DATE	REMARKS
15T	3-10-87	DELETE PAR. DESIGN CHANGE NO WORK

Woo 65-1950 (2)