

PRIORITY NO. 22PART 1 OF 1SHEET 1 OF 12COUNTY WOODROUTE SR 65SECTION 22.19BEGIN LOG (SLM) 22.19TERMINII South Corporation LineEND LOG (SLM) 24.21TERMINII North Corporation LineTOTAL LENGTH 2.02

MILES

MUNICIPALITY RossfordBEGIN LOG (SLM) 22.19 END LOG (SLM) 24.21

MUNICIPALITY _____

BEGIN LOG (SLM) _____ END LOG (SLM) _____

PROPOSED WORK:

PAVEMENT

1 1/2" 404

SHOULDER

CurbOTHER Mill 5' each side - Remove Precast Concrete Traffic Divider ²⁰⁹ TOTALEXISTING DATA: See sheets 7-8-9-10-11 & 12

SLM <u>22.19</u> TO <u>23.37</u>	PAV'T	WIDTH <u>30'</u> (type _____)	SHLD	WIDTH _____ (type <u>Curb</u>)
SLM <u>23.37</u> TO <u>24.21</u>	PAV'T	WIDTH <u>20' 24'</u> (type _____)	SHLD	WIDTH _____ (type _____)
SLM _____ TO _____	PAV'T	WIDTH _____ (type _____)	SHLD	WIDTH _____ (type _____)
SLM _____ TO _____	PAV'T	WIDTH _____ (type _____)	SHLD	WIDTH _____ (type _____)
STRUCTURES:

NOT A BRIDGE - IT IS A LARGE PIPE

STR. NO. <u>W200-65-2308</u>	WIDTH _____	LENGTH _____	PROP. WORK _____
STR. NO. _____	WIDTH _____	LENGTH _____	PROP. WORK _____
STR. NO. _____	WIDTH _____	LENGTH _____	PROP. WORK _____
RAILROAD CROSSING:


NAME <u>TT RR</u>	STATION _____	NO. TRACKS <u>1</u>	LENGTH ALONG C L _____ ft
NAME <u>E. N.B. LANES</u>	STATION <u>1261+70</u>	NO. TRACKS _____	LENGTH ALONG C L <u>13'</u> ft
NAME <u>E. S.B. LANES</u>	STATION <u>1262+07</u>	NO. TRACKS _____	LENGTH ALONG C L <u>12'</u> ft

MISCELLANEOUS:

NO. RAISED PAVEMENT MARKERS; EDGE OF PAVEMENT ○, CENTERLINE ○

NO. MAILBOX APPROACHES _____, MAILBOX SUPPORTS _____

REMARKS:

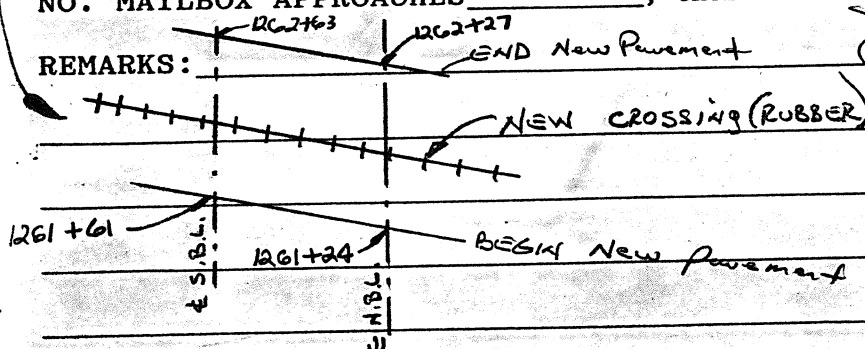

APPROACHES (INTERSECTIONS & DRIVES)

COUNTY WOOD

ROUTE SR 65

SECTION 22.19

$L = \text{Prop Pav't Depth (in.)} \times .10$; $W = \text{Width @ Mouth}$; $W-1 = \text{Width @ Throat}$

[illegible]

UTILITIES (Catch Basin, Manhole, Inlet, Watervalue Box and Monument Box)

COUNTY WOOD

ROUTE SR 65

SECTION 22.19
R = Raise F = Feather

STATION	OUT (FT) Rt/Lt	CATCH BASIN	MAN- HOLE	INLET	W V BOX	MON BOX	CASTING		REMARKS
							R	F	
1172+09	RT			X				X	AT CURB
1172+09	LT			X				X	AT CURB
1173+57	RT		X				X		IN INTERSECTION - 3' BACK OF CURB LINE
1177+32	RT			X				X	AT CURB
1177+32	LT			X				X	AT CURB
1179+51	RT		X					X	IN INTERSECTION 13' BACK OF CURB LINE
1180+30	RT			X				X	AT CURB
1180+30	LT			X				X	AT CURB
1183+04	RT			X				X	AT CURB
1183+04	LT			X				X	AT CURB
1185+82	RT			X				X	AT CURB
1185+82	LT			X				X	AT CURB
1189+40	RT			X				X	AT CURB
1189+40	LT			X				X	AT CURB
1193+05	RT			X				X	AT CURB
1193+05	LT			X				X	AT CURB
1196+76	RT			X			X		6' RT. of LT. CURB
1196+76	LT		STORM X					X	AT CURB
1197+14	LT			X				X	2' BACK OF CURB LINE
1197+36	RT		SEWER X				X		6' RT. of LT. CURB
1197+63	LT		WATER X				X		5' RT. of LT. CURB
1198+08	LT		X					X	9' BACK IN RADIUS OF AT CURB - INTERSECTION
1198+09	RT			X				X	8' RT. OF LT. CURB
1198+26	LT		X				X		IN RADIUS - 3.5' BACK OF CURB LINE
1198+60	LT		SEWER X				X		2' RT. OF LT. CURB LINE
1199+19	LT		WATER X				X		IN RADIUS
1199+28	LT		X				X		4' RT. OF LT. CURB LINE IN RADIUS
1200+79	RT			X				X	AT CURB
1200+79	LT			X				X	AT CURB
1203+80	RT			X				X	AT CURB
1203+80	LT			X				X	AT CURB
1206+58	RT			X				X	AT CURB
1206+58	LT			X				X	AT CURB
1209+66	RT			X				X	AT CURB
1209+66	LT			X				X	AT CURB
1209+94	RT		X				X		IN INTERSECTION 11' BACK OF CURB LINE
1212+86	RT			X				X	AT CURB
1212+86	LT			X				X	AT CURB
1216+53	LT		WATER X					X	AT CURB
1216+81	LT			X				X	AT CURB
1219+12	LT			X				X	AT CURB

UTILITIES (Catch Basin, Manhole, Inlet, Watervale Box and Monument Box)

COUNTY WoodROUTE SR 65SECTION 22.19

R = Raise F = Feather

STATION	OUT Rt/Lt	CATCH BASIN	MAN- HOLE	INLET	W V BOX	MON BOX	CASTING		REMARKS
							R	F	
1220+13	RT			X				X	AT CURB
1220+13	LT			X				X	AT CURB
1220+56	RT			X				X	AT CURB
1222+79	RT			X				X	AT CURB
1224+29	RT			X				X	AT CURB
1225+27	LT			X				X	AT CURB
1226+28	RT			X				X	AT CURB
1227+35	RT		X				X		6' LT. & RT. CURB
1228+38	RT			X				X	AT CURB
1230+14	RT			X				X	AT CURB
1231+35	LT							X	BACK Edge of CURB
1231+88	RT			X				X	AT CURB
1231+88	RT		X				X		10' LT. & RT. CURB
1234+95	LT		X				X		IN INTERSECTION ON CURB LINE EXTENDED
1235+02	LT		X				X		IN INTERSECTION 7' RT. & LT. CURB LINE
1235+13	LT			X				X	AT CURB
1235+81	LT INSIDE CURB			X				X	AT CURB
1235+81	RT INSIDE			X				X	AT CURB
1235+81	RT OUTSIDE			X				X	AT CURB
1237+38	LT OUTSIDE			X				X	AT CURB
1239+62	RT INSIDE			X				X	AT CURB
1239+62	RT OUTSIDE			X				X	AT CURB
1239+62	LT INSIDE			X				X	AT CURB
1239+62	LT OUTSIDE			X				X	AT CURB
1240+74	LT OUTSIDE			X				X	AT CURB
1241+32	LT		X				X		5' RT. & LT. CURB LINE IN INTERSECTION
1241+60	LT OUTSIDE			X				X	AT CURB
1241+20	RT		X				X		IN INTERSECTION 3' LT. & RT. CURB LINE
1241+28	RT			X			X		6' RT. & RT. CURB LINE IN INTERSECTION
1241+56	RT				X		X		6' LT. & RT. CURB LINE
1241+61	RT				X		X		3' LT. & RT. CURB LINE
1241+65	RT		X	3' $\square$ WATER			X		2' LT. & RT. CURB LINE
1241+90	LT INSIDE			X				X	AT CURB
1242+37	RT OUTSIDE			X				X	AT CURB
1242+39	RT INSIDE			X				X	AT CURB
1242+40	LT		X				X		3' LT. & INSIDE CURB
1242+40	LT		X				X		11' LT. & INSIDE CURB
1242+89	LT OUTSIDE			X				X	AT CURB
1244+14	RT		X				X		7' LT. & RT. CURB

UTILITIES (Catch Basin, Manhole, Inlet, Watervalue Box and Monument Box)

COUNTY WoodROUTE 65SECTION 22.19

R = Raise F = Feather

	STATION	OUT Rt/Lt	CATCH BASIN	MAN- HOLE	INLET	W V BOX	MON BOX	CASTING		REMARKS
								R	F	
IBC	1244+27	RT		WATER X				X		7' Lt. of Rt. CURB
IBC	1244+41	RT		WATER X				X		5' Rt. of Rt. CURB LINE
IBC	1244+43	RT		WATER X	1.5x2.0'			X		7' Lt. of Rt. CURB
IBC	1244+53	RT outside X							X	IN INTERSECTION ON CURB LINE
IBC	1244+78	RT INSIDE CURB			X				X	AT CURB
SBC	1244+79	LT OUTSIDE CURB			X				X	AT CURB
SBL	1244+80	LT INSIDE							X	AT CURB
SBC	1245+44	LT OUTSIDE		X					X	AT CURB
SBC	1246+30	LT outside X						X		AT CURB LINE IN DRIVE TO BANK
IBC	1247+05	RT INSIDE CURB	X					X		IN CROSS-OVER DRIVE 3' Lt. of Lt. CURB
IBC	1248+80	RT		WATER X				X		IN INTERSECTION 5' BACK of CURB LINE
IBC	1248+81	RT		WATER X	1.5x2.0'			X		5' Lt. of Rt. (outside) CURB LINE
IBC	1248+91	RT	X						X	IN INTERSECTION 2' BACK of CURB LINE
IBC	1248+98	RT		WATER X				X		3' Lt. of Rt. CURB LINE
IBC	1249+01	RT	X						X	3' Rt. of Rt. CURB LINE
IBC	1249+15	RT INSIDE CURB			X				X	AT CURB
SBC	1249+15	LT INSIDE			X				X	AT CURB
SBC	1249+15	LT OUTSIDE			X				X	AT CURB
IBC	1252+83	RT INSIDE			X				X	AT CURB
SBC	1252+83	LT INSIDE			X				X	AT CURB
IBC	1253+16	RT		WATER X				X		IN INTERSECTION 5' RT of Rt. CURB LINE
IBC	1253+17	RT	1.5x2.0'	WATER X				X		IN INTERSECTION 6' Lt. of Rt. CURB LINE
SBC	1255+06	LT OUTSIDE	X					X		1' Rt. of Lt. CURB
SBC	1256+86	LT outside			X				X	AT CURB
SBC	1256+86	LT INSIDE			X				X	AT CURB
IBC	1256+86	RT INSIDE			X				X	AT CURB
IBC	1256+89	RT OUTSIDE			X				X	AT CURB
IBC	1257+54	RT	1.5x2.0'	WATER X				X		IN INTERSECTION 6' Lt. of Rt. CURB LINE
IBC	1257+54	RT		WATER X				X		IN INTERSECTION 2' Lt. of Rt. CURB LINE
IBC	1257+60	RT	1.5x2.0'	WATER X				X		IN INTERSECTION 2' Rt. of Rt. CURB LINE
IBC	1258+41	RT INSIDE			X				X	AT CURB
IBC	1258+41	RT OUTSIDE			X				X	AT CURB
SBL	1259+56	LT INSIDE			X				X	AT CURB
SBL	1259+54	LT OUTSIDE			X				X	AT CURB
	1260+56	CTR			X				X	AT NOSE of CROSSOVER
IBC	1262+47	RT OUTSIDE			X				X	AT CURB
	1264+54	LT		WATER X				X		5' RT of Lt. CURB
	1265+67	RT			X				X	AT CURB
	1265+67	LT			X				X	AT CURB

UTILITIES (Catch Basin, Manhole, Inlet, Watervalue Box and Monument Box)

COUNTY Waco

ROUTE SRGS

SECTION 22.19

R = Raise F = Feather

STATION	OUT Rt/Lt	CATCH BASIN	MAN- HOLE	INLET	W V BOX	MON BOX	CASTING		REMARKS
							R	F	
1267+31	RT		water X				X		9' Lt of Rt curb
1267+31	LT		water X				X		9' RT of Lt curb
1268+68	LT			X				X	AT CURB
1269+35	RT			X				X	AT CURB
1269+35	LT			X				X	AT CURB
1270+54	LT		water X				X		5' RT of Lt curb
1271+05	LT		water X				X		4' RT of Lt curb
1274+31	RT			X				X	AT CURB
1274+49	RT		X				X		14' RADIUS - 6' RT of curb curb
1274+72	LT			X				X	AT CURB
1274+76	RT		X				X		14' intersection - 3' RT of curb curb
1276+66	LT		water X				X		3' RT of Lt curb
1277+80	RT		water X				X		17' Lt of Rt curb
1277+97	RT		water X				X		15' Lt of Rt curb
1279+00	RT		water X				X		12' Lt of Rt curb
1278+30	RT		water X				X		21.5 Lt of Rt curb
1278+32	RT		water X				X		15.0 Lt of Rt curb
1278+12	LT		X					X	AT CURB
1278+54	RT			X				X	AT CURB
1279+44	LT			X				X	AT CURB
POSSIBLE END PROJECT at 1279+11 at CORP SIGW !!									


PERSONNEL TITLE PERSONNEL TITLE COUNTY Wood DATE 10-12-89
Hoffman M _____
BARNHISEL _____ S. R. 65 WEATHER CLEAR - Green
 _____ SEC. 22.19 - 24.21 TEMP. 65°

DESCRIPTION	EXTRA INFORMATION	JOB NO.
	CENTER LINE	RIGHT

STA	Left	Pavement	Right	Notes
1170+90	SANDSTONE		SANDSTONE	ROSSFORD CORP SIGNAL
1170+98	CURB	30.0'	CURB	CONST JOINT
1201+17	END TAPER		END	Newer 6" STRAIGHT CURB
1200+10	BEGIN TAPER			
	EXTRA AREA TURN LANES			
1197+18	END TAPER			
1195+19	BEGIN TAPER		BEGIN	Newer 6" STRAIGHT CURB
1223+39	END TAPER			
1220+97	BEGIN TAPER			

PERSONNEL	TITLE	PERSONNEL	TITLE	COUNTY	DATE
HOFFMAN	□			Wood	10-12-89
BARNHISEL				S. R. 65	WEATHER Great
				SEC. 22.19	TEMP. 75°

DESCRIPTION	EXTRA INFORMATION	JOB NO.
-------------	-------------------	---------

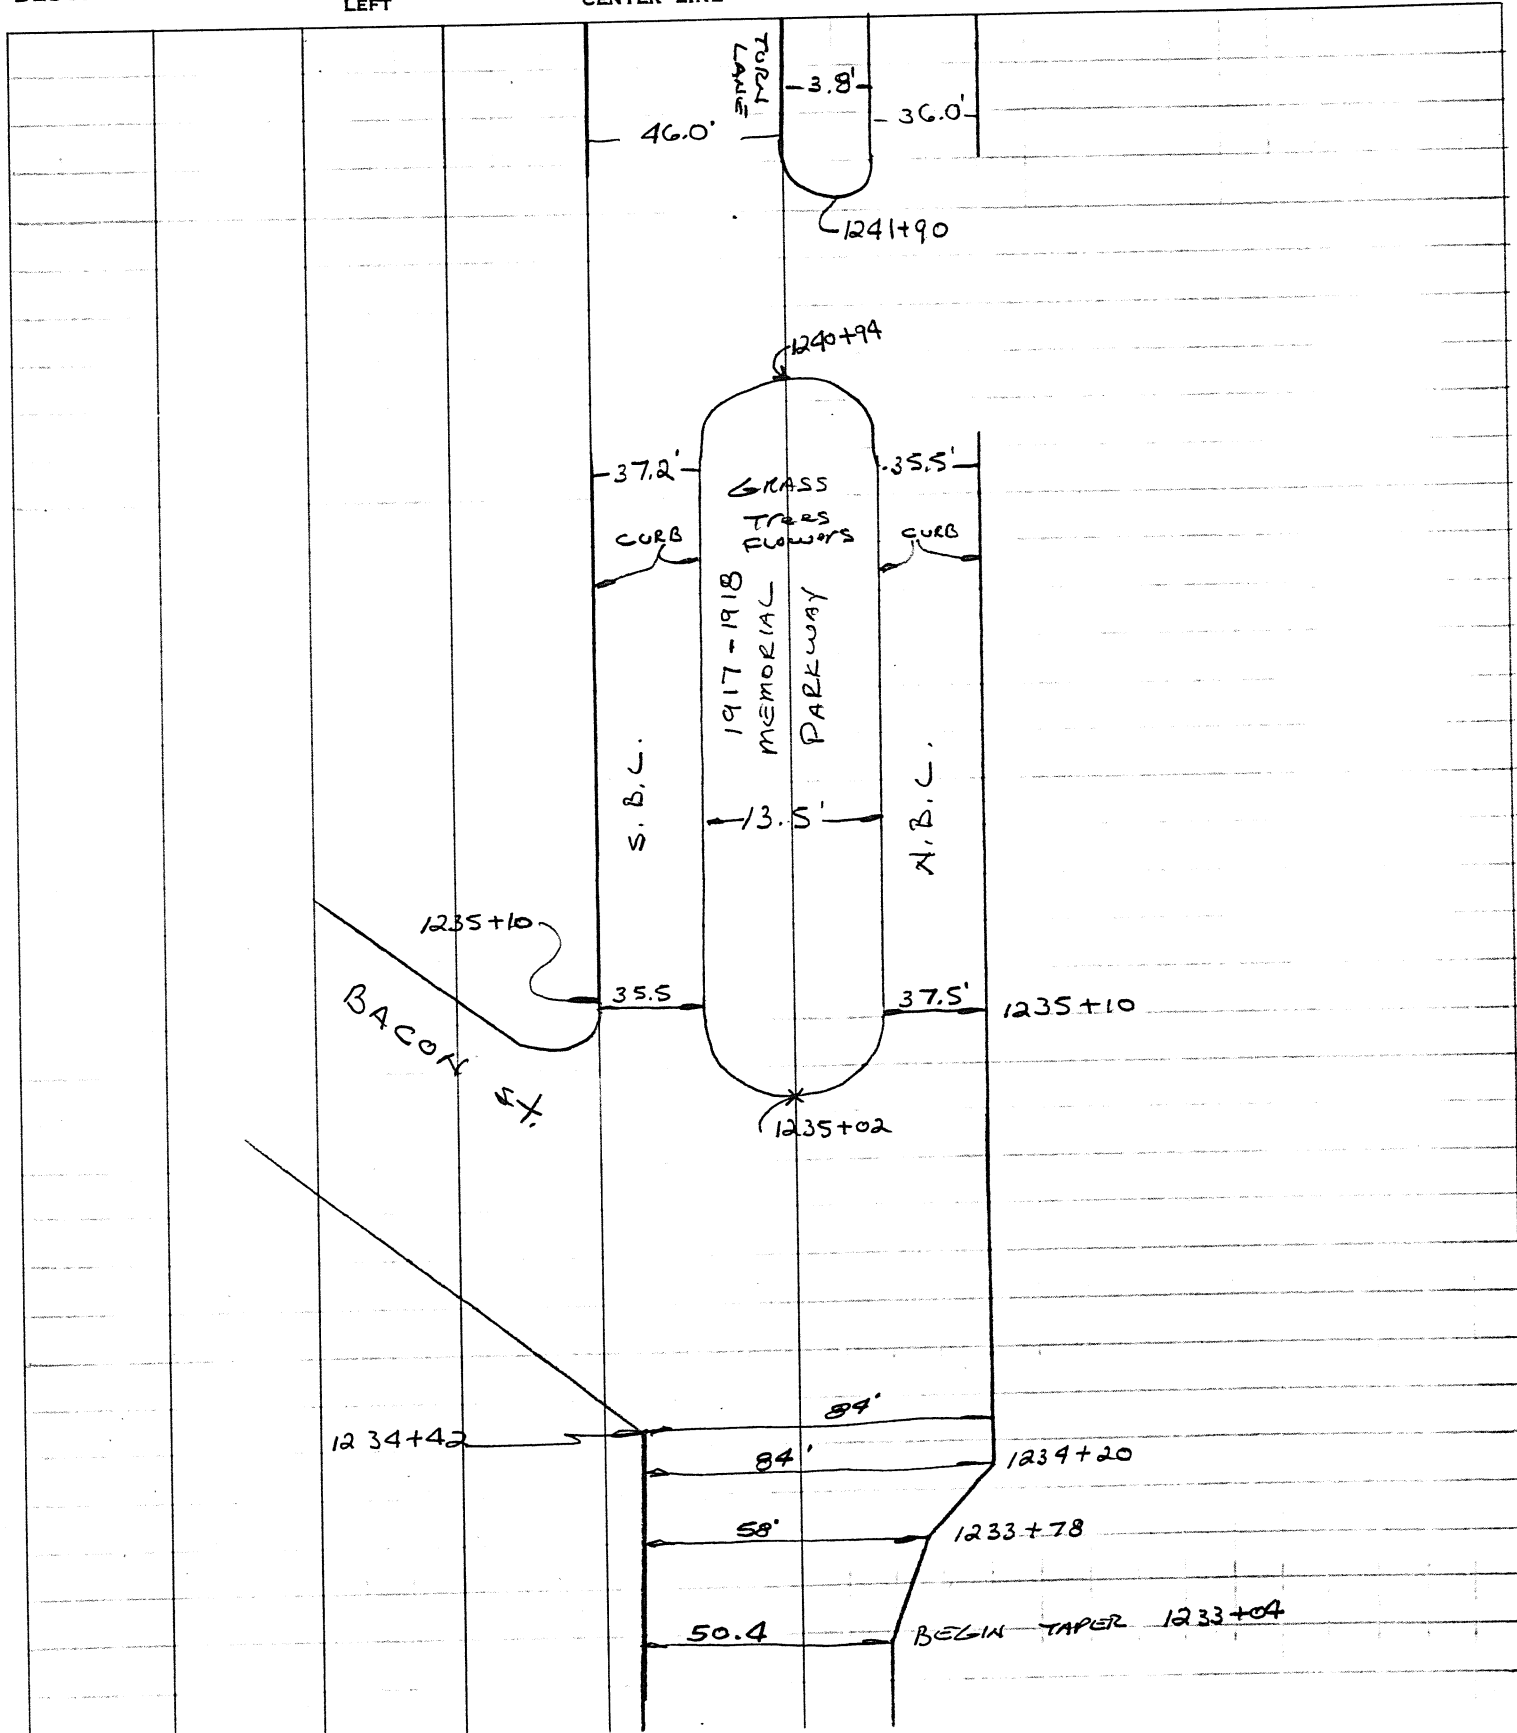


PERSONNEL	TITLE	PERSONNEL	TITLE	COUNTY	DATE
HOFFMAN	II			Wood	10-12-89
BARNHISEL				S. R. 65	WEATHER CLEAR
				SEC. 22.19	TEMP. 77°
DESCRIPTION				JOB NO.	

EXTRA INFORMATION

LEFT


CENTER LINE

RIGHT

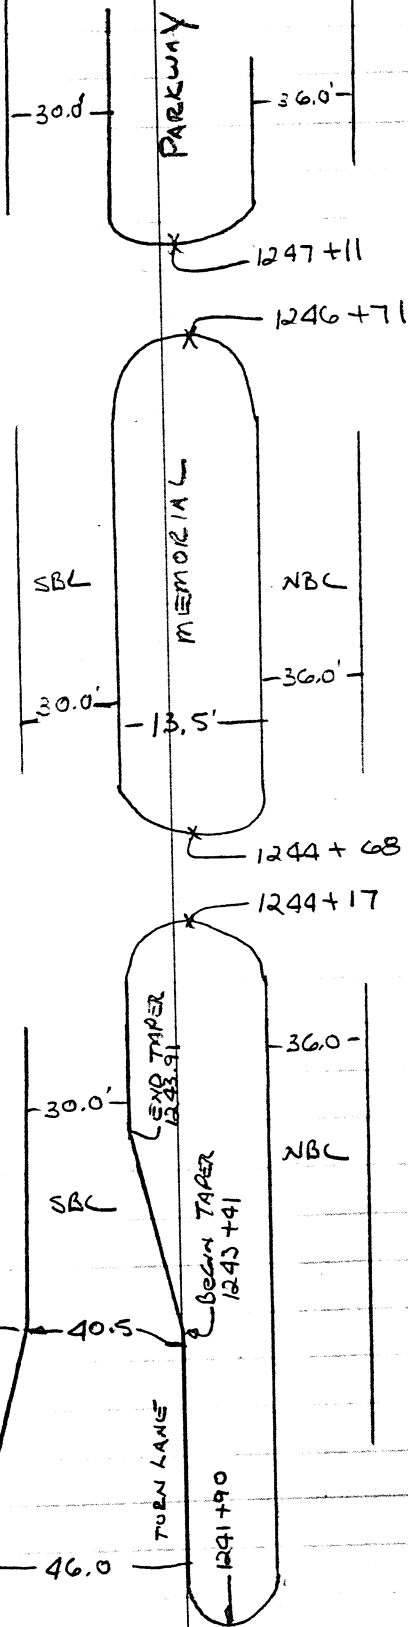


PERSONNEL	TITLE	PERSONNEL	TITLE	COUNTY	DATE
Hoffman	□			Woods	10-12-89
Barthel				S. R. 65	WEATHER CLEAR !!
				SEC. 22.19	TEMP. 79° !!

DESCRIPTION	EXTRA INFORMATION	JOB NO.
LEFT	CENTER LINE	RIGHT

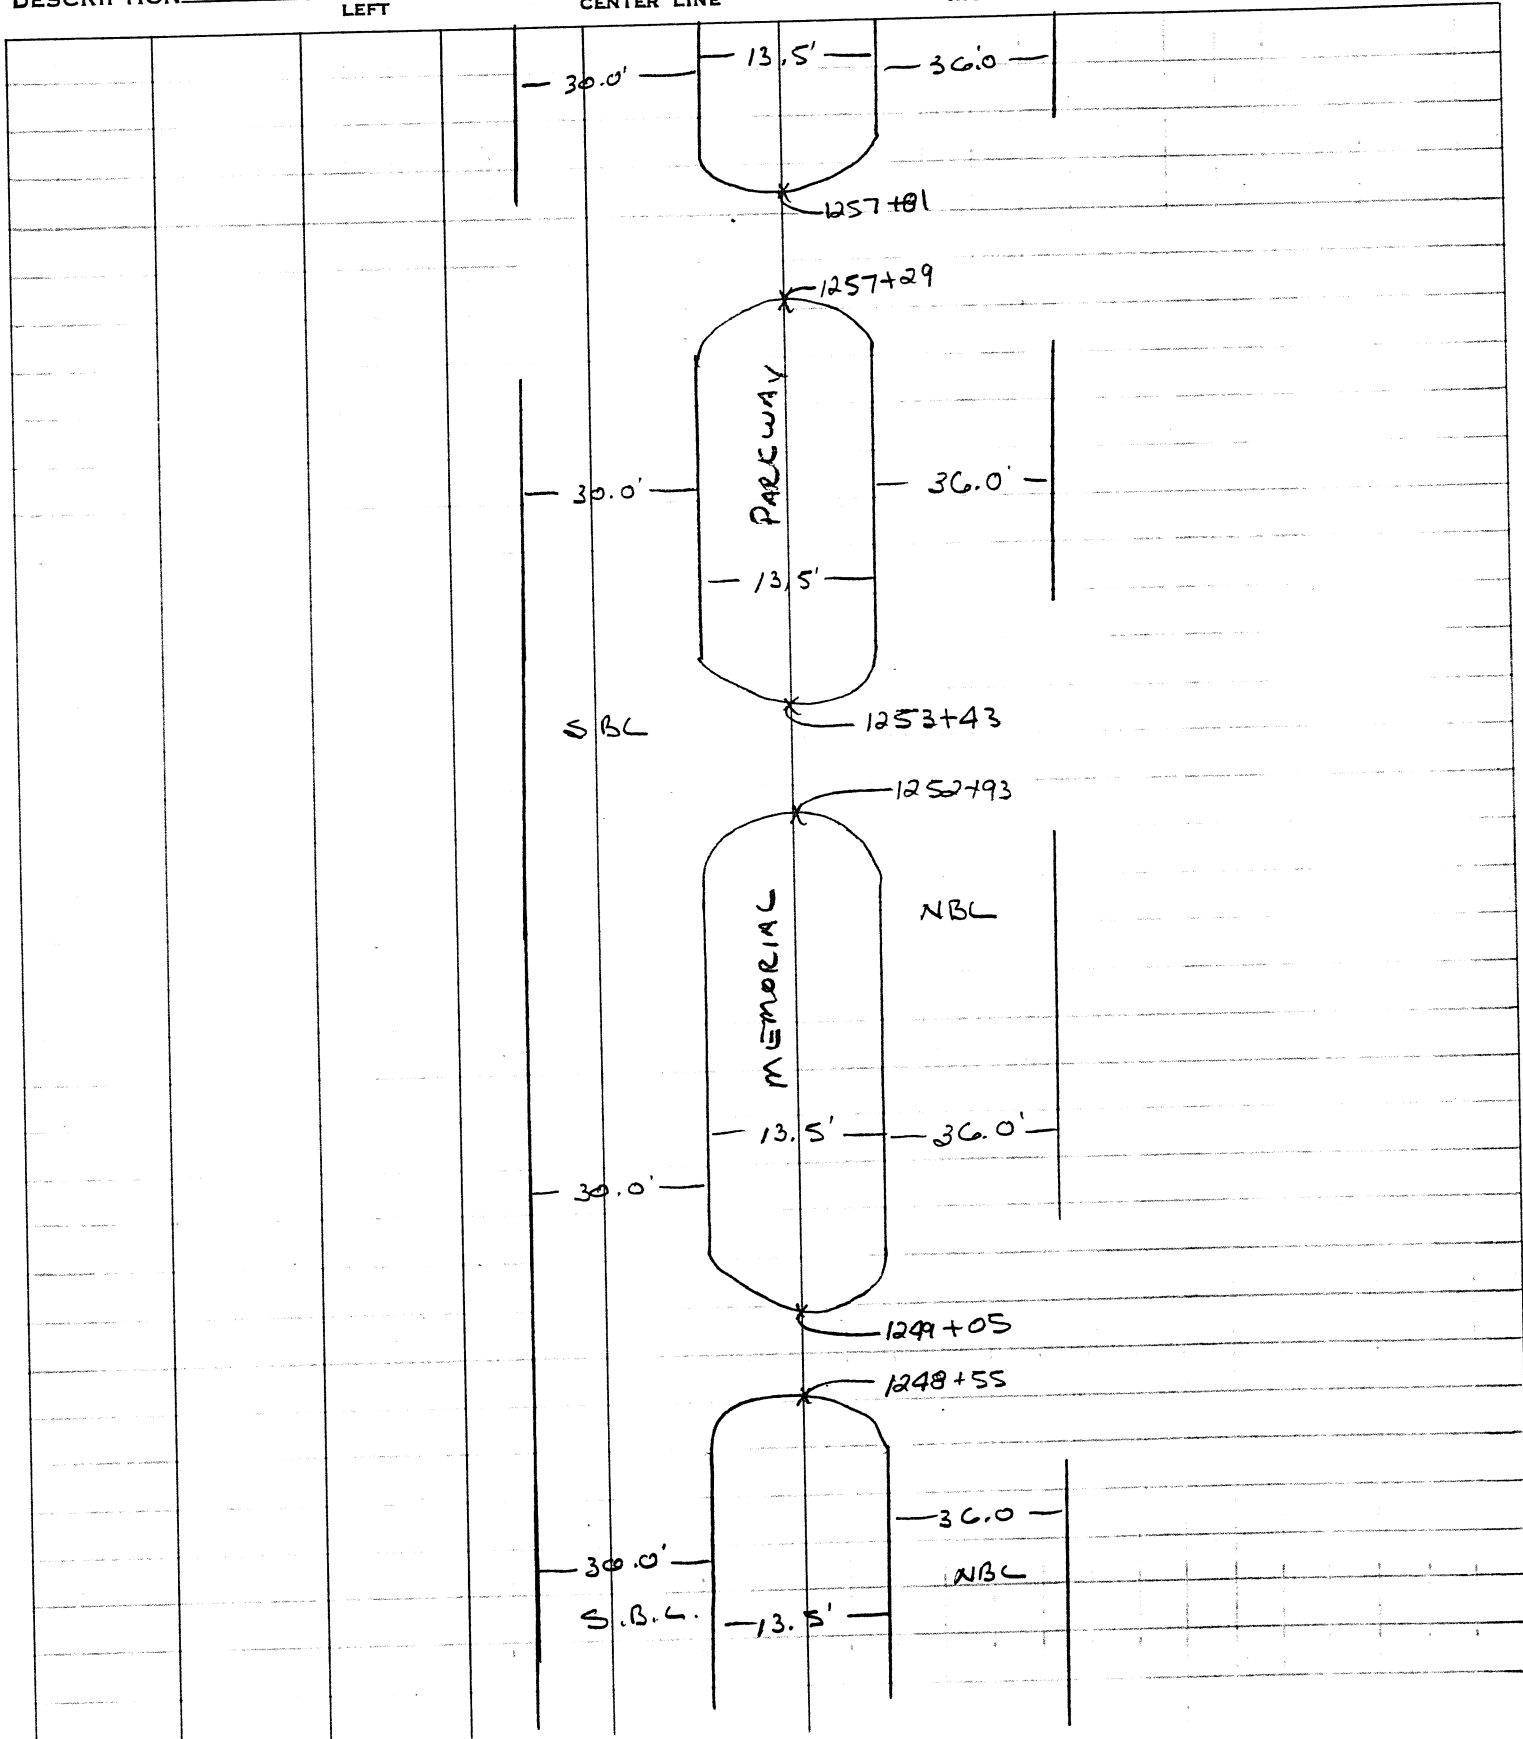

PERSONNEL	TITLE	PERSONNEL	TITLE	COUNTY	DATE
HOFFMAN	II			Wood	10-12-89
BARNHISEL				S. R. 65	WEATHER CLEAR
				SEC. 22.19	TEMP. 79°
DESCRIPTION EXTRA INFORMATION				JOB NO.	
LEFT		CENTER LINE		RIGHT	

1262+42 END PARKWAY

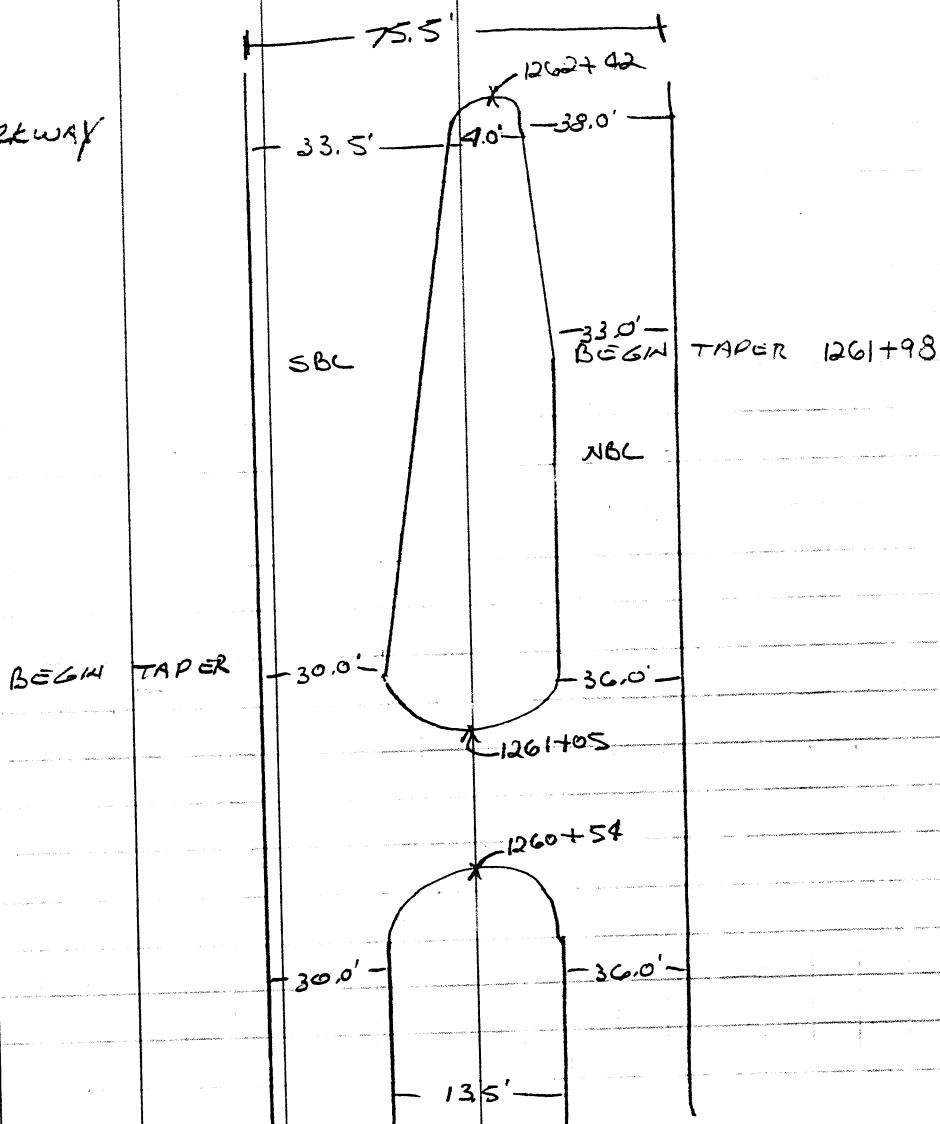

PERSONNEL HOFFMAN TITLE III COUNTY Wood DATE 10-18-89
BARHAMISEL wheel S. R. 65 WEATHER Cloudy
 SEC. 22.19 TEMP. 41°

DESCRIPTION EXTRA INFORMATION JOB NO. _____
 LEFT CENTER LINE RIGHT

STA	CURB	Pavement	CURB		
1263+00	Street	71 ±	Yes		
1264+00	2' CONC & gutter curb	66.3'	2' CONC gutter curb		
1265+00	"	63.8'	"		
1266+00	"	60.4'	"		
1267+00	"	55.0'	"		
1268+00	"	54.0'	"		
1269+00	"	54.0'	"		
1270+00	"	54.0	"		
1271+00	"	54.0	"		
1272+00	"	55.2	"		
1273+00	"	58.4	"		
1274+00	"	60.0	"		
1275+00	"	62.0	at intersection		
1276+00	"	59.2	curb		
1277+00	"	60.0	"		
1278+00	"	59.5	"		
1278+11	END JOB HERE? —				ROSSFORD CORP SIGN (LEFT) 1278+03 IS A CONTROL POINT - POSSIBLE LUCAS-WOOD LINE
1279+00		55.8			
1280+00		54.0			
1280+22					TOLEDO CORP SIGN (RIGHT)