

O.D.O.T. DISTRICT 2 SURVEY OFFICE (USE ONLY)

PERSONNEL

REFERENCE NO. 1

SHEET 1 OF 40

NOTES RHOADES

DATE 4/28/17

ROUTE SR 65

H.C. LEU

WEATHER FAIR

COUNTY WOOD

R.C. HELDMAN

TEMP. 46°

TOWNSHIP GRAND RAPIDS

SECTION 7

DWG BY RHOADES PID 95796

T 5 N R 9 E

TYPE MONUMENT MAG/WASHER

ON SURFACE - ~~BELOW~~ ON

OFFSET CL PAVEMENT 2.4' ~~LT~~ : RT

12.5' TO LT EDGE PAVEMENT


STATION: 0+00

HORIZ.DATUM: NAD83 2011


GEOID: NAVD88 2018

GRID: NORTHING: 638092.144

EASTING: 1589091.109

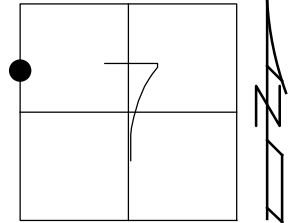

NOTE: HEN 65 REF 40

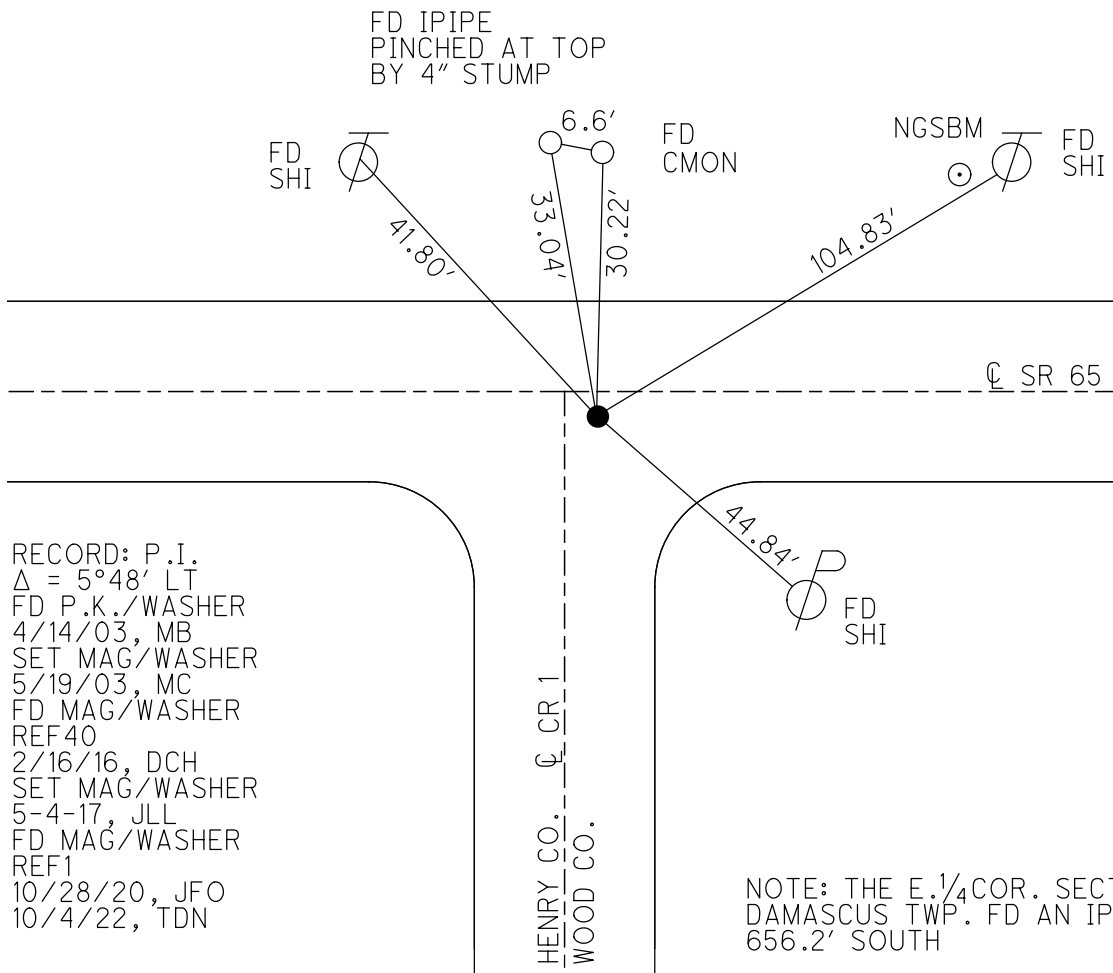

RECORD: P.I.
 $\Delta = 5^{\circ}48'$ LT
 FD P.K./WASHER
 4/14/03, MB
 SET MAG/WASHER
 5/19/03, MC
 FD MAG/WASHER
 REF40
 2/16/16, DCH
 SET MAG/WASHER
 5-4-17, JLL
 FD MAG/WASHER
 REF1
 10/28/20, JFO
 10/4/22, TDN

NOTE: THE E. 1/4 COR. SECT. 12
 DAMASCUS TWP. FD AN IPIN
 656.2' SOUTH

O.D.O.T. DISTRICT 2 SURVEY OFFICE (USE ONLY)

PERSONNEL

REFERENCE NO. 1

SHEET 1 OF 9

NOTES RHOADES

DATE 4/28/17

ROUTE SR 65

H.C. LEU

WEATHER FAIR

COUNTY WOOD

R.C. HELDMAN

TEMP. 46°

TOWNSHIP GRAND RAPIDS

DWG BY RHOADES

PID 100787

SECTION 7

T 5 N R 9 E

TYPE MONUMENT MAG/WASHER

ON SURFACE - ~~BELOW~~ ON

OFFSET \odot PAVEMENT 2.4' ~~LT~~ : RT

12.5' TO LT EDGE PAVEMENT


STATION: 0+00

HORZ.DATUM: NAD83 2011


GEOID: 2012A

GRID: NORTHING: 638092.128

EASTING: 1589091.079

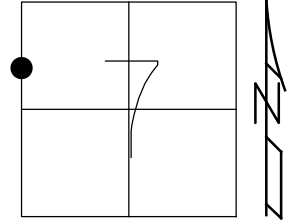

NOTE: HEN 65 REF 40

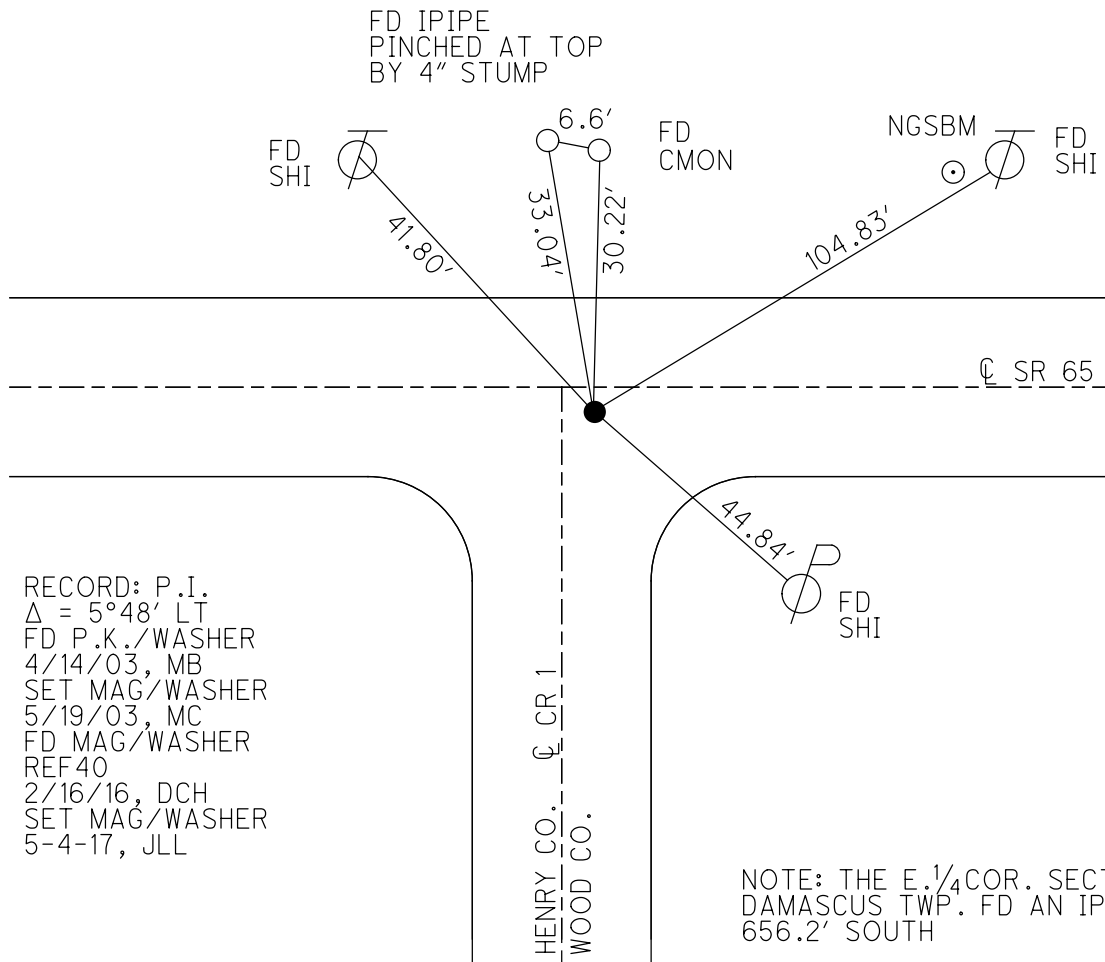

RECORD: P.I.
 $\Delta = 5^{\circ}48'$ LT
 FD P.K./WASHER
 4/14/03, MB
 SET MAG/WASHER
 5/19/03, MC
 FD MAG/WASHER
 REF 40
 2/16/16, DCH
 SET MAG/WASHER
 5-4-17, JLL

NOTE: THE E. $\frac{1}{4}$ COR. SECT. 12
 DAMASCUS TWP. FD AN IPIN
 656.2' SOUTH

HENRY CO. \odot CR 1
 WOOD CO.

O.D.O.T. DISTRICT 2 SURVEY OFFICE

PERSONNEL _____

REFERENCE NO. 1 - Wood SHEET 26 OF 26
40 - Henry

NOTES BARNHSEL H.C. _____

H.C. _____

R.C. GLASS _____

RYALL _____

DATE 4-14-03

WEATHER SUN

TEMP. +50°

ROUTE S.R. 65

COUNTY WOOD

TOWNSHIP GRAND RAPIDS

SECTION 7

T 5 N R 9 E


TYPE MONUMENT P.R. / WASHER

ON SURFACE - ~~BELOW~~ SURFACE

~~LEFT - & PAVT.~~ - RIGHT 1.7' RT.


12.5 TO LT. EDGE PAVEMENT

S.L.M. 0+00 Wood Co. / 1065+27 HENRY CO.

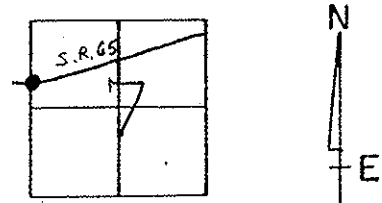

RECORD.: P.I. $\Delta = 5^{\circ} 48'$ LT.
ALSO: THE E. $\frac{1}{4}$ COR. SEC. 12
DAMASCUS TWP. IS AN IRON
PIN 656.2' SOUTH

RESET MAG/WASHER
5-19-03
M.C.

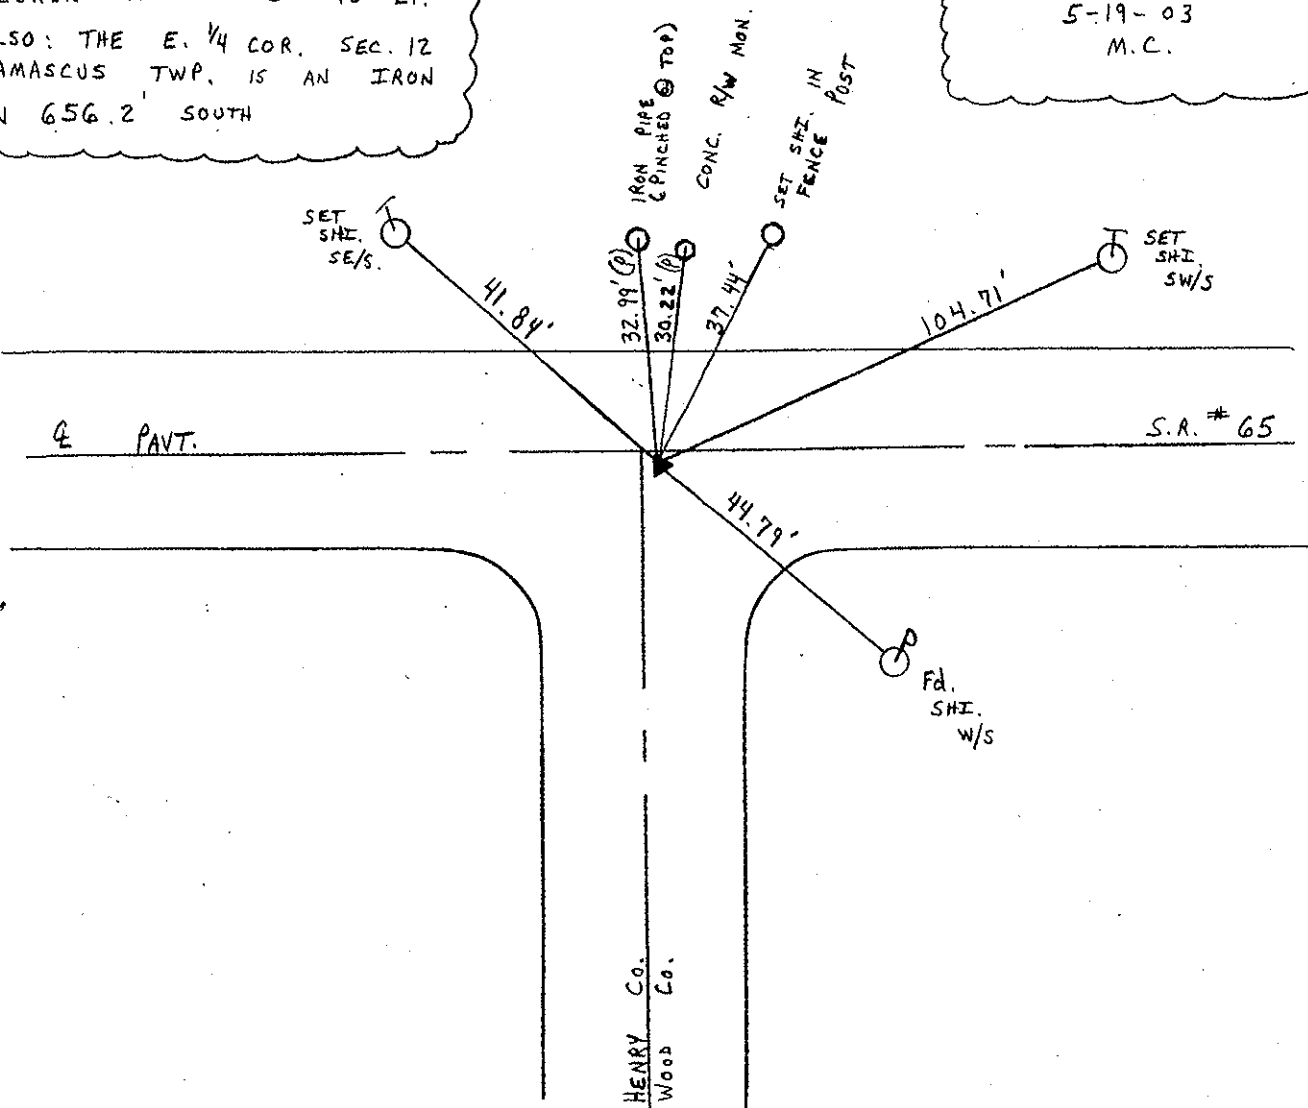

O.D.O.T. DISTRICT 2 SURVEY OFFICE

PERSONNEL _____

REFERENCE NO. 1

SHEET 1 OF 3

NOTES VAN DUSEN

H.C. BARNHISEL

R.C. _____

DATE 4-20-92

WEATHER Cloudy

TEMP. +70° F

ROUTE SR 65

COUNTY Wood

TOWNSHIP Grand Rapids

SECTION 7

T 5 N R 9 E


TYPE MONUMENT PK & WASHER

ON SURFACE - BELOW YES

LEFT - 0 PAV'T. - RIGHT 2.4

12.5 TO LT. EDGE PAVEMENT

S.L.M. 0 + 00 = 1066 + 38 Henry Co. SR 65

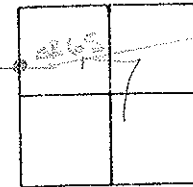


RECORD:

P.I. $\Delta = 5^{\circ} 48' 41''$

ALSO: The E 1/4 cor.
Sec. 12 DAMASCUS TWP.
IS AN IRON PIN
656.2' SWTH

Set PK & WASHER
3-24-92
BVD

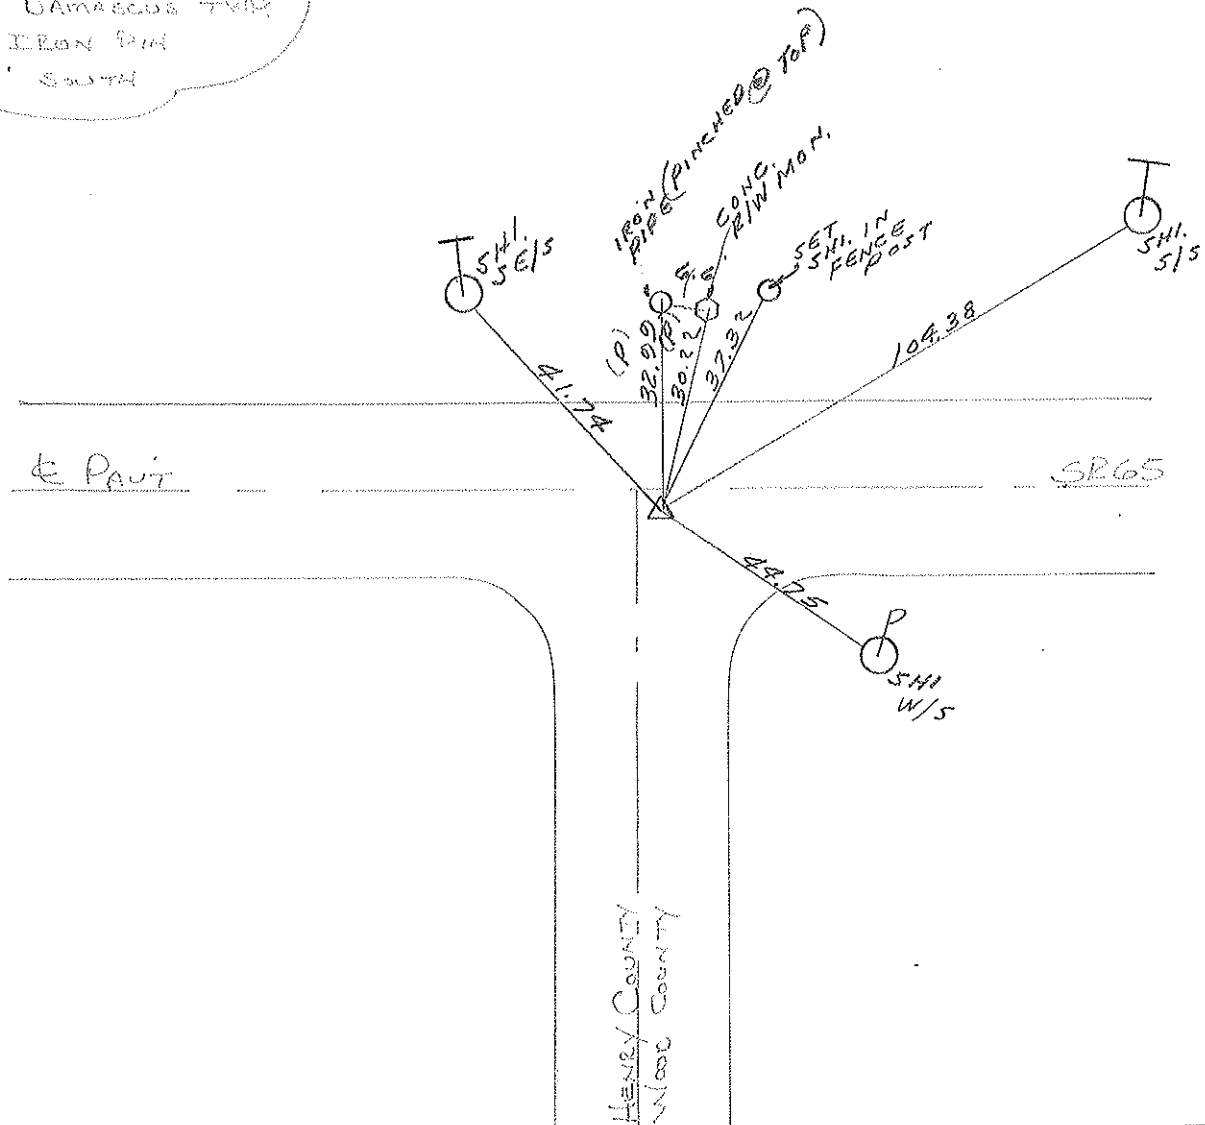

OD.O.T. DISTRICT 2 SURVEY OFFICE

SHEET 1 OF

County Wood S.R. 65

Date 12-3-81

Township Grand Rapids

Weather Partly Sunny

Section 7

Temp. +35°


T5N, R9E

Personnel Hoffman


Householder

Loehrke

1

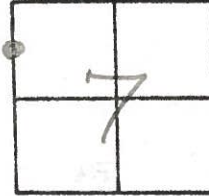

Fd. P.K. Nail @ surface
2.1' S. of & PAUT S.R. 65
12.0' TO N. E.P. of S.R. 65
2.9' E. of & PAUT Rd #1-Henry

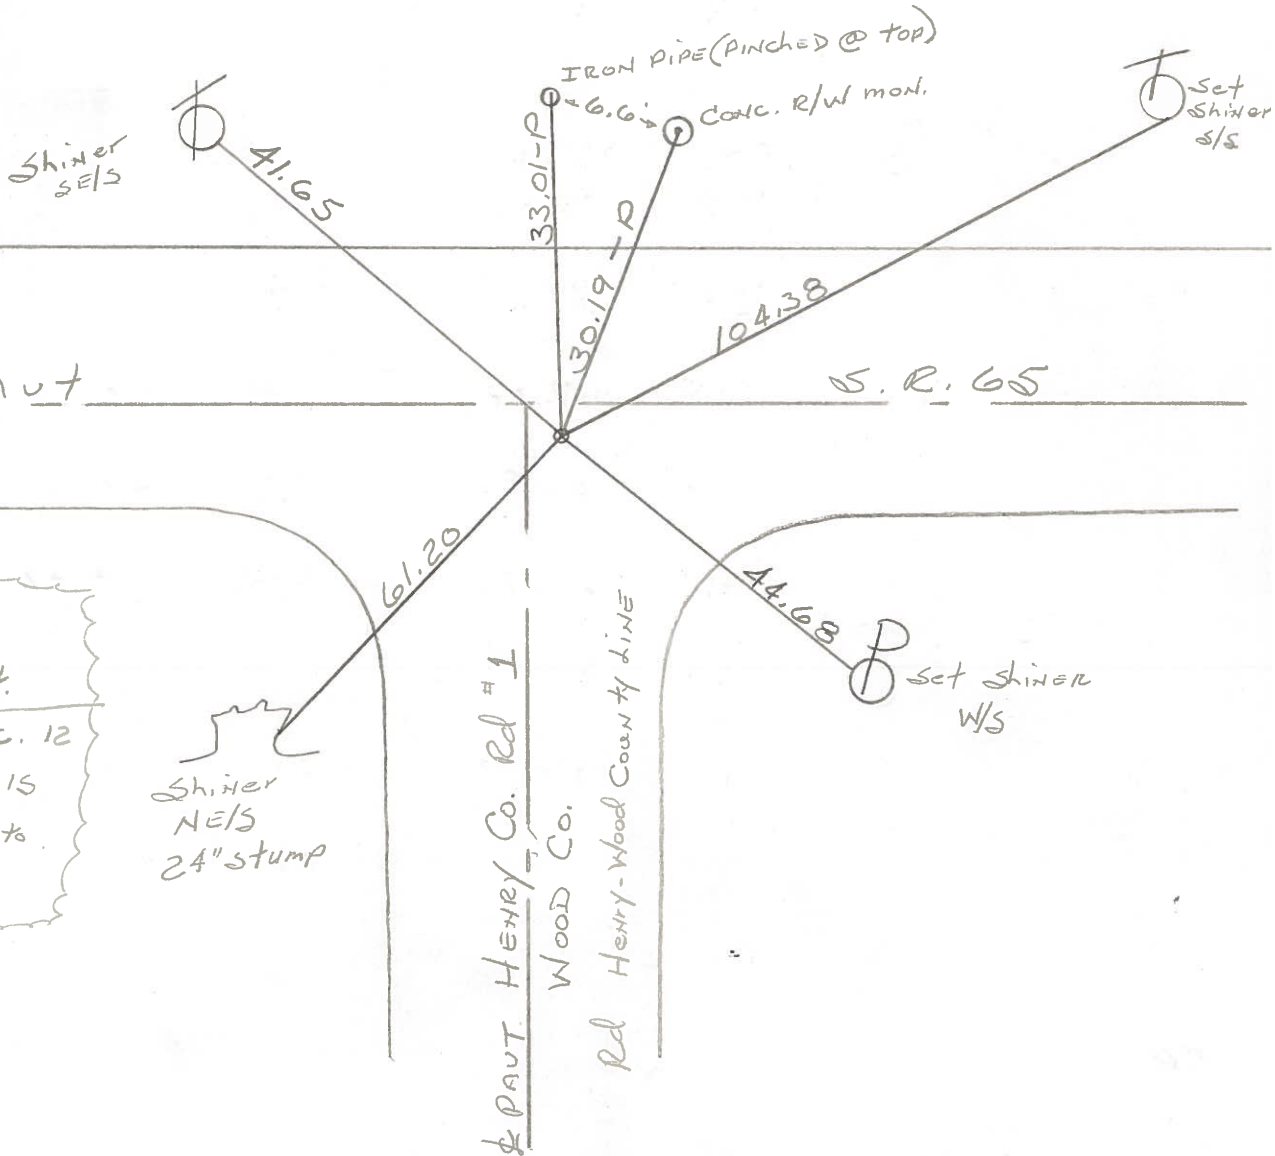


Record
P.I.
 $\Delta = 5^{\circ} - 48' 24''$
E. 1/4 COR. SEC. 12
DAMASCUS TWP 15
656.2' South to
AN IRON PIPE

U. 65-WOOD
 O.D.O.T. DISTRICT 2 SURVEY OFFICE

SHEET _____ OF _____

County WOOD S.R. 65
 Township GRAND RAPIDS
 Section 7
T5N, R9E
 Personnel BURNSIDE
SMITH
BOWERS
MEAD

Date 3-11-74
 Weather CLOUDY
 Temp. 35°

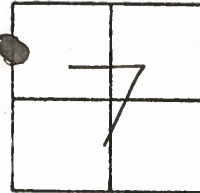


#1

P.I.
 $\Delta = 5^{\circ} - 48' \text{ LT.}$
 F.D. P.K. NAIL @ surface
 FITS π PIPES
 TO THE EAST
 S of R. 65
 2.1
 TO NE P. 12.0
 E of R. 12.1

USGS
 47 DAW
 663 1959

Not covered
 SW 69.82

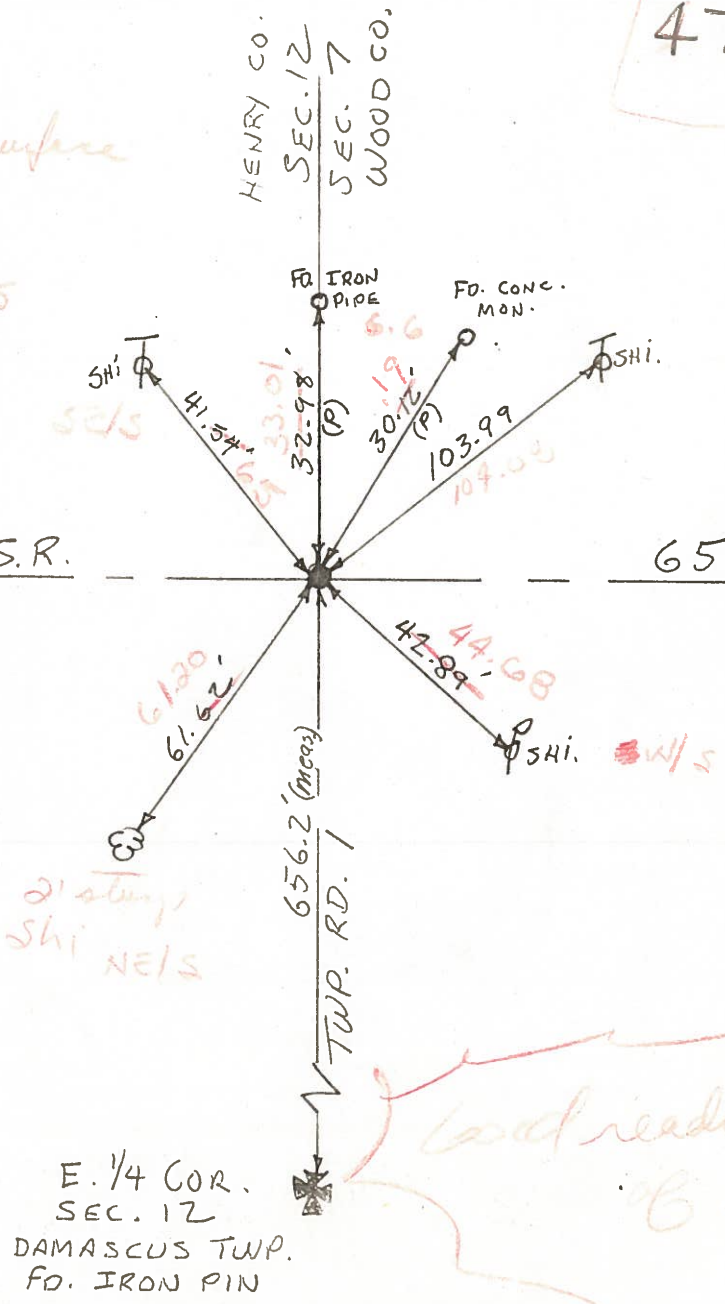

New station
 515
 104.38

load reading 2' NE
 of PK

County WOOD S.R. 65

Date 3-11-74

Township GRAND RAPIDS

Weather CLOUDY

Section 7

Temp. 35°


T5N, R9E

Personnel BURNSIDE

SMITH


BOWERS

MEAD

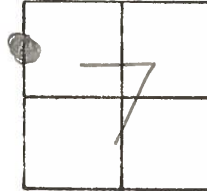

#1

P.I.
 $\Delta = 5^{\circ} - 48' \text{ LT.}$
FD. P.K. NAIL
FITS \varnothing PIPES
TO THE EAST

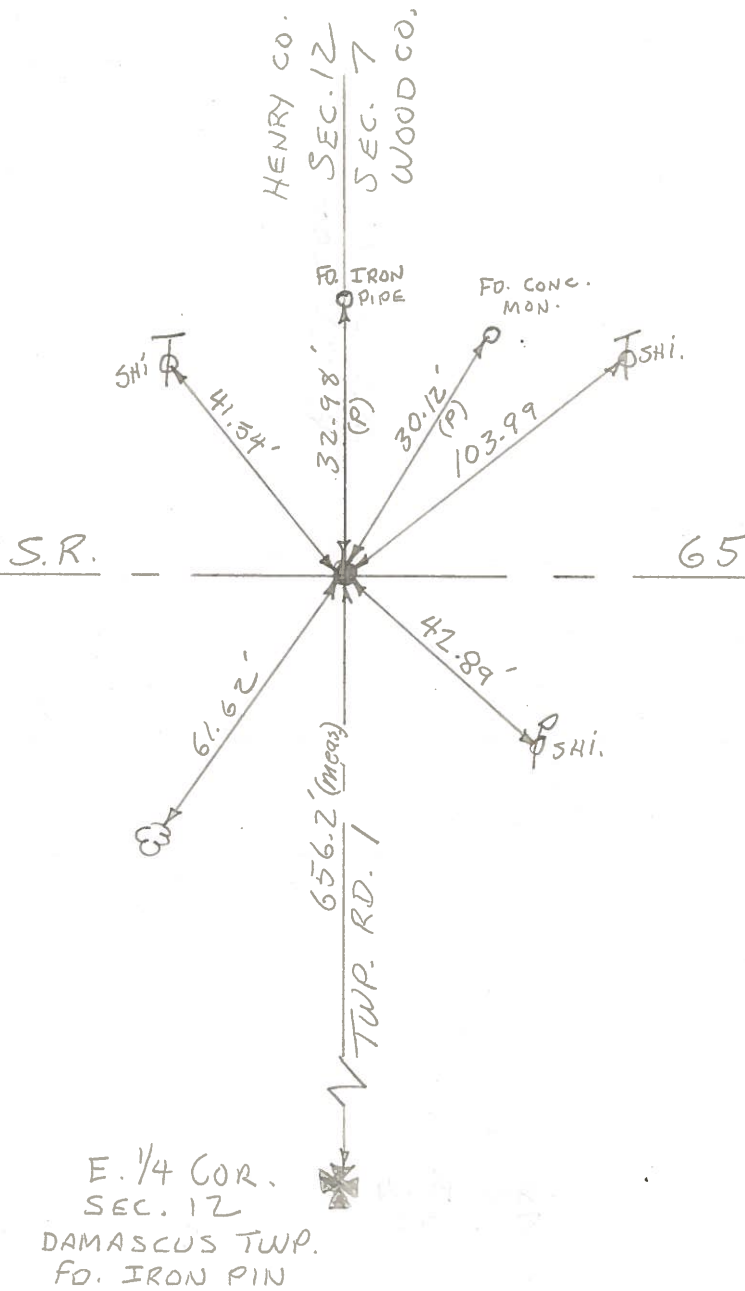

SEE NEW TIES

SHEET NO. 1

PERSONNEL BURNSIDE TITLE _____ PERSONNEL _____ TITLE _____ COUNTY Wood DATE 7-13-70

HOFFMAN _____ S. R. #65 WEATHER CLEAR

SEC. Co. Line E. To Kellogg Rd. TEMP. +85°

DESCRIPTION POINTS FOUND BEFORE RE-SURFACING JOB NO. _____

