

O.D.O.T. DISTRICT 2 SURVEY OFFICE (USE ONLY)

PERSONNEL

REFERENCE NO. 1 A

SHEET 2 OF 40

NOTES O'DONNELL

DATE 3/21/22

ROUTE SR 65

H.C. NIESE

WEATHER SUNNY

COUNTY WOOD

R.C. AUBLE

TEMP. 65°

TOWNSHIP GRAND RAPIDS

SECTION 7

DWG BY RHOADES

PID 95796

T 5 N R 9 E

TYPE MONUMENT 1" IPIN

ON SURFACE - ~~BELOW~~ ON

OFFSET Q PAVEMENT 11.5' ~~LT~~ : RT

7.7' TO RT EDGE PAVEMENT



STATION: 10+78.09

HORIZ.DATUM: NAD83 2011

GEOID: NAVD88 2018


GRID: NORTHING: 637935.915

EASTING: 1590159.766

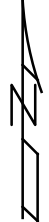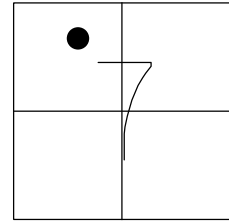

RECORD: P.I.  
 $\Delta = 14^\circ 34' \text{ LT}$   
 ORIGIN UNKNOWN  
 FD 1" IPIN  
 6/17/04, DCH  
 SET MAG/WASHER  
 9-20-04, RGN  
 FD MAG/WASHER  
 REFA1  
 5-26-20, JLL  
 10/28/20, JFO  
 SET MAG/WASHER  
 10/4/22, TDN

MARY JANE  
 THURSTON  
 STATE PARK

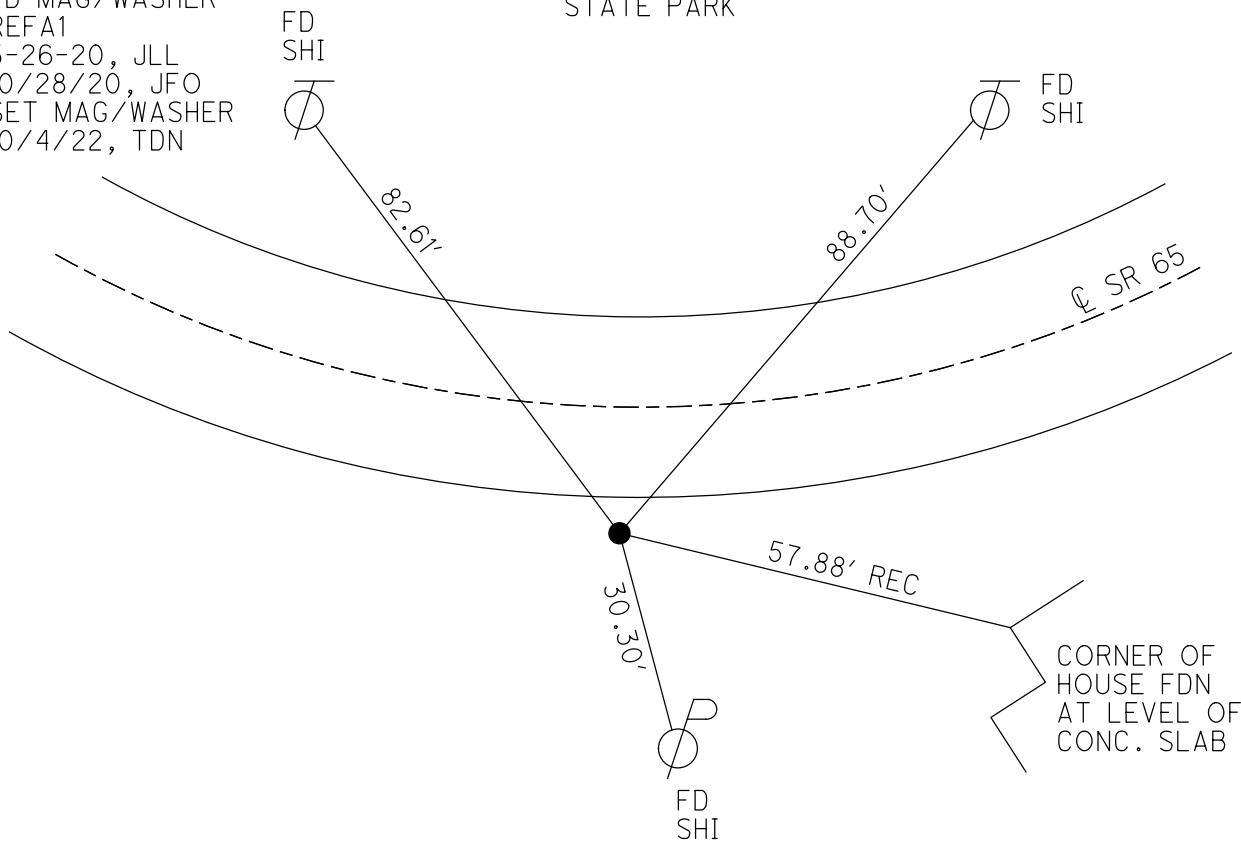

O.D.O.T. DISTRICT 2 SURVEY OFFICE (USE ONLY)

PERSONNEL

REFERENCE NO. 1 A

SHEET 2 OF 9

NOTES HUSS

DATE 6/17/04

ROUTE SR 65

H.C. HOMAN

WEATHER CLOUDY

COUNTY WOOD

R.C. ADKINS

TEMP. 70°

TOWNSHIP GRAND RAPIDS

DWG BY AUBLE

PID 109339

SECTION 7

T 5 N R 9 E

TYPE MONUMENT 1" IPIN

ON SURFACE - ~~BELOW~~ ON

OFFSET ☉ PAVEMENT 11.5' ~~LT~~ : RT

7.7' TO RT EDGE PAVEMENT


STATION: 10+80

HORIZ.DATUM: NAD83 2011

GEOID: 2012A


GRID: NORTHING: 637935.917

EASTING: 1590159.762

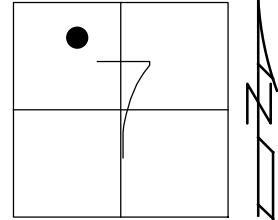

RECORD: P.I.  
 $\Delta = 14^\circ 34' \text{ LT}$   
 ORIGIN UNKNOWN  
 SET MAG/WASHER  
 9-20-04, RGD  
 FD MAG/WASHER  
 REFA1  
 5-26-20, JLL

MARY JANE  
 THURSTON  
 STATE PARK

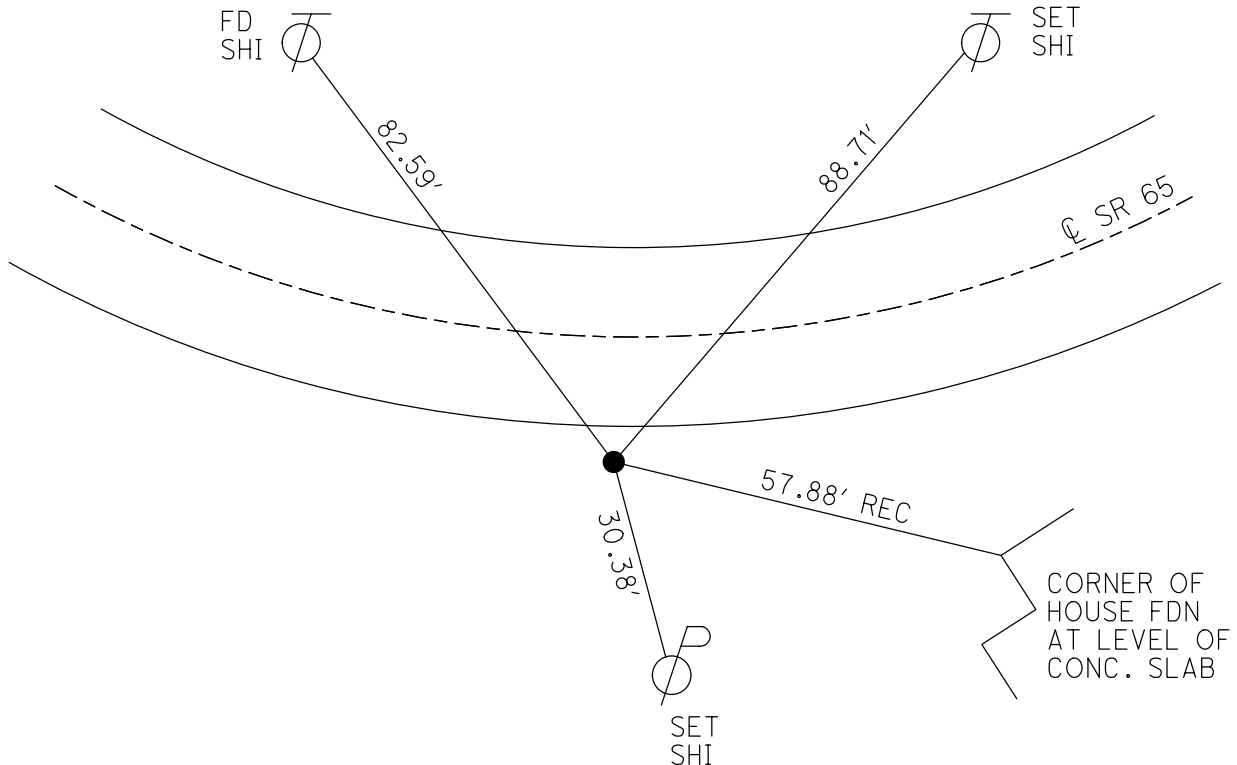

# O.D.O.T. DISTRICT 2 SURVEY OFFICE

PERSONNEL

REFERENCE NO. 1-A

SHEET 1 OF 49

NOTES Huss

H.C. Homan

R.C. Kyle Adkins

DATE 6-17-04

WEATHER Clky

TEMP. +70° F.

ROUTE S.R. 65

COUNTY Wood

TOWNSHIP Grand Rapids

SECTION 7

T5 N R 9 E


TYPE MONUMENT 1" iron rod

ON SURFACE - ~~BELOW~~ yes

~~LEFT~~ RIGHT 11.5'

1.7 TO Rt. EDGE PAVEMENT


S.L.M. 10 + 80

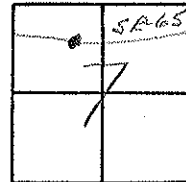

Record: P.I.  
 $\Delta = 14^\circ 34' \text{ LT.}$   
 Origin Unknown

Set Mag/Wash.  
 9-20-04  
 RLD

Mary Jane Thurston  
State Park

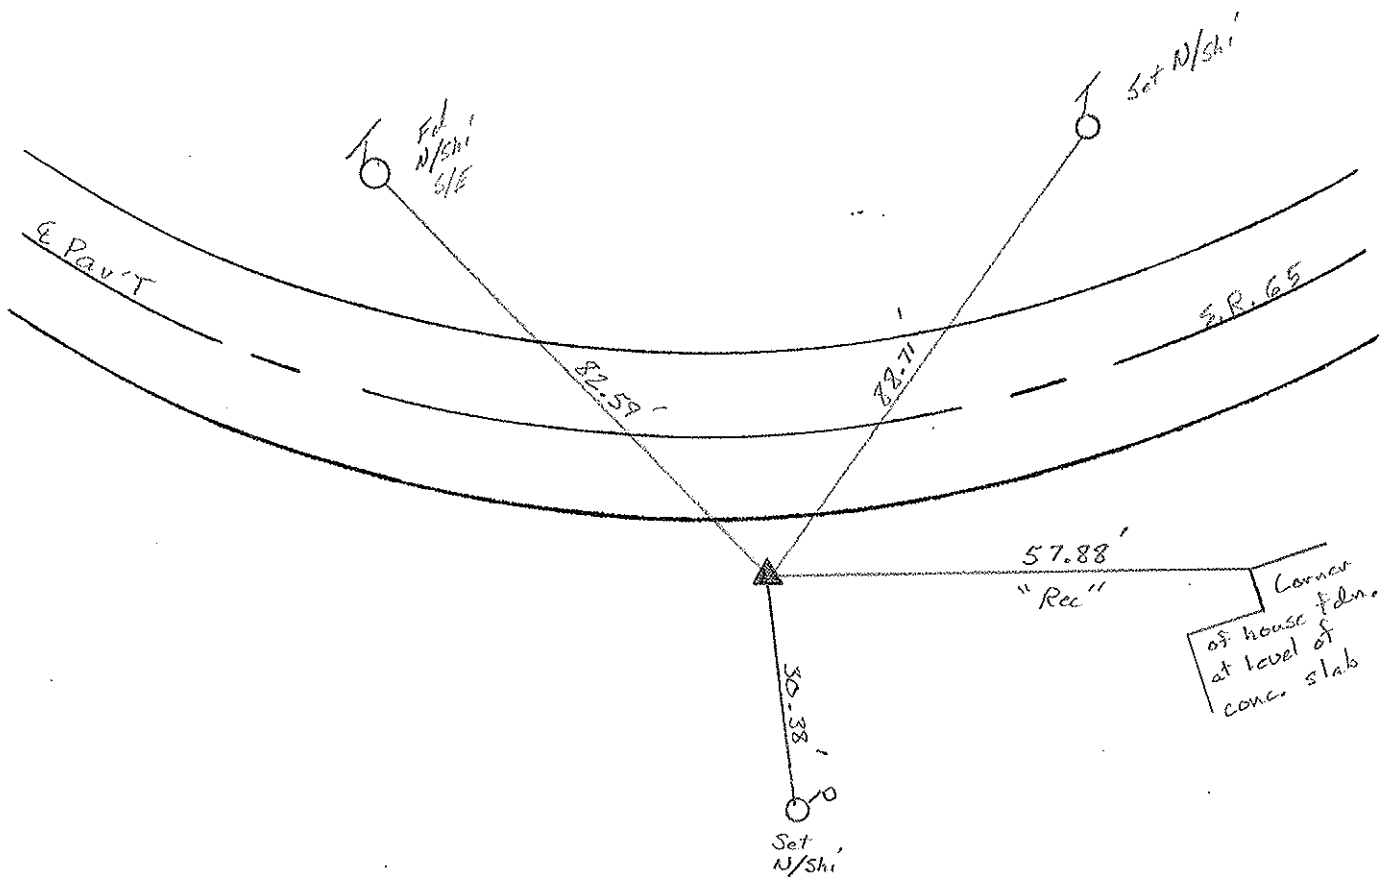

Resurface 2004

O.D.O.T. DISTRICT 2 SURVEY OFFICE

PERSONNEL

REFERENCE NO. 1-A

SHEET 2 OF 3

NOTES VAN DUSEN

H.C. BARNHISEL

R.C. \_\_\_\_\_

DATE 4-20-92

WEATHER Cloudy

TEMP. +70° F

ROUTE SR 65

COUNTY WOOD

TOWNSHIP GRAND RAPIDS

SECTION 7

T 5 N 9 E


TYPE MONUMENT 1" IRON ROD

ON SURFACE - BELOW YES

LEFT - & PAV'T. - RIGHT 12.5


3.0' TO RT. EDGE PAVEMENT

S.L.M. PROJECT STA. 10+80

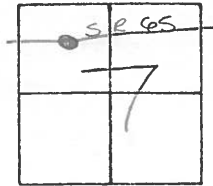

RECORD: P.I.  
 $\Delta = 14^{\circ} 34' \text{ LT.}$   
 ORIGIN UNKNOWN

MARY JANE THURSTON  
 STATE PARK

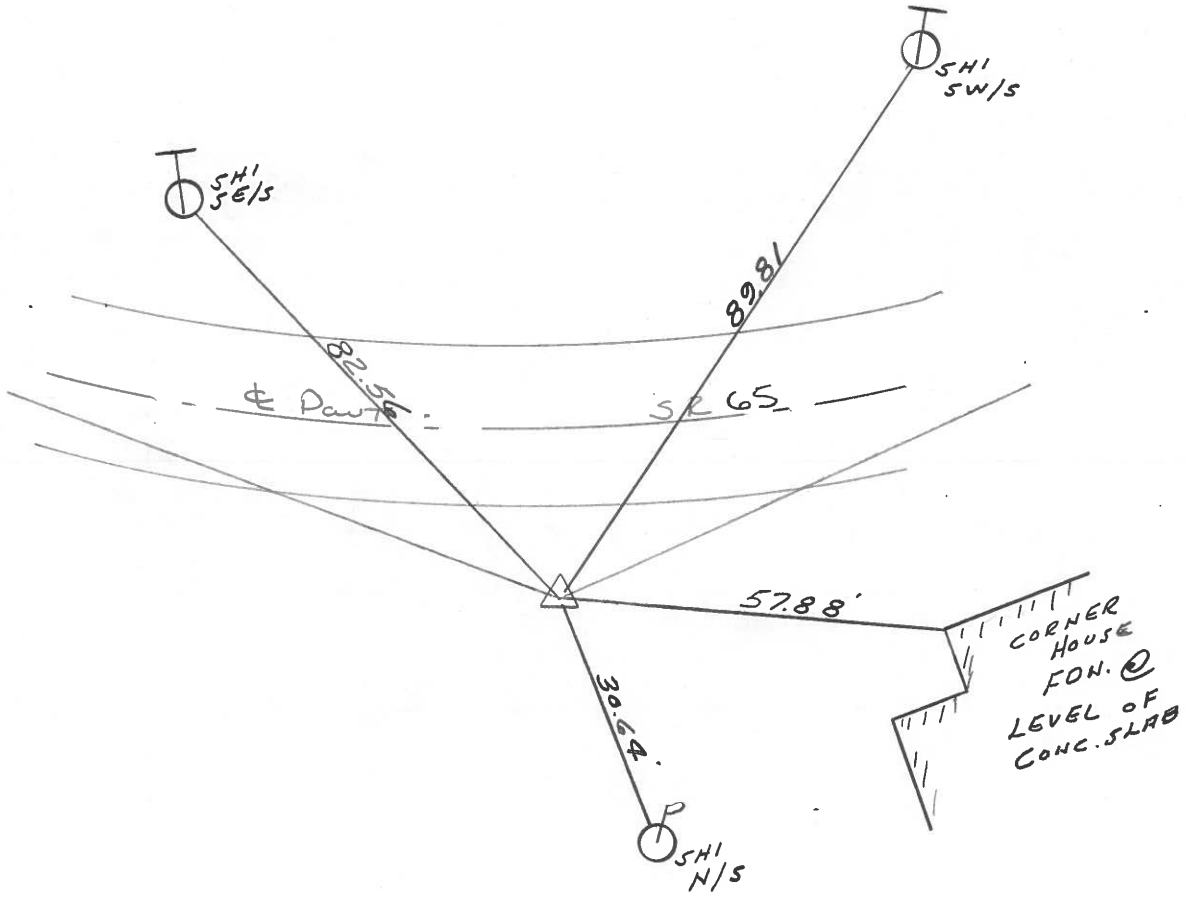

County Wood S.R. 65

Date 12-3-81

Township Grand Rapids

Weather Partly Sunny

Section 7

Temp. +35°

T5N, R9E

Personnel Hoffman

Loehrke

Householder

\_\_\_\_\_

\_\_\_\_\_


\_\_\_\_\_

\_\_\_\_\_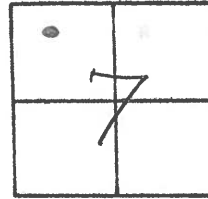

# 1-A


Fd 1" IRON ROD @ SURFACE

project sta ± 10 + 80

12' S. of & PAUT S.R. 65

3' S. of S.F.P. S.R. 65

MARY LANE THURSTON STATE PARK

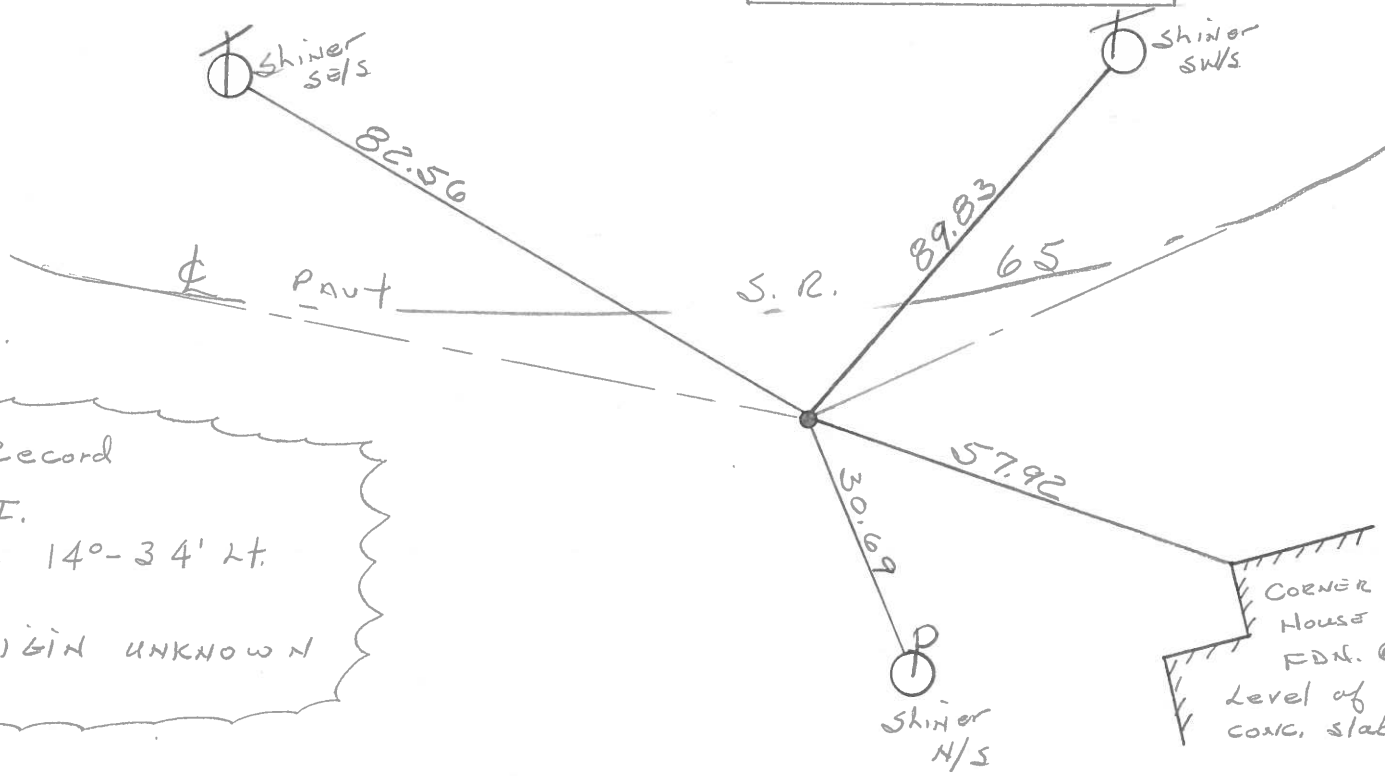

Record

P.I.

Δ = 14° - 34' Lt.

ORIGIN UNKNOWN

O.D.O.T. DISTRICT 2 SURVEY OFFICE

SHEET \_\_\_\_\_ OF \_\_\_\_\_

County WOOD S.R. 65

Date 3-14-74

Township GRAND RAPIDS


Weather CLEAR

Section 7

Temp. 29°

T5N, R9E

Personnel BURNSIDE

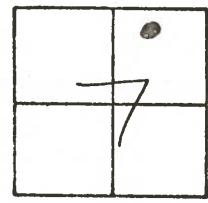


#1-A

Project sta

5 of L12  
5 of EP 3  
0.3'

located 6-9-82  
painted arrow  
on S.E.P.

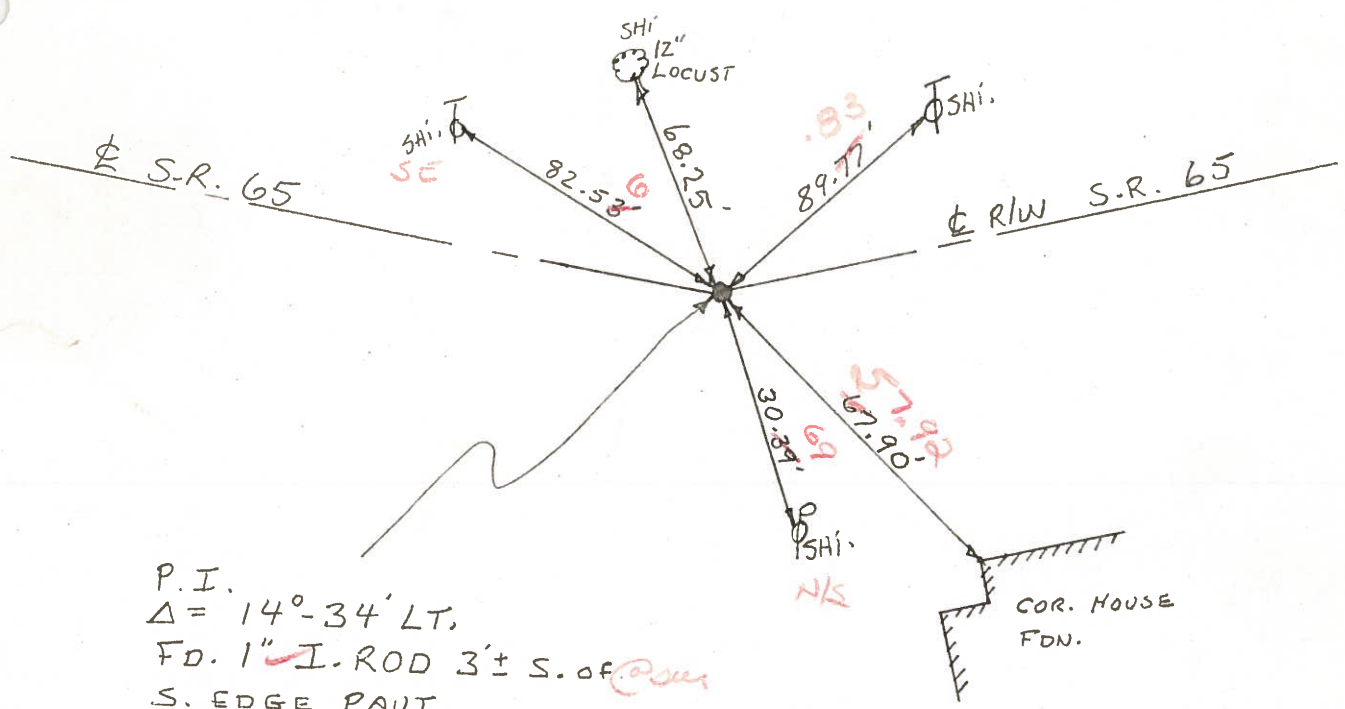

P.I.  
Δ = 14°-34' LT.  
FD. 1" I. ROD 3' ± S. of  
S. EDGE PAUT.  
(ORIGIN UNKNOWN)

ODOT DISTRICT 2 SURVEY OFFICE

SHEET OF

County WOOD S.R. 65

Date 3-14-74

Township GRAND RAPIDS

Weather CLEAR

Section 7

Temp. 29°


T5N, R9E

Personnel BURNSIDE


SMITH

BOWERS

MEAD

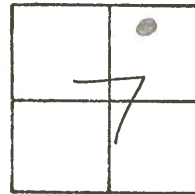

#1-A

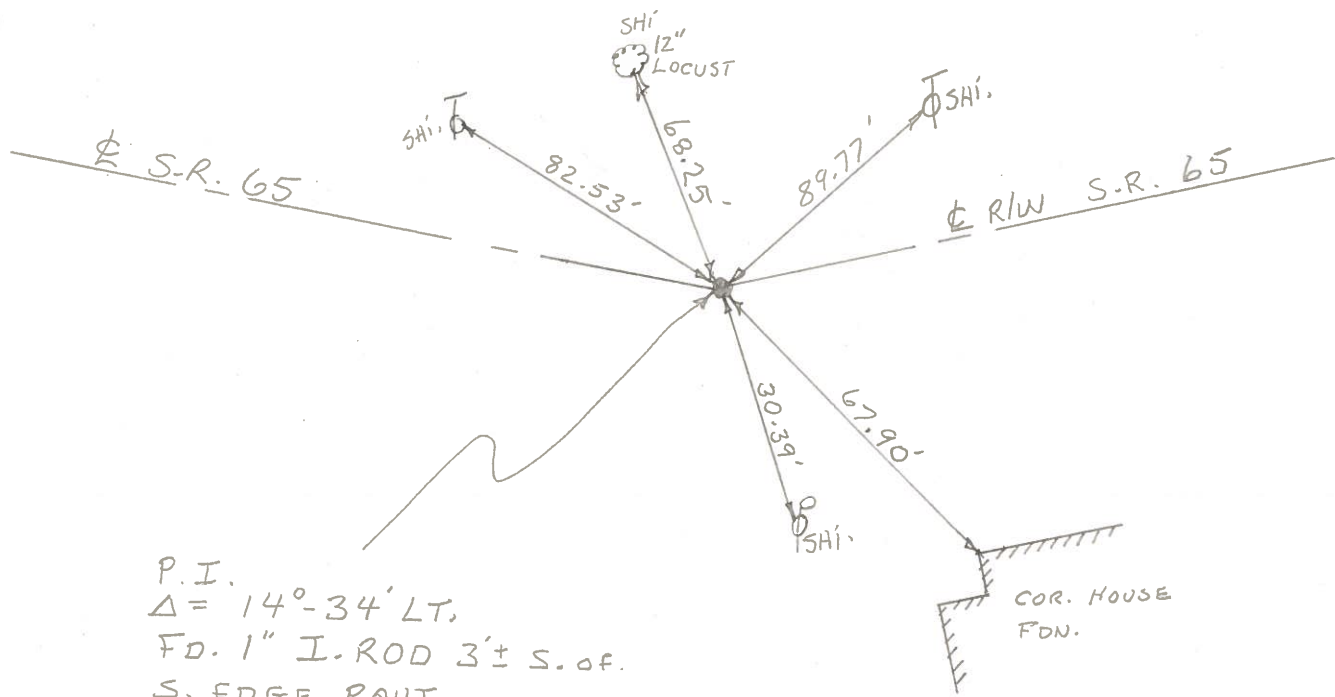


P.I.  
 $\Delta = 14^{\circ} - 34' \text{ LT.}$   
FD. 1" I-ROD 3'± S. OF.  
S. EDGE PAUT.  
(ORIGIN UNKNOWN)

PERSONNEL	TITLE	PERSONNEL	TITLE
BURNSIDE			
SMITH			
BOWERS			

COUNTY Wood DATE 9-27-72  
 S. R. 65 WEATHER Cloudy  
 SEC. GRAND RAPIDS TWP TEMP. +63°

DESCRIPTION ESTABLISH P.I. JOB NO. \_\_\_\_\_

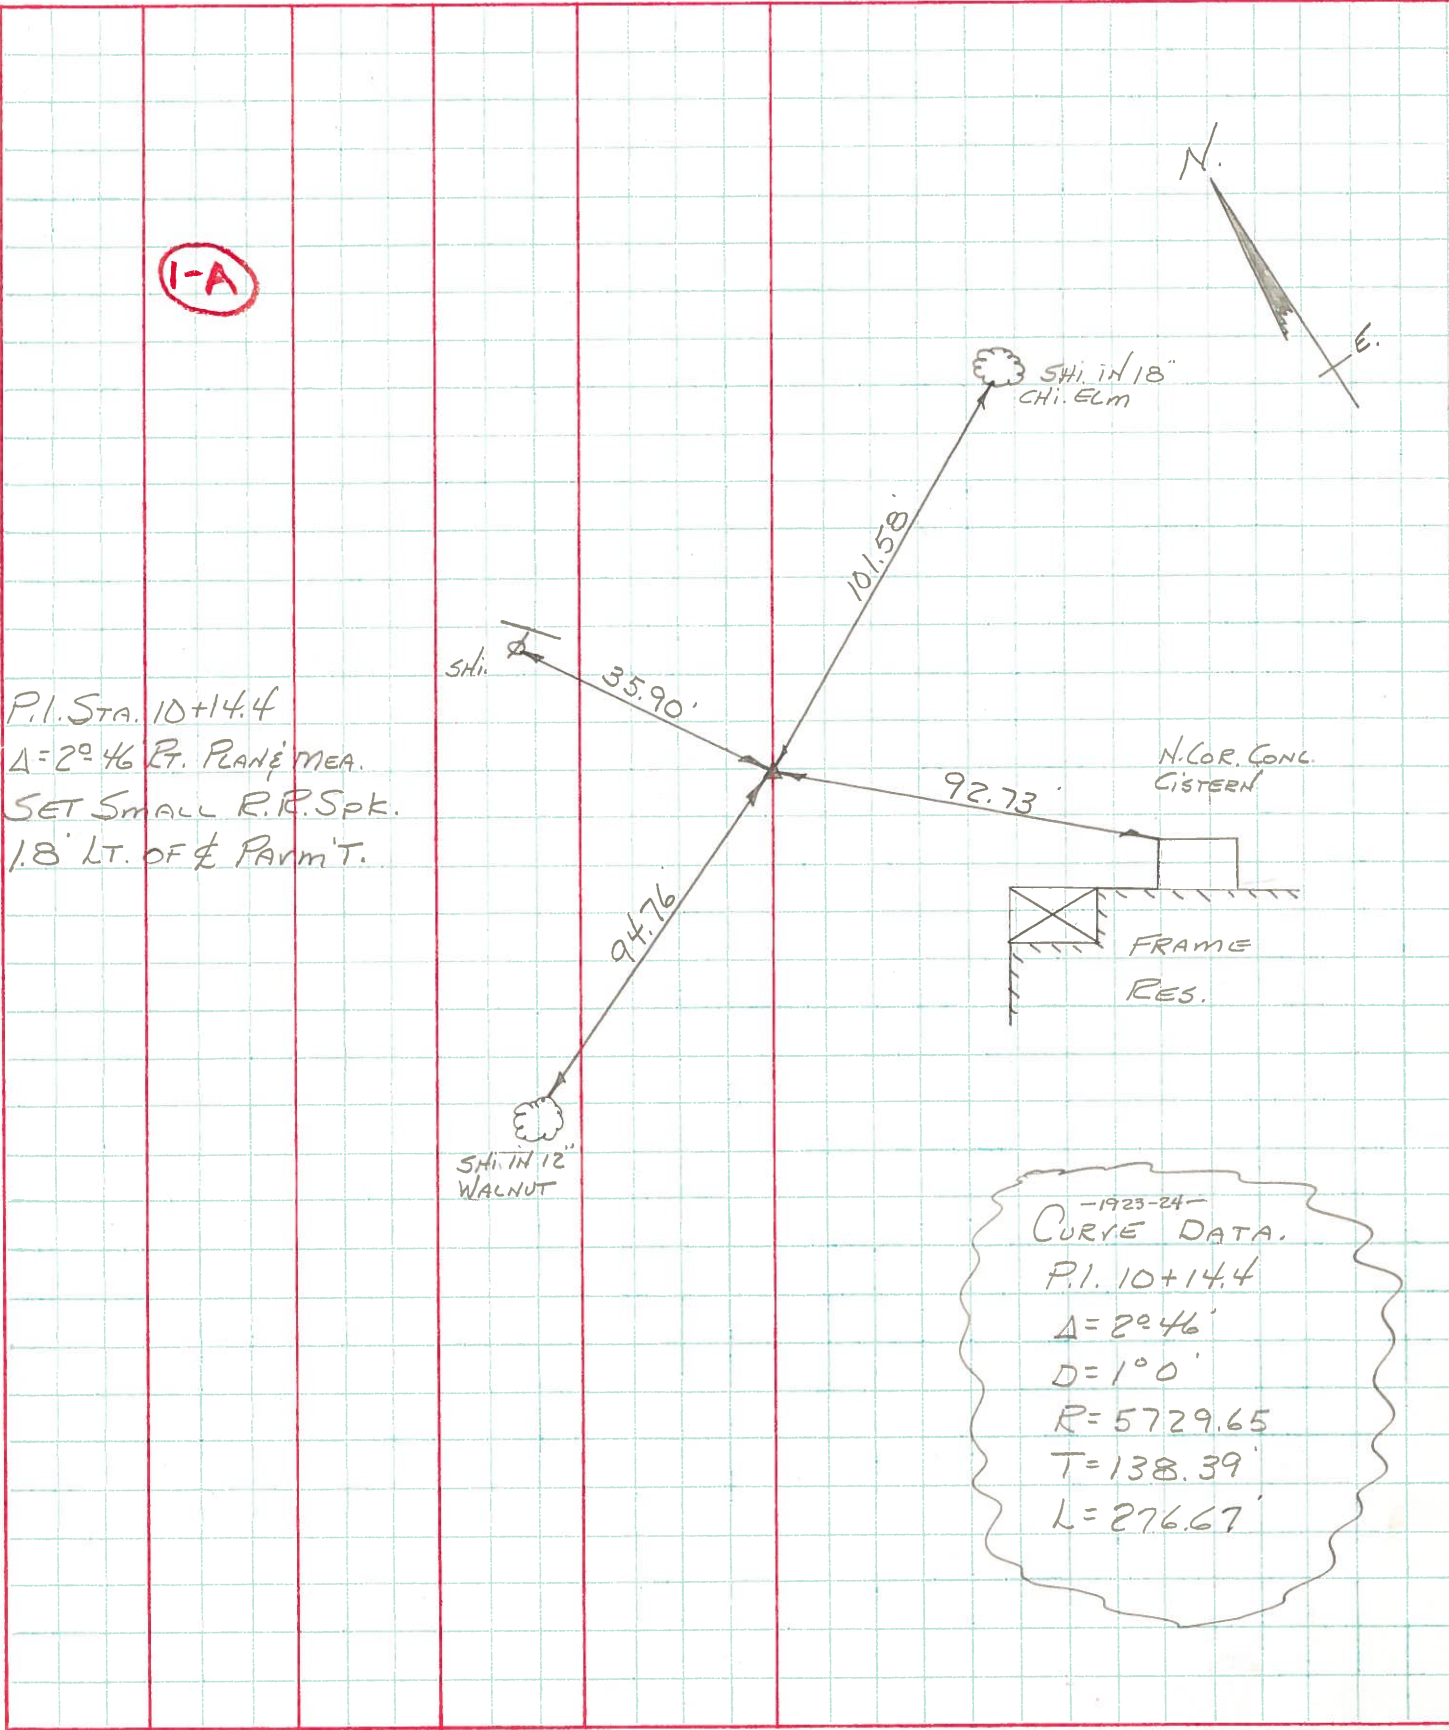


P.I. STA. 10+14.4  
 $\Delta = 2^\circ 46'$  RT. PLANE MEAS.  
 SET SMALL R.R. SPK.  
 1.8' LT. OF  $\frac{1}{2}$  PAVM'T.

-1923-24-  
 CURVE DATA.  
 P.I. 10+14.4  
 $\Delta = 2^\circ 46'$   
 $D = 1^\circ 0'$   
 $R = 5729.65$   
 $T = 138.39'$   
 $L = 276.67'$



PERSONNEL	TITLE	PERSONNEL	TITLE	COUNTY	WOOD	DATE	7-13-70
BURNSIDE				S. R.	#65	WEATHER	CLEAR
HOFFMAN				SEC.	Co. LINE E. TO KELLOGG RD.	TEMP.	+85°

DESCRIPTION POINTS FOUND BEFORE RE-SURFACING JOB NO. \_\_\_\_\_

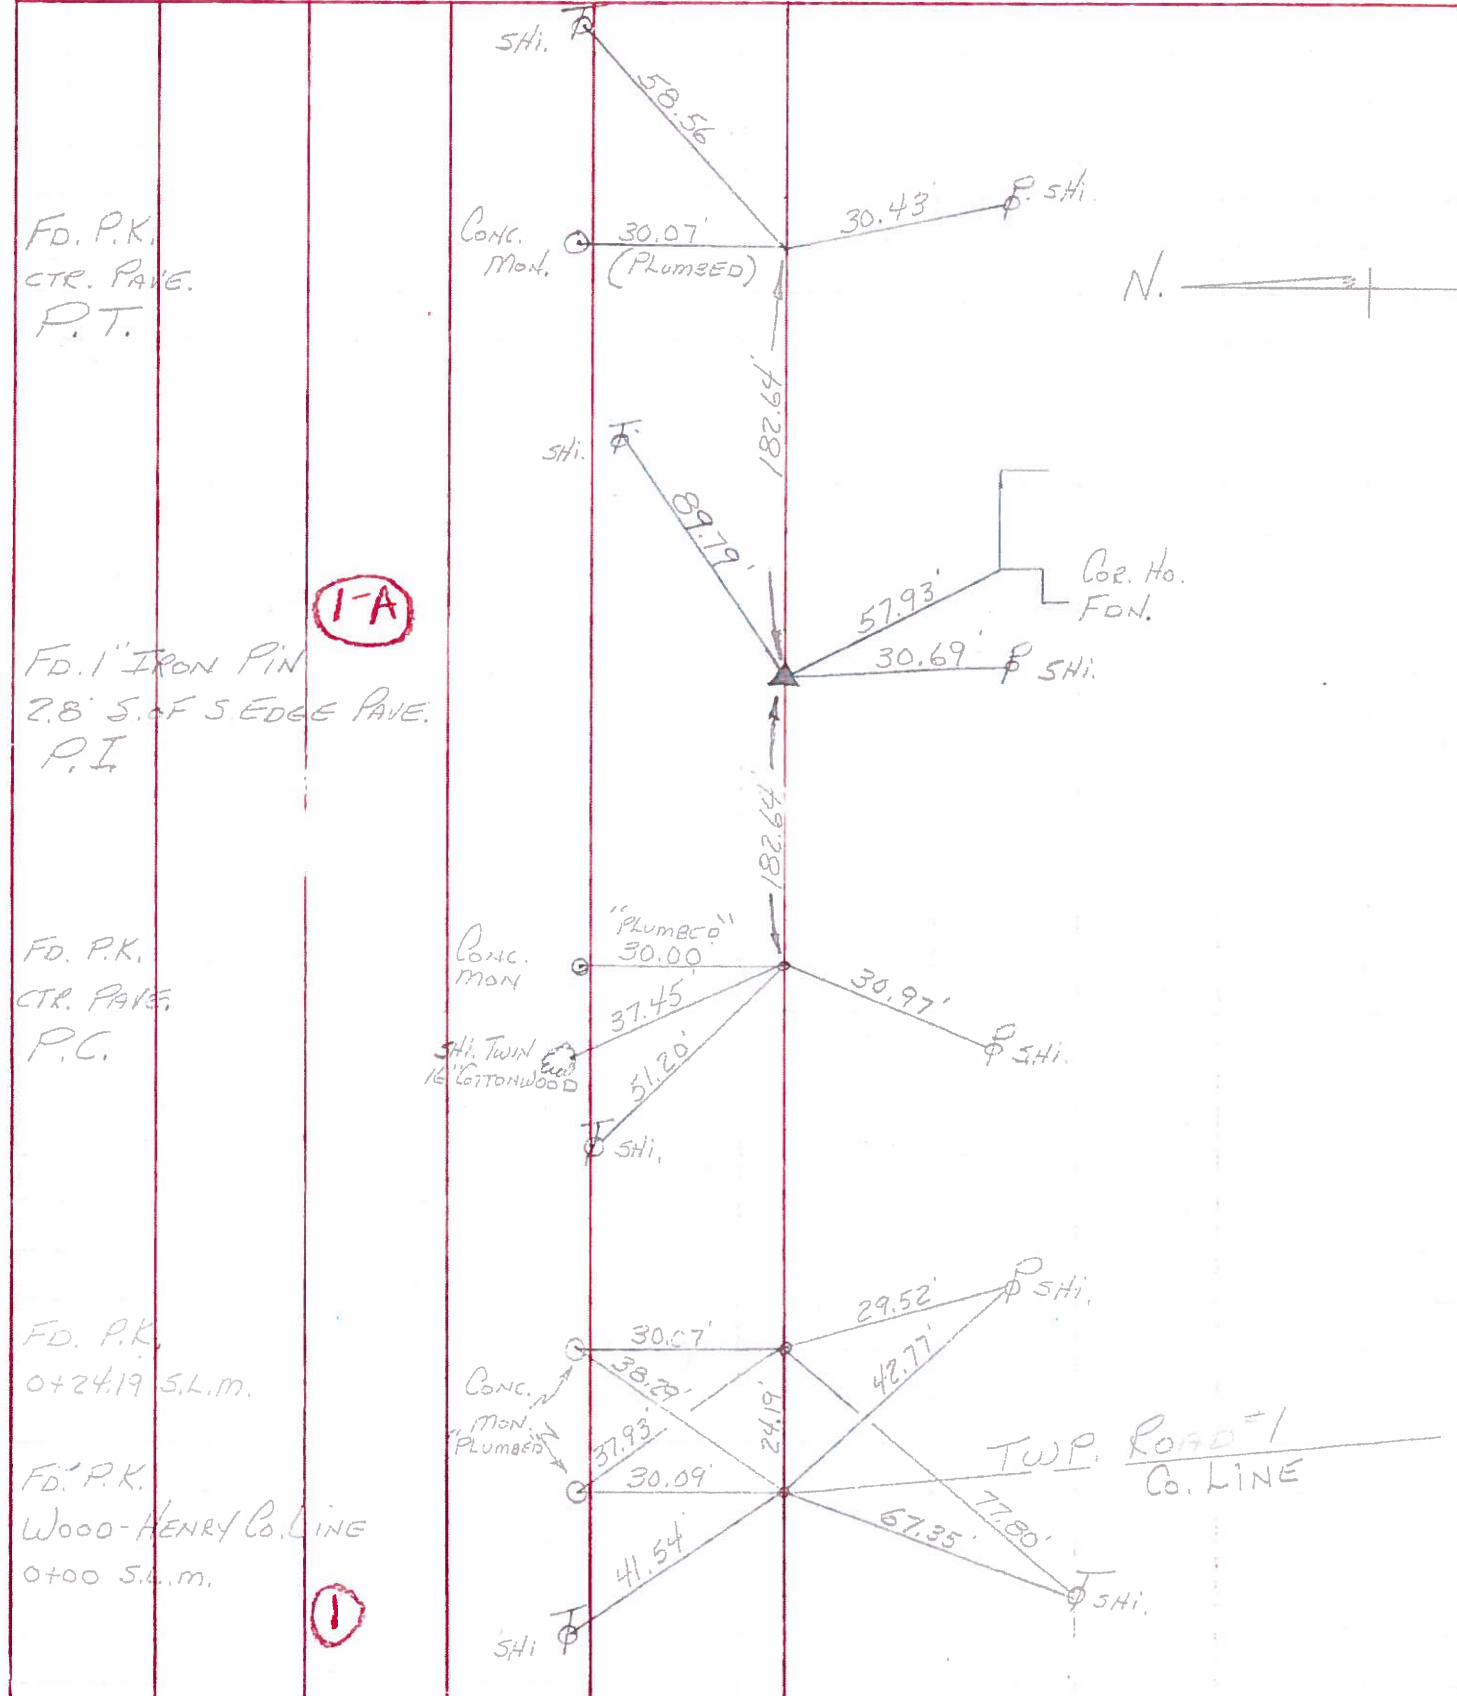

FD. P.K.  
CTR. PAVE.  
P.T.

1-A

FD. 1" IRON PIN  
2.8' S. OF S. EDGE PAVE.  
P.I.

FD. P.K.  
CTR. PAVE.  
P.C.

FD. P.K.  
0+24.19 S.L.M.

FD. P.K.  
WOOD-HENRY Co. LINE  
0+00 S.L.M.

1