

O.D.O.T. DISTRICT 2 SURVEY OFFICE (USE ONLY)

PERSONNEL

REFERENCE NO. 1 BC

SHEET 4 OF 40

NOTES O'DONNELL

DATE 3/21/22

ROUTE SR 65

H.C. NIESE

WEATHER SUNNY

COUNTY WOOD

R.C. AUBLE

TEMP. 65°

TOWNSHIP GRAND RAPIDS

DWG BY RHOADES

PID 95796

SECTION 7

T 5 N R 9 E

TYPE MONUMENT MAG/WASHER

ON SURFACE - ~~BELOW~~ ON

OFFSET \odot PAVEMENT 2.0' ~~LT~~ : RT

8' TO RT EDGE PAVEMENT


STATION: 23+27.55

HORZ. DATUM: NAD83 (2011)

GEOID: NAVD88 2018

GRID: NORTHING: 638080.295


EASTING: 1591400.662

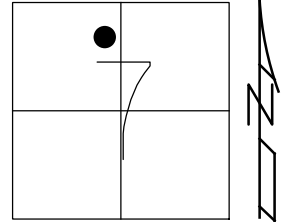

RECORD:
 ORIGIN UNKNOWN
 SET P.K./WASHER
 4-20-92, BVD
 FD P.K./WASHER
 6/17/04, DCH
 SET MAG/WASHER
 9-16-04, SAH
 FD MAG/WASHER
 REFB1
 5-26-20, JLL
 REFBC1
 10/28/20, JFO
 SET MAG/WASHER
 10/4/22, TDN

MARY JANE
 THURSTON
 STATE PARK

SET SHI
 24"

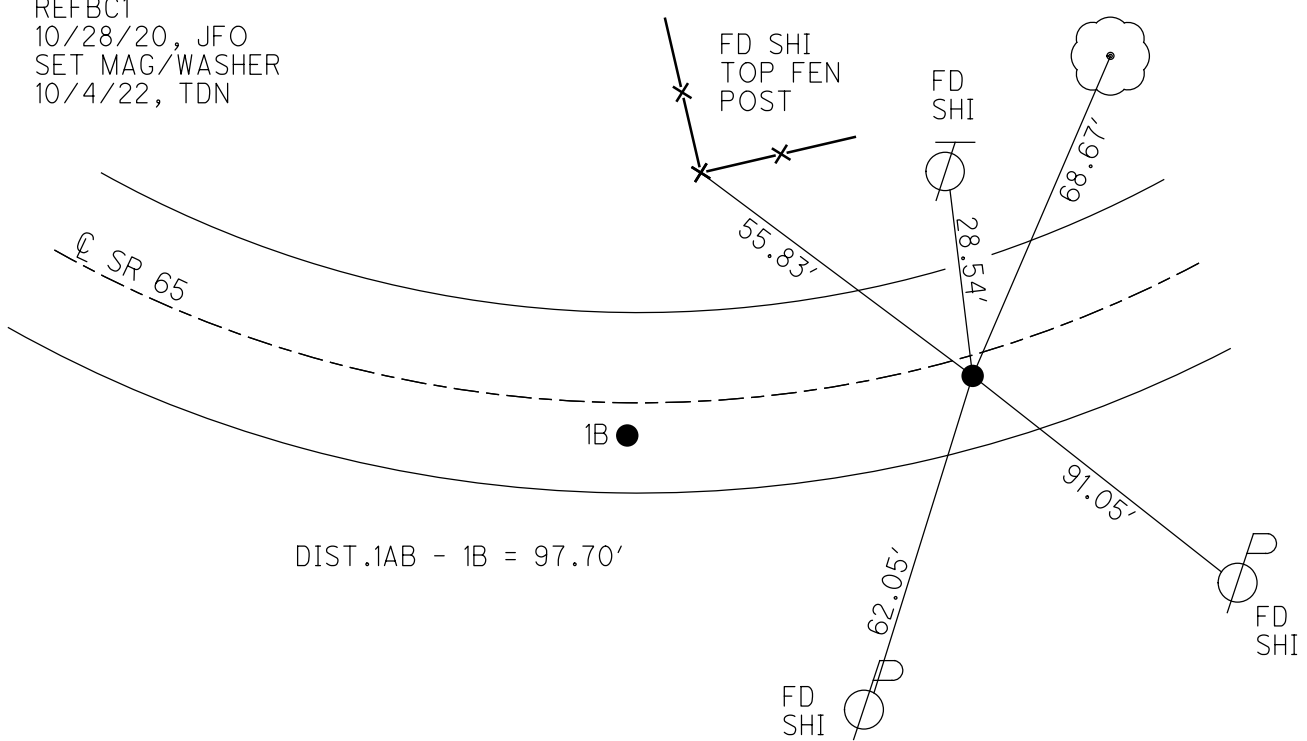

O.D.O.T. DISTRICT 2 SURVEY OFFICE (USE ONLY)

PERSONNEL

REFERENCE NO. 1 B

SHEET 4 OF 9

NOTES HUSS

DATE 6/17/04

ROUTE SR 65

H.C. HOMAN

WEATHER CLOUDY

COUNTY WOOD

R.C. ADKINS

TEMP. 78°

TOWNSHIP GRAND RAPIDS

DWG BY AUBLE

PID 109339

SECTION 7

T 5 N R 9 E

TYPE MONUMENT P.K./WASHER

ON SURFACE - ~~BELOW~~ ON

OFFSET 2.0' RT : RT

8' TO RT EDGE PAVEMENT


STATION: 23+30.7

HORIZ.DATUM: NAD83 (2011)

GEOID: 2012A


GRID: NORTHING: 638080.353

EASTING: 1591400.714

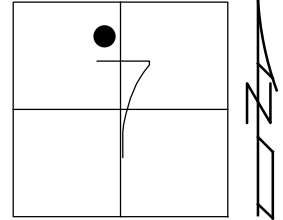

RECORD:
 ORIGIN UNKNOWN
 SET P.K./WASHER
 4-20-92, BVD
 SET MAG/WASHER
 9-16-04, SAH
 FD MAG/WASHER
 REFB1
 5-26-20, JLL

MARY JANE THURSTON PARK

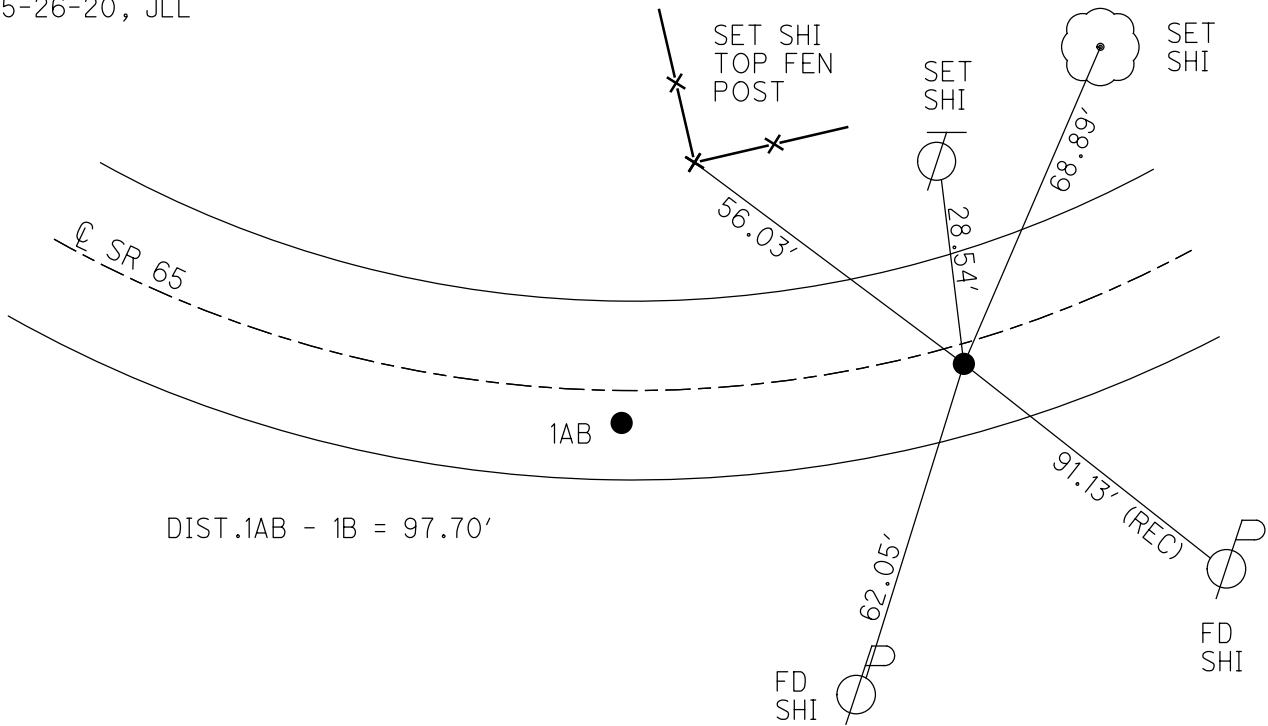

O.D.O.T. DISTRICT 2 SURVEY OFFICE

PERSONNEL

REFERENCE NO. 1-B
PT. A

SHEET 2 OF 49

NOTES Huss

H.C. Duane

R.C. Kyle

DATE 6-17-04

WEATHER Clay

TEMP. +78° F.

ROUTE S.R. 65

COUNTY Wood

TOWNSHIP Grand Rapids

SECTION 7

T. 5 N. R. 9 E


TYPE MONUMENT PK/Wash.

ON SURFACE - ~~BELOW~~ Both (A) + (B)

~~LEFT~~ - RIGHT (A) - 2.6' (B) - 2.0'

(A) 7.5' TO RT. EDGE PAVEMENT (B) 8' TO RT. EOP

S.L.M. Pt (A) 22131

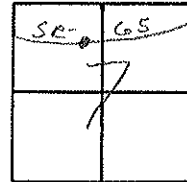


Record: P.T.
 $\Delta = 8^{\circ} 44' \text{ LT.}$

Record: Point B
origin unknown

Mary Jane Thurston
State Park

Set PK/washer
4-20-92
BVD

Set Mark/wash
9-16-04,
Both Points
SAH

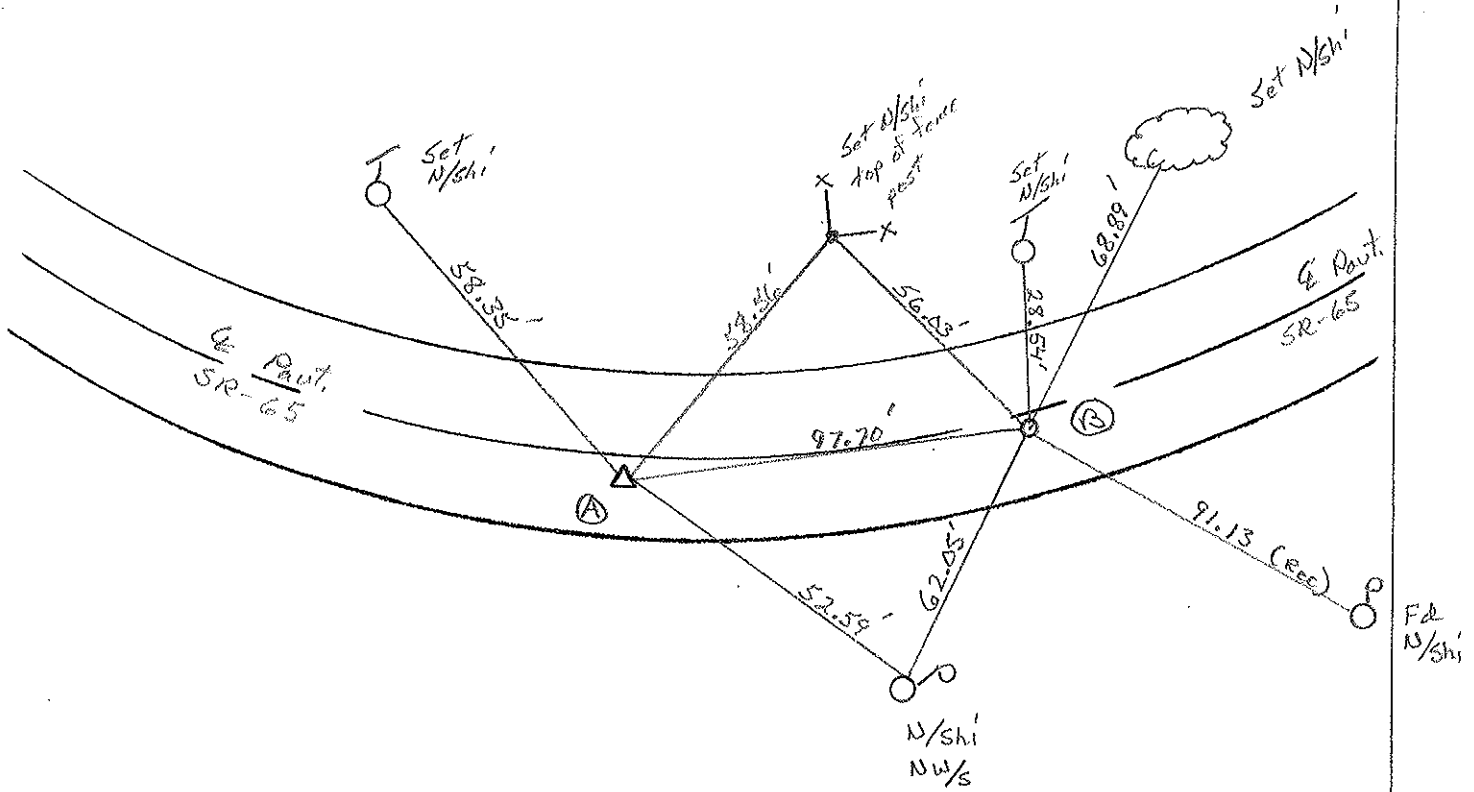

O.D.O.T. DISTRICT 2 SURVEY OFFICE

PERSONNEL _____

REFERENCE NO. 1-B
PT. A

SHEET 3 OF 3

NOTES VAN DUSEN

H.C. BARNHISEL

R.C. _____

DATE 4-20-92

WEATHER CLOUDY

TEMP. +70° F

ROUTE SR 65

COUNTY WOOD

TOWNSHIP GRAND RAPIDS

SECTION 7

T.S. N R 9 E


TYPE MONUMENT PK&WASHER

ON SURFACE - BELOW YES A"

~~LEFT~~ - PAV'T. - RIGHT 2.5 A"

TO _____ EDGE PAVEMENT

S.L.M. PT. A PROJECT STA. ± 22+31

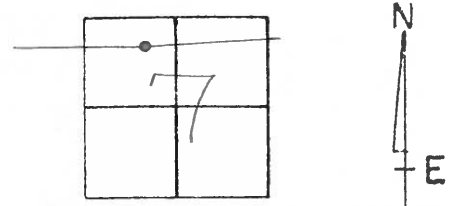


RECORD : P.I.

$\Delta = 8^{\circ} - 44' \text{ LT.}$

PT. A PROJECT STA. ± 22+31
PT. A $\Delta = 8^{\circ} - 44' \text{ LT. - RECORD}$
PT. B & C ORIGIN UNKNOWN

SET PK&WASHER
4-20-92
BVD

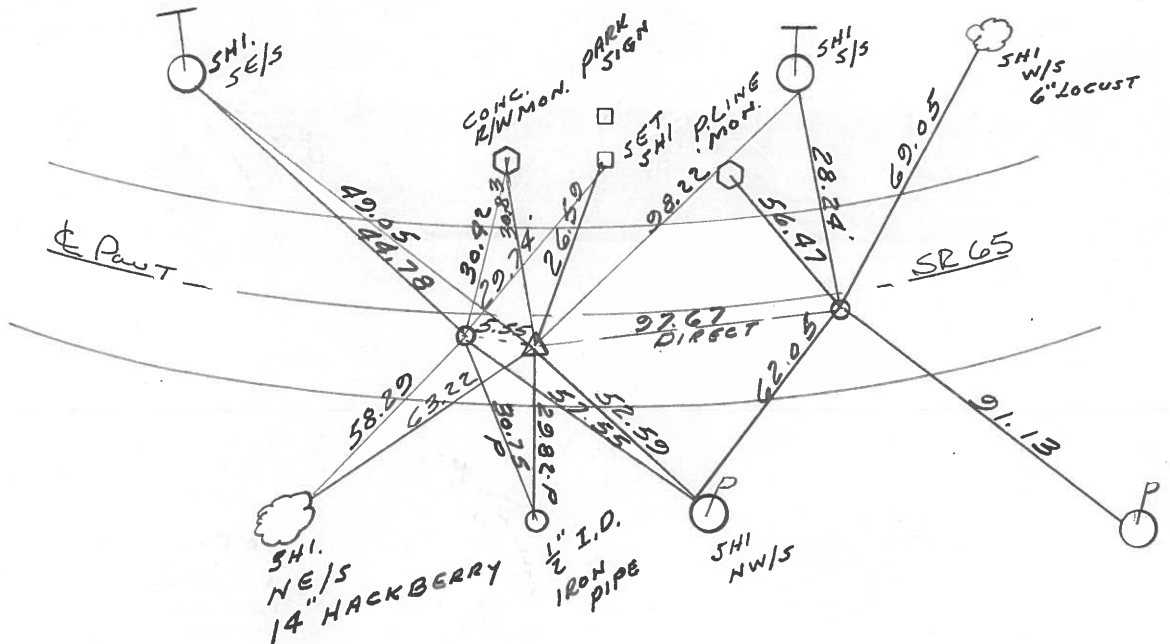

O.D.O.T. DISTRICT 2 SURVEY OFFICE

SHEET 3 OF

County Wood S.R. 65

Date OK-6-9-82
12-3-81

Township Grand Rapids


Weather Clear

Section 7

Temp. +40°

T5N, R9E

Personnel Hoffman

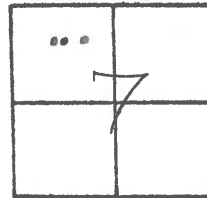

1-13
(Pt. "A")

Pt. "A" Fd. small R.R. SPK @ SURFACE
2.5' S. of & PAVT S.R. 65


Pt. "A" Protect STA ± 22+31

Pt. "B" Fd. P.K. Nail @ SURFACE
2.3' S. of & PAVT S.R. 65

Pt. "A" Δ = 8° - 44' Lt. - Record

Pt. "C" Fd. P.K. Nail @ SURFACE
2.0' S. of & PAVT S.R. 65

Pt. "B" & "C" origin UNKNOWN

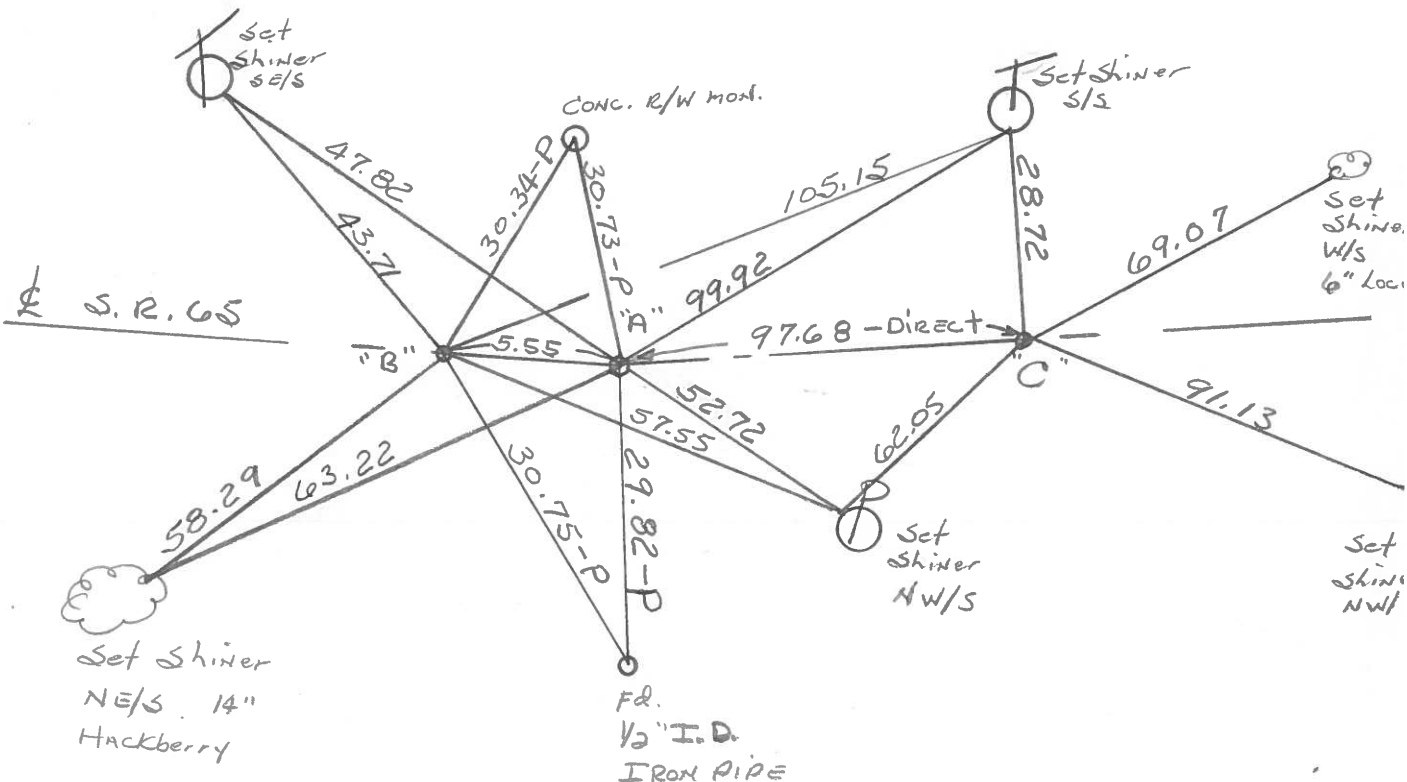

O.D.O.T. DISTRICT 2 SURVEY OFFICE

SHEET _____ OF _____

County WOOD S.R. 65

Date 3-14-74

Township GRAND RAPIDS

Weather CLEAR

Section 7

Temp. 29°


T5N, R9E

Personnel BURNSIDE

SMITH

BOWERS


MEAD

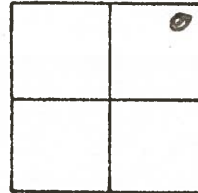

1-B 97.68 btw

P.I. 22+31
 $\Delta = 8^{\circ}-44'$ LT.
 SET SMALL R.R. SPK.
 2.5' ± RT. & PAUT.

BTW 555
 TO SEP 66
 PK 68.87
 2.36

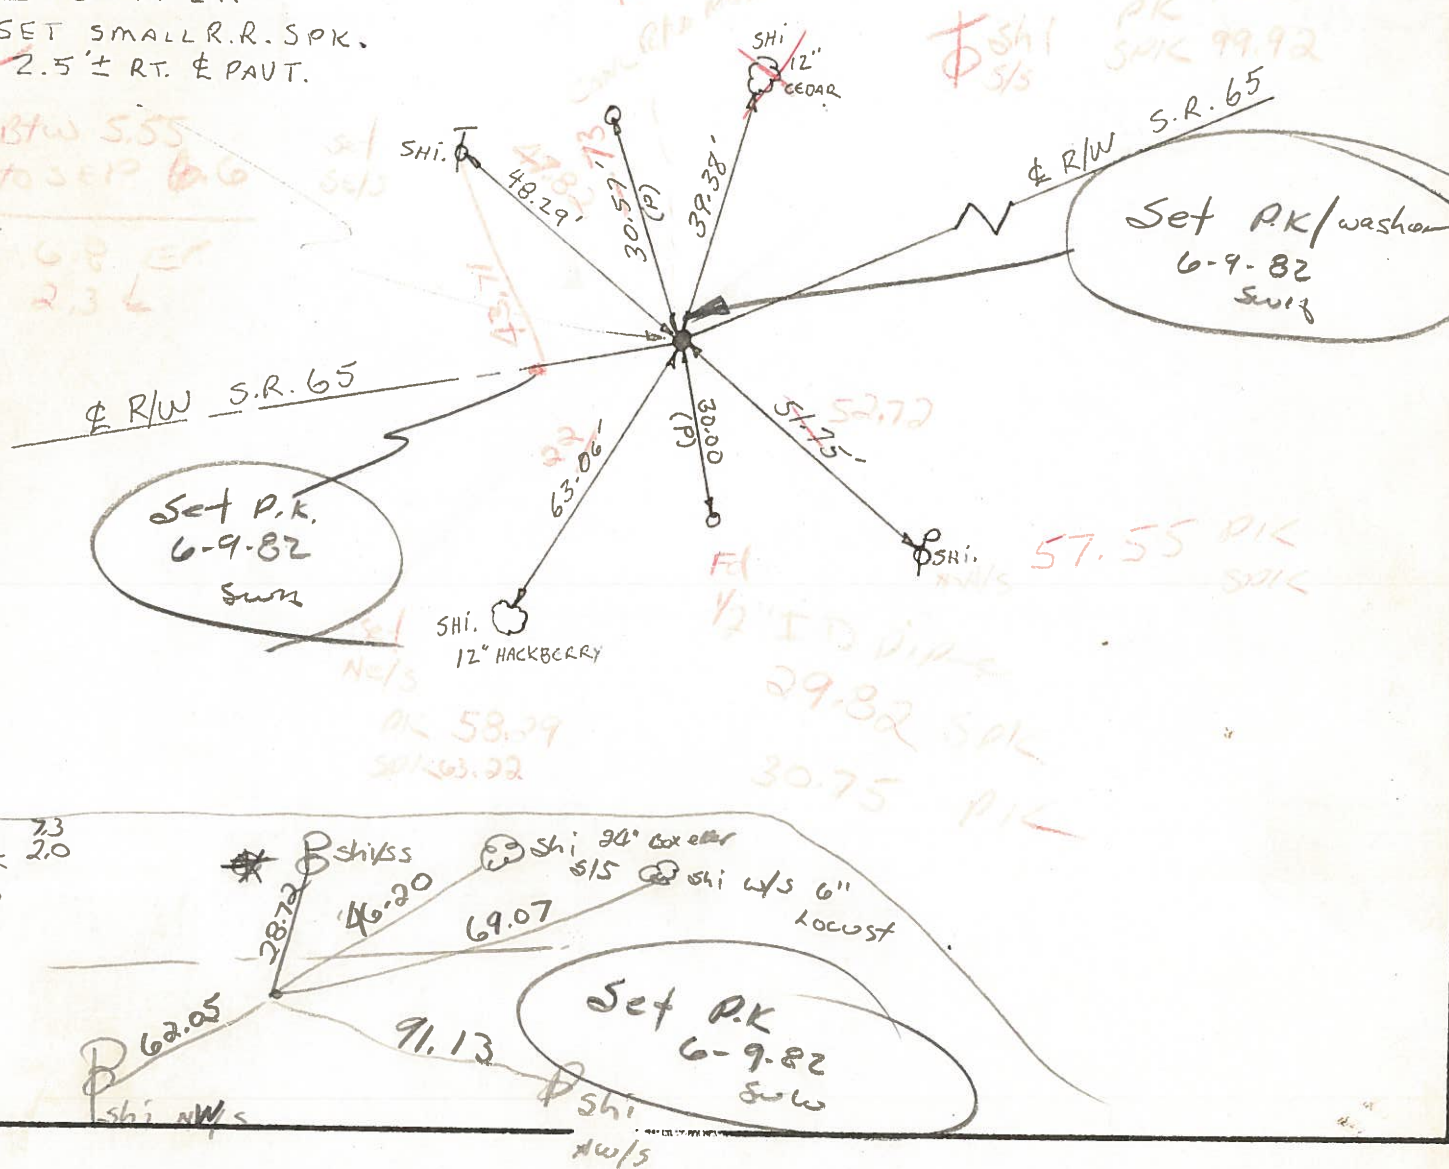


Set PK/washer
 6-9-82
 SWL

Set P.K.
 6-9-82
 SWL

Set P.K.
 6-9-82
 SWL

SEP 73
 SWL 2.0
 23+27

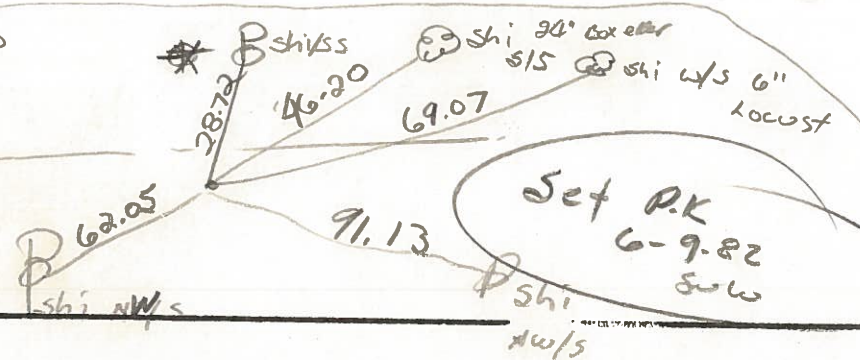

O.D.O.T. DISTRICT 2 SURVEY OFFICE

SHEET _____ OF _____

County WOOD S.R. 65

Date 3-14-74

Township GRAND RAPIDS

Weather CLEAR

Section 7

Temp. 29°


T5N, R9E

Personnel BURNSIDE

SMITH

BOWERS

MEAD

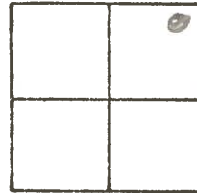

1-13

P.I.
 $\Delta = 8^{\circ} - 44' \text{ LT.}$
SET SMALL R.R. SPK.
2.5' \pm RT. $\&$ PAVT.

