

O.D.O.T. DISTRICT 2 SURVEY OFFICE (USE ONLY)

PERSONNEL

REFERENCE NO. 1C

SHEET 5 OF 40

NOTES RHOADES
 H.C. NIESE
 R.C. KETNER, AUBLE
O'DONNELL

DATE 3/29/22
 WEATHER CLEAR
 TEMP. 27°

ROUTE SR 65
 COUNTY WOOD
 TOWNSHIP GRAND RAPIDS
 SECTION 7
 T 5 N R 9 E

DWG BY RHOADES PID 95796

TYPE MONUMENT MAG/WASHER

ON SURFACE - ~~BELOW~~ ON

OFFSET Q PAVEMENT 4.4' LT : ~~RT~~

5' TO LT EDGE PAVEMENT


STATION: 26+22.89

HORZ.DATUM: NAD83 2011


GEOID: NAVD88 2018

GRID: NORTHING: 638163.240

EASTING: 1591684.311

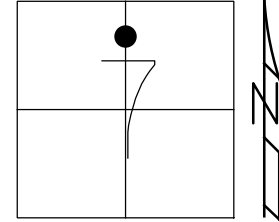

RECORD:
 SET P.K./WASHER
 11-21-89, SWH
 FD SM.R.R.SPIKE
 1" DOWN
 6/17/04, DCH
 SET MAG/WASHER
 9-20-04, SAH
 FD MAG/WASHER
 REFC1
 5-26-20, JLL
 10/28/20, JFO
 SET MAG/WASHER
 10/4/22, TDN

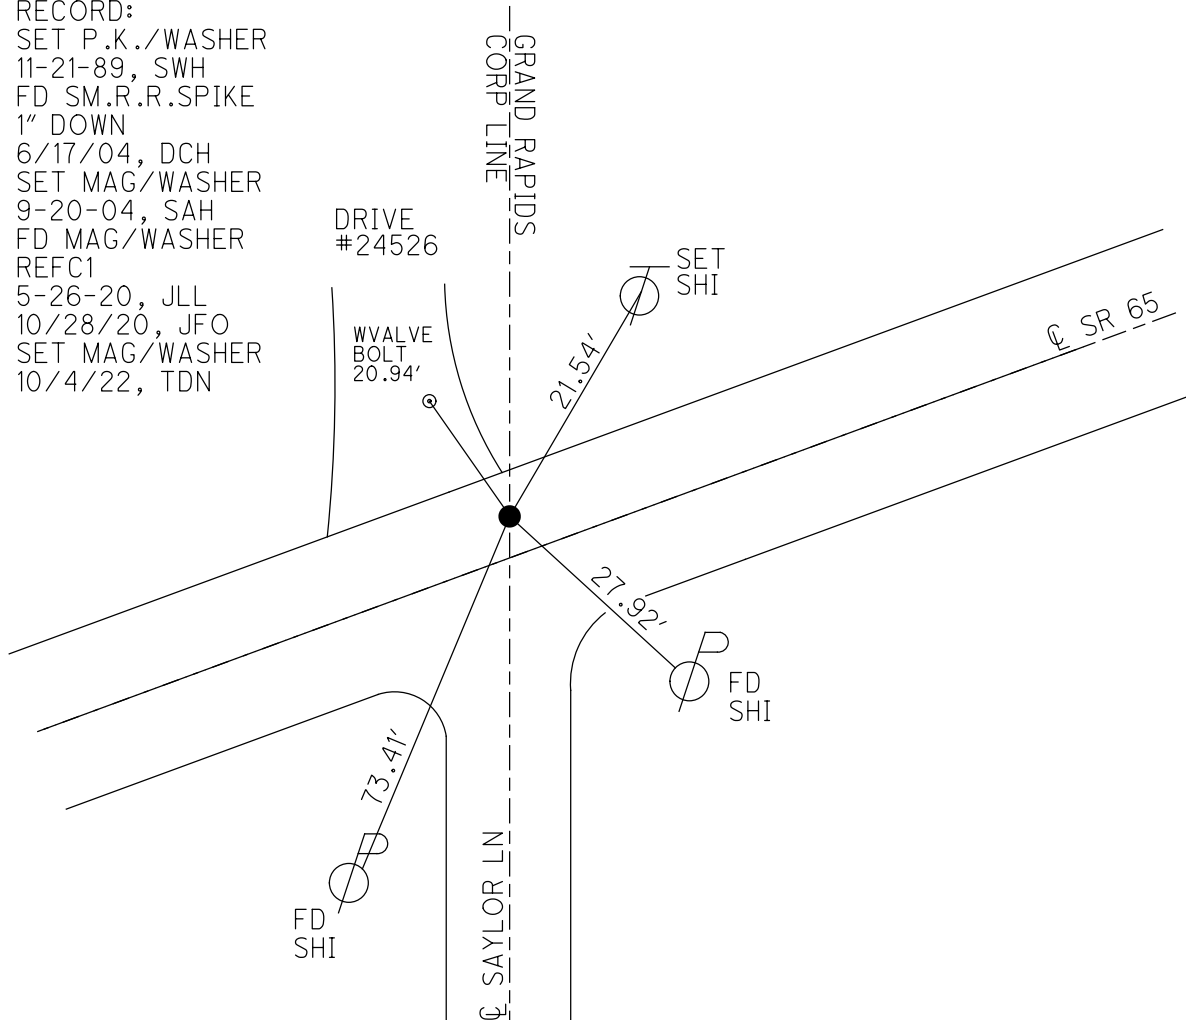

O.D.O.T. DISTRICT 2 SURVEY OFFICE (USE ONLY)

PERSONNEL

REFERENCE NO. 1 C

SHEET 5 OF 9

NOTES HUSS

DATE 6/17/04

ROUTE SR 65

H.C. HOMAN

WEATHER CLOUDY

COUNTY WOOD

R.C. ADKINS

TEMP. 78°

TOWNSHIP GRAND RAPIDS

DWG BY AUBLE PID 109339

SECTION 7

T 5 N R 9 E

TYPE MONUMENT SM.R.R.SPIKE

~~ON SURFACE~~ - BELOW 1"

OFFSET \curvearrowright PAVEMENT 4.4' LT : ~~RT~~

5' TO LT EDGE PAVEMENT


STATION: 25+87.2

HORZ.DATUM: NAD83 2011


GEOID: 2012A

GRID: NORTHING: 638163.228

EASTING: 1591684.319

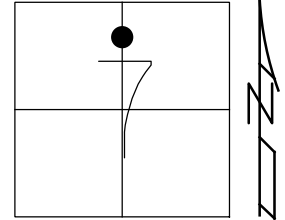

RECORD:
 SET P.K./WASHER
 11-21-89, SWH
 SET MAG/WASHER
 9-20-04, SAH
 FD MAG/WASHER
 REFC1
 5-26-20, JLL

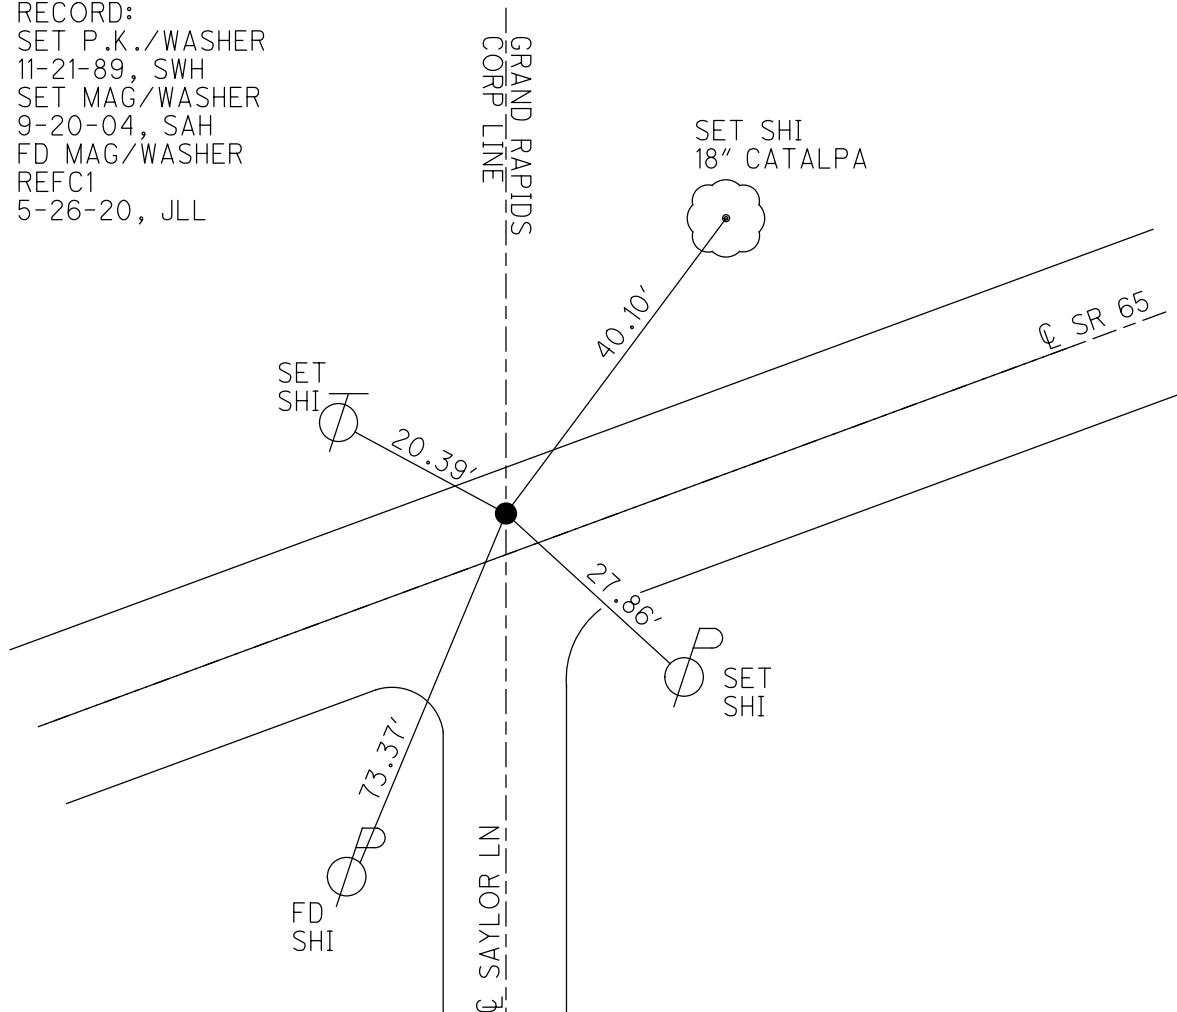

O.D.O.T. DISTRICT 2 SURVEY OFFICE

PERSONNEL

REFERENCE NO. 1-C

SHEET 3 OF 49

NOTES Huss

H.C. Duane

R.C. Kyle

DATE 6-17-04

WEATHER Cldy

TEMP. + 78°F

ROUTE S.R. 65

COUNTY Wood

TOWNSHIP Grand Rapids

SECTION 7

T5 N R 9 E



TYPE MONUMENT Small rer-Spk:

~~ON/SURFACE~~ **(BELOW)** 1" Below

(LEFT) ~~ON/PAN/RIGHT~~ 4.4' Lt.

5.0' TO Lt. EDGE PAVEMENT

S.L.M. 26+30

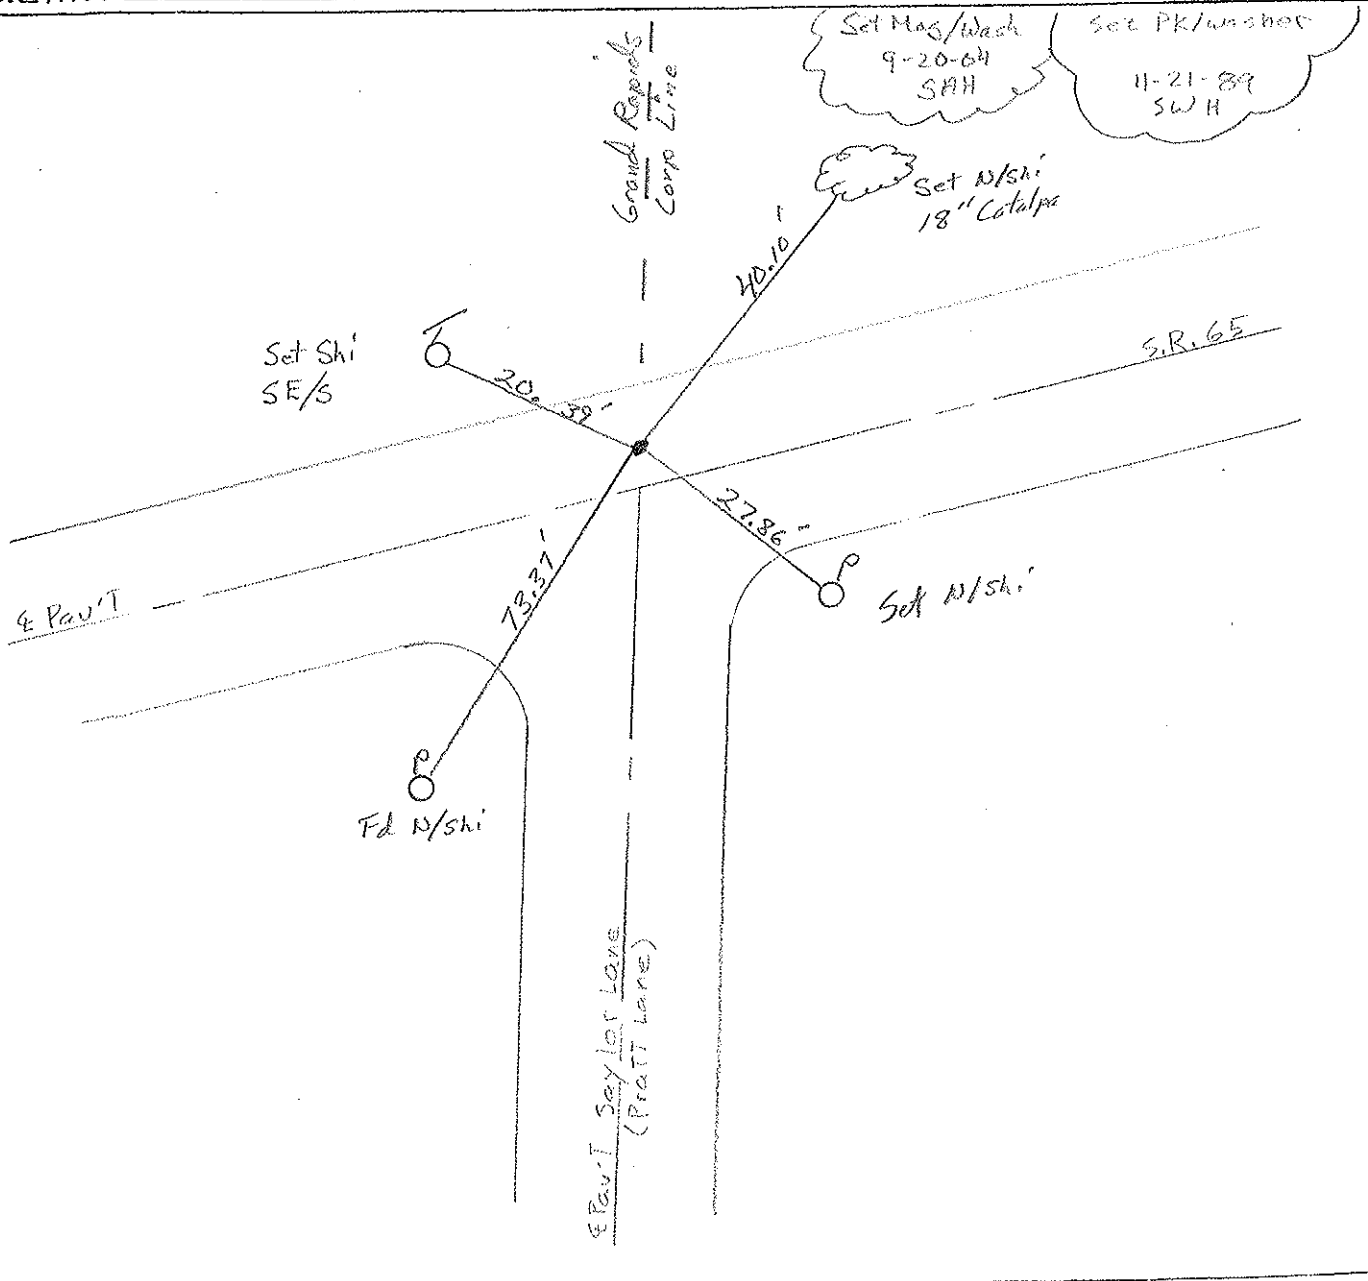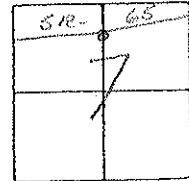

O.D.O.T. DISTRICT 2 SURVEY OFFICE

PERSONNEL

REFERENCE NO. 1-C

SHEET 1 OF 12

NOTES HOFFMAN

H.C. LOENHUIS

DATE 9-7-89

ROUTE SR 65

R.C. BARNAISEL

WEATHER CLEAR

COUNTY WOOD

TEMP. 85°


TOWNSHIP GRAND RAPIDS

SECTION 7


T5 N R 9 E

"A"
 TYPE MONUMENT SMALL R.R. SPIKE
~~ON SURFACE - BELOW~~ 1"
~~LEFT - C PART - RIGHT~~ 4.8'
4.8 TO LT EDGE PAVEMENT
 S.L.M. 26 + 24

Set P.K. / washer
 11-21-89
 SWN

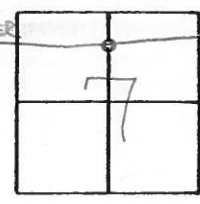

"B" ORIGIN UNKNOWN
 Fd. P.K. at SURFACE
 2.97' N.E. of POINT "A"
 Set P.K. 11-21-89
 SWN

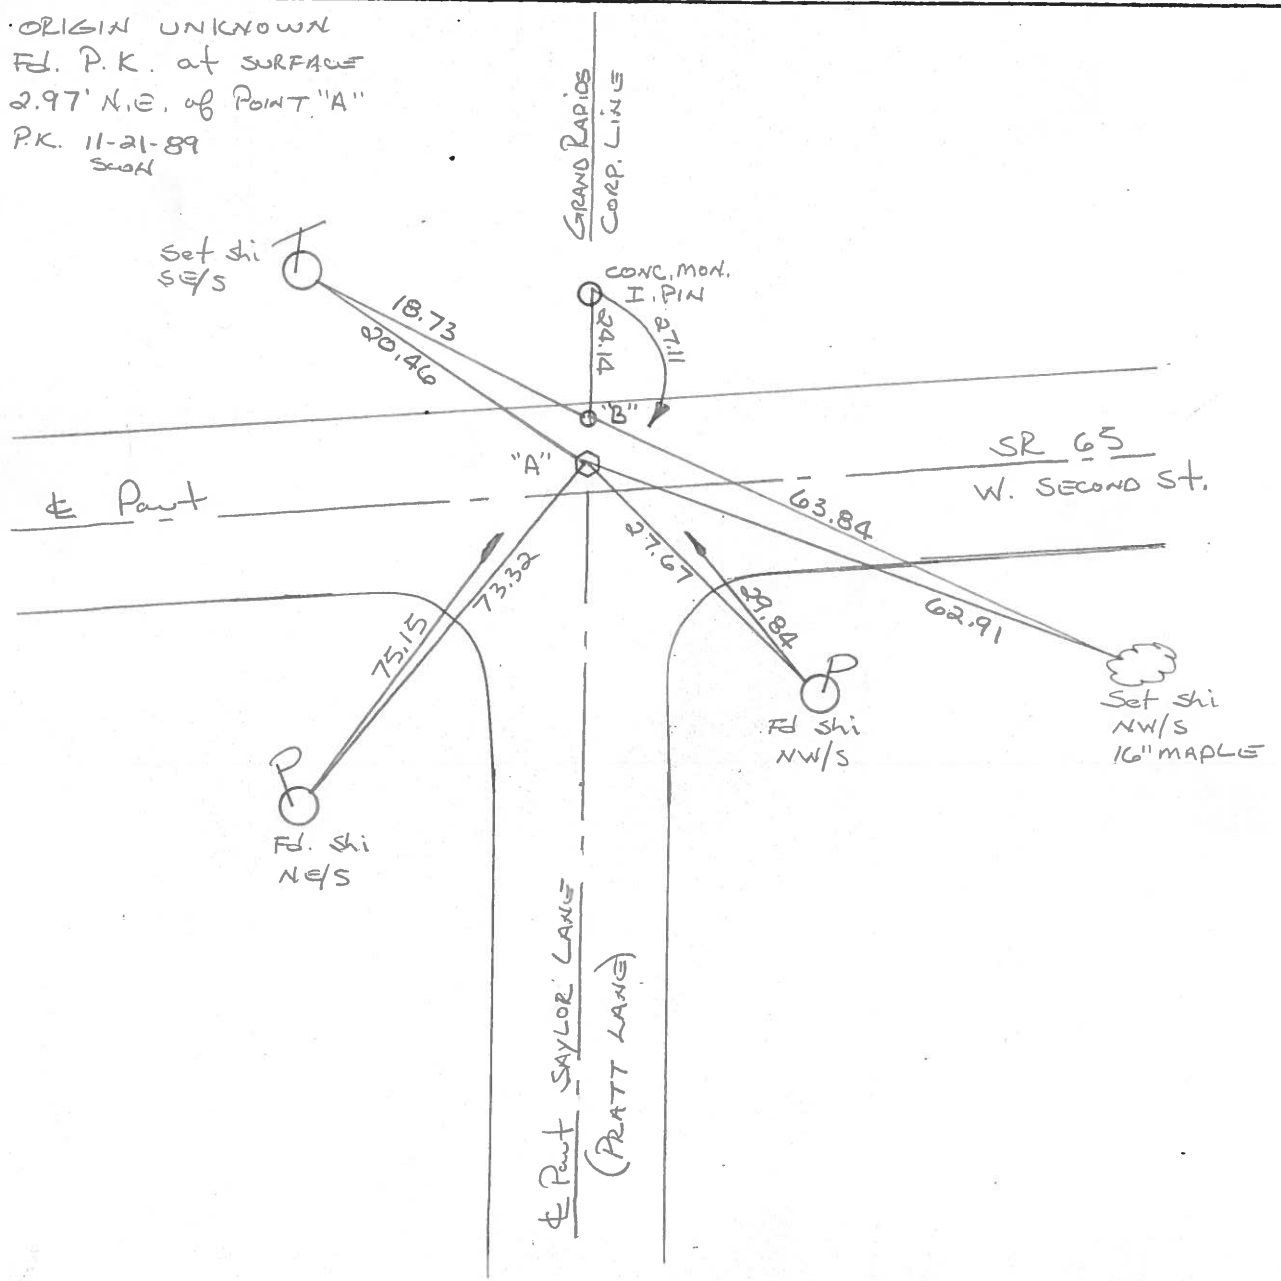

County WOOD S.R. 65

Date 6-9-82
12-3-81

Township Grand Rapids

Weather clear

Section 7 @ Grand Rapids

Temp. +40°

T5N, R9E


Personnel Hoffman

Loehke

Householder


1-C

Pt. "A"

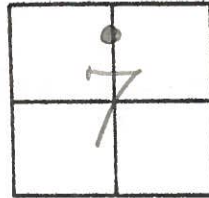

Pt. "A" Fd. small R.R. SPK, 1" below surface @ Project stat 26+24
4.8' N. of & PAUT S. R. 65

Pt. "B" origin unknown
Fd. P.K. @ surface
2.96' NE of Pt. "A"

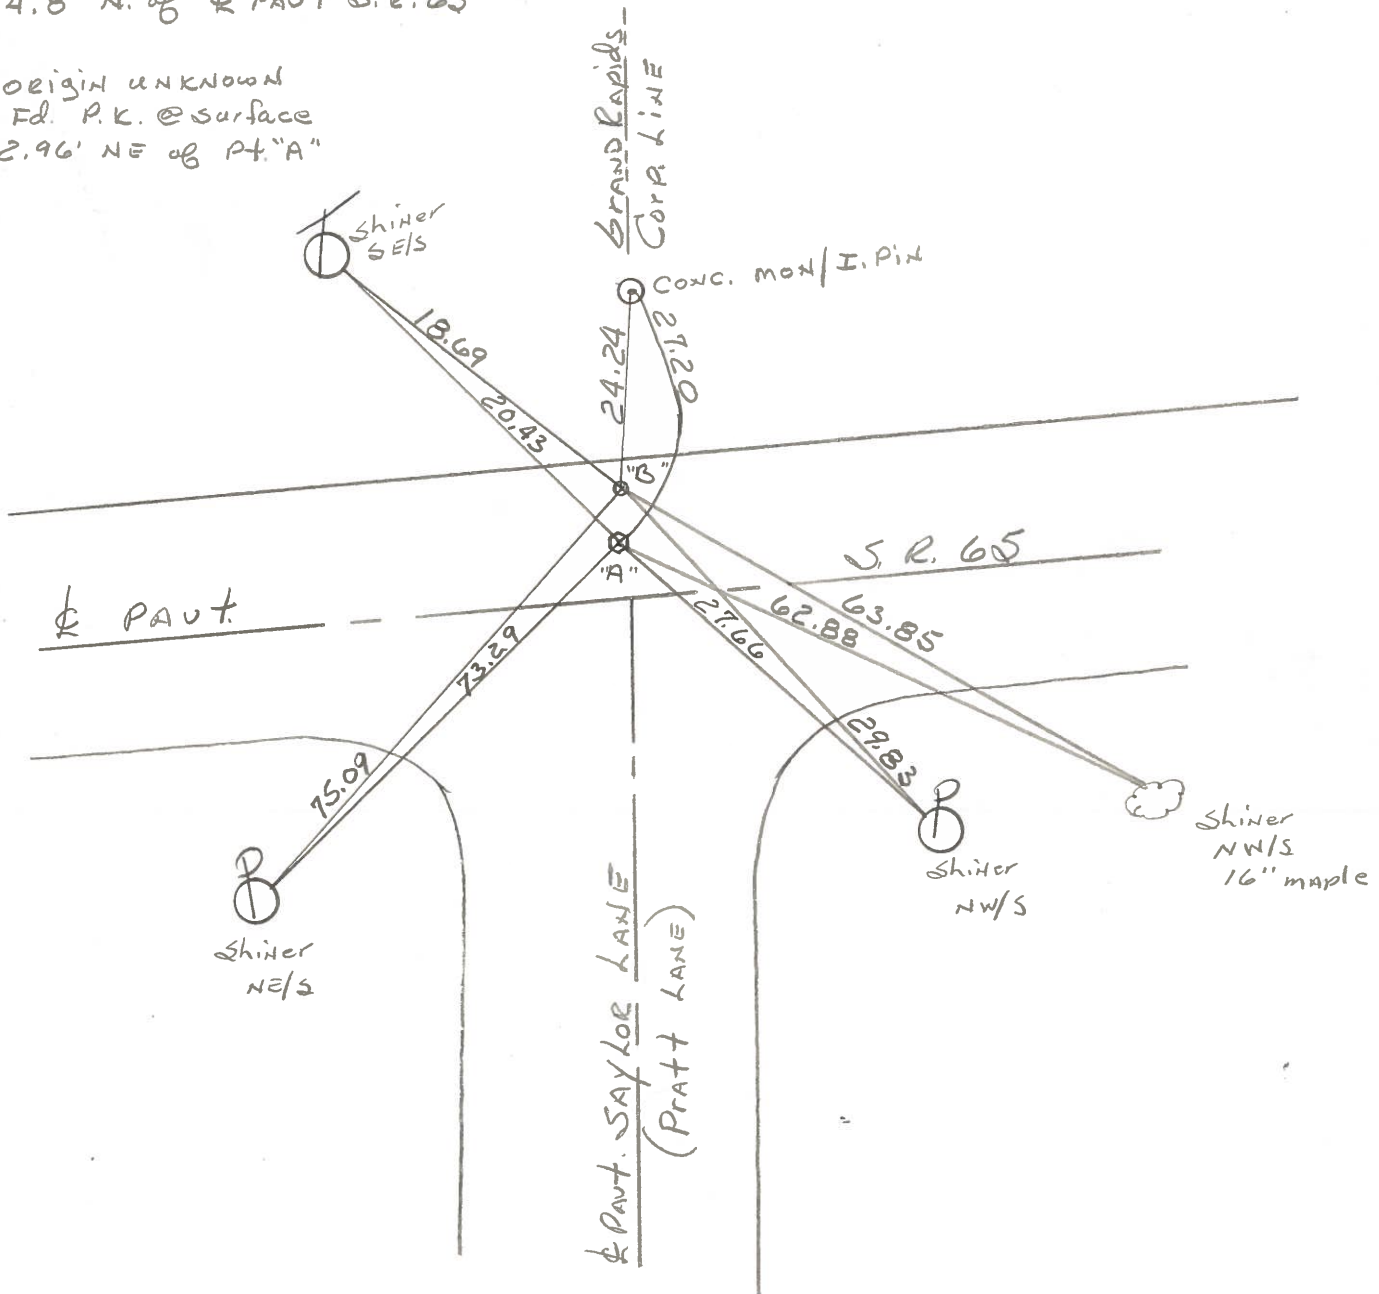

County WOOD S.R. 65

Date 3-14-74

Township GRAND RAPIDS

Weather CLEAR

Section 7

Temp. 33°


T5N, R9E

Personnel BURNSIDE

SMITH

BOWERS

MEAD

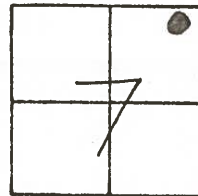

#1-C

Not covered
6-9-82
SWX

P.I.

$\Delta = 2^\circ - 20' \text{ RT.}$

SET SMALL R.R. SPK. *Fd 1" below*
3.5' ± LT. & PAINT. & ON
CORP. LINE

USED STONES @ LOT COR.
TO ESTABLISH CENTERLINE
AND PRODUCED SAME TO WEST
CORP. LINE TO SET P.I.

PK NO. 6 &
NEP

SPK NO. 6 & 48
NEP 48

± R/W S.R. 65


74° 41'
(MEAS.)

$\frac{36}{25+88}$
 $\frac{26}{24}$

TONJES
ADDITION
AS SURVEYED BY
F. GOSSMAN
btw 2.9 & 6

Fd. R.R. SPK.

THIRD ST.

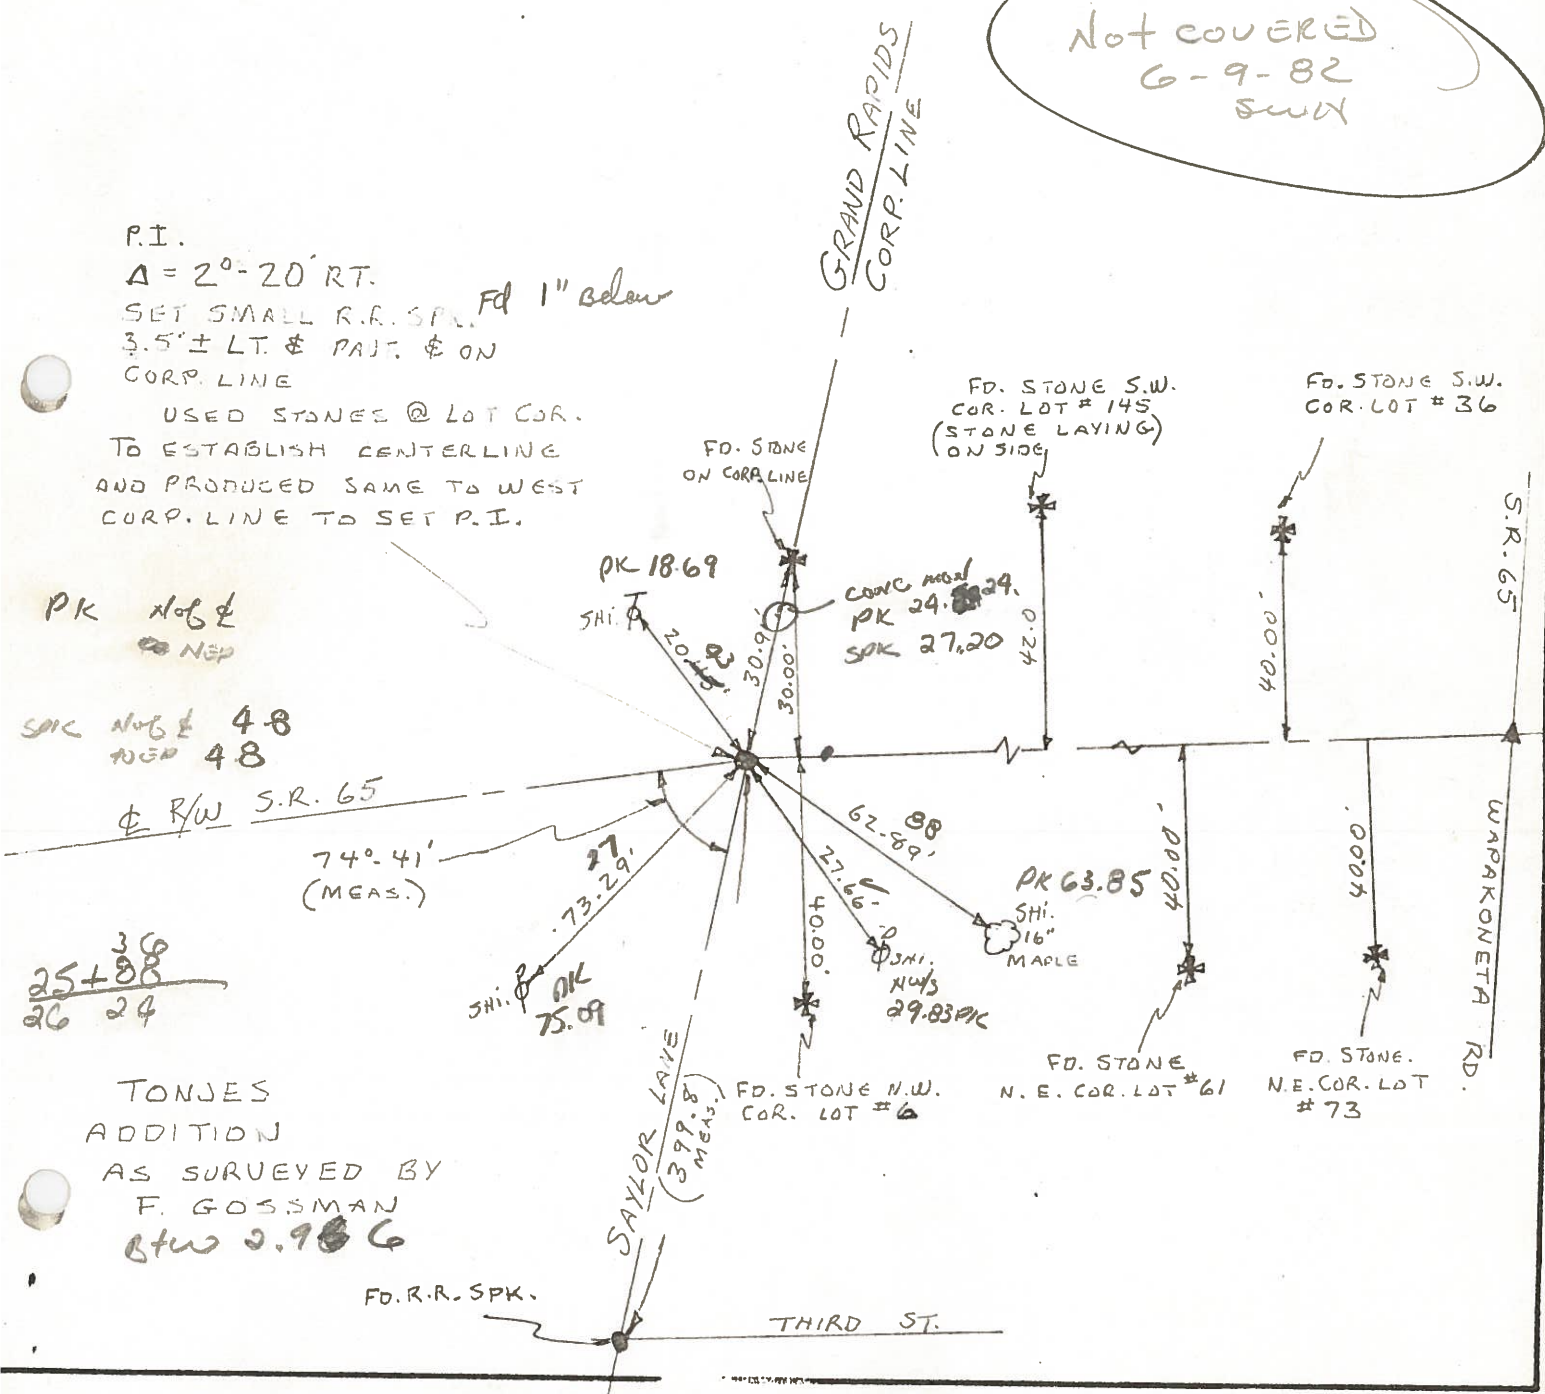

O.D.O.T. DISTRICT 2 SURVEY OFFICE

SHEET _____ OF _____

County WOOD S.R. 65

Date 3-14-74

Township GRAND RAPIDS

Weather CLEAR

Section 7

Temp. 33°


T5N, R9E

Personnel BURNSIDE

SMITH


BOWERS

MEAD

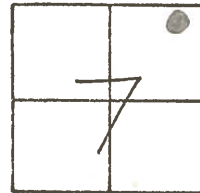

#1-C

P.I.
 $\Delta = 2^\circ - 20' \text{ RT.}$
 SET SMALL R.R. SPK.
 3.5' ± LT. & PAUT. & ON
 CORP. LINE
 USED STONES @ LOT COR.
 TO ESTABLISH CENTERLINE
 AND PRODUCED SAME TO WEST
 CORP. LINE TO SET P.I.

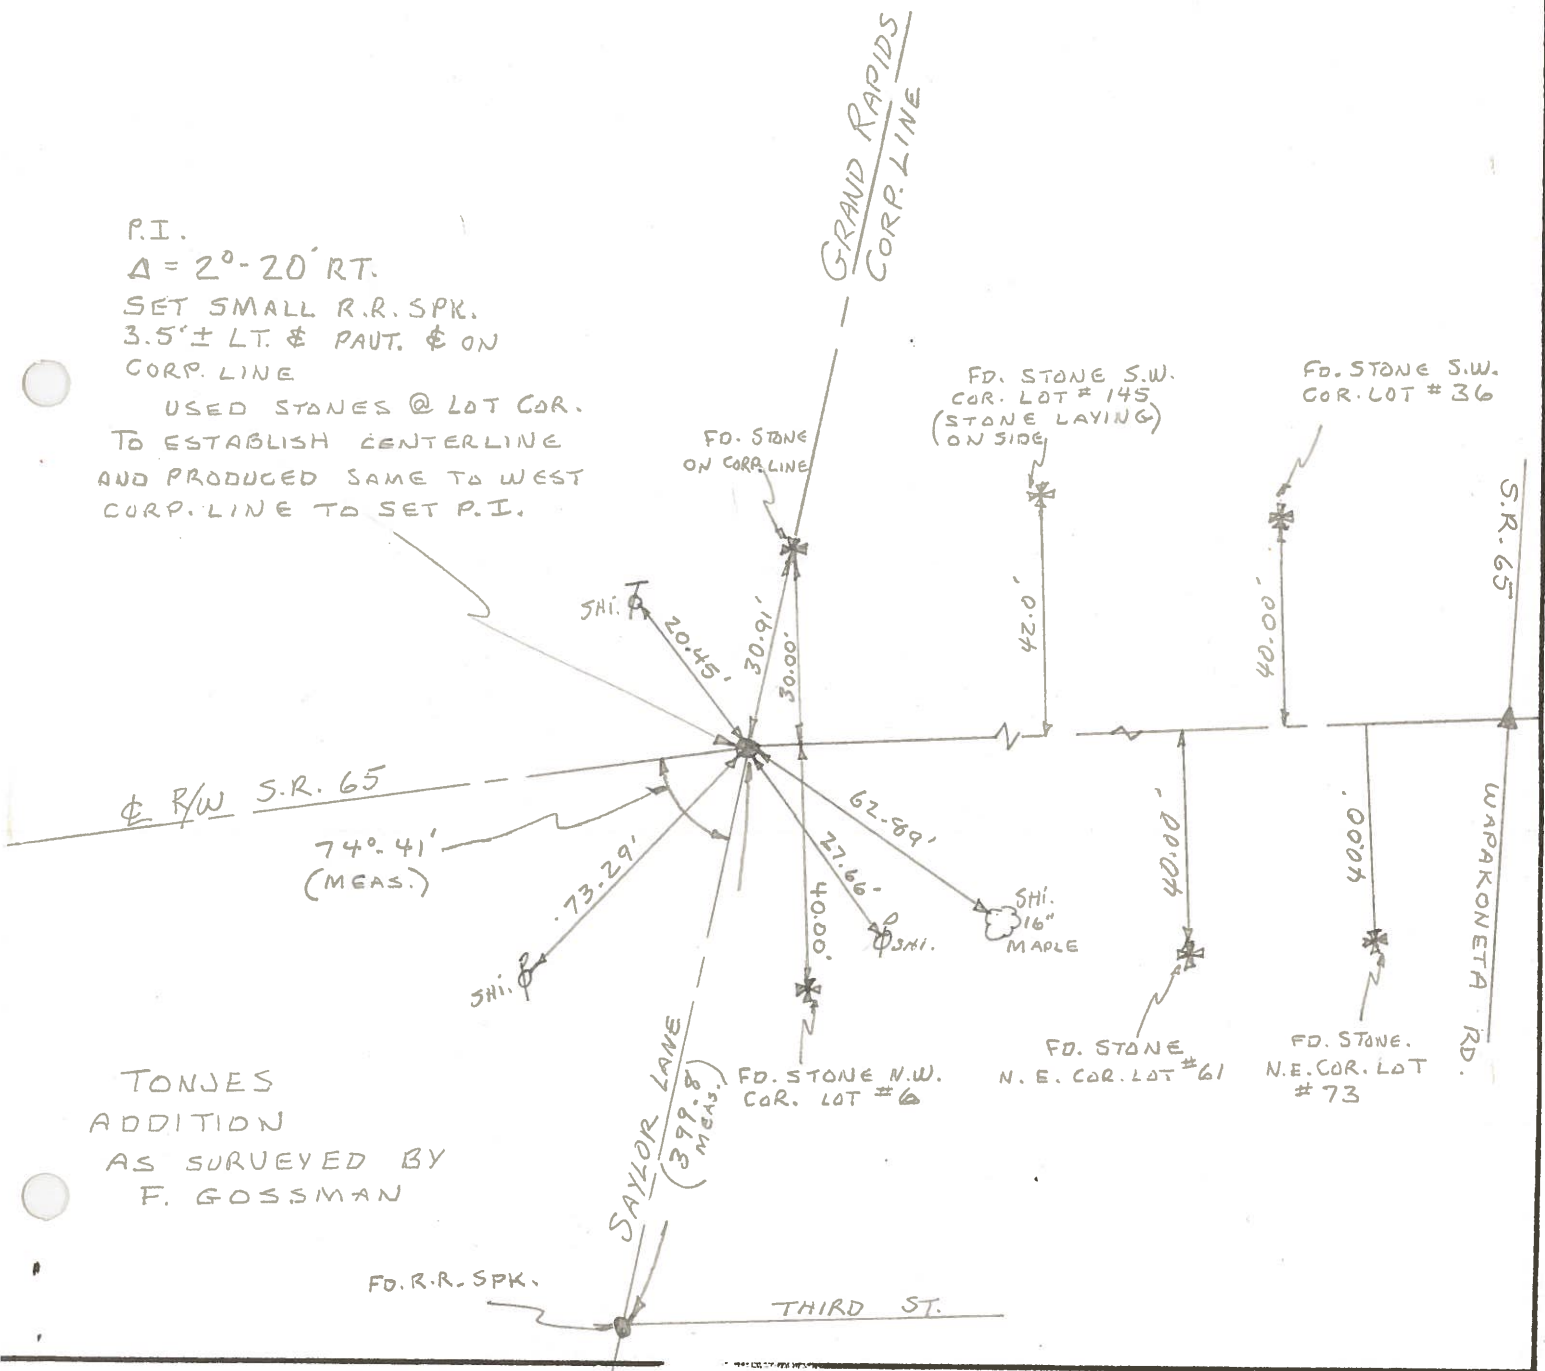

TONJES
 ADDITION
 AS SURVEYED BY
 F. GOSSMAN

FD. R.R. SPK.

THIRD ST.

SEE NEW TIES

LD-5-(25M-2-59)


SHEET NO. 3

PERSONNEL BURNSIDE TITLE _____ PERSONNEL _____ TITLE _____ COUNTY WOOD DATE 7-13-70
HOFFMAN _____ _____ _____ _____ _____ _____

S. R. #65 WEATHER CLEAR

SEC. P.O. LINE E. TO KELLOGG RD. TEMP. +88°

DESCRIPTION POINTS FOUND BEFORE RE-SURFACING JOB NO. _____

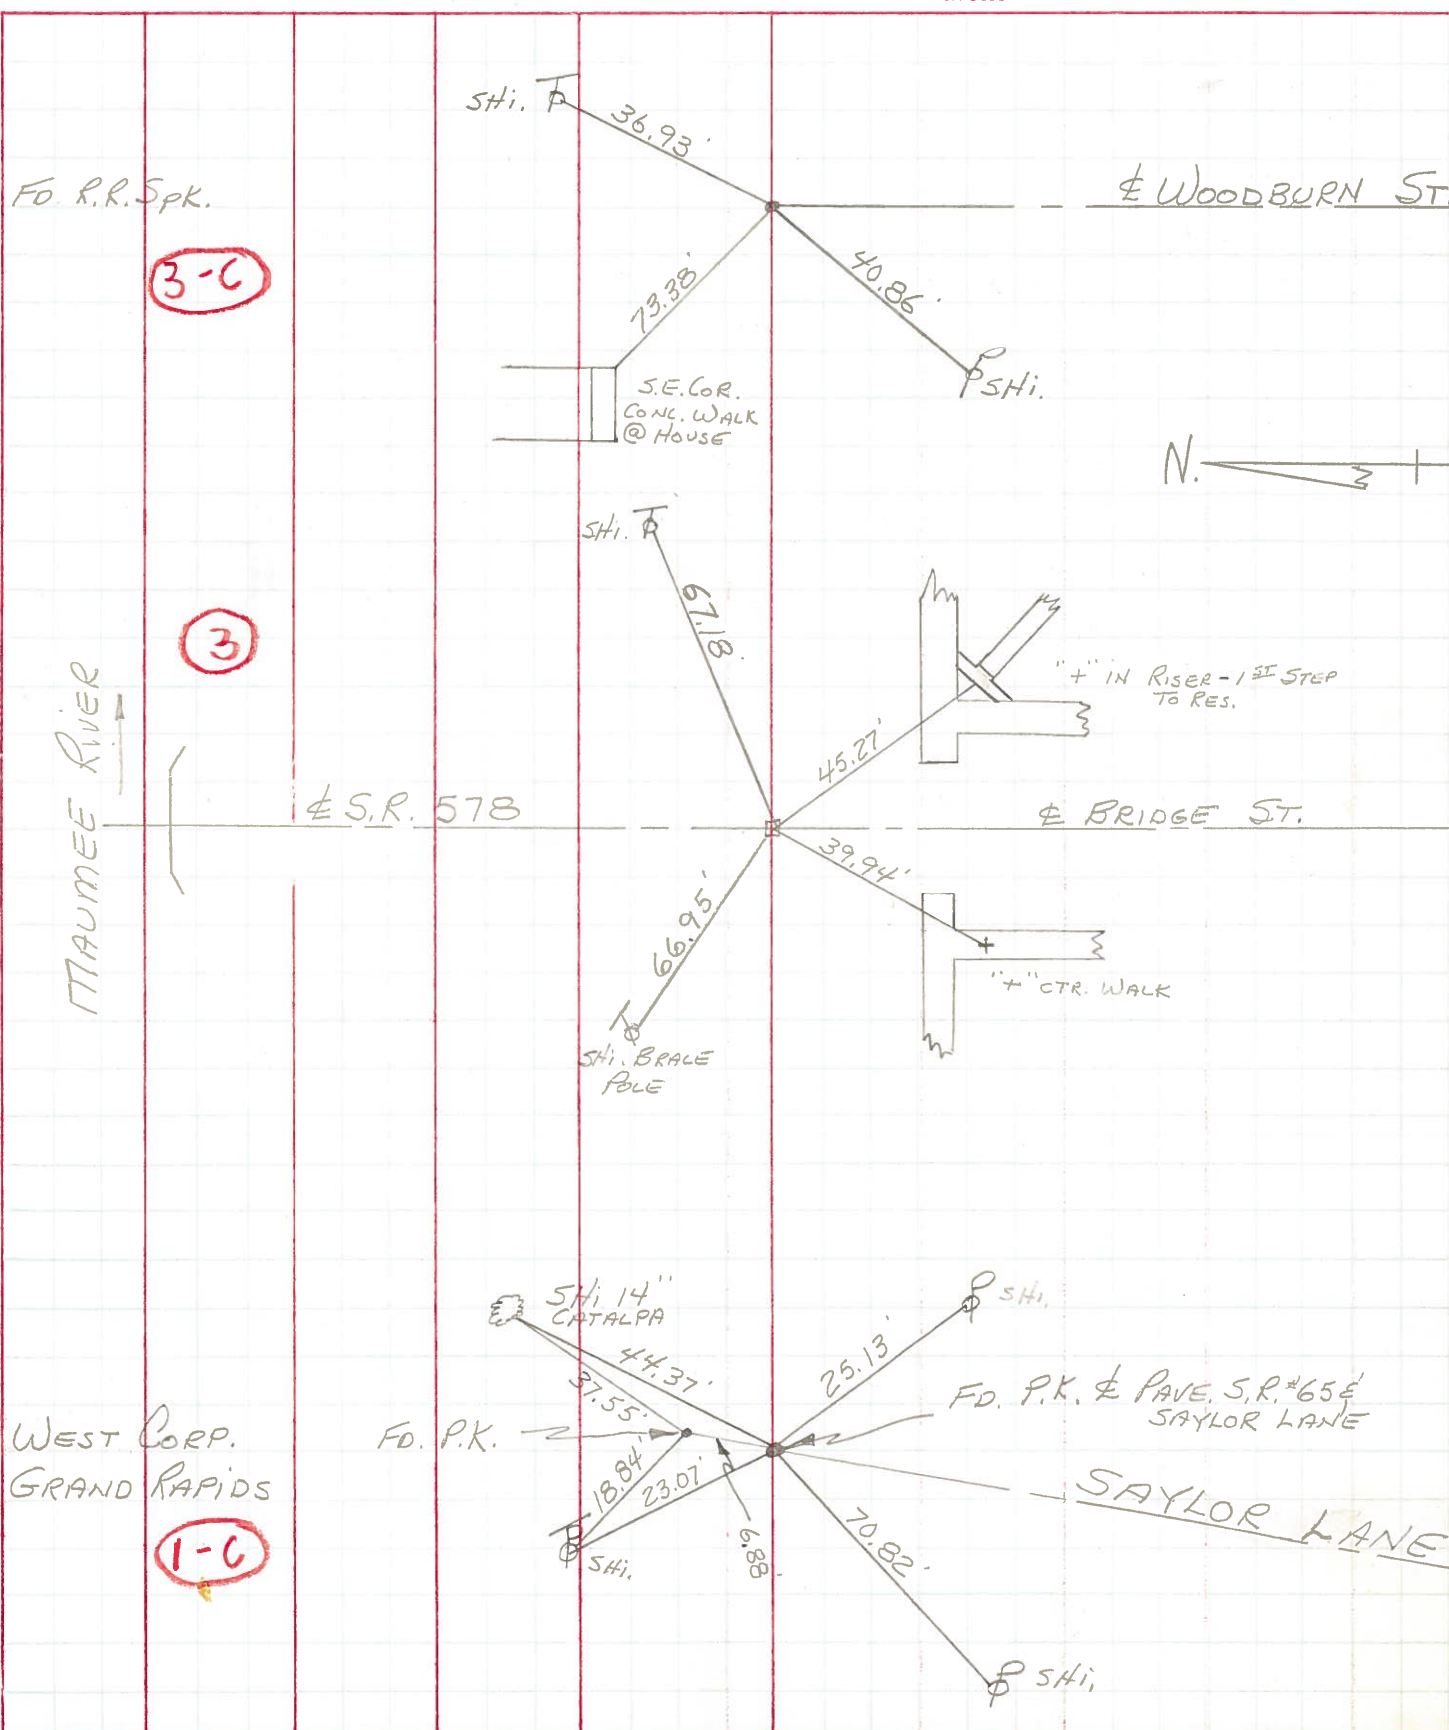

3-C

3

1-C

WEST CORP.
GRAND RAPIDS

F.D. P.K. & PAVE. S.R. #65 & SAYLOR LANE

SAYLOR LANE