

O.D.O.T. DISTRICT 2 SURVEY OFFICE (USE ONLY)

PERSONNEL

REFERENCE NO. 1 E

SHEET 9 OF 40

NOTES RHOADES

DATE 3/29/22

ROUTE SR 65

H.C. NIESE

WEATHER CLEAR

COUNTY WOOD

R.C. KETNER

TEMP. 27°

TOWNSHIP GRAND RAPIDS

AUBLE, O'DONNELL

SECTION 7

DWG BY RHOADES PID 95796

T 5 N R 9 E

TYPE MONUMENT MAG/WASHER

ON SURFACE - ~~BELOW~~ ON

OFFSET 0 PAVEMENT 1' LT : ~~RT~~

- TO - EDGE PAVEMENT


STATION: 47+97.24

HORIZ.DATUM: NAD83 2011


GEOID: NAVD88 2018

GRID: NORTHING: 638639.194

EASTING: 1593805.917

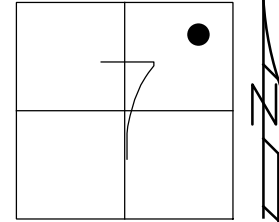

RECORD:  
 ORIGIN UNKNOWN  
 SET P.K./WASHER  
 11-21-89, SWH  
 FD HINGE NAIL  
 0.15' DOWN  
 6/24/04, DCH  
 SET MAG/WASHER  
 9-20-04, RGN  
 FD MAG/WASHER  
 REFE1  
 10/28/20, JFO  
 SET MAG/WASHER  
 10/4/22, TDN

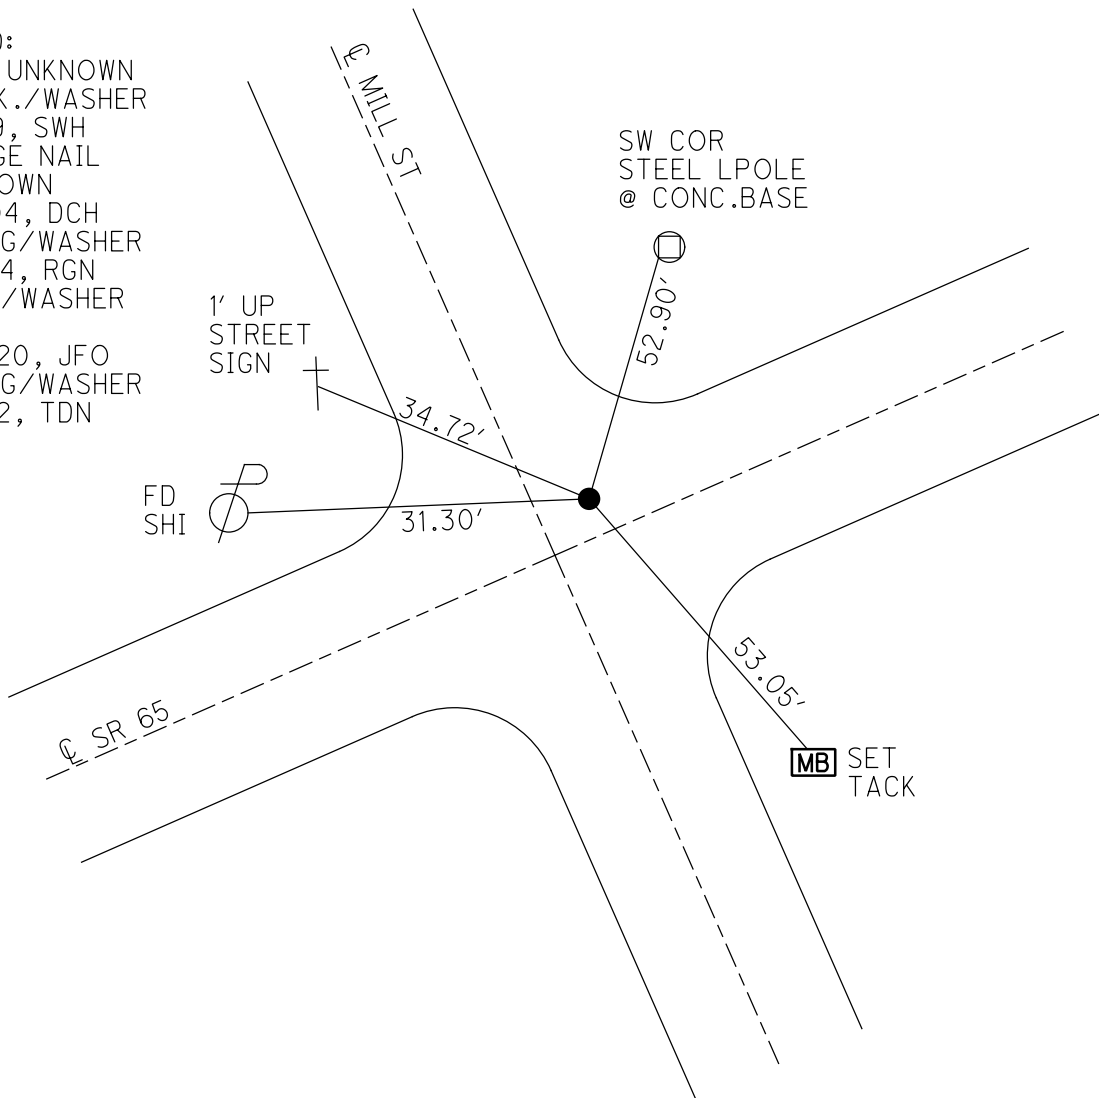

O.D.O.T. DISTRICT 2 SURVEY OFFICE (USE ONLY)

PERSONNEL

REFERENCE NO. 1 E

SHEET 9 OF 16

NOTES HOMAN

DATE 6/24/04

ROUTE SR 65

H.C. HUSS

WEATHER CLEAR

COUNTY WOOD

R.C. NUHFER

TEMP. 80° F

TOWNSHIP GRAND RAPIDS

SECTION 7

DWG BY AUBLE

PID \_\_\_\_\_

T 5 N R 9 E

TYPE MONUMENT HINGE NAIL

~~ON SURFACE~~ - BELOW 0.15'

OFFSET ℄ PAVEMENT 0.5' LT : ~~RT~~

- TO - EDGE PAVEMENT


STATION: 48+00

HORZ.DATUM: -


GEOID: -

GRID: NORTHING: -

EASTING: -

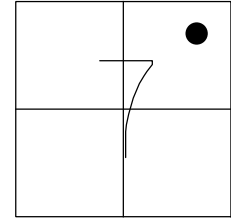

RECORD:  
 ORIGIN UNKNOWN  
 SET P.K./WASHER  
 11-21-89, SWH  
 FD HINGE NAIL  
 0.15' DOWN  
 6/24/04, DCH  
 SET MAG/WASHER  
 9-20-04, RGN

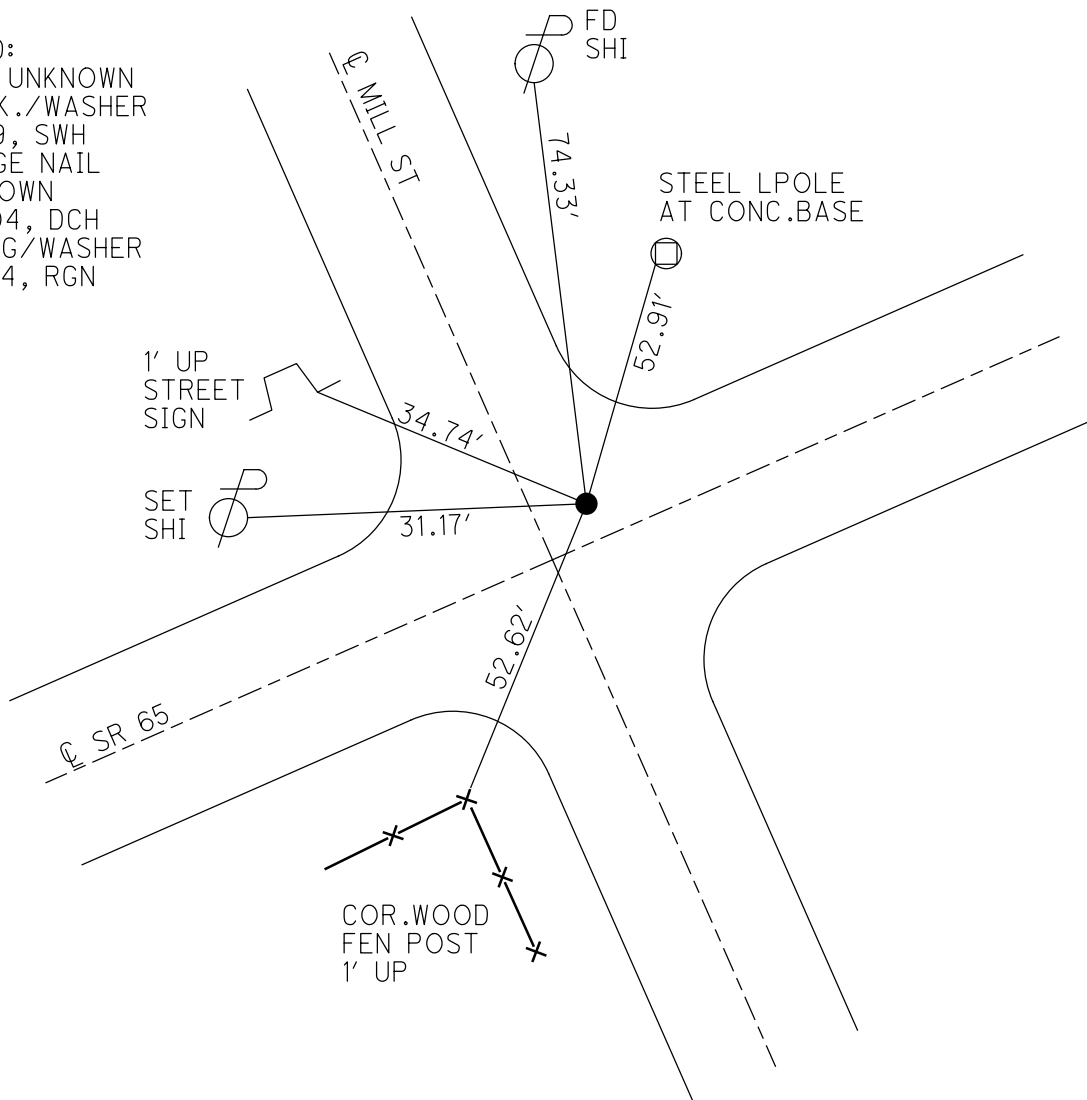

# O.D.O.T. DISTRICT 2 SURVEY OFFICE

PERSONNEL \_\_\_\_\_

REFERENCE NO. 1-E

SHEET 7 OF 49

NOTES Huss

H.C. Homan

R.C. Ryan

DATE 6-24-04

WEATHER Clear

TEMP. 80°F

ROUTE S.R. 65

COUNTY Wood

TOWNSHIP Grand Rapids

SECTION 7

T5 N R 9 E


TYPE MONUMENT Hinge Nail

~~ON SURFACE~~ - BELOW 0.15' Down

LEFT - ~~PAV'T~~ - RIGHT 0.5' Lt.


TO EDGE PAVEMENT

S.L.M. 48+00

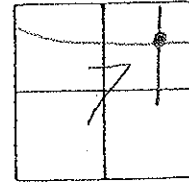

Record:  
Origin Unknown

Set PK Nail  
11-21-89  
SWH  
  
Set Mag/Wash  
9-20-04  
R6W

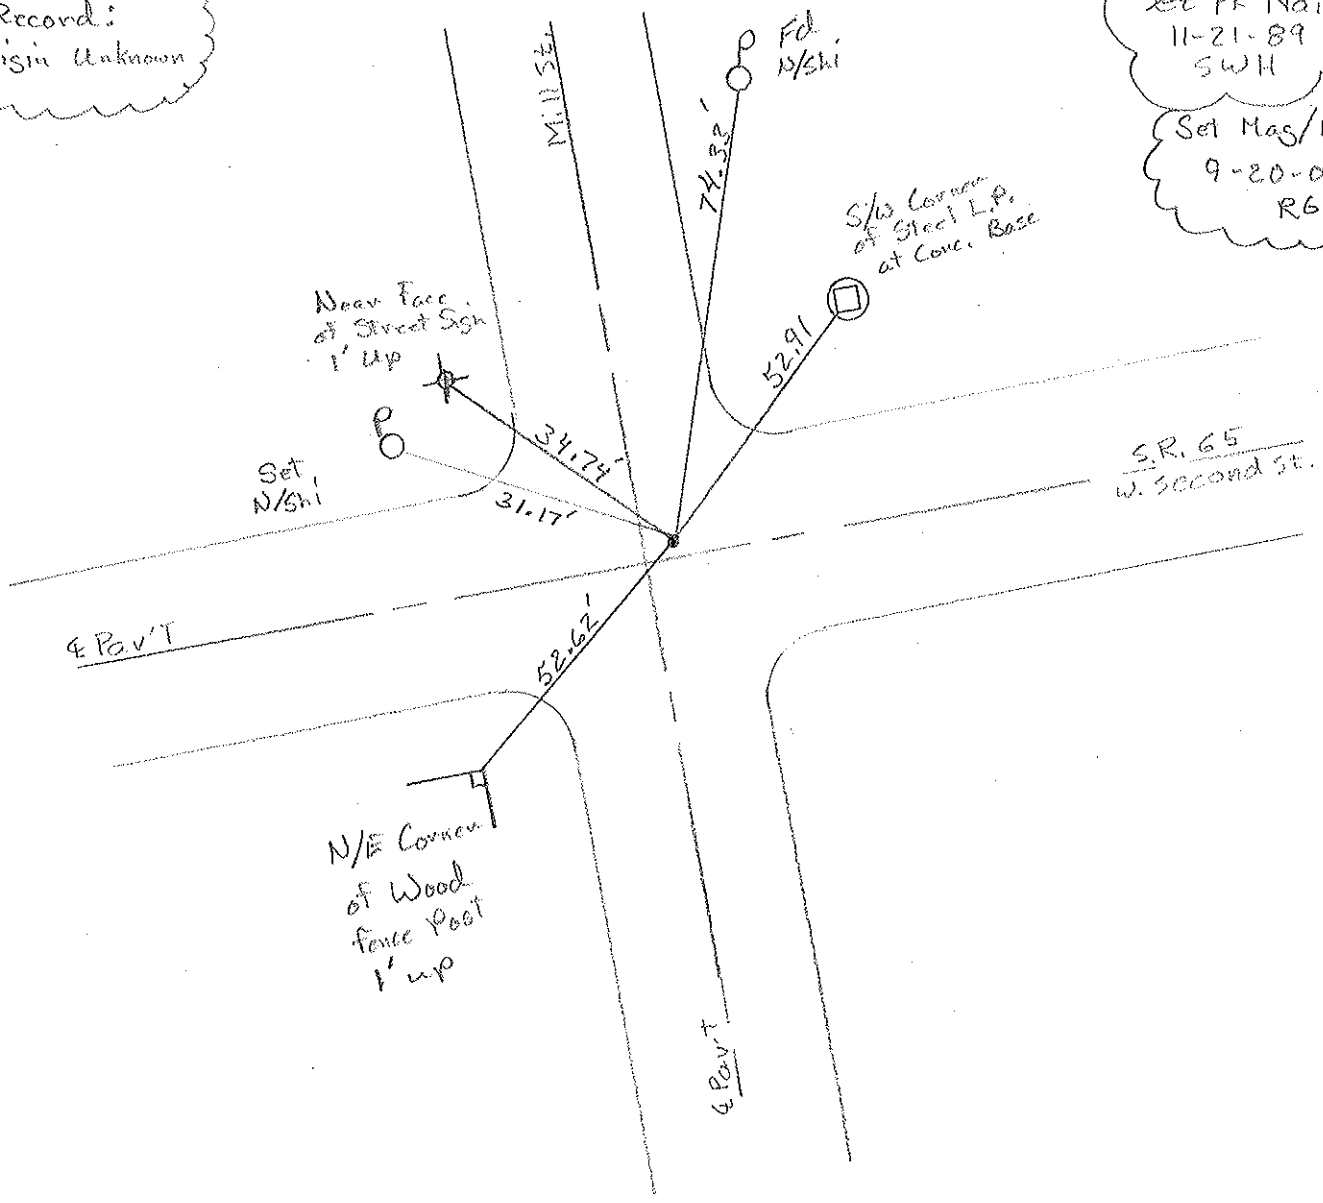

# O.D.O.T. DISTRICT 2 SURVEY OFFICE

PERSONNEL

REFERENCE NO. 1-D SHEET 2 OF 12

NOTES HOFFMAN

H.C. LOEHRKE

R.C. BARNHISEL

DATE 9-7-89

WEATHER CLEAR

TEMP. 85°

ROUTE SR 65

COUNTY WOOD

TOWNSHIP GRAND RAPIDS

SECTION 7

T 5 N R 9 E

TYPE MONUMENT P.K. NAIL - BY OTHERS


ON SURFACE - BELOW YES

~~LEFT - & PAV'T. - RIGHT~~ YES

TO EDGE PAVEMENT

S.L.M. 42+26

Set P.K. NAIL  
11-21-89  
SWH

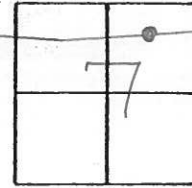

ORIGIN UNKNOWN

