

O.D.O.T. DISTRICT 2 SURVEY OFFICE (USE ONLY)

PERSONNEL

REFERENCE NO. 2

SHEET 10 OF 40

NOTES RHOADES DATE 3/29/22
 H.C. NIESE WEATHER CLEAR
 R.C. KETNER TEMP. 27°
AUBLE, O'DONNELL

ROUTE SR 65
 COUNTY WOOD
 TOWNSHIP GRAND RAPIDS
 SECTION 7
T 5 N R 9 E

DWG BY RHOADES PID 95796


TYPE MONUMENT MAG/WASHER

ON SURFACE - ~~BELOW~~ ON

OFFSET C PAVEMENT 3.3' ~~LT~~ : RT

- TO - EDGE PAVEMENT

STATION: 53+55.05

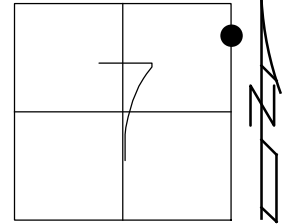


HORZ.DATUM: NAD83 2011

GEOID: NAVD88 2018

GRID: NORTHING: 638761.425

EASTING: 1594350.258

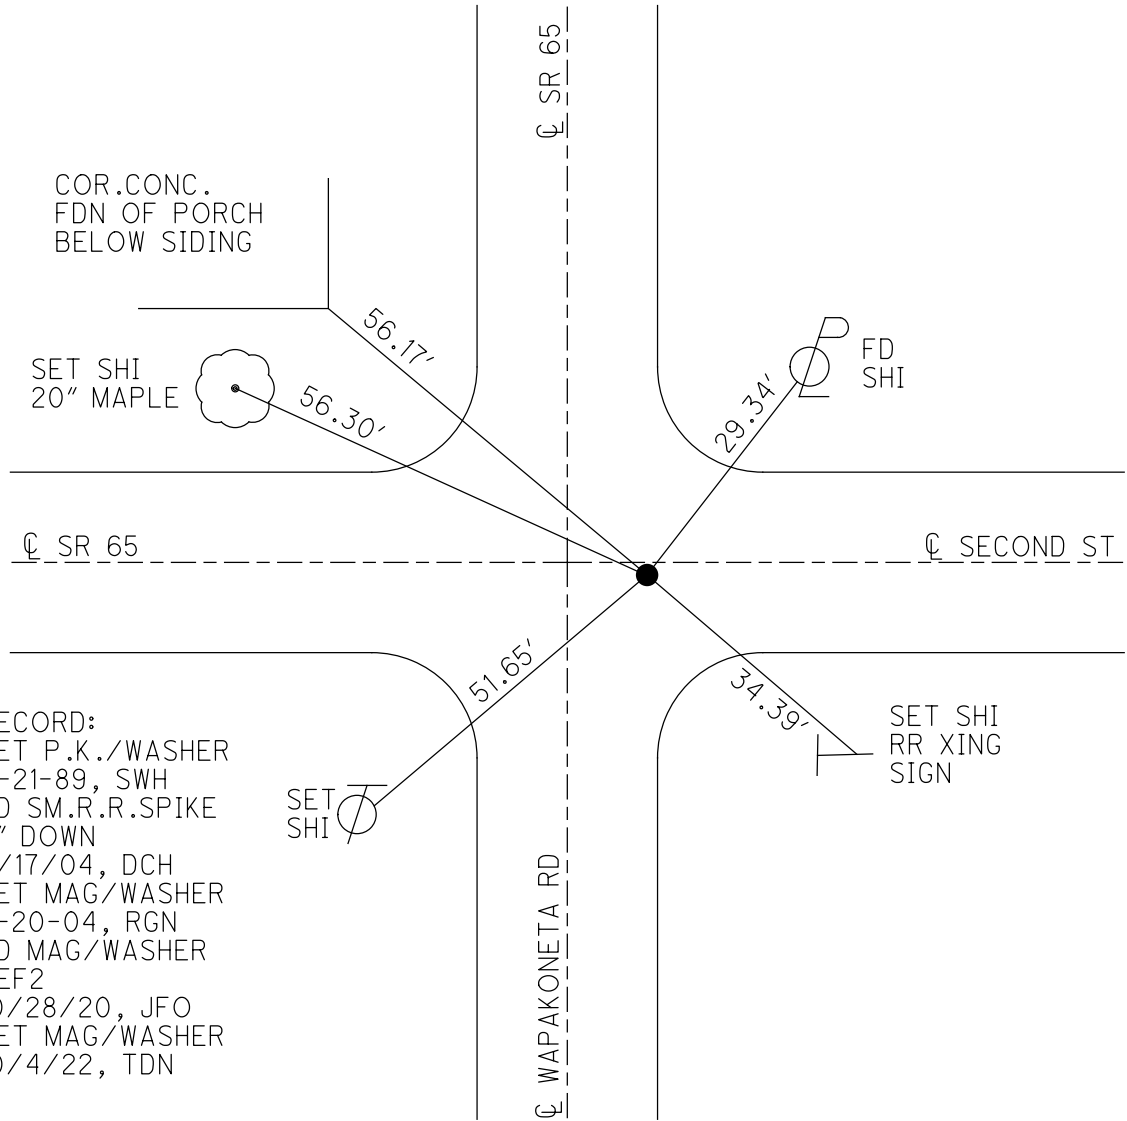

RECORD:
 SET P.K./WASHER
 11-21-89, SWH
 FD SM.R.R.SPIKE
 3" DOWN
 6/17/04, DCH
 SET MAG/WASHER
 9-20-04, RGN
 FD MAG/WASHER
 REF2
 10/28/20, JFO
 SET MAG/WASHER
 10/4/22, TDN

O.D.O.T. DISTRICT 2 SURVEY OFFICE

PERSONNEL

REFERENCE NO. 2

SHEET 8 OF 49

NOTES Huss

H.C. Homan

R.C. Kyle

DATE 6-17-04

WEATHER Clidy

TEMP. +84°F

ROUTE S.R. 65

COUNTY Wood

TOWNSHIP Grand Rapids

SECTION 7

T5 N R9 E



TYPE MONUMENT Small RR Spike

ON SURFACE - BELOW 3" below

LEFT - ☉ PAV'T. - RIGHT 3.3' Rt.


— TO — EDGE PAVEMENT

S.L.M. 53 + 57

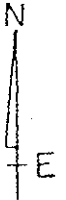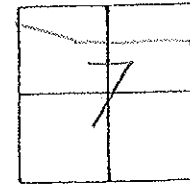

Record! Set
PK/W 11-21-89
SWH

Set Mag/Wash
9-20-04
RGN

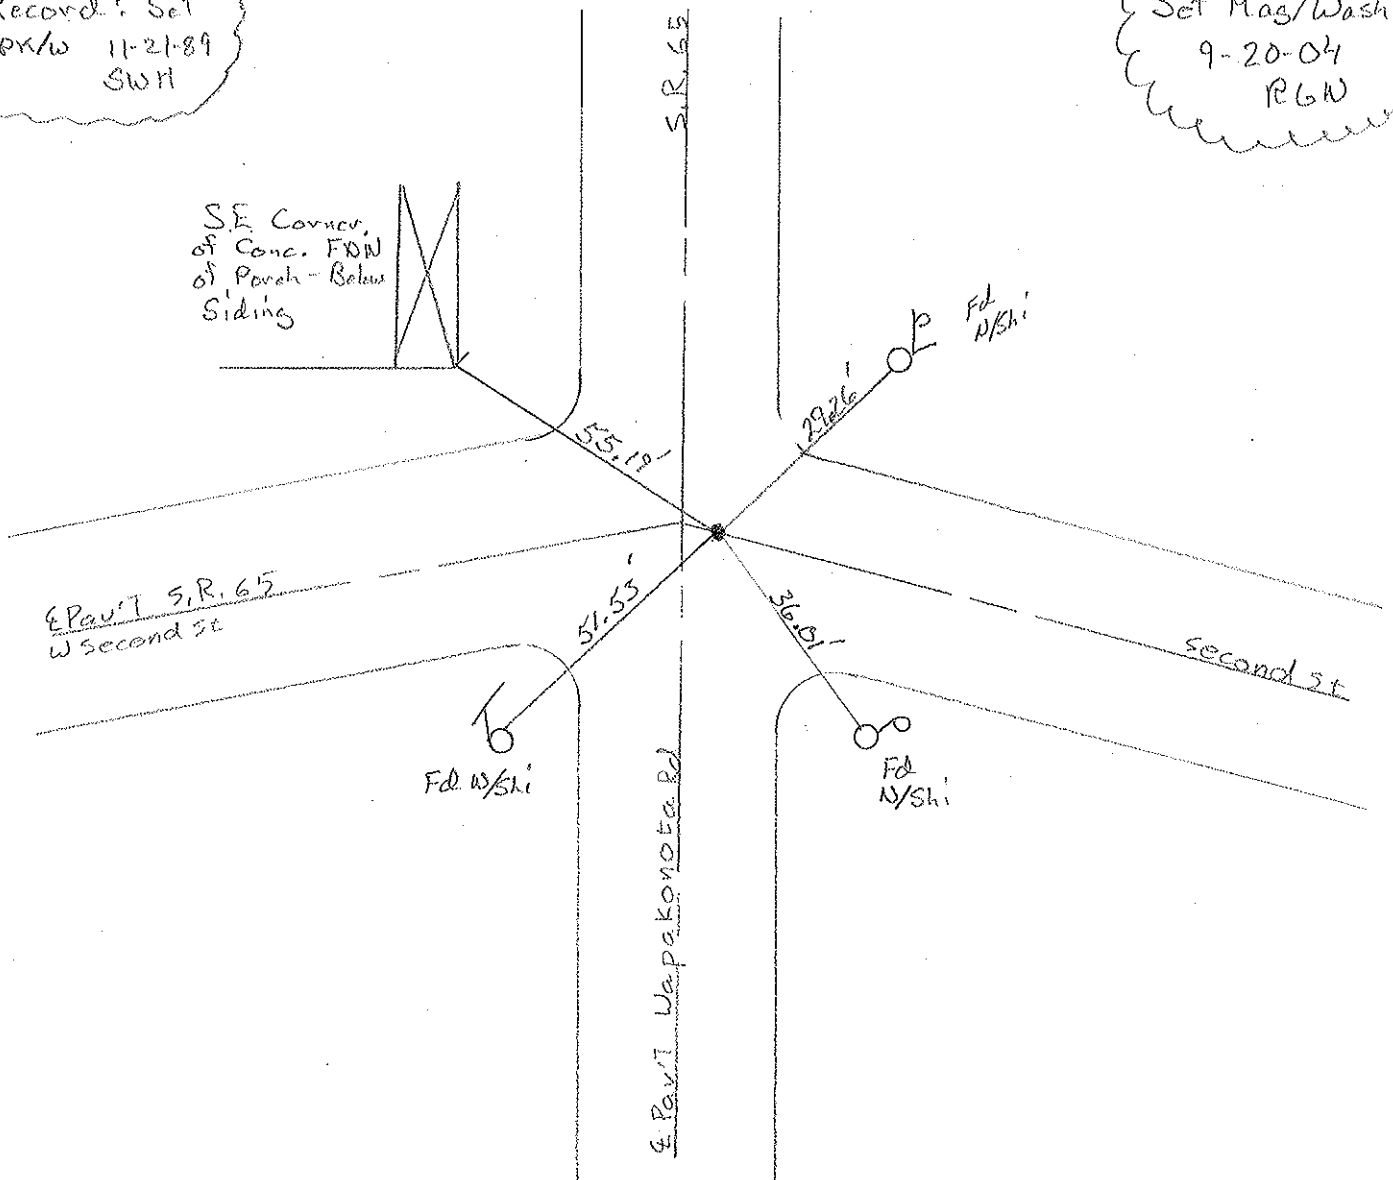

O.D.O.T. DISTRICT 2 SURVEY OFFICE

PERSONNEL

REFERENCE NO. 2

SHEET 4 OF 12

NOTES HOFFMAN

H.C. LOEHRKE

DATE 9-7-89

ROUTE SR 65

R.C. BARNHISEL

WEATHER CLEAR

COUNTY WOOD

TEMP. 86°


TOWNSHIP GRAND RAPIDS

SECTION 7

T 5 N 9 E


"A"
 TYPE MONUMENT R.R. SPIKE
~~ON SURFACE~~ - BELOW 1 1/2"
 LEFT- & PAV'T. - RIGHT 3.3'
 TO EDGE PAVEMENT
 S.L.M. 53 + 55

Set P.K./WASHER
 11-21-89
 SWN

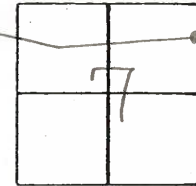

"B" Fd P.K. at surface
 ORIGIN UNKNOWN
 1.27' S. of Point "A"

Set P.K. Nail
 11-21-89
 SWN

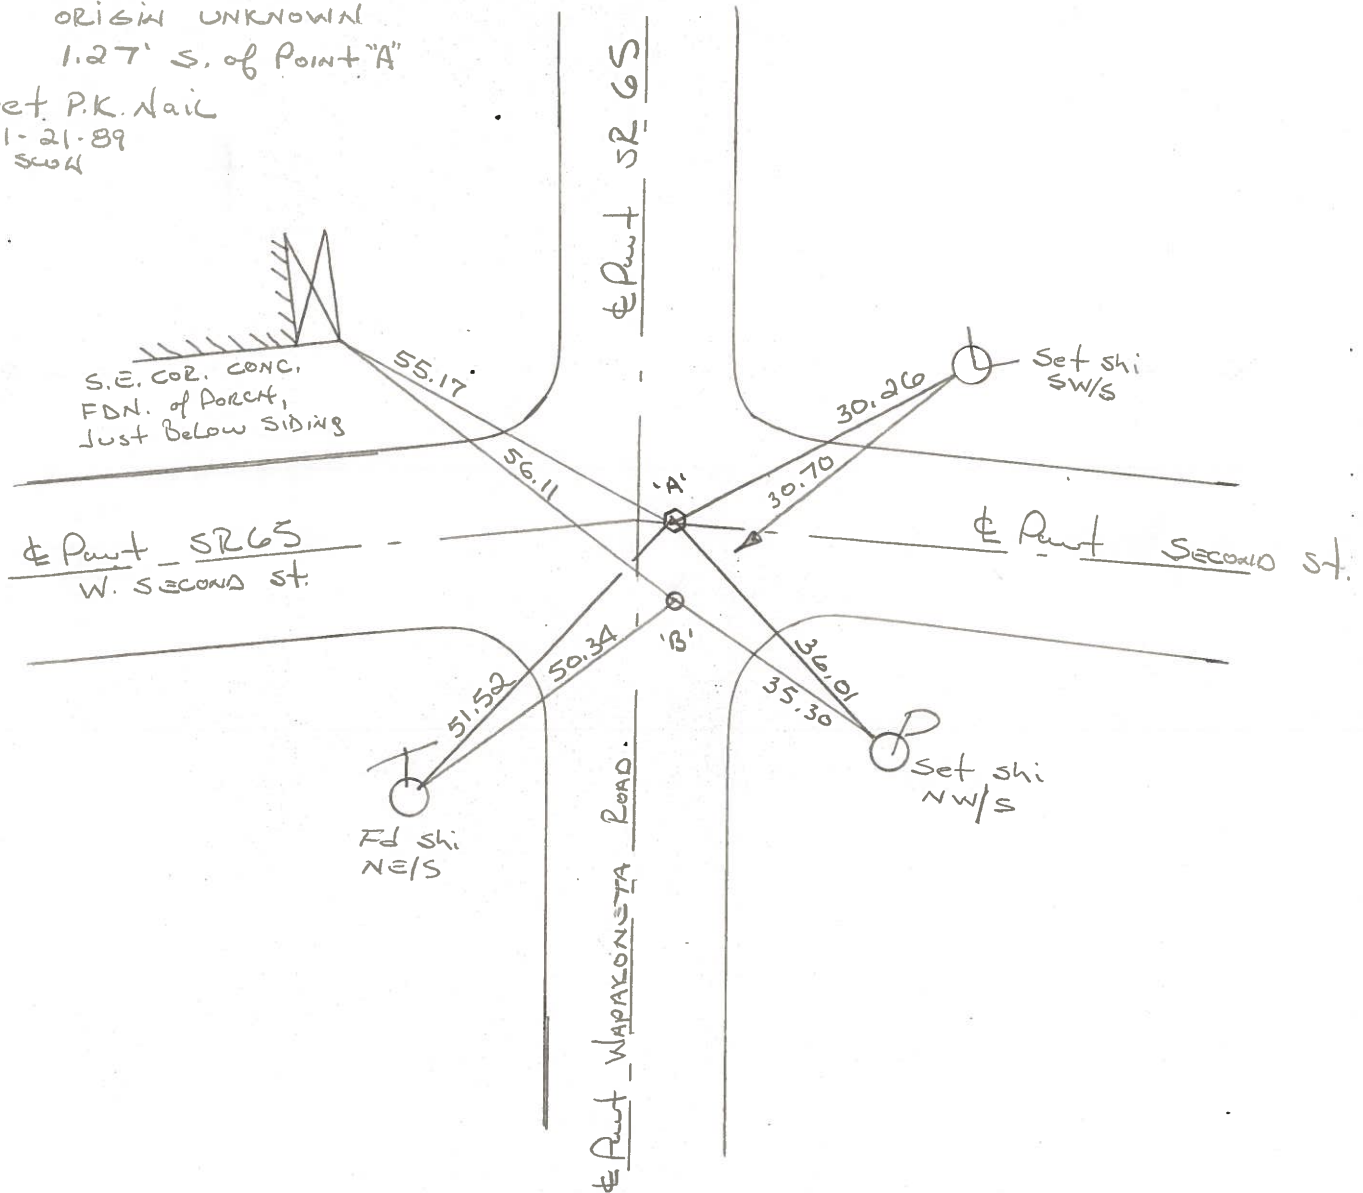

County Wood S.R. 65

Date 12-3-81

Township Grand Rapids

Weather Clear

Section 7 @ Grand Rapids

Temp. +40°


T5N, R9E

Personnel Hoffman

Loehrke


Householder

#2
(Pt "A")

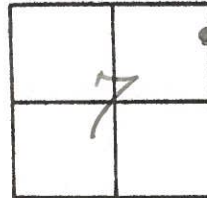

Pt "A" Fd. small R.R. spike 1 1/2" below surface
3.3' E. of & PAUT S.R. 65-North

Pt "B" ORIGIN UNKNOWN
Fd P.K. Nail @ surface
1.27' S. of Pt. "A"

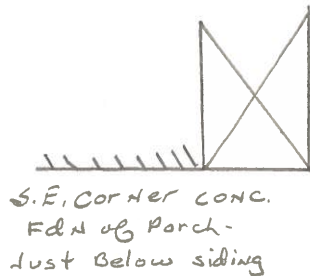

& PAUT U.S. 65

& PAUT S.R. 65

& PAUT Second St.



Shiner
NW/S


& PAUT
WAPAKONETA ST.



Shiner
NW/S



Shiner
SW/S

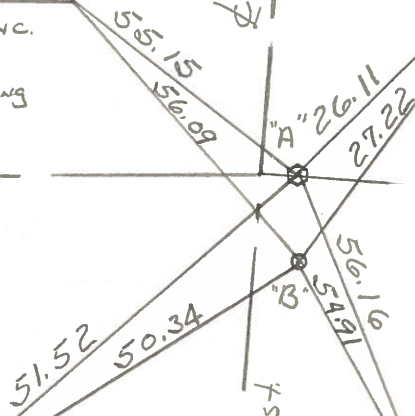

O.D.O.T. DISTRICT 2 SURVEY OFFICE

SHEET OF

County WOOD S.R. 65

Township GRAND RAPID

Section 7

T5N, R9E

Personnel BURNSIDE

SMITH

BOWERS


BAGDONAS

KIOWSKI

Date 7-16-73


Weather PT. CLOUDY

Temp. 70°

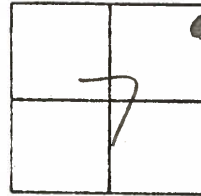

#2

2-A

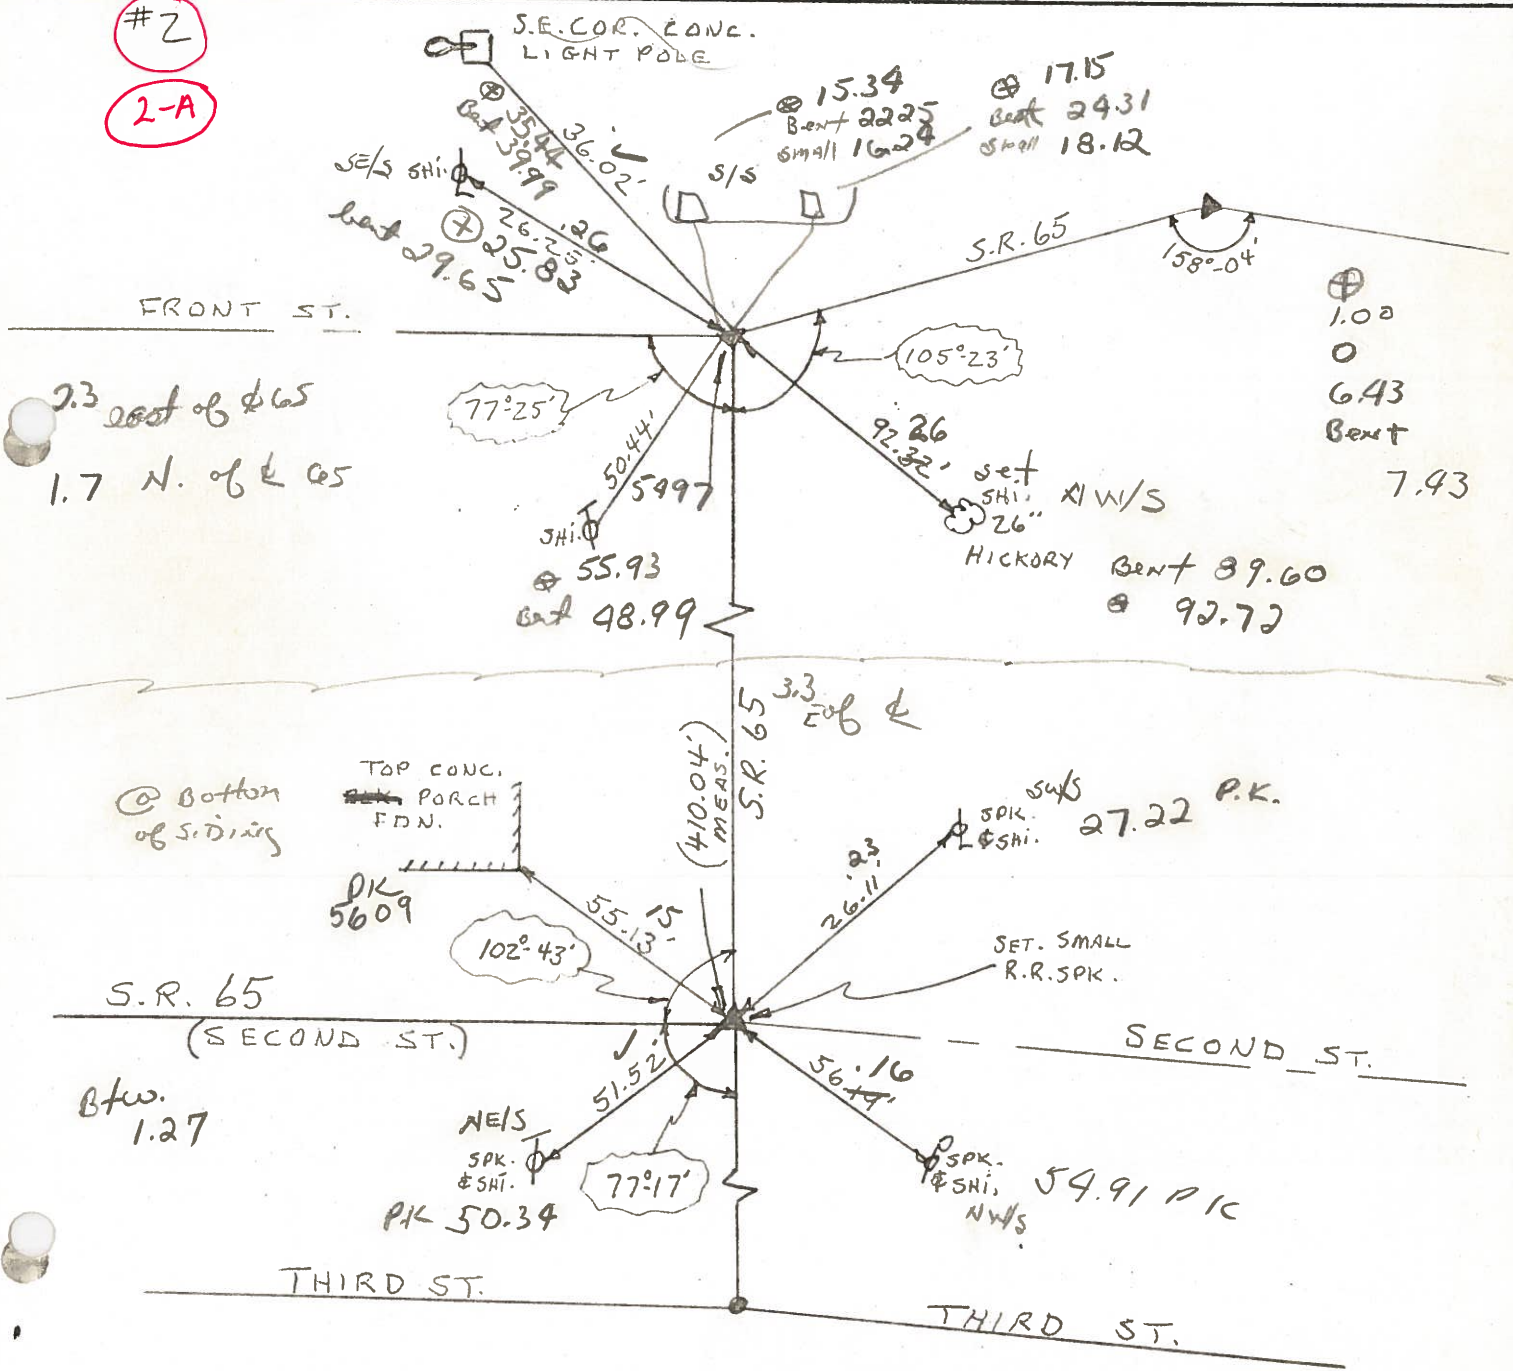

1.02
0
6.43
Bent
7.93

ODOT. DISTRICT 2 SURVEY OFFICE

SHEET OF

County WOOD S.R. 65

Date 7-16-73

Township GRAND RAPID

Weather PT. CLOUDY

Section 7

Temp. 70°

T5N, R9E


Personnel BURNSIDE

SMITH

BOWERS


BAGDONAS

KIJOWSKI

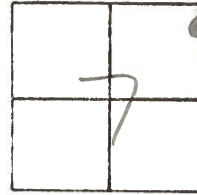

#2

2-A

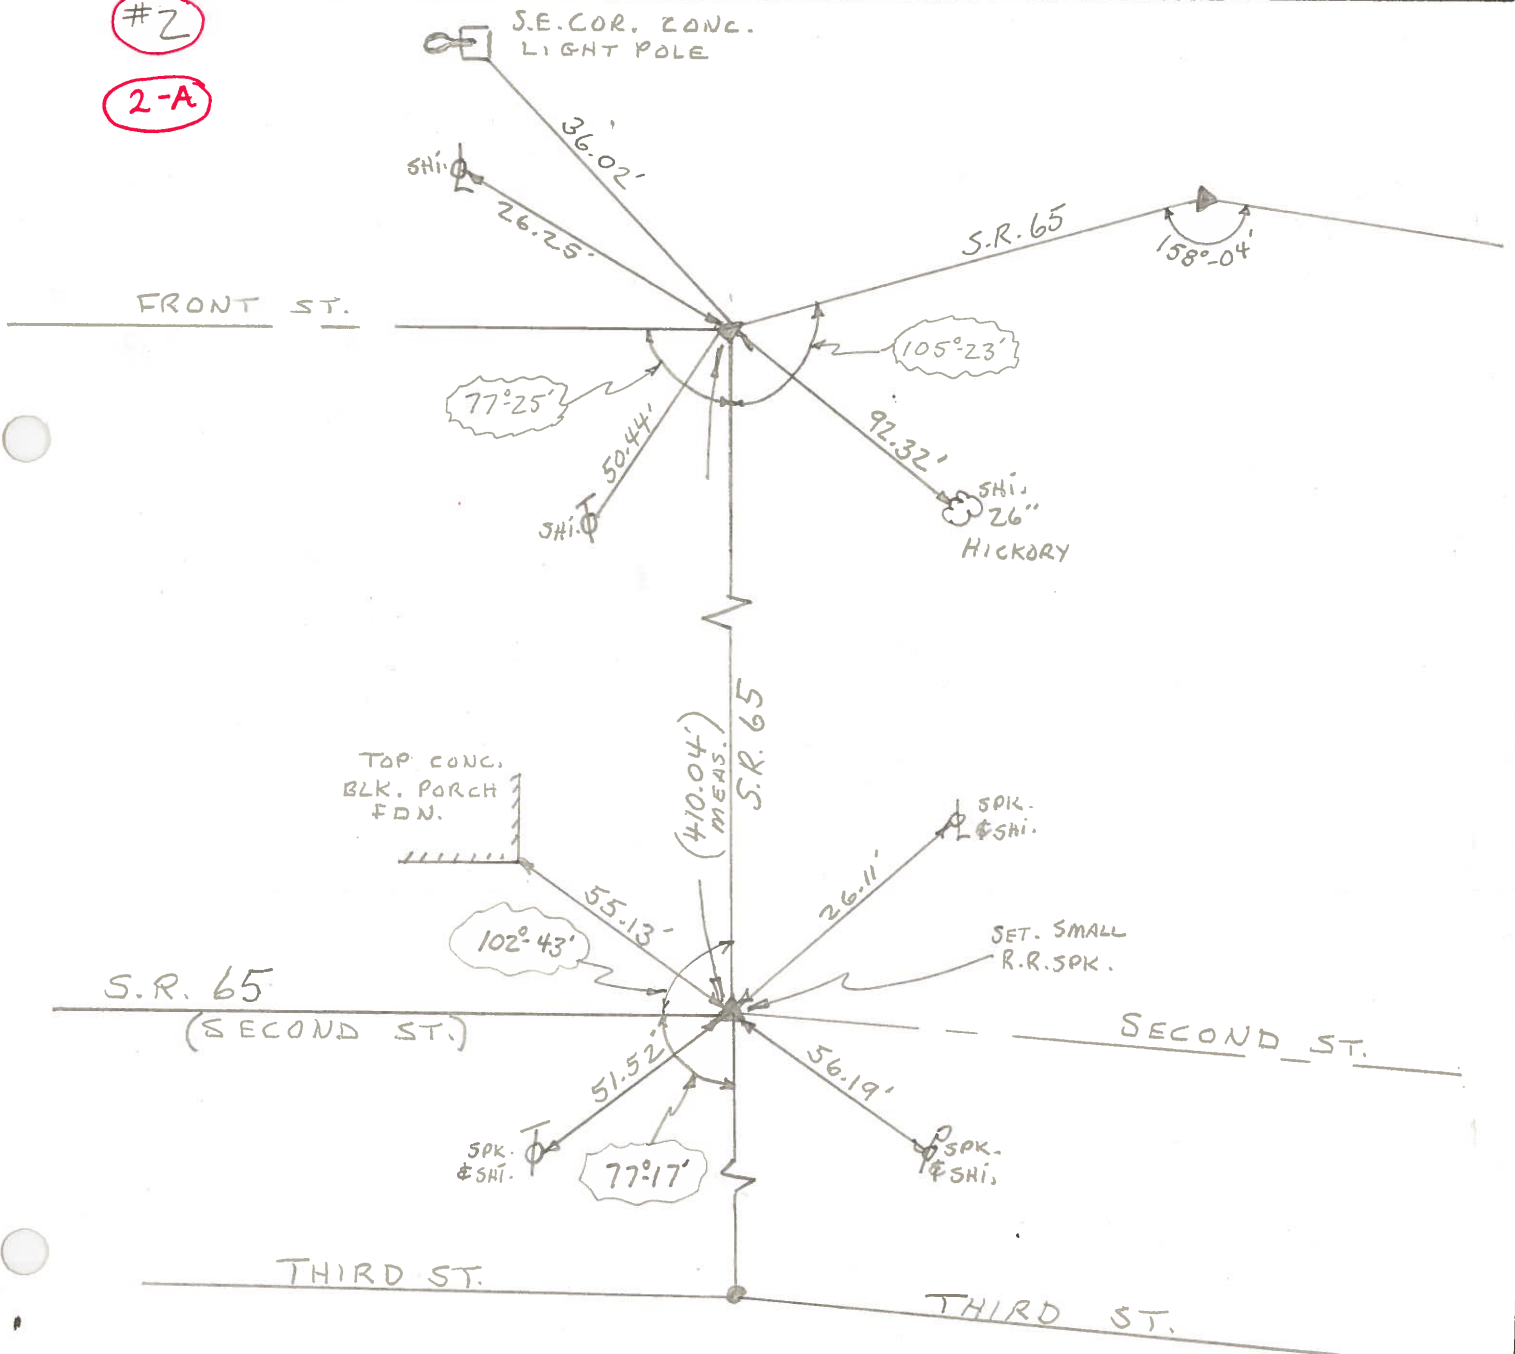

SHEET NO. _____

PERSONNEL TITLE PERSONNEL TITLE
 BURNSIDE _____ Kijowski _____
 SMITH _____
 BOWERS _____
 BAGDONAS _____

COUNTY Wood DATE 7-16-73
 S. R. 65 WEATHER Pt. Cloudy
 SEC. GRAND RAPIDS TEMP. +70°

DESCRIPTION CENTERLINE CONTROL TIES LEFT CENTER LINE RIGHT JOB NO. _____

