

O.D.O.T. DISTRICT 2 SURVEY OFFICE (USE ONLY)

PERSONNEL

REFERENCE NO. 2468

SHEET 1 OF 2

NOTES RHOADES

DATE 4/12/22

ROUTE CR 189

H.C. NIESE

WEATHER SUNNY

COUNTY WOOD

R.C. KETNER
O'DONNELL

TEMP. 44°

TOWNSHIP GRAND RAPIDS

DWG BY RHOADES PID 95796

SECTION 7

T 5 N R 9 E


TYPE MONUMENT LG.R.R.SPIKE

~~ON SURFACE~~ - BELOW 4 1/2"

OFFSET \varnothing PAVEMENT 6' LT : ~~RT~~

- TO - EDGE PAVEMENT

STATION: 195+19.40

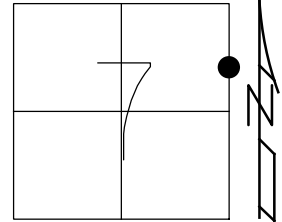


HORZ.DATUM: NAD83 2011

GEOID: NAVD88 2018

GRID: NORTHING: 638359.071

EASTING: 1594349.742


RECORD: P.I.
FD R.R.SPIKE
SV2468
FD LG.R.R.SPIKE
4 1/2" DOWN
SV2468
4/12/22, TDN
SET MAG/WASHER
10/4/22, TDN

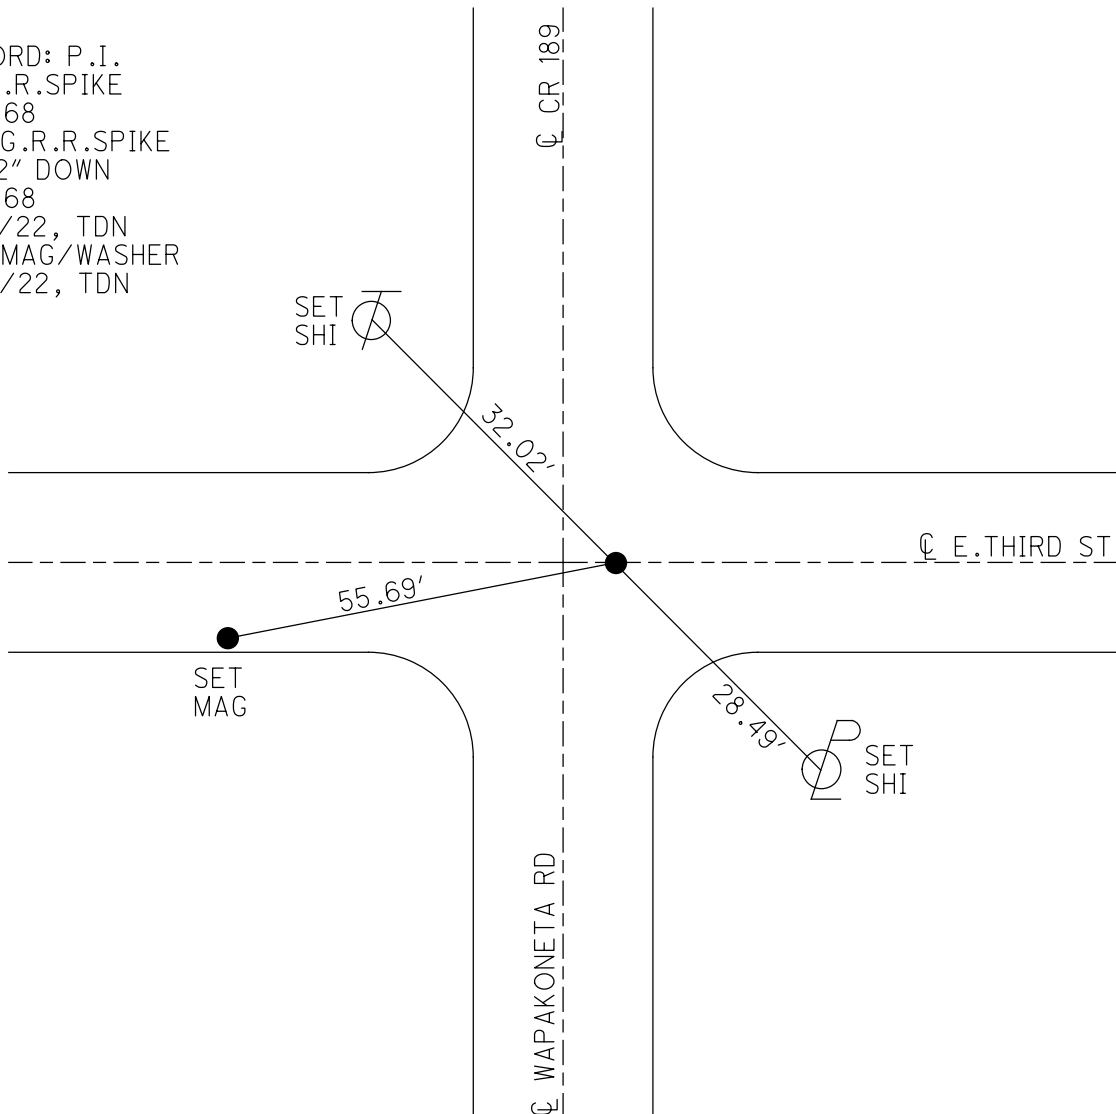

I:\64000\00045\11253_GR_WAPAKONETA\Design\Roadway\Sheets\11253_08001.dgn 7/6/2021 3:36:49 PM HCR-gft

POINT #	NORTHING	EASTING	ELEVATION	FEATURE	STATION	OFFSET
CL1	638275.1300	1595060.0110	661.17	IPIN	BRIDGE ST/THIRD ST INTERSECTION	
CL2	638761.5970	1594350.2640	659.93	MAG	199+21.80	0.00'
CL3	638639.2980	1593805.8930	660.73	MAG	MILL ST/SR-65 INTERSECTION	
SV1322	637762.6490	1594319.2450	662.45	IPIN	189+22.84	30.29' LT
SV1957	637400.3820	1594349.4460	665.80	IPIPE/SCOR	185+60.58	0.00'
SV1958	634730.4220	1594322.9210	670.18	MAG/SCOR	LONG JUDSON/CR-189 INTERSECTION	
SV2468	638359.1990	1594349.6860	663.78	RSPK	195+19.40	0.00'
HV1	637225.5110	1594321.2970	666.83	MAGS	183+85.54	26.26' LT.
HV2	638152.6570	1594366.0590	661.87	CNPT	193+12.86	16.43' RT.
HV3	638379.6670	1594319.2450	662.92	MAGS	195+39.87	30.47' LT.
HV4	638728.7010	1594370.9870	660.42	CNPT	198+88.93	20.77' RT.

REF2
REFE1
SV1957
SV2468

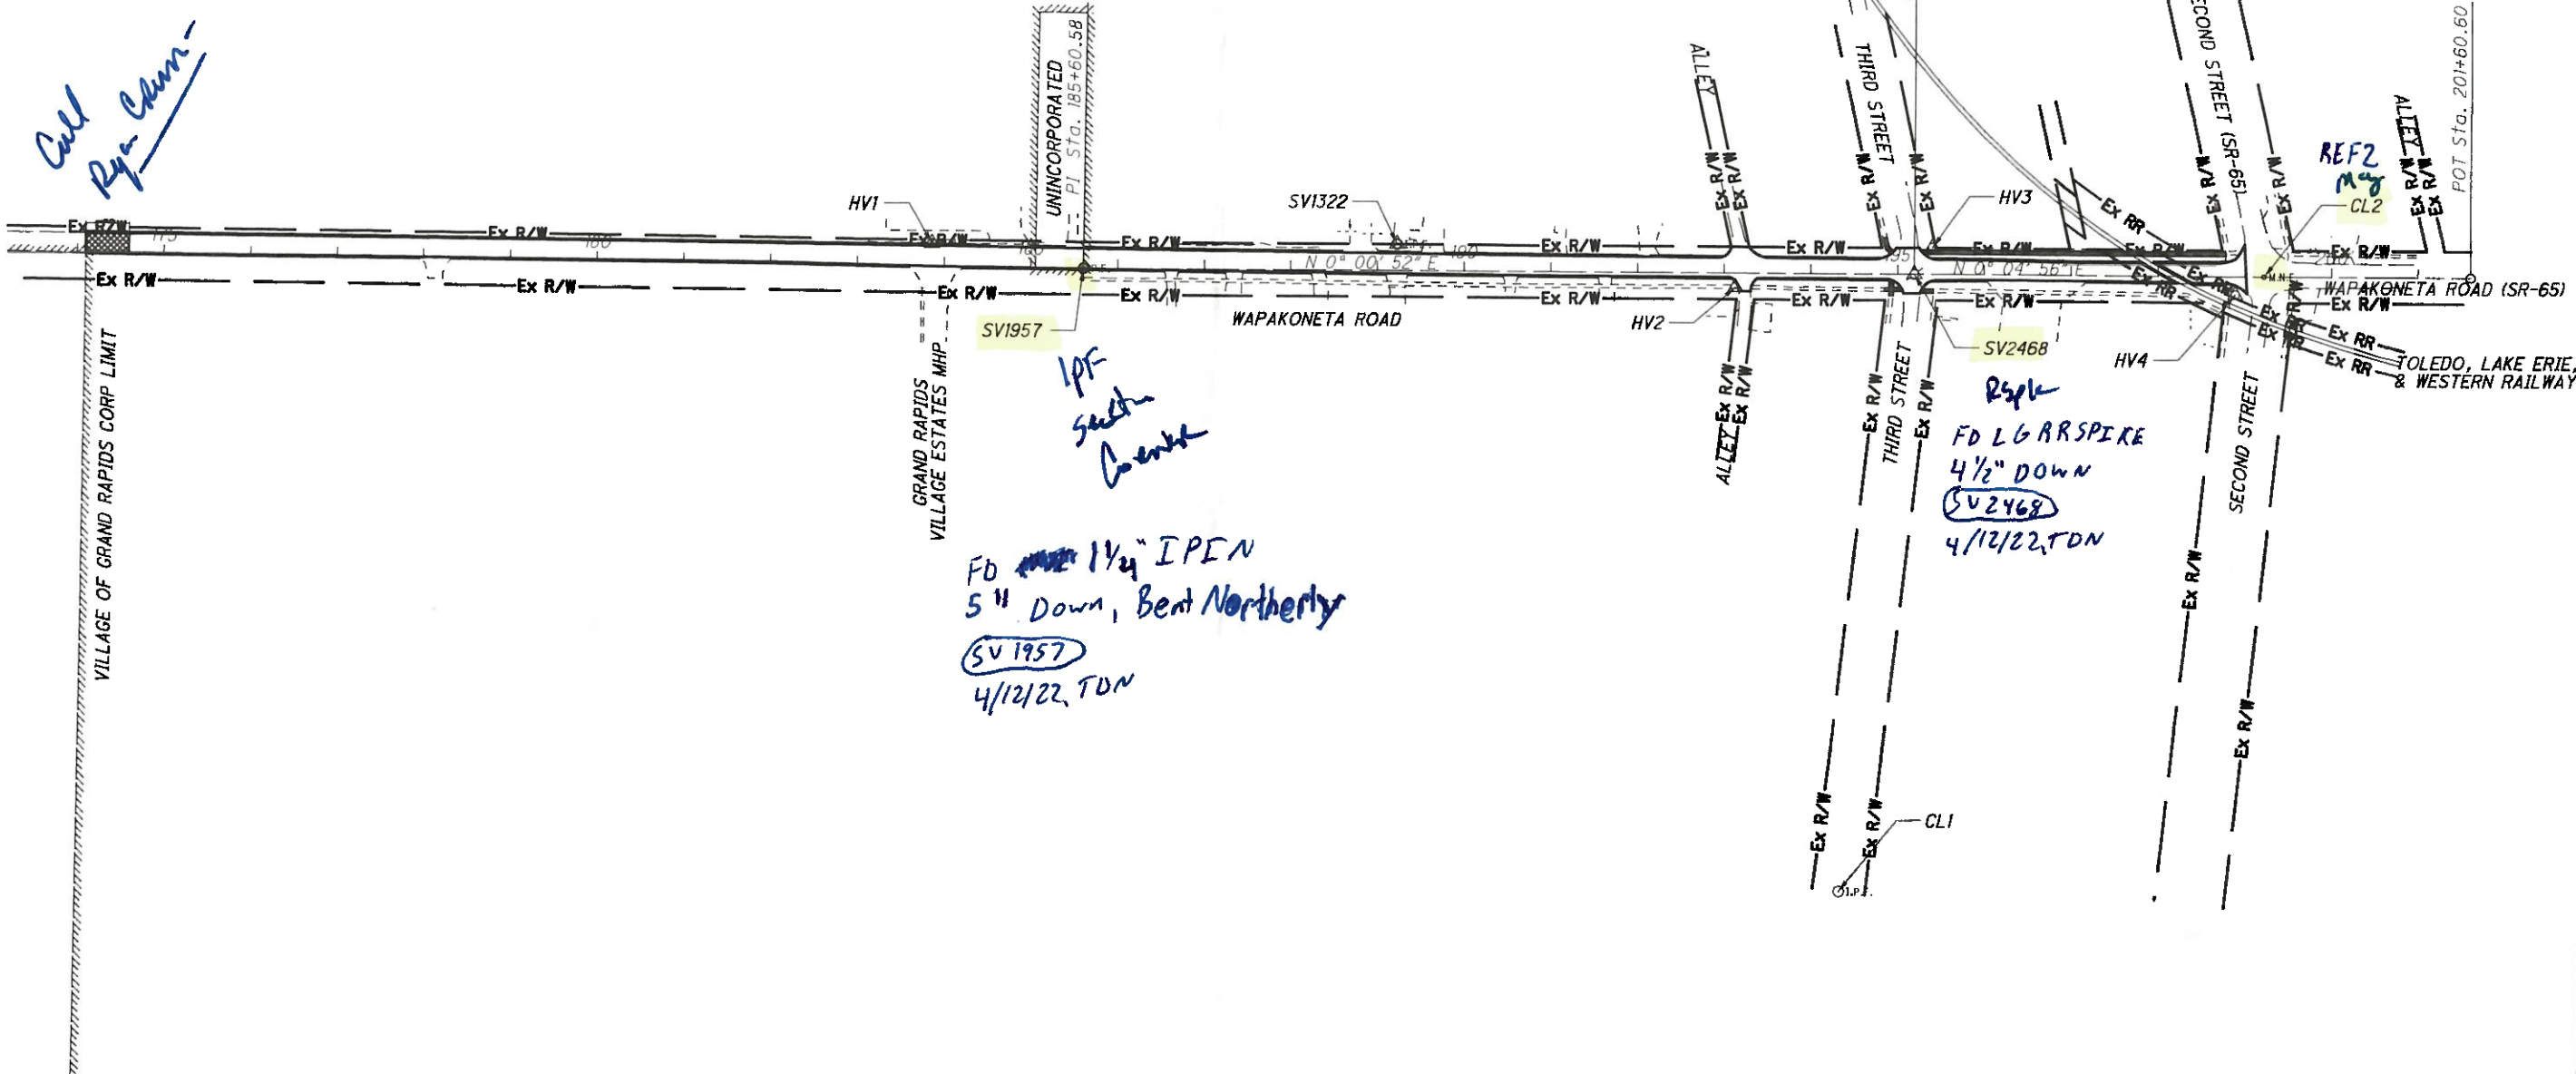

Call
Rys-Column

FD 1 1/4" IPIN
5" Down, Bent Northerly
SV1957
4/12/22 TDN

Rys
FD LG RR SPIKE
4 1/2" DOWN
SV2468
4/12/22 TDN

N

0 50 100
HORIZONTAL SCALE IN FEET

CALCULATED
HAC
CHECKED
TJB

SCHEMATIC PLAN

WAPAKONETA RD
GRAND RAPIDS

2
19