

O.D.O.T. DISTRICT 2 SURVEY OFFICE (USE ONLY)

PERSONNEL

REFERENCE NO. 2 A

SHEET 11 OF 40

NOTES O'DONNELL

DATE 10/30/20

ROUTE SR 65

H.C. AUBLE

WEATHER CLOUDY

COUNTY WOOD

R.C. O'DONNELL

TEMP. 38°

TOWNSHIP GRAND RAPIDS

SECTION 7

DWG BY RHOADES

PID 95796

T 5 N R 9 E

TYPE MONUMENT P.K.SHANK

ON SURFACE - ~~BELOW~~ ON

OFFSET \varnothing PAVEMENT 1.1' LT : ~~RT~~

- TO - EDGE PAVEMENT



STATION: 57+65.30

HORIZ.DATUM: NAD83 2011

GEOID: NAVD88 2018

GRID: NORTHING: 639165.232

EASTING: 1594350.682

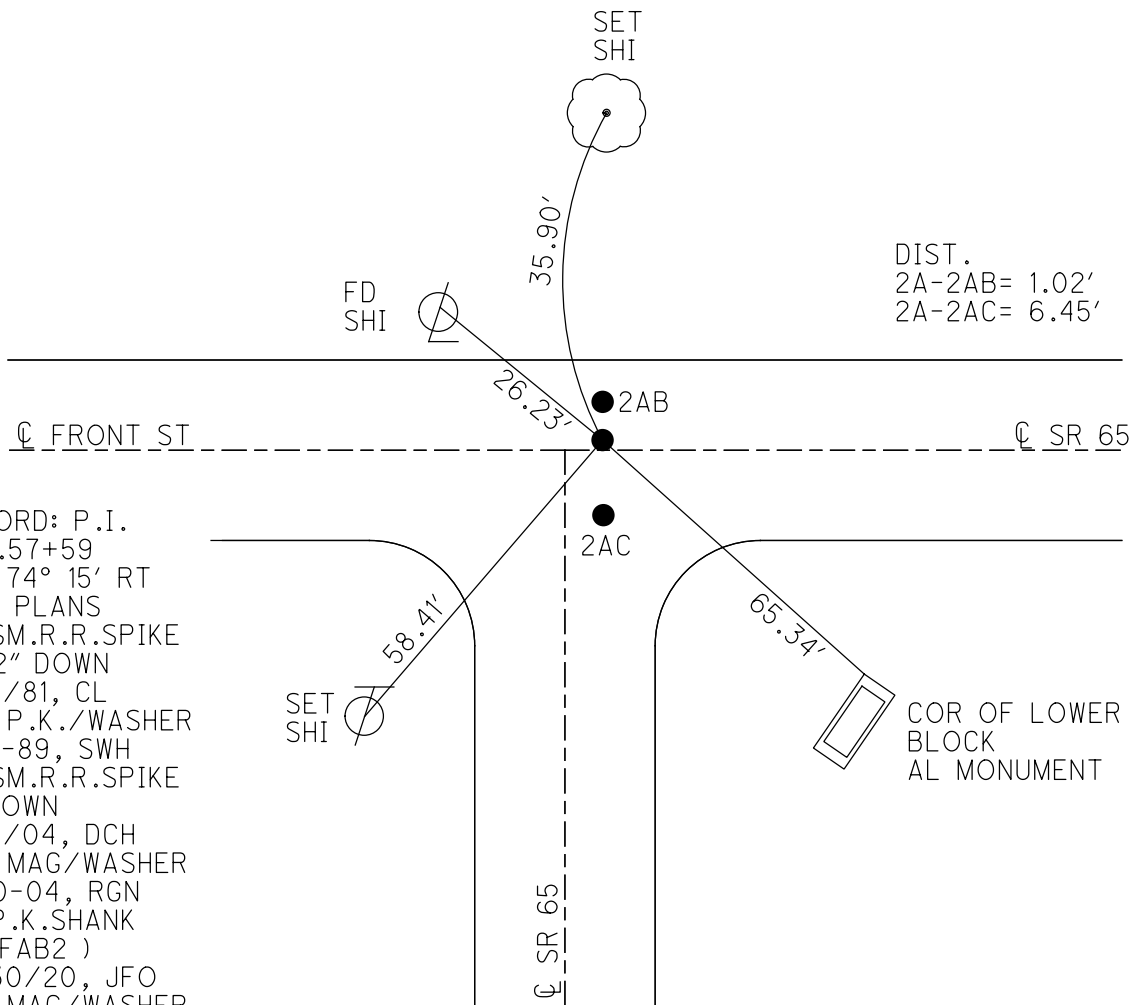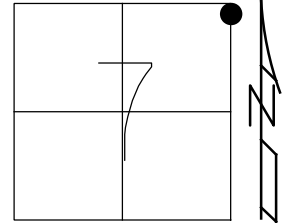

RECORD: P.I.
 STA. 57+59
 $\Delta = 74^\circ 15' RT$
 1925 PLANS
 FD SM.R.R.SPIKE
 1 1/2" DOWN
 12/3/81, CL
 SET P.K./WASHER
 11-21-89, SWH
 FD SM.R.R.SPIKE
 4" DOWN
 6/17/04, DCH
 SET MAG/WASHER
 9-20-04, RGN
 FD P.K.SHANK
 (REFAB2)
 10/30/20, JFO
 SET MAG/WASHER
 10/4/22, TDN

O.D.O.T. DISTRICT 2 SURVEY OFFICE (USE ONLY)

PERSONNEL

REFERENCE NO. 2 A

SHEET 11 OF 16

NOTES HOMAN
 H.C. HUSS
 R.C. NUHFER

DATE 6/17/04
 WEATHER CLOUDY
 TEMP. 84° F

ROUTE SR 65
 COUNTY WOOD
 TOWNSHIP GRAND RAPIDS
 SECTION 7
 T 5 N R 9 E

DWG BY RHOADES PID _____

TYPE MONUMENT SM.R.R.SPIKE

~~ON SURFACE~~ - BELOW 4"


OFFSET \odot PAVEMENT 1.1' LT : ~~RT~~

~~-~~ TO ~~-~~ EDGE PAVEMENT


STATION: 57+68

HORIZ.DATUM: - GEOID: -

GRID: NORTHING: - EASTING: -

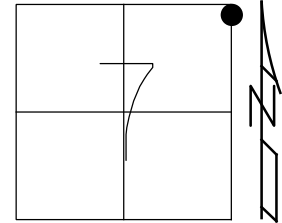

RECORD: P.I.
 STA.57+59
 $\Delta = 74^\circ 15' RT$
 1925 PLANS
 FD SM.R.R.SPIKE
 1 1/2" DOWN
 12/3/81, CL
 SET P.K./WASHER
 11-21-89, SWH
 SET MAG/WASHER
 9-20-04, RGN

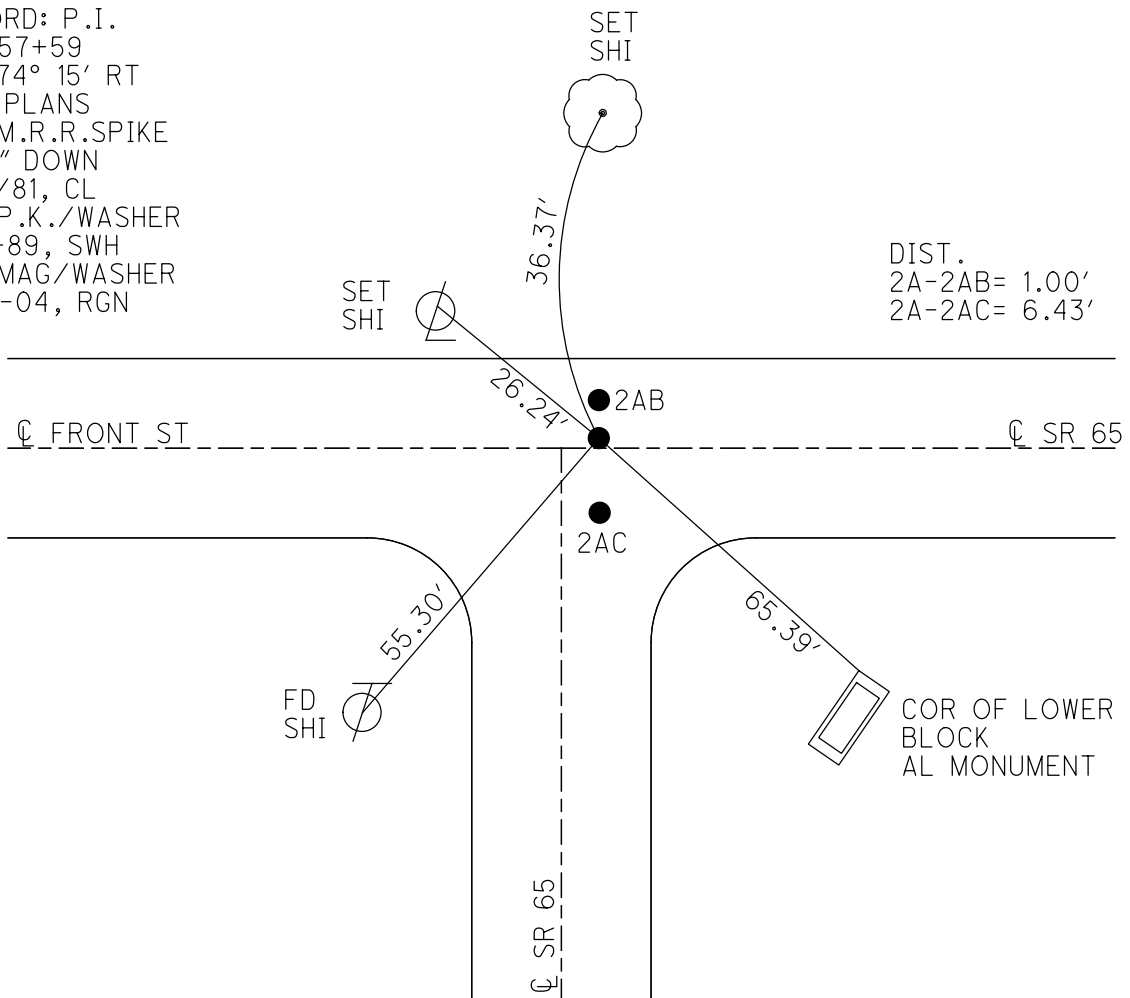

O.D.O.T. DISTRICT 2 SURVEY OFFICE

PERSONNEL _____

REFERENCE NO. 2-A

SHEET 9 OF 49

NOTES Huss

H.C. Homan

R.C. Adkins

DATE 6-17-04

WEATHER Cldy

TEMP. +84°F

ROUTE S.R. 65


COUNTY Wood

TOWNSHIP Grand Rapids

SECTION 7

T 5 N R 9 E

TYPE MONUMENT A - Small RR Spk
B - 2 1/2 RR Spk
~~ON SURFACE~~ BELOW All - 4" Below
~~LEFT & PAV'T~~ RIGHT A 1.1' Lt
9.5' TO Lt. EDGE PAVEMENT
 S.L.M. 57 + 68

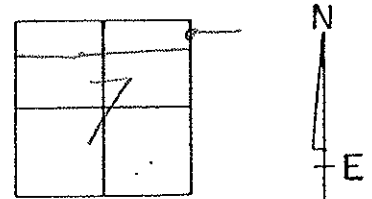


Record: Origin
Unknown

Set N/Shi
in 15"
tree

A - 36.37'
B - 35.45'
C - 42.52'

Set PK/Washer
11-21-89
SWH

Set Mag/Wch
All pts.
9-20-04
RGN

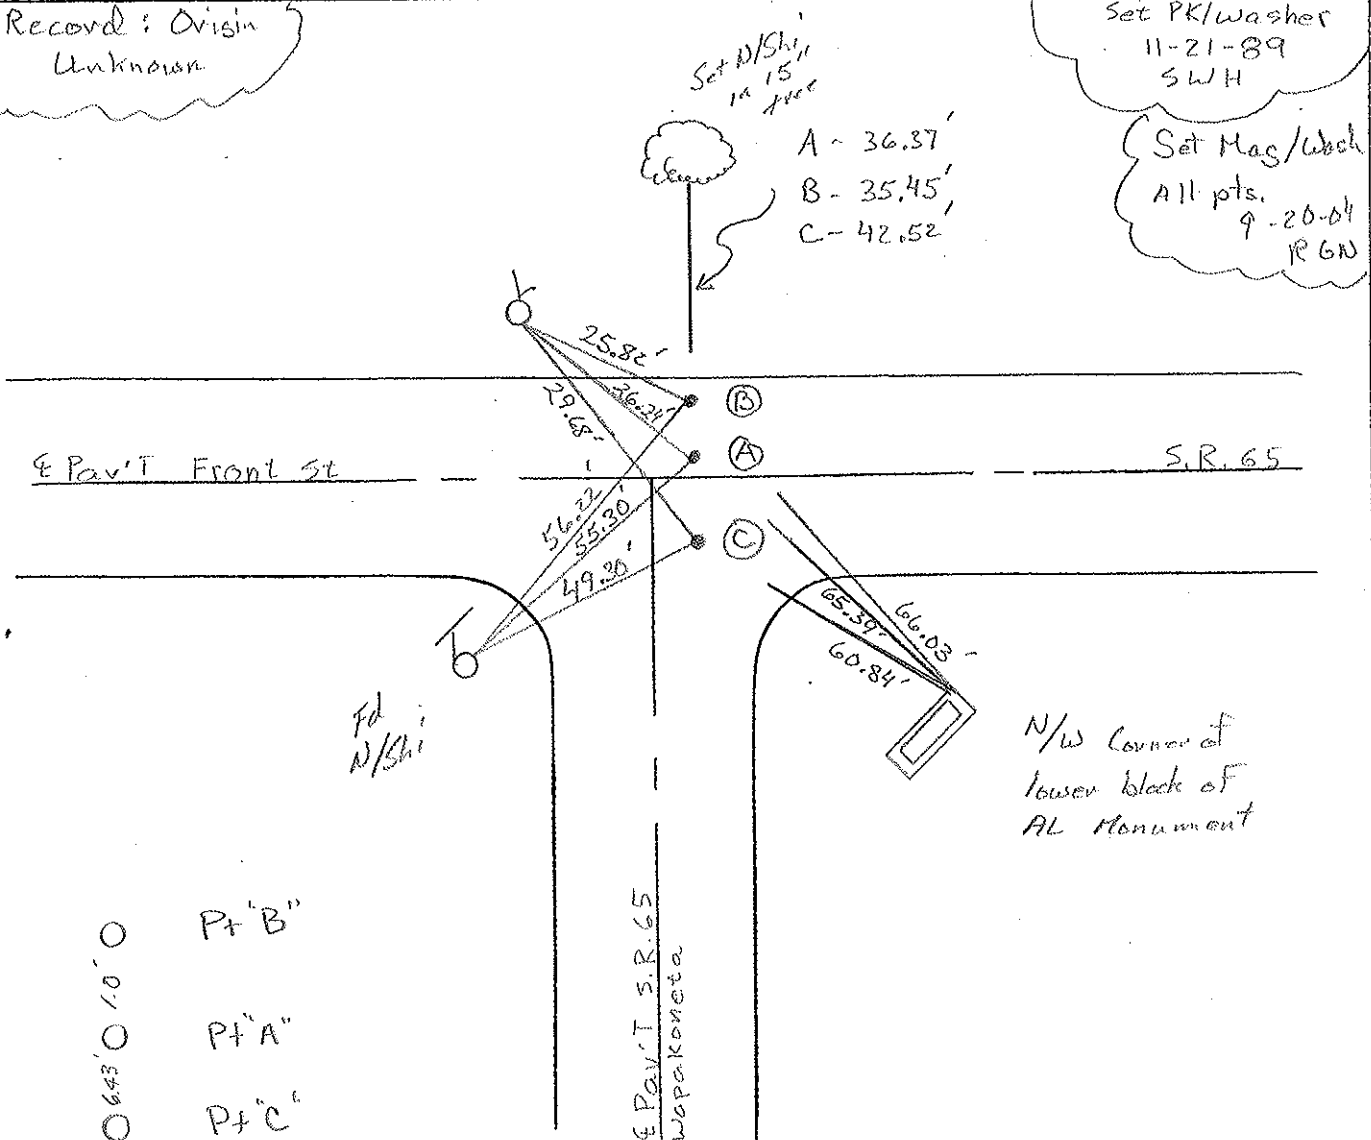

O.D.O.T. DISTRICT 2 SURVEY OFFICE

PERSONNEL

REFERENCE NO. 2-A

SHEET 5 OF 12

NOTES HOFFMAN

H.C. LOSHRKE

R.G. BARNHISEL

DATE 9-7-89

WEATHER CLEAR

TEMP. 88°

ROUTE SR 65

COUNTY WOOD

TOWNSHIP GRAND RAPIDS

SECTION 7

T5 N R 9 E

TYPE MONUMENT "A" SMALL R.R. SPIKE


~~ON SURFACE~~ - BELOW 1 1/2"

~~LEFT-PAV'T - RIGHT~~ 1.7'

~~TO~~ EDGE PAVEMENT 2.3' E. & SOUTH

S.L.M. 57 + 68



Set P.K./WASHER
11-21-89
SWH

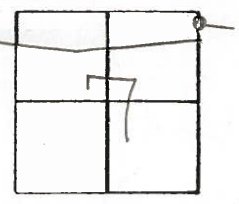

"B" = ORIGIN UNKNOWN
Fd. R.R. SPK / "A" AT SURFACE

PTS. "B" & "C" Set P.K. NAIL
11-21-89
SWH

"C" = ORIGIN UNKNOWN
Fd. BENT R.R. SPK AT SURFACE

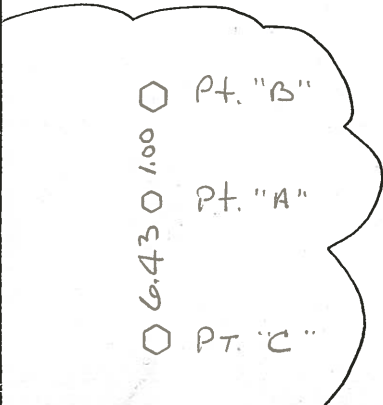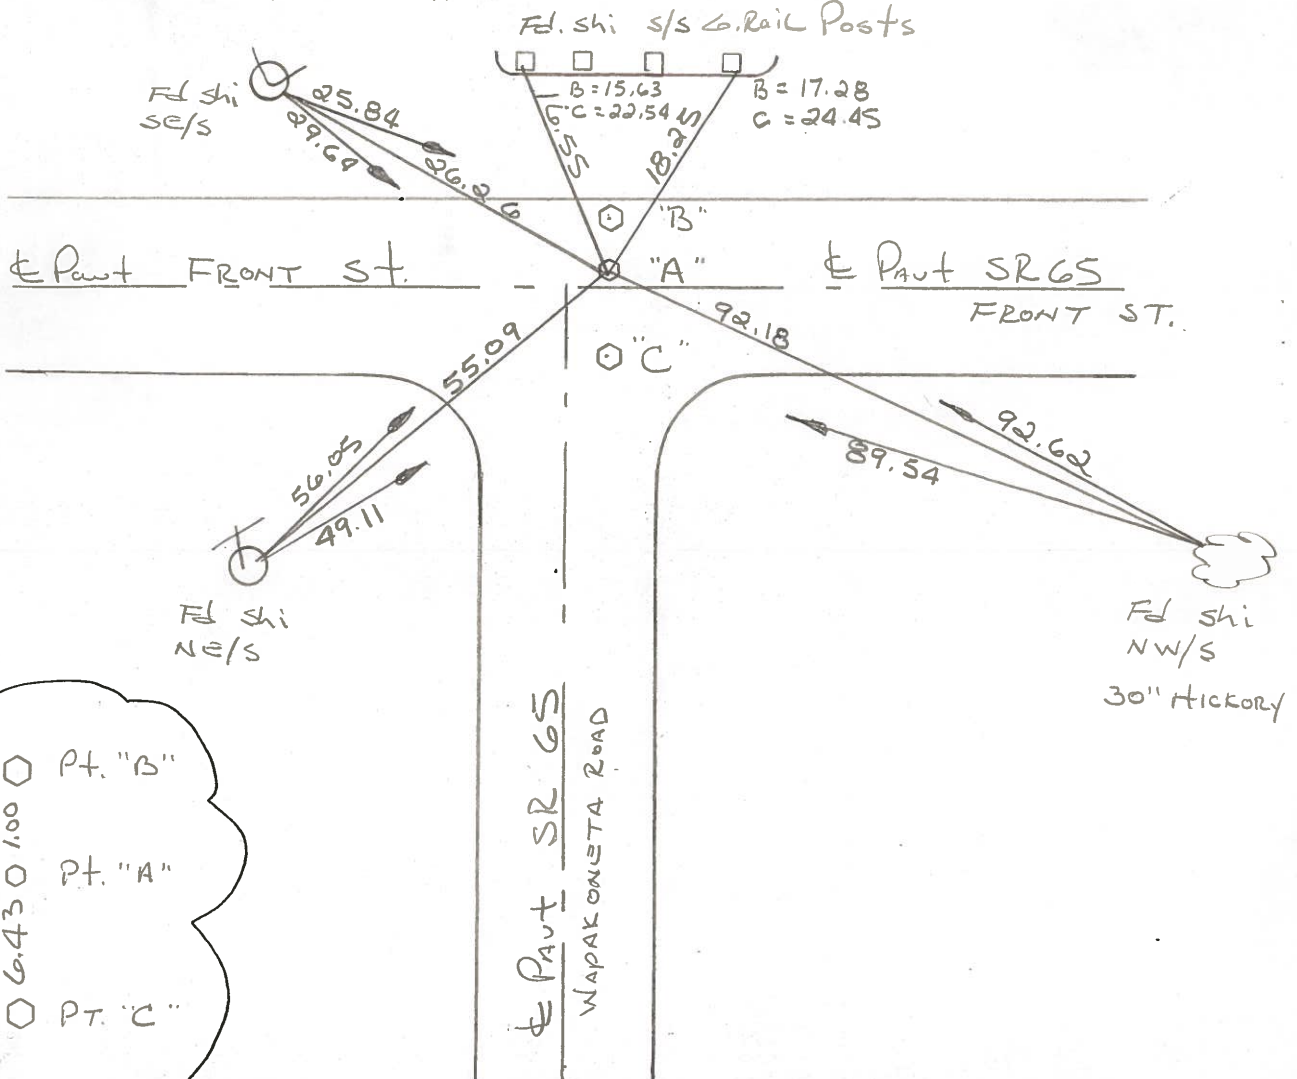

PAV'T SR 65
WAPAKONETA ROAD

Fd Shi NW/S
30" HICKORY

County Wood S.R. 65

Date 12-3-81

Township Grand Rapids

Weather Clear

Section 7 @ Grand Rapids

Temp. +40°


T&N, R&E

Personnel Hoffman


Loehrke

Householder

2-A
(Pt. "A")

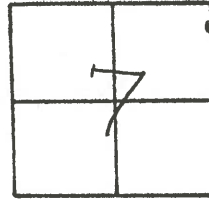


Pt. "A" Fd. small R.R. SPK, 1 1/2" Below surface
1.7' N. of & PAUT S.R. 65 EAST
2.3' E. of & PAUT S.R. 65 south

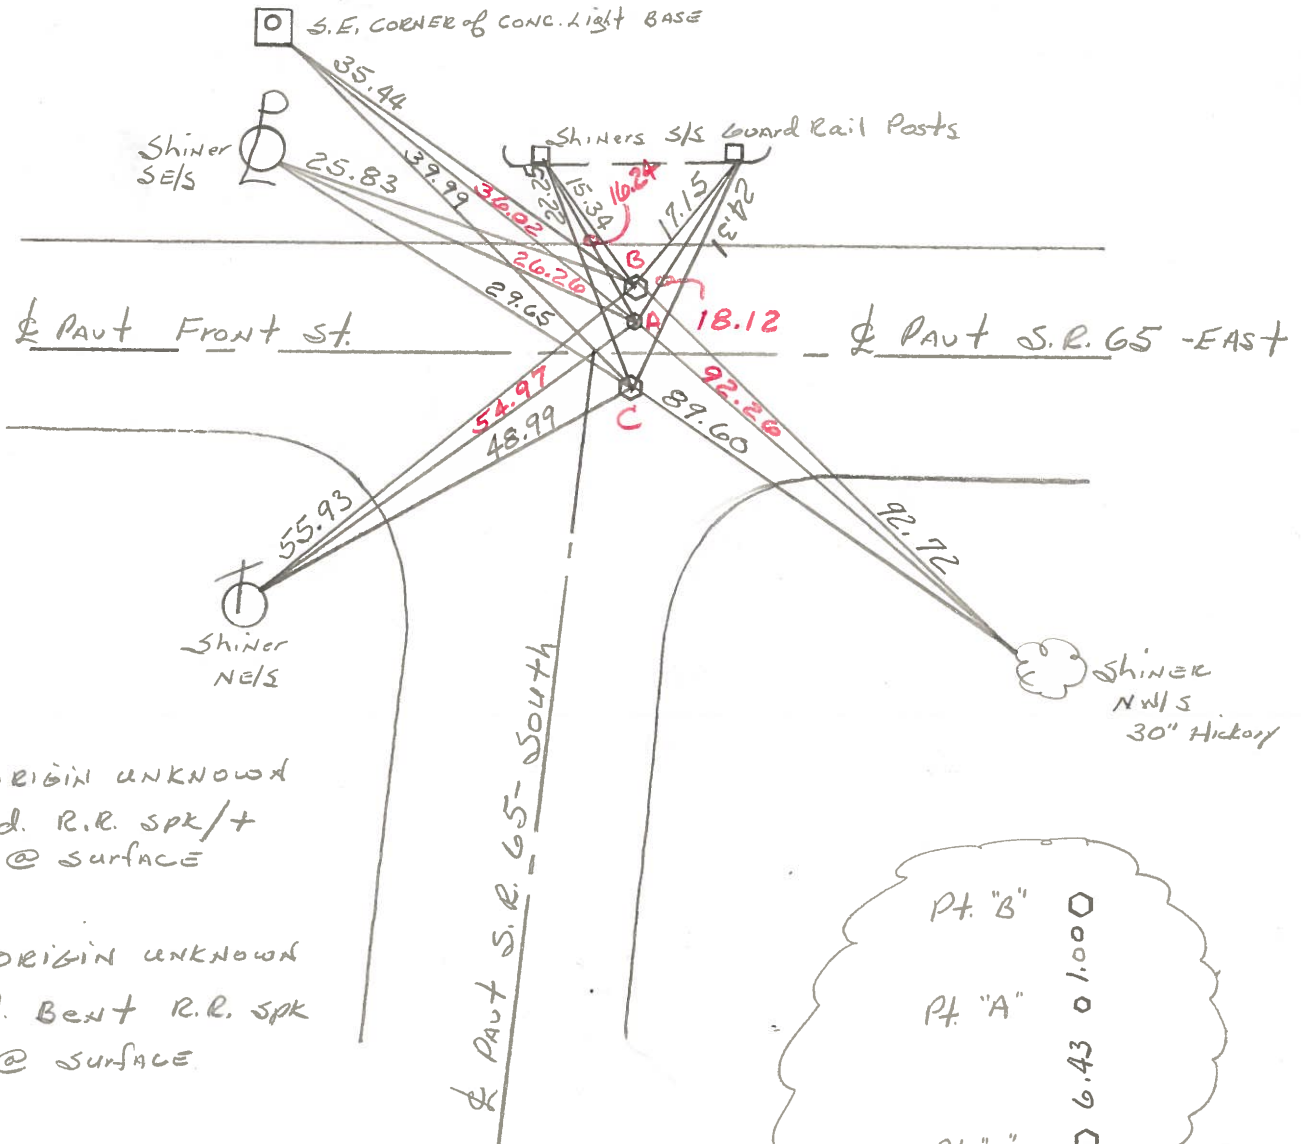

Pt. "B" ORIGIN UNKNOWN
Fd. R.R. SPK/+
@ SURFACE

Pt. "C" ORIGIN UNKNOWN
Fd. Bent R.R. SPK
@ SURFACE

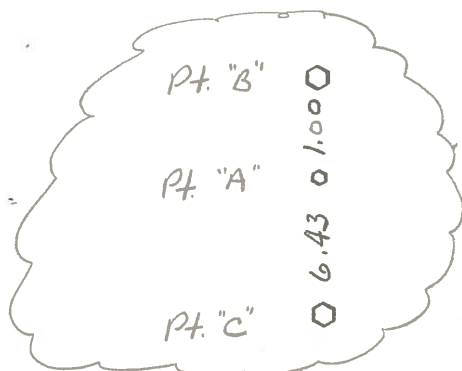

O.D.O.T. DISTRICT 2 SURVEY OFFICE

SHEET

OF

County WOOD S.R. 65

Date 7-16-73

Township GRAND RAPID

Weather PT. CLOUDY

Section 7

Temp. 70°

T5N, R9E


Personnel BURNSIDE

SMITH

BOWERS


BAGDANAS

KILOWSKI

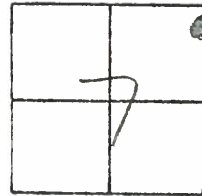

#2

2-A

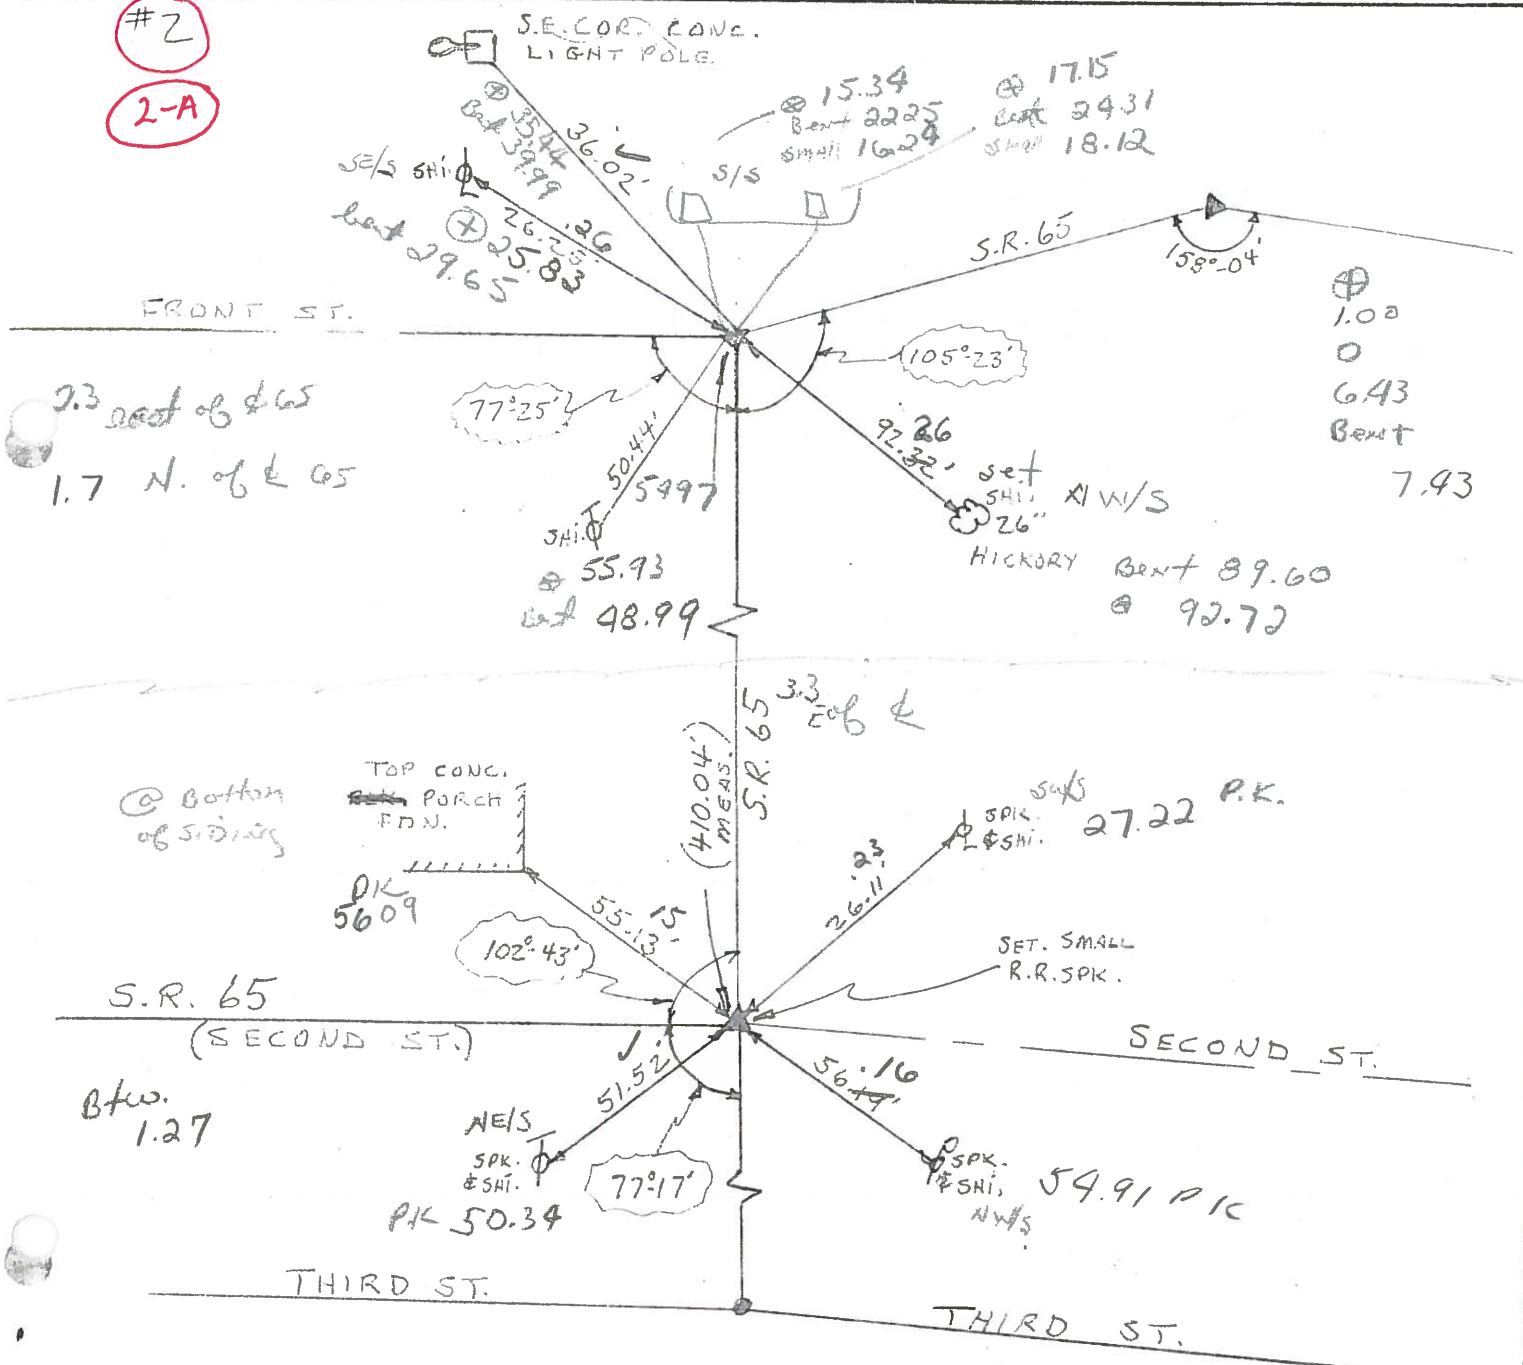

O.D.O.T. DISTRICT 2 SURVEY OFFICE

SHEET

OF

County WOOD S.R. 65

Date 7-16-73

Township GRAND RAPID

Weather PT. CLOUDY

Section 7

Temp. 70°

T5N, R9E


Personnel BURNSIDE

SMITH

BOWERS

BAGDANAS

KIJAWSKI

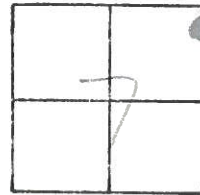

#2

2-A

