

O.D.O.T. DISTRICT 2 SURVEY OFFICE (USE ONLY)

PERSONNEL

REFERENCE NO. 3 A

SHEET 17 OF 40

NOTES RHOADES DATE 3/29/22  
 H.C. NIESE WEATHER CLEAR  
 R.C. KETNER TEMP. 27°  
AUBLE, O'DONNELL

ROUTE SR 65  
 COUNTY WOOD  
 TOWNSHIP GRAND RAPIDS  
 SECTION 8  
 T 5 N R 9 E

DWG BY RHOADES PID 95796

TYPE MONUMENT MAG NAIL

~~ON SURFACE~~ - BELOW 3 1/2"

OFFSET  $\text{C}$  PAVEMENT 2.4'  $\text{RT}$  : RT  
7.5' TO RT EDGE PAVEMENT


STATION: 68+03.68

HORIZ.DATUM: NAD83 2011


GEOID: NAVD88 2018

GRID: NORTHING: 639177.637

EASTING: 1595375.520

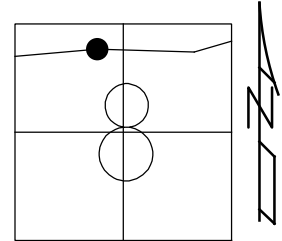

RECORD: P.I.  
 $\Delta = 0^\circ 37' \text{ LT}$   
 FD LG. R.R. SPIKE  
 6-18-04, DCH  
 FD LG.R.R.SPIKE  
 6/18/04, DCH  
 SET MAG/WASHER  
 9-20-04, RGN  
 FD MAG NAIL  
 REFA3  
 3-10-15, EBW  
 10/28/20, JFO  
 SET MAG/WASHER  
 10/4/22, TDN

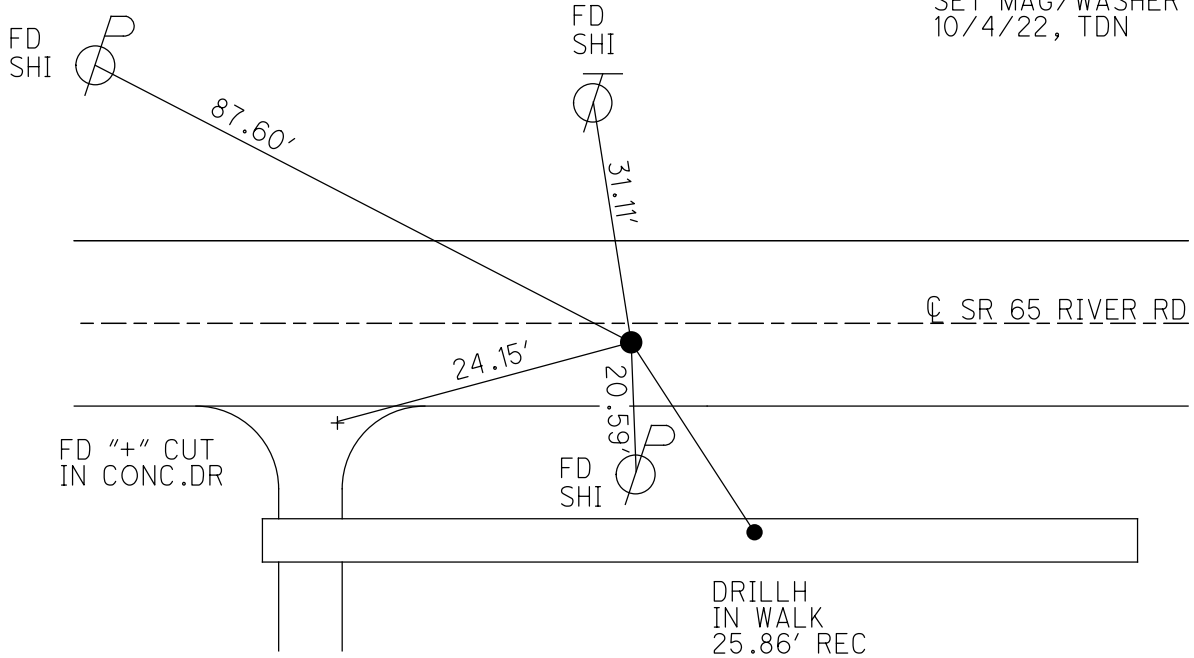



# O.D.O.T. DISTRICT 2 SURVEY OFFICE

PERSONNEL

REFERENCE NO. 3-1


SHEET 12 OF 49

NOTES Huss  
 H.C. D. Homan  
 R.C. Adkins

DATE 6-18-04  
 WEATHER Cloudy  
 TEMP. \_\_\_\_\_


ROUTE S.R. 65  
 COUNTY Wood  
 TOWNSHIP Grand Rapids  
 SECTION 8  
T 5 N R 9 E

TYPE MONUMENT Lg. RR Spike  
~~ON SURFACE~~ - BELOW 3" below  
~~LEFT PAV'T.~~ - RIGHT 2.4' Rt.  
7.5' TO Rt. EDGE PAVEMENT  
 S.L.M. 68+11

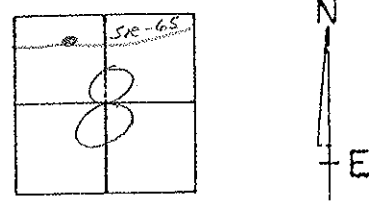

Record: PI  
 $\Delta = 0^\circ 37' LT$

Set Mag/Wash  
 9-20-04  
 RGN

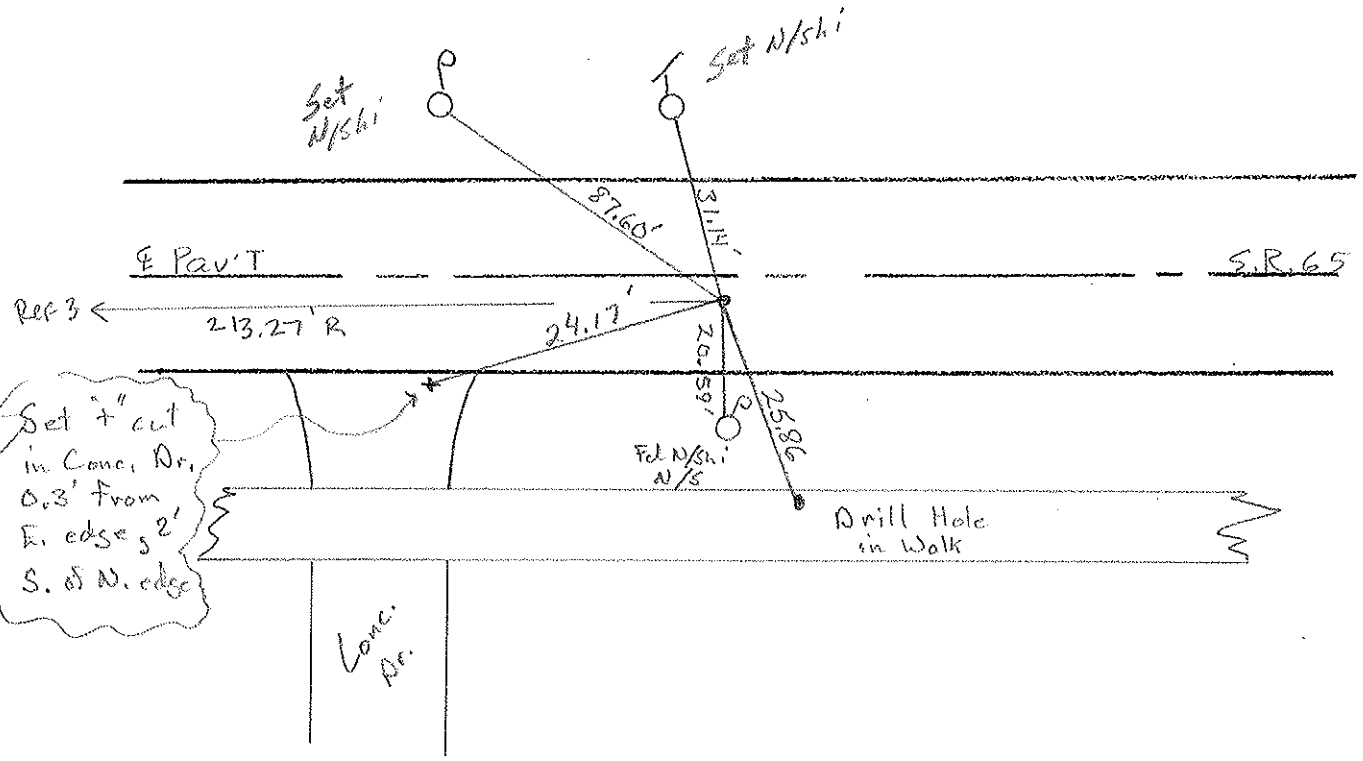



ODOT DISTRICT 2 SURVEY OFFICE

SHEET OF

County WOOD S.R. 65

Township GRAND RAPIDS

Section 8

T5N, R9E

Personnel BURNSIDE

SMITH

BOWERS


KIJOWSKI

BAGDONAS

Date 7-17-73

Weather CLEAR

Temp. 82°

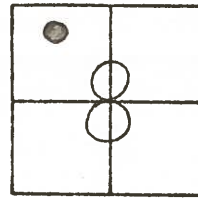


#3-A

12-9-81 work located with Schonstedt - painted - did not dig out.

REF. #2 ← 213.27 Rec. & MEAS.  
S.R. 65

S.R. 65

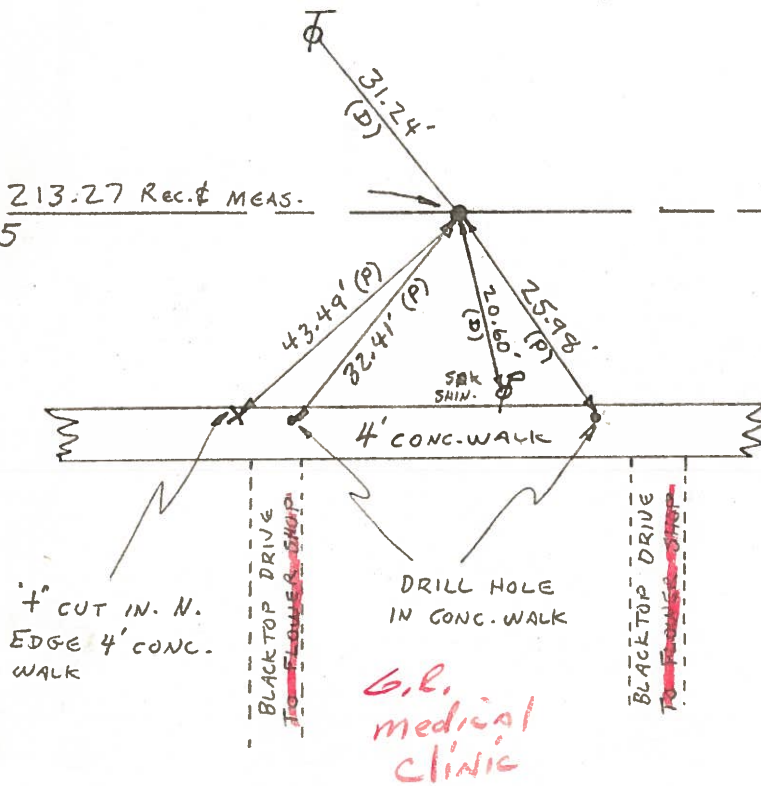

O.D.O.T. DISTRICT 2 SURVEY OFFICE

SHEET \_\_\_\_\_ OF \_\_\_\_\_

County WOOD S.R. 65

Date 7-17-73

Township GRAND RAPIDS


Weather CLEAR

Section 8


Temp. 82°

T5N, R9E

Personnel BURNSIDE  
SMITH  
BOWERS  
KIJOWSKI  
BAGDONAS

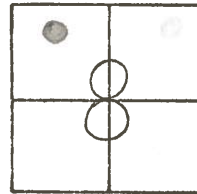

#3-A

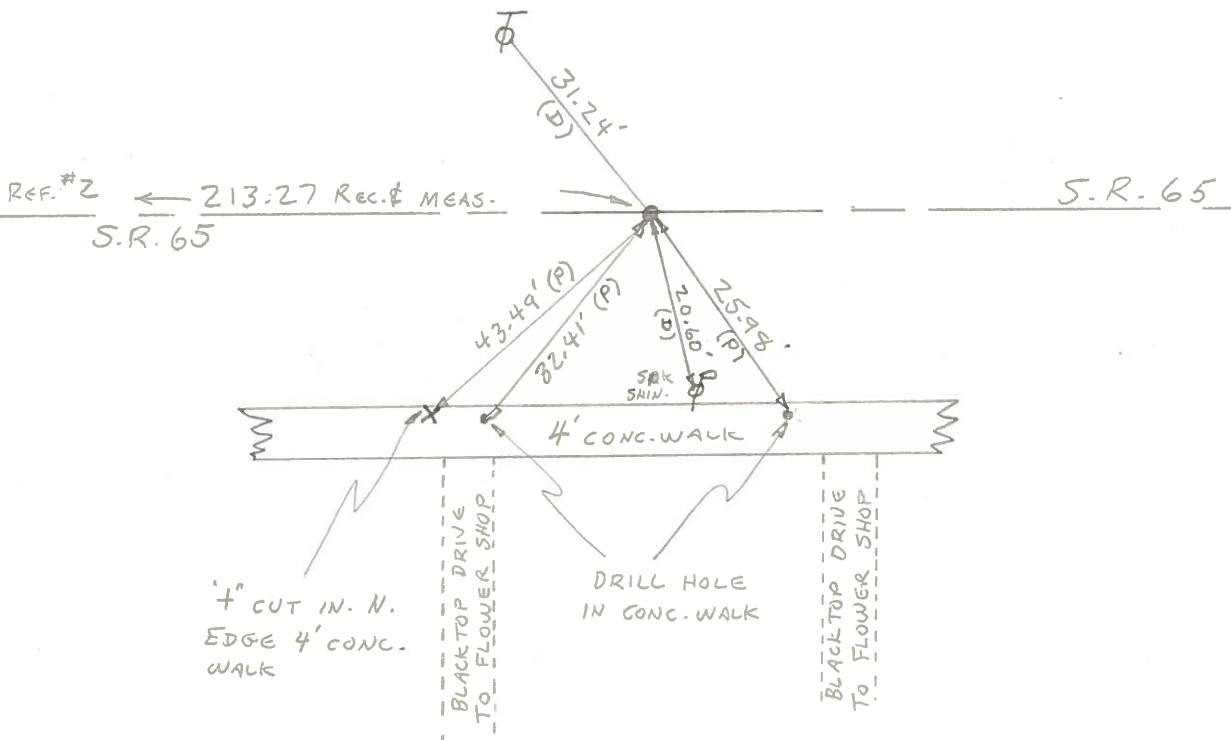

# O.D.O.T. DISTRICT 2 SURVEY OFFICE

PERSONNEL \_\_\_\_\_

REFERENCE NO. 3-B

SHEET 9 OF 12

NOTES HOFFMAN

H.C. LOEHLKE

DATE 9-11-89

ROUTE SR 65

R.C. \_\_\_\_\_

WEATHER CLEAR

COUNTY WOOD

\_\_\_\_\_

TEMP. 72°

TOWNSHIP GRAND RAPIDS

\_\_\_\_\_


SECTION 8

T.S. N 9 E

TYPE MONUMENT P.K. NAIL

Set P.K./WASHER  
11-21-89  
SWK

~~ON SURFACE~~ - BELOW 4"

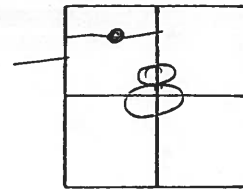

~~LEFT~~ - ~~PAV'T.~~ - RIGHT 0.5

10.3 TO RT. EDGE PAVEMENT

S.L.M. 76+28

