


O.D.O.T. DISTRICT 2 SURVEY OFFICE (USE ONLY)


PERSONNEL _____ REFERENCE NO. 3 E SHEET 21 OF 40
 NOTES RHOADES DATE 3/28/22 ROUTE SR 65
 H.C. NIESE WEATHER CLEAR COUNTY WOOD
 R.C. KETNER TEMP. 28° TOWNSHIP GRAND RAPIDS
AUBLE, O'DONNELL SECTION 8
 DWG BY RHOADES PID 95796 T 5 N R 9 E

TYPE MONUMENT MAG NAIL
 ON SURFACE - ~~BELOW~~ ON _____
 OFFSET \odot PAVEMENT 1.5' ~~LT~~ : RT
9.8' TO RT EDGE PAVEMENT
 STATION: 80+43.1

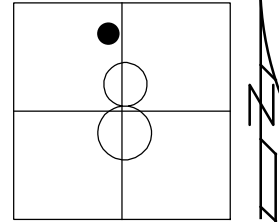

HORZ. DATUM: NAD83 2011 GEOID: NAVD88 2018
 GRID: NORTHING: 639048.240 EASTING: 1596608.176

RECORD:
 FD P.K./WASHER
 6/18/04, DCH
 SET MAG/WASHER
 9-20-04, RGN
 FD MAG NAIL
 REFE3
 11/2/20, JFO
 SET MAG/WASHER
 10/5/22, TDN

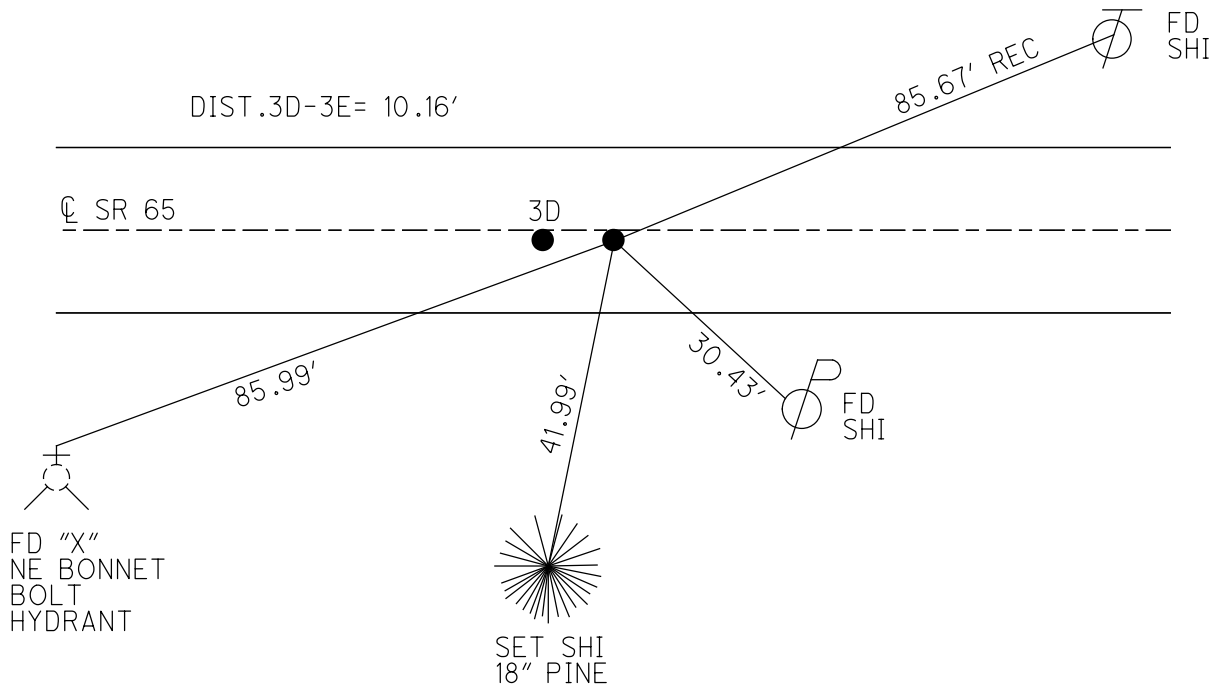

O.D.O.T. DISTRICT 2 SURVEY OFFICE (USE ONLY)

PERSONNEL _____

REFERENCE NO. 3 E

SHEET 4 OF 23

NOTES HUSS DATE 6/18/04

ROUTE SR 65

H.C. HOMAN WEATHER CLOUDY

COUNTY WOOD

R.C. ADKINS TEMP. 78° F

TOWNSHIP GRAND RAPIDS

SECTION 8

DWG BY AUBLE PID _____

T 5 N R 9 E

TYPE MONUMENT P.K./WASHER

ON SURFACE - ~~BELOW~~ ON _____


OFFSET \odot PAVEMENT 1.0' ~~LT~~ : RT

9.8' TO RT EDGE PAVEMENT


STATION: 80+47

HORZ.DATUM: _____ GEOID: _____

GRID: NORTHING: _____ EASTING: _____

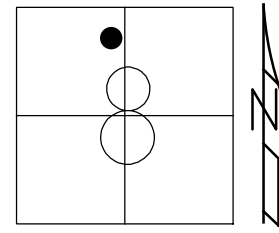

RECORD:
 FD P.K./WASHER
 6/18/04, DCH
 SET MAG/WASHER
 9-20-04, RGN

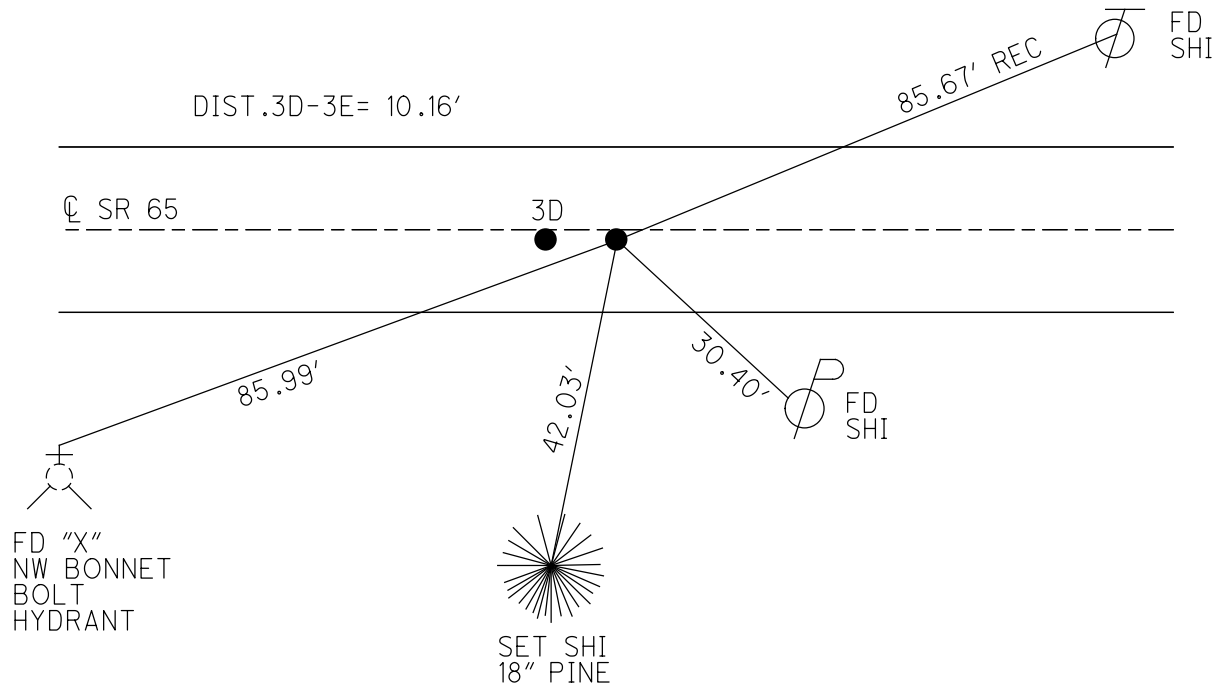

O.D.O.T. DISTRICT 2 SURVEY OFFICE

PERSONNEL

REFERENCE NO. 3-D

SHEET 15 OF 49

NOTES Huss

H.C. Homan

R.C. Adkins

DATE 6-18-04

WEATHER Cl'dy

TEMP. 78°F

ROUTE S.R. 65

COUNTY Wood

TOWNSHIP Grand Rapids

SECTION 8

T5 N R 9 E


TYPE MONUMENT PK/W

~~ON SURFACE~~ - ~~BELOW~~ Surface

~~REFINEMENT~~ - ~~RIGHT~~ 1' Rt.

9.8' TO Rt. EDGE PAVEMENT


S.L.M. 80+37

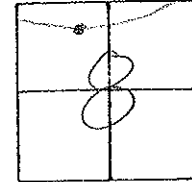

Record:

P.C. (12+30.24 Plan of 1931)
 $\Delta = 34^\circ - 52'$ $E = 55.17'$
 $D = 5^\circ - 00'$ $L = 677.33'$
 $T = 359.95'$ $R = 1146.28'$

Set Mag/W
 9-20-04
 RBW

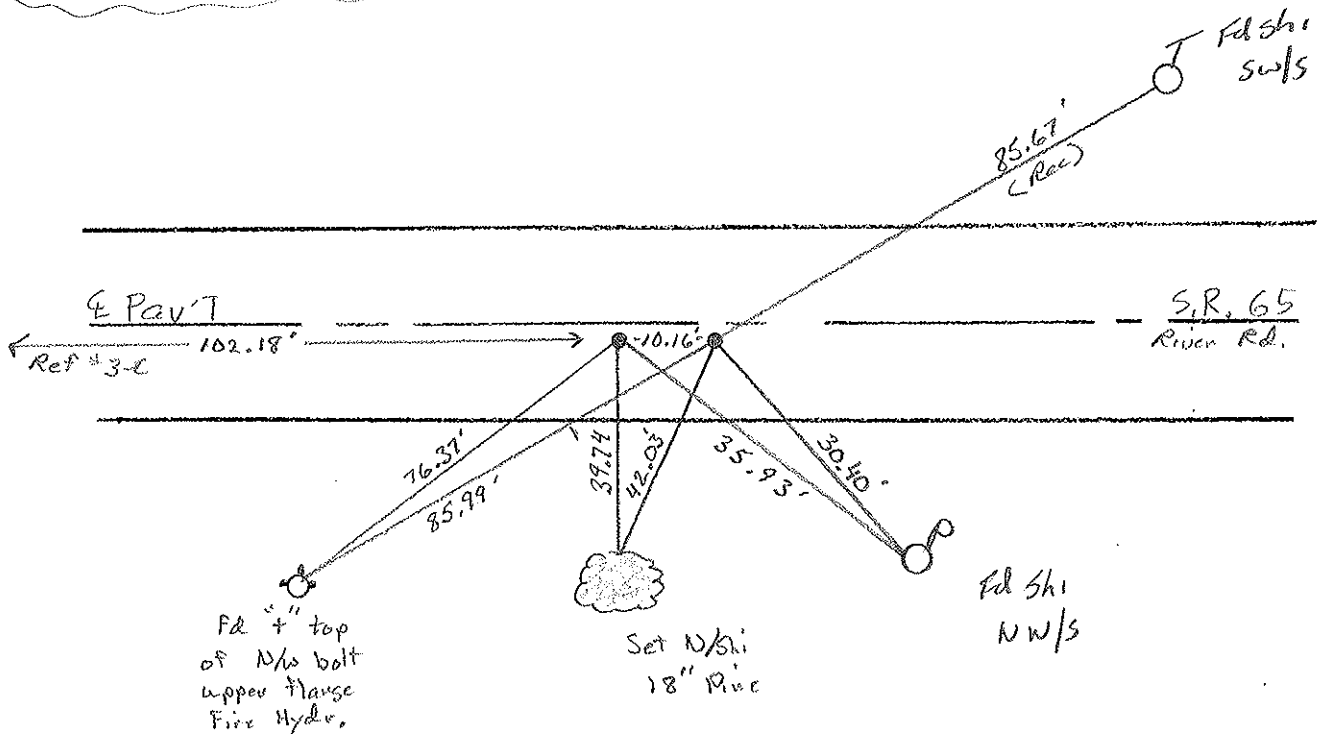

O.D.O.T. DISTRICT 2 SURVEY OFFICE

PERSONNEL _____

REFERENCE NO. 3-D

SHEET 11 OF 12

NOTES HOFFMAN

H.C. LOEHLER

DATE 9-11-89

ROUTE SR 65

R.C. _____

WEATHER CLEAR

COUNTY WOOD

TEMP. 78°

TOWNSHIP Grand Rapids

SECTION 8

T5 N R 9 E

TYPE MONUMENT SMALL R.R. SPIKE


~~ON-SURFACE~~ - BELOW 1 1/2"

Set P.K./WASHER
11-21-89
SWH

~~LEFT-C~~ PAV'T. - RIGHT 0.6'

9.3 TO RT EDGE PAVEMENT

S.L.M. 80+37

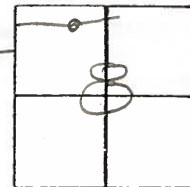


RECORD:

P.C. (12+30.24 PLAN OF 1931)

$\Delta = 34^\circ - 52'$ $E = 55.17$

$D = 5^\circ - 00'$ $L = 697.33$


$T = 359.95$ $R = 1146.28'$

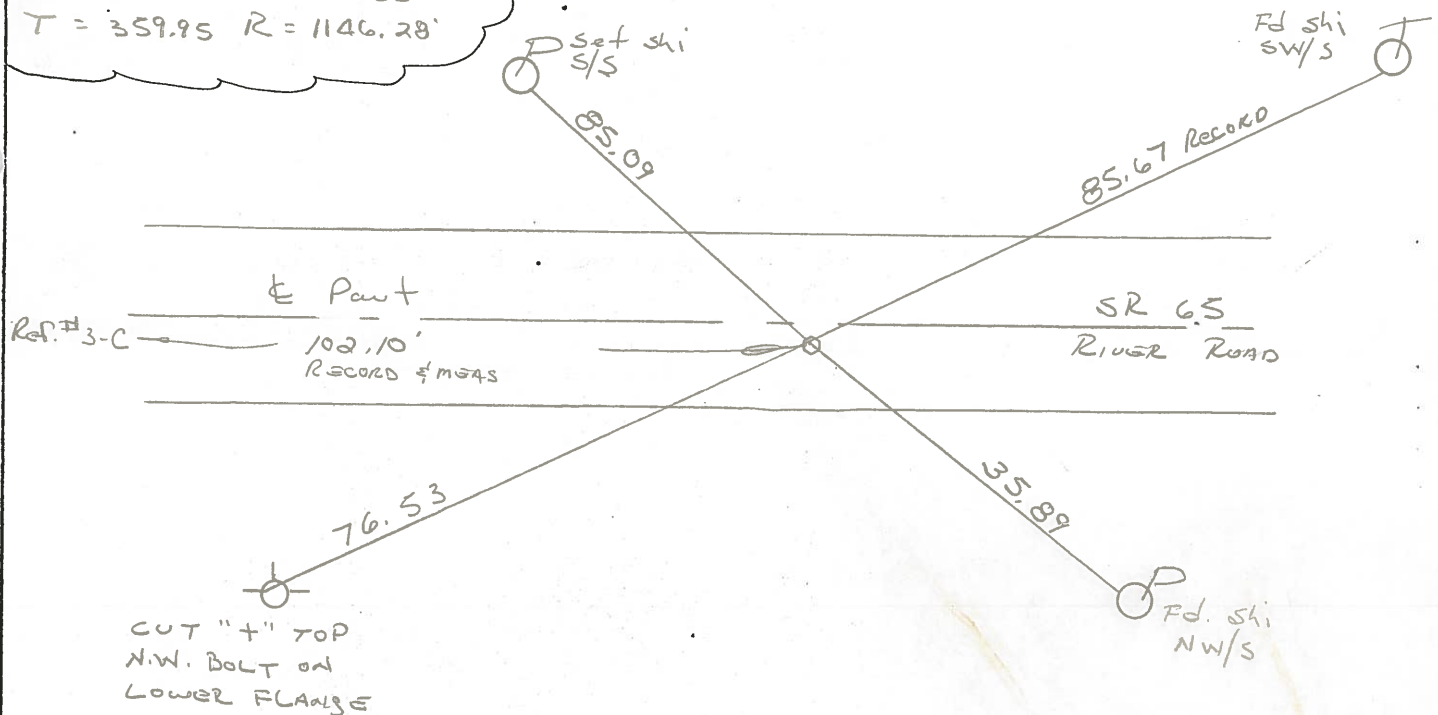

PERSONNEL TITLE PERSONNEL TITLE
 BURNSIDE _____ BAGDONAS _____
 SMITH _____
 POWERS _____
 KIWOWSKI _____

COUNTY WOOD DATE 7-17-73
 S. R. 65 WEATHER CLEAR
 SEC. GRAND RAPIDS TEMP. +85°

DESCRIPTION LEFT CENTER LINE RIGHT JOB NO. _____

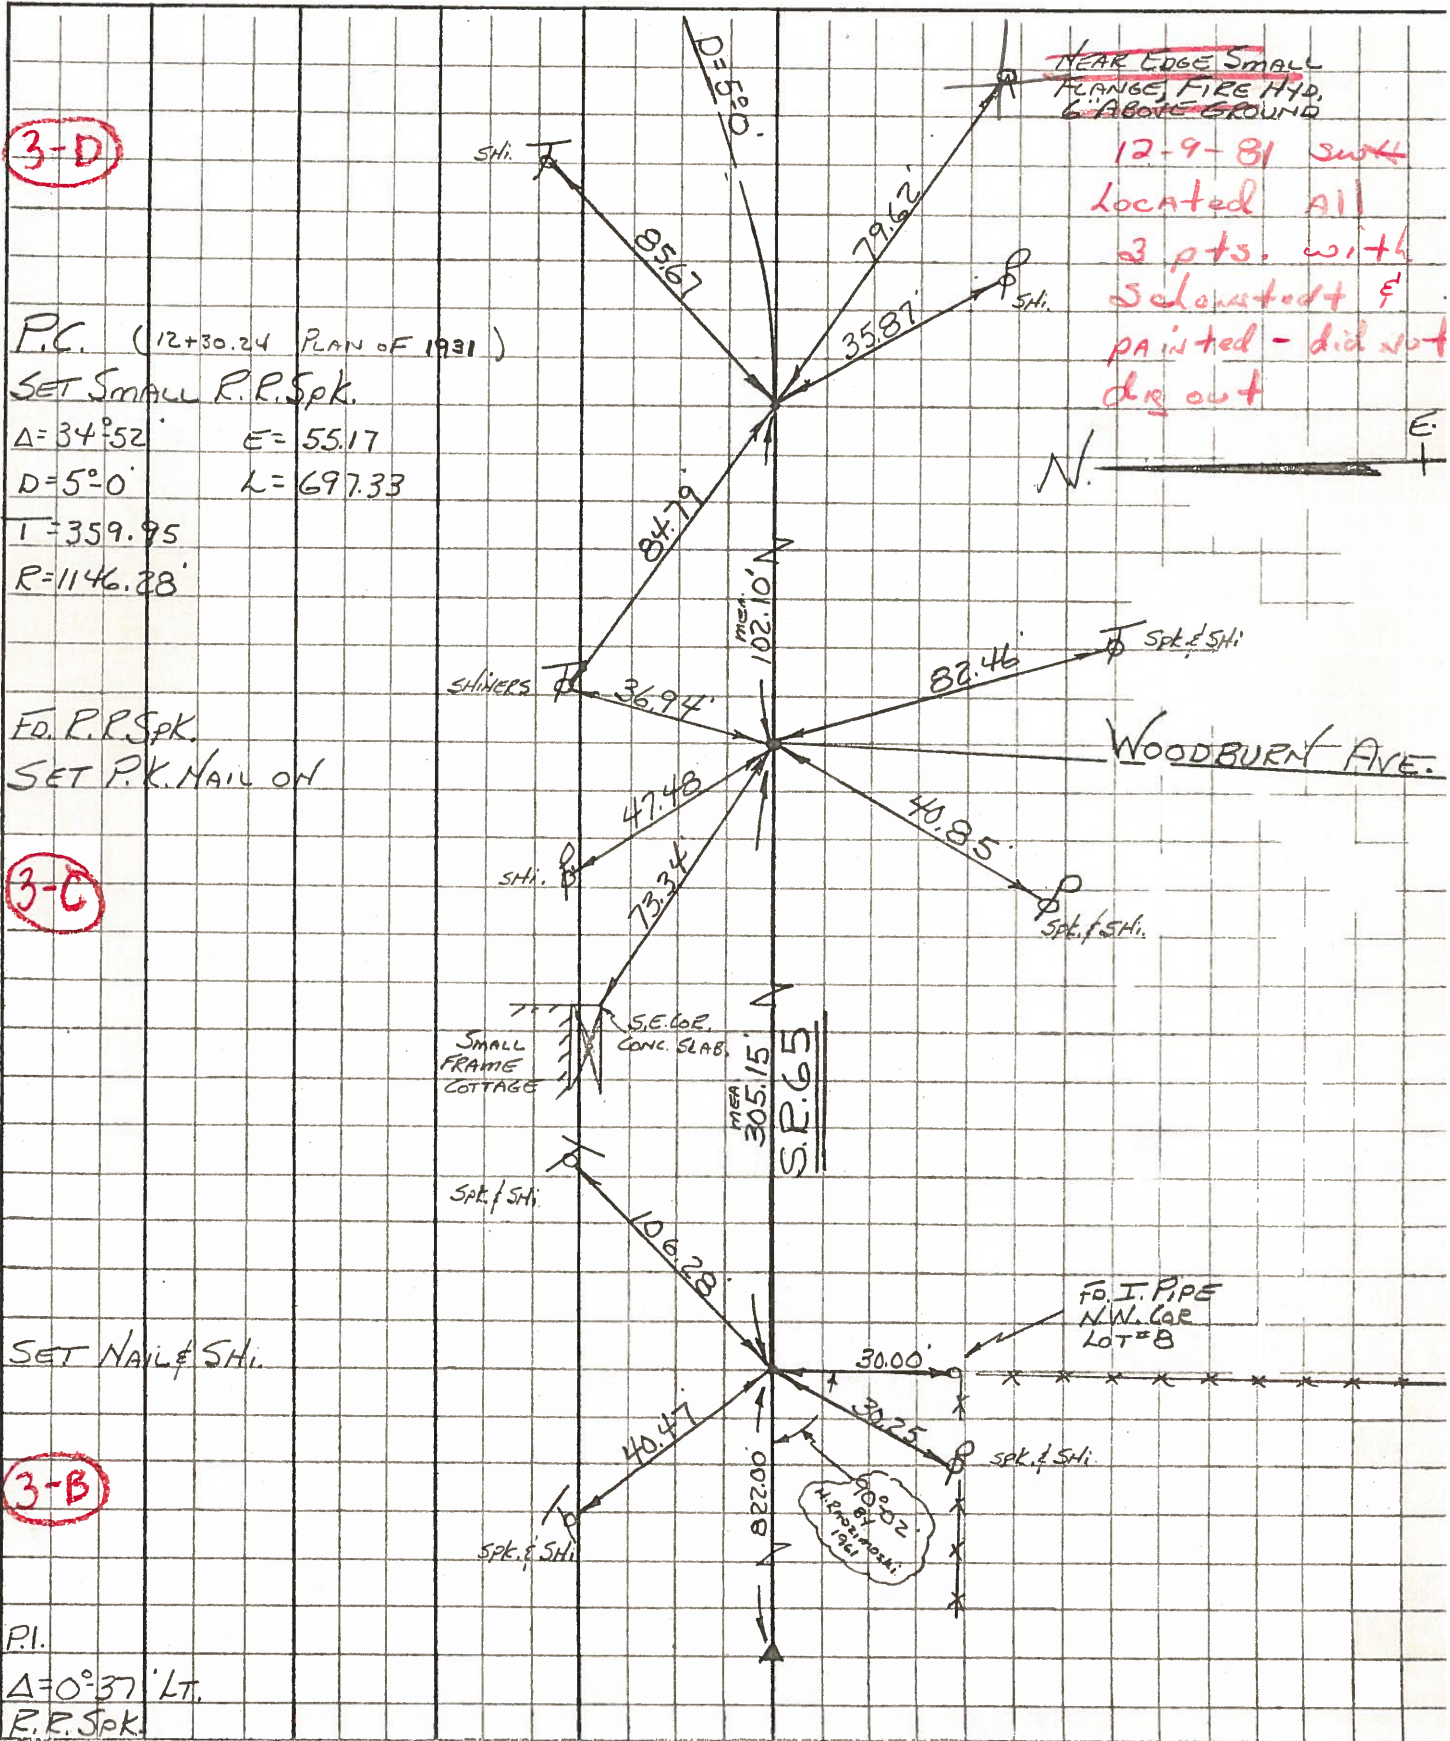

PERSONNEL TITLE PERSONNEL TITLE
BURNSIDE _____ RAGDONAS _____
SMITH _____ _____
POWERS _____ _____
KIOWSKI _____ _____

COUNTY WOOD DATE 7-17-73
 S. R. 65 WEATHER CLEAR
 SEC. GRAND RAPIDS TEMP. +85°

DESCRIPTION _____ LEFT _____ CENTER LINE _____ RIGHT _____ JOB NO. _____

