

O.D.O.T. DISTRICT 2 SURVEY OFFICE (USE ONLY)

PERSONNEL

REFERENCE NO. 4

SHEET 22 OF 40

NOTES RHOADES

DATE 3/29/22

ROUTE SR 65

H.C. NIESE

WEATHER CLEAR

COUNTY WOOD

R.C. KETNER
AUBLE, O'DONNELL

TEMP. 27°

TOWNSHIP GRAND RAPIDS

SECTION 8

DWG BY RHOADES PID 95796

T 5 N R 9 E

TYPE MONUMENT MAG/WASHER

ON SURFACE - ~~BELOW~~ ON

OFFSET \varnothing PAVEMENT 1' ~~LT~~ : RT

10.5' TO LT EDGE PAVEMENT



STATION: 84+53.5

HORZ.DATUM: NAD83 2011

GEOID: NAVD88 2018

GRID: NORTHING: 639082.447

EASTING: 1597014.875

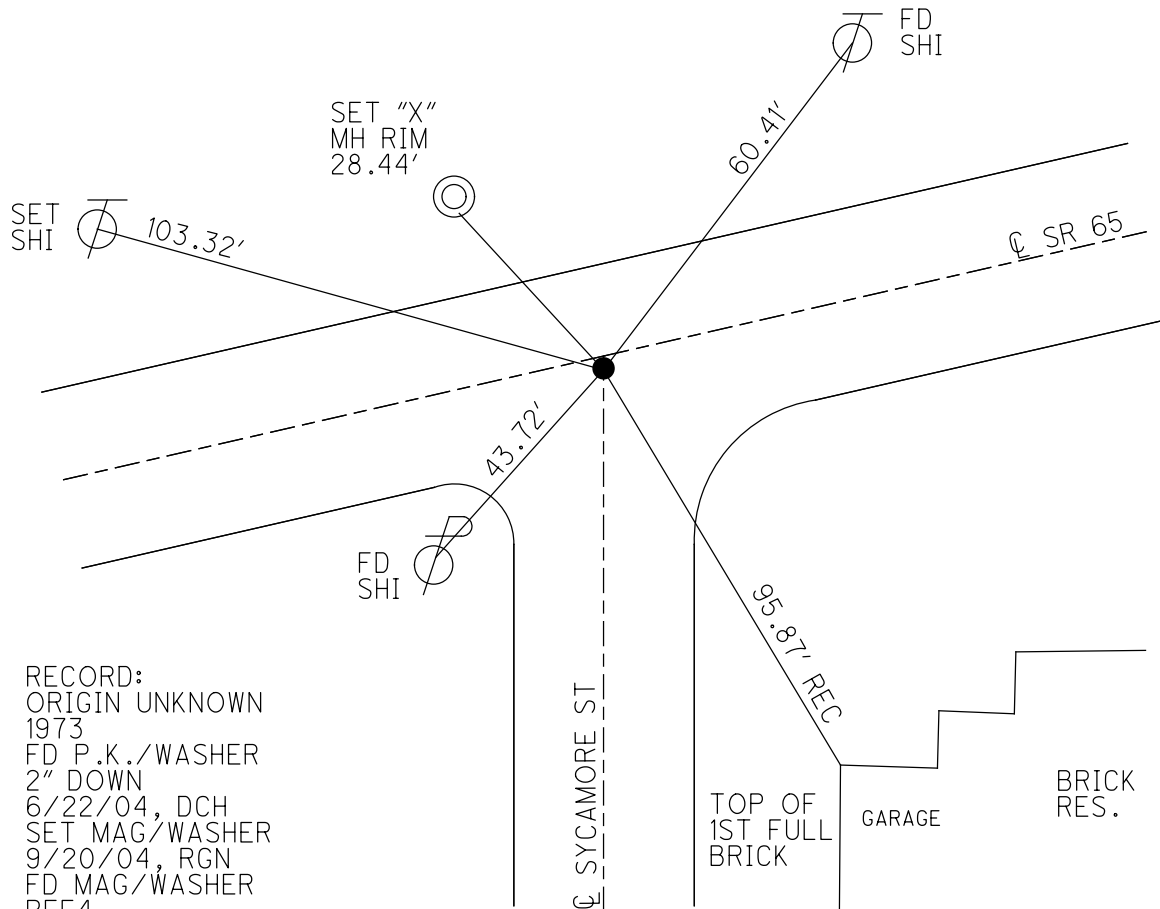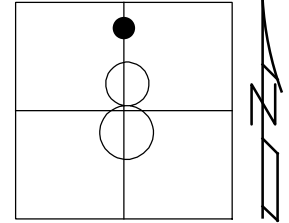

RECORD:
ORIGIN UNKNOWN
1973
FD P.K./WASHER
2" DOWN
6/22/04, DCH
SET MAG/WASHER
9/20/04, RGN
FD MAG/WASHER
REF4
11/2/20, JFO
SET MAG/WASHER
10/5/22, TDN

O.D.O.T. DISTRICT 2 SURVEY OFFICE

PERSONNEL _____

REFERENCE NO. 4

SHEET 16 OF 49

NOTES Nukter

H.C. Homan

R.C. Huss

DATE 6-22-04

WEATHER Sunny

TEMP. 73° F

ROUTE S.R. 65

COUNTY Wood

TOWNSHIP Grand Rapids

SECTION 8

T 5 N R 9 E



TYPE MONUMENT PK/W

~~ON/SURFACE~~ (BELOW) 2" below

LEFT - ⊙ PAV'T. (RIGHT) 0.5 Rt.


105 TO Lt EDGE PAVEMENT

S.L.M. 84+58

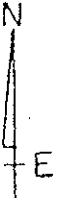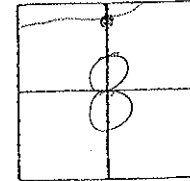

Records:
Origin Unknown
1973

Set Mag/W
9-20-04
RGN

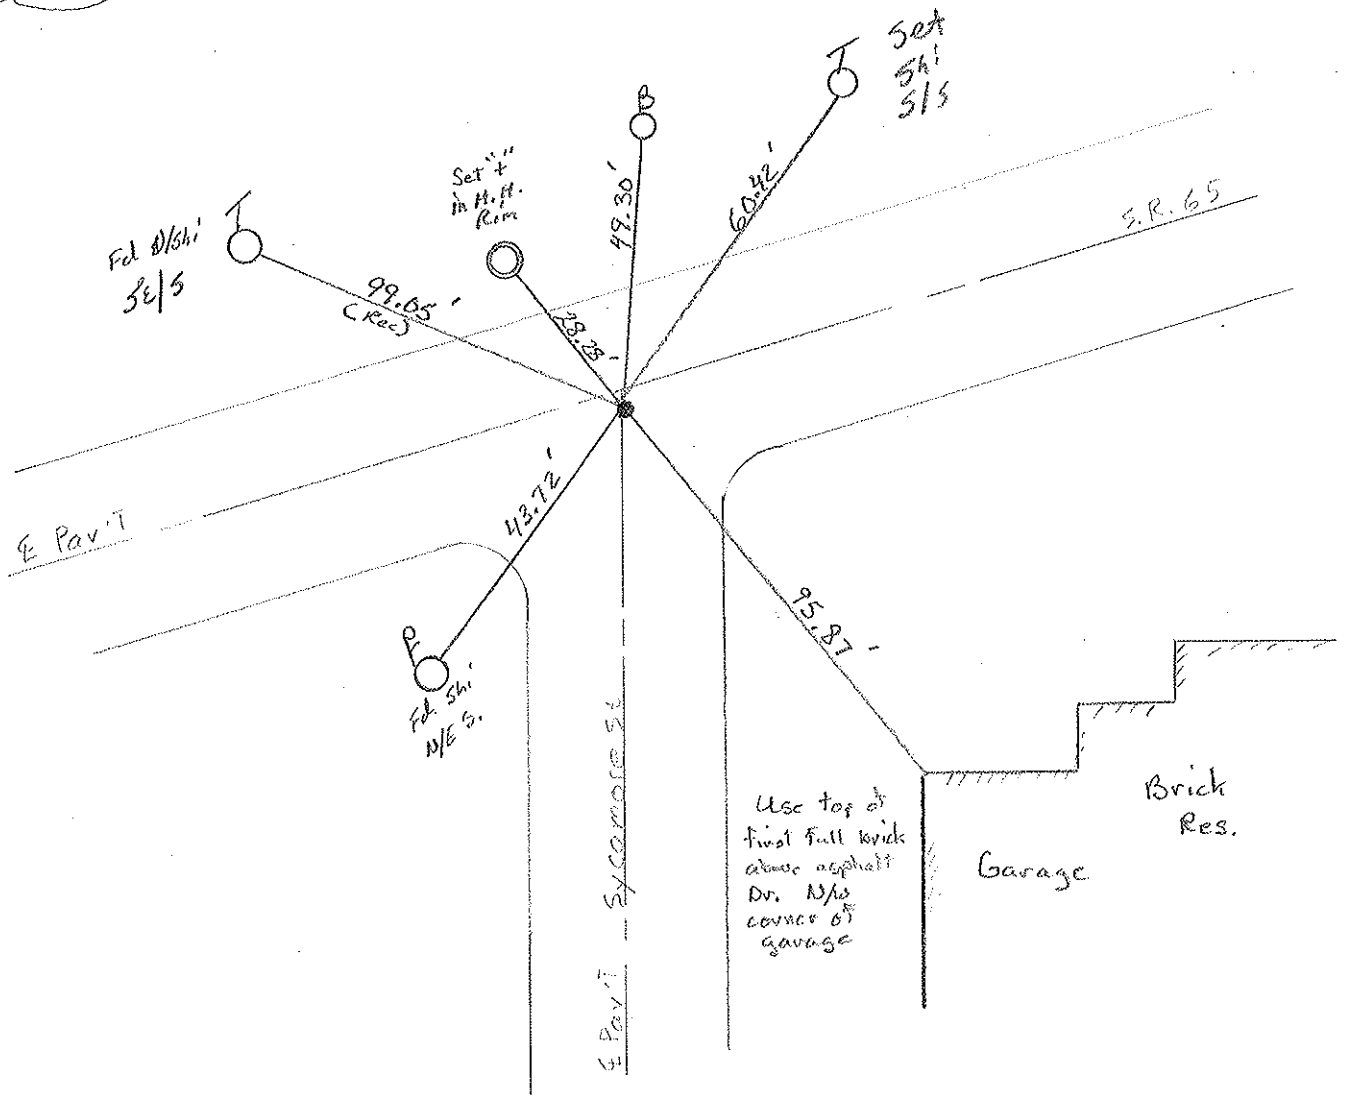

O.D.O.T. DISTRICT 2 SURVEY OFFICE

PERSONNEL

REFERENCE NO. 4

SHEET 1 OF 34

NOTES BARNHISEL

H.C. CURTIS

DATE 4-22-92

ROUTE 65

R.C. Locheke

WEATHER Cloudy

COUNTY WOOD

VAN DUSEN

TEMP. +50°

TOWNSHIP GRAND RAPIDS

Rometo

SECTION 8

T. 5 N. R. 9 E


TYPE MONUMENT PK & WASHER Set

5-4-92

ON SURFACE - BELOW yes

C.L.


~~LEFT~~ - & PAV'T. - RIGHT 1.2

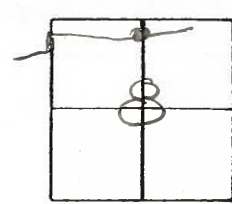

10.7 TO LT EDGE PAVEMENT

S.L.M. 84+57

RECORD:
ORIGIN UNKNOWN
1973 NOTES

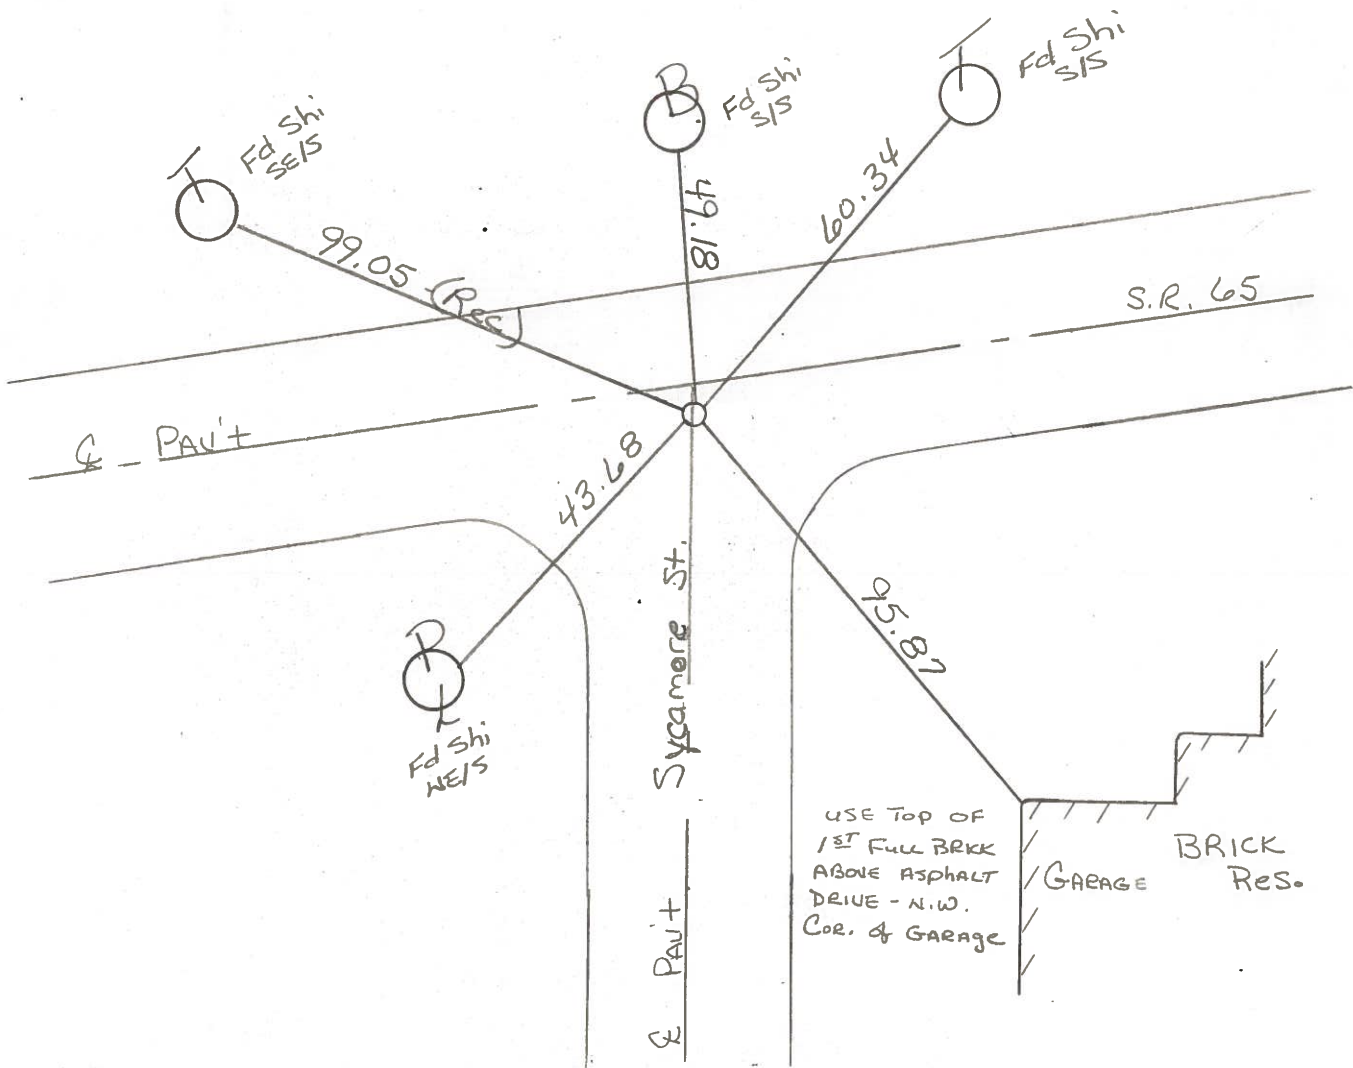

O.D.O.T. DISTRICT 2 SURVEY OFFICE

PERSONNEL _____

REFERENCE NO. 4

SHEET 12 OF 12

NOTES Hoffman

H.C. LOSHREE

R.C. _____

DATE 9-11-89

WEATHER CLEAR

TEMP. 78°

ROUTE SR 65

COUNTY WOOD

TOWNSHIP GRAND RAPIDS

SECTION 8

T5 N R 9 E


TYPE MONUMENT P.K. / WASHER

ON SURFACE - BELOW YES


~~LEFT~~ & PAV'T. - RIGHT 1.2'

10.7 TO LT. EDGE PAVEMENT

S.L.M. 84+57

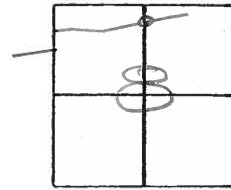

Records!
 ORIGINAL UNKNOWN 1973 NOTES

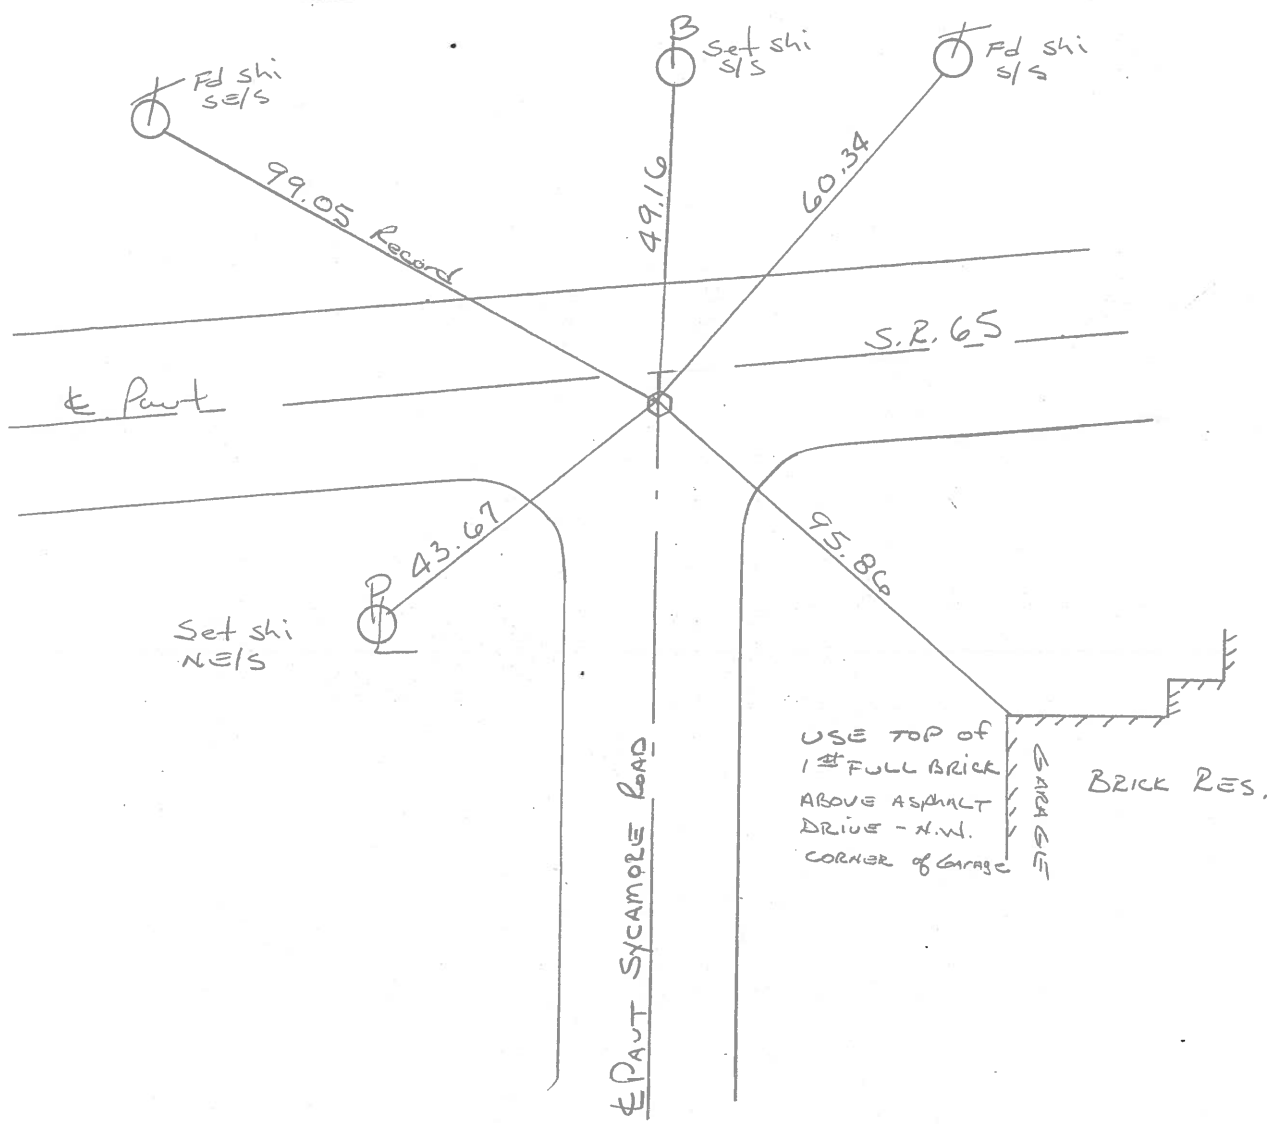

County Wood S.R. 65

Date 12-9-81
6-9-82

Township Grand Rapids

Weather cloudy

Section 8

Temp. +34°


T5N, R9E

Personnel Hoffman

Loehrke

Householder


#4

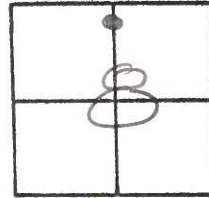

Fd- small R.R. SPK @ SURFACE
(ORIGINAL UNKNOWN 1973)

Project sta ± 84+63

1.2' S. of & PAUT S.E. 65

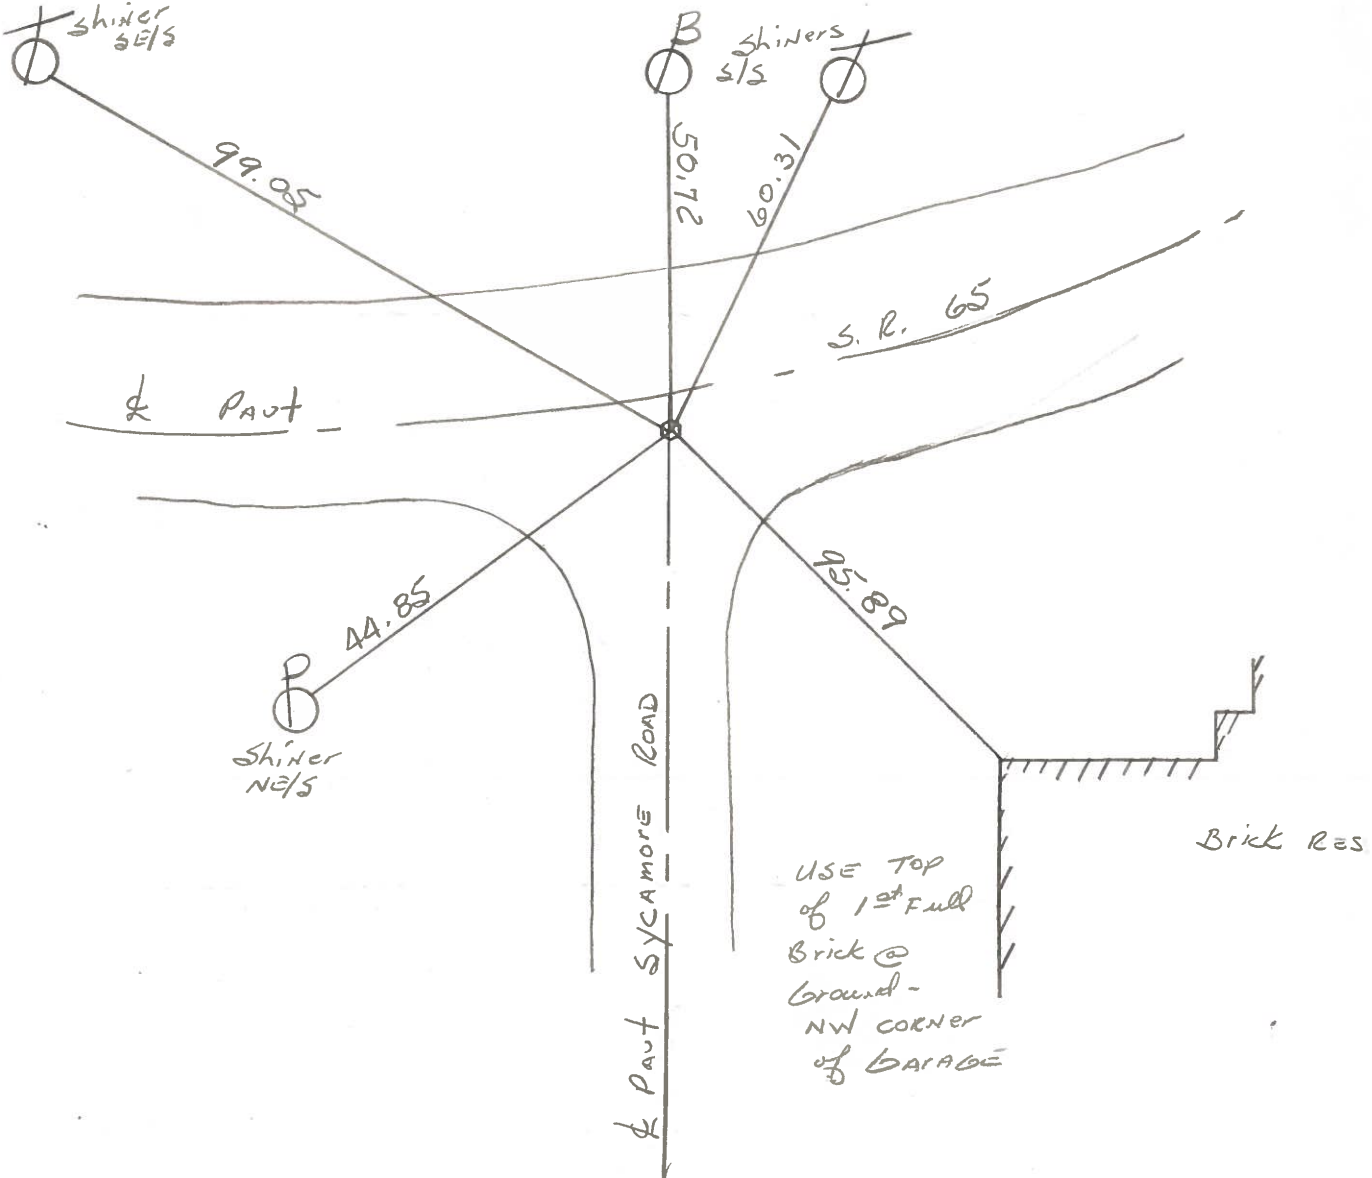

ODOT DISTRICT 2 SURVEY OFFICE

SHEET OF

County WOOD S.R. 65

Date 7-16-73

Township GRAND RAPIDS

Weather PT. CLOUDY

Section 8

Temp. 70°

T5N, R7E


Personnel BURNSIDE

SMITH

BOWERS

KIOWSKI

BAGDONAS

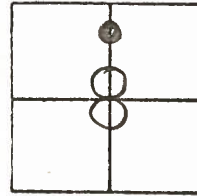

#4

Set PK/washer
6-9-82
Suidb


Fd @ sur. on & syc.

1.2
Sub 65k

P.O.C. TO SMALL R.R. SPK.
2" DEEP RAISED SAME
TO SURFACE

84 + 63

(ORIGIN UNKNOWN)

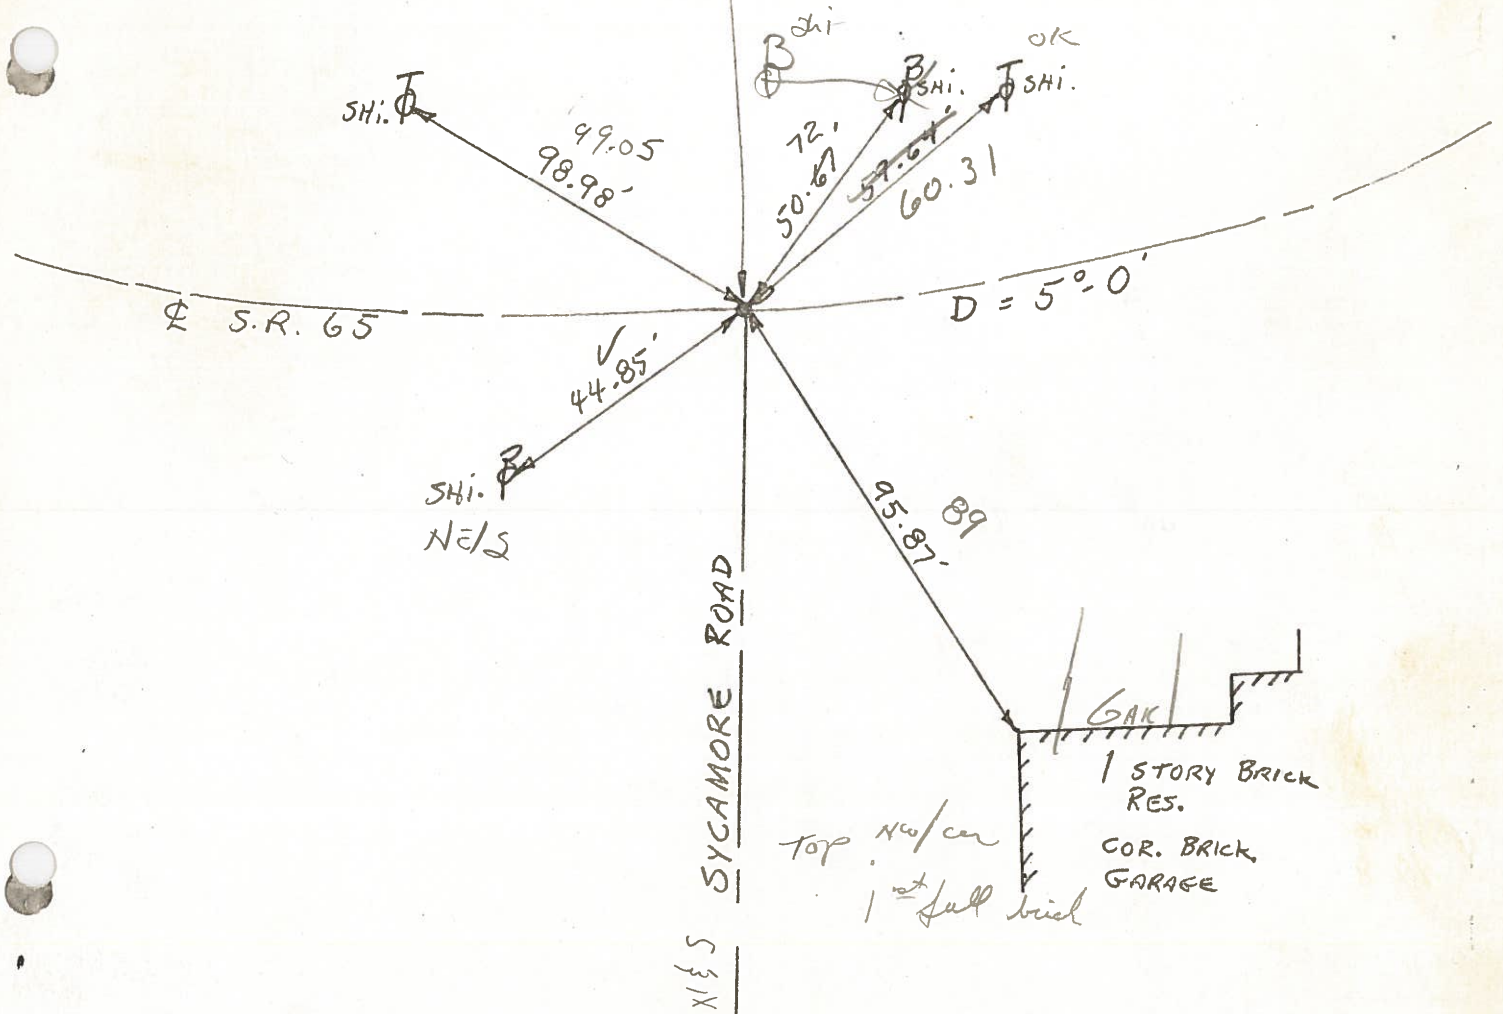

O.D.O.T. DISTRICT 2 SURVEY OFFICE

SHEET _____ OF _____

County WOOD S.R. 65

Date 7-16-73

Township GRAND RAPIDS

Weather PT. CLOUDY

Section 8

Temp. 70°

T5N, R9E


Personnel BURNSIDE

SMITH

BOWERS


KIOWSKI

BARONAS

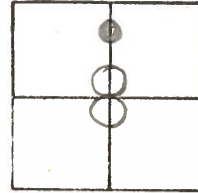

#4

P.O.C. TO SMALL R.R. SPK.
2" DEEP RAISED SAME
TO SURFACE
(ORIGIN UNKNOWN)

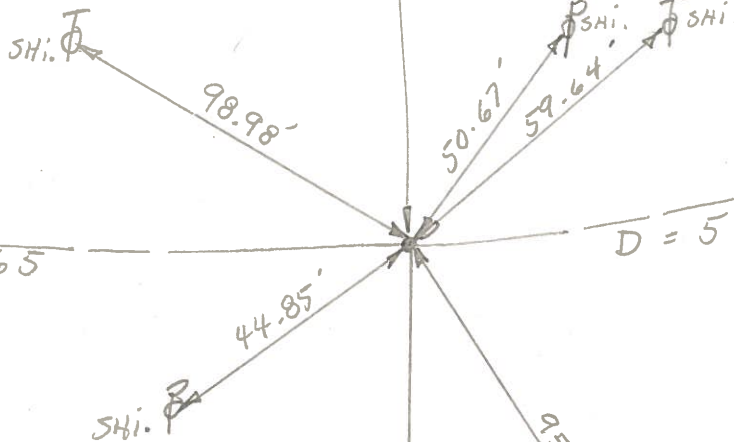

§ S.R. 65

SYCAMORE ROAD

1 STORY BRICK
RES.
COR. BRICK
GARAGE