

O.D.O.T. DISTRICT 2 SURVEY OFFICE (USE ONLY)

PERSONNEL

REFERENCE NO. 4 A

SHEET 23 OF 40

NOTES RHOADES

DATE 3/29/22

ROUTE SR 65

H.C. NIESE

WEATHER CLEAR

COUNTY WOOD

R.C. AUBLE

TEMP. 35°

TOWNSHIP GRAND RAPIDS

KETNER, O'DONNELL

SECTION 8

DWG BY RHOADES

PID 95796

T 5 N R 9 E

TYPE MONUMENT MAG/WASHER

ON SURFACE - ~~BELOW~~ ON

OFFSET ☉ PAVEMENT 1.5' ~~±~~ : RT

9.7' TO RT EDGE PAVEMENT


STATION: 87+30.48

HORZ. DATUM: NAD83 2011


GEOID: NAVD88 2018

GRID: NORTHING: 639185.327

EASTING: 1597271.270

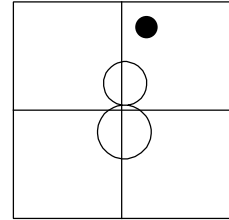

RECORD: P.C.C.
 STA. 19+27.77
 1931 PLANS
 FD P.K./WASHER
 6/22/04, DCH
 SET MAG/WASHER
 9/20/04, RGN
 FD MAG/WASHER
 REFA4
 11/2/20, JFO
 SET MAG/WASHER
 10/5/22, TDN

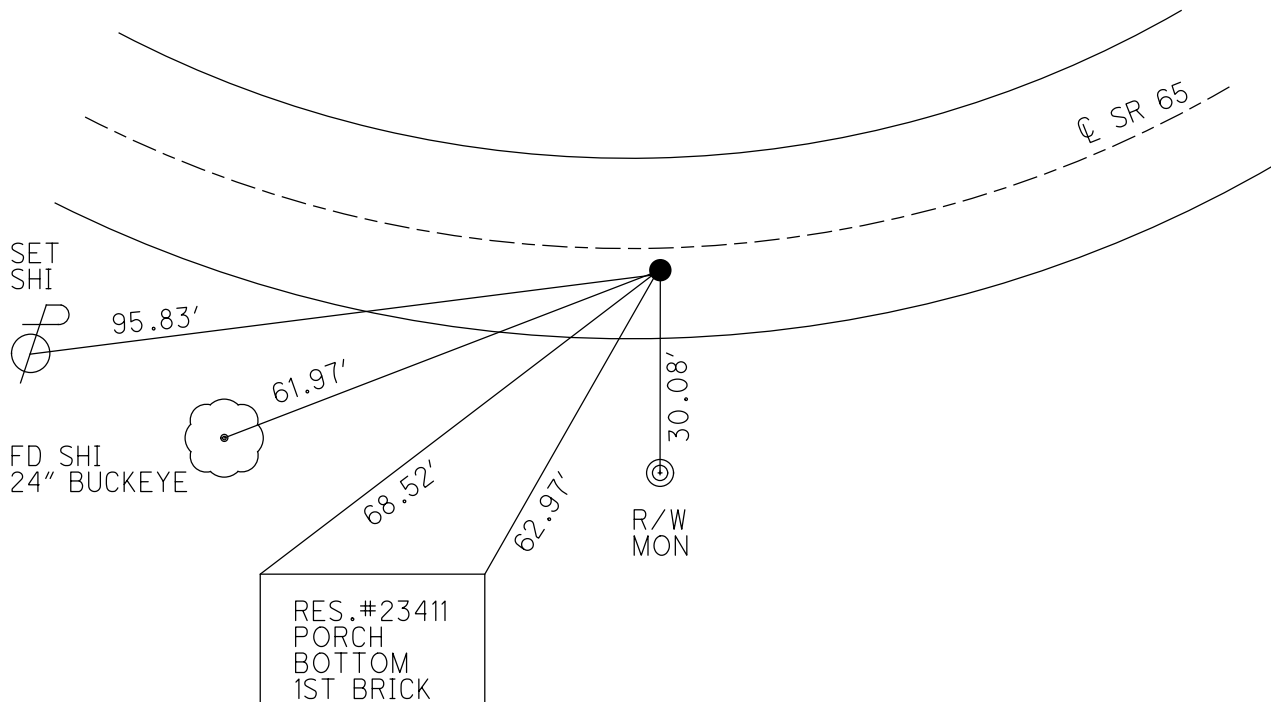

O.D.O.T. DISTRICT 2 SURVEY OFFICE

PERSONNEL

REFERENCE NO. 4-A

SHEET 17 OF 49

NOTES Number

H.C. Homan

R.C. Huss

DATE 6-22-04

WEATHER Sun.

TEMP. 73°F

ROUTE S.R. 65

COUNTY Wood

TOWNSHIP Grand Rapids

SECTION 8

T. 5 N. R. 9 E.



TYPE MONUMENT PK/W

ON SURFACE - ~~BELOW~~ Surface

~~LEFT~~ RIGHT 1.2' Rt


9.7' TO Rt. EDGE PAVEMENT

S.L.M. 87135

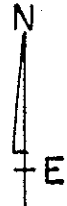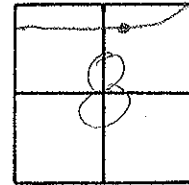

Record: P.C.C.
Sta. 19127.77
1931 Plans

Set Mag/W
9-20-04
RGN

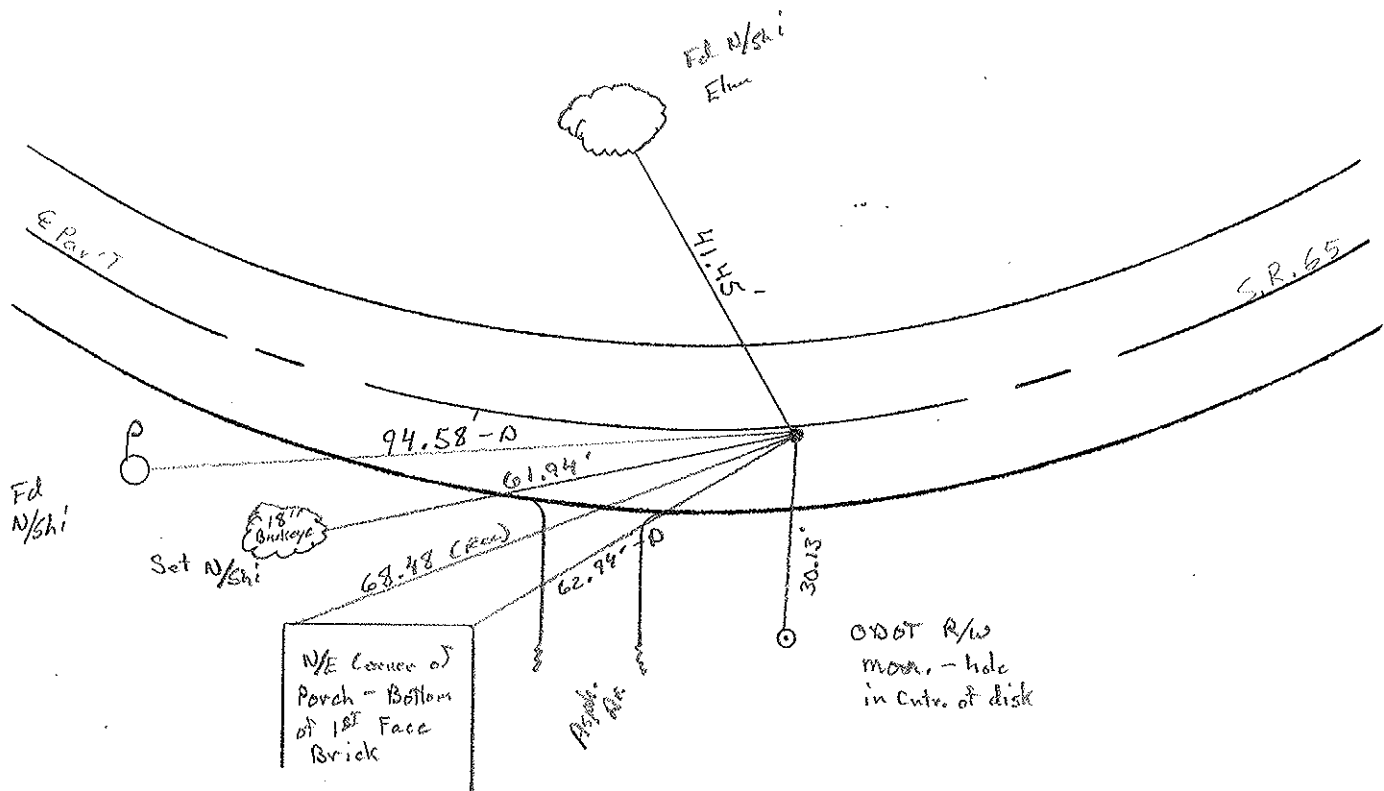

O.D.O.T. DISTRICT 2 SURVEY OFFICE

PERSONNEL

REFERENCE NO. 4-A

SHEET 2 OF 34

NOTES BARNHISEL

H.C. CURTIS

R.C. JAN DUSEN

Lochrke

Rometo

DATE 4-22-92

WEATHER cloudy

TEMP. +50°

ROUTE SR 65

COUNTY WOOD

TOWNSHIP Grand Rapids

SECTION 8

T 5 N R 9 E


TYPE MONUMENT PK & WASHER ^{Set} 5-4-92

ON SURFACE - BELOW yes C.L.


~~LEFT~~ - C PAV'T. - RIGHT 1.5

2.7 TO RT EDGE PAVEMENT

S.L.M. 87+32

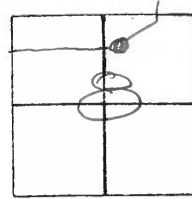

RECORD: P.C.C.
STA. 19+27.77
1931 PLANS

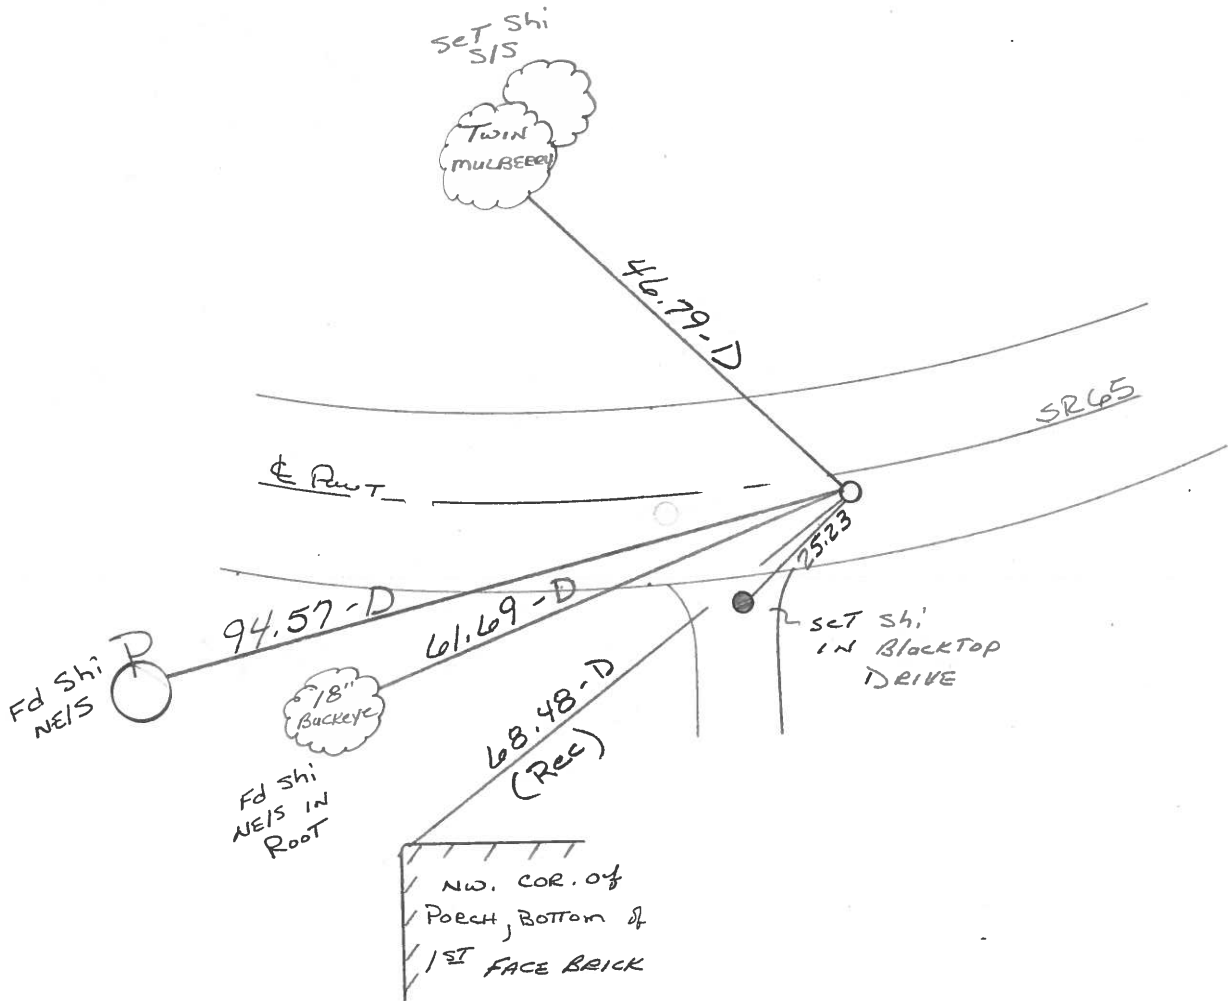

ODOT DISTRICT 2 SURVEY OFFICE

SHEET 10 OF

County Wood S.R. 65

Township Grand Rapids

Section 8

T5N, R9E

Personnel Hoffman

Loehrke


Householder

#4-A

Date 6-9-82
12-9-81


Weather cloudy

Temp. +34°

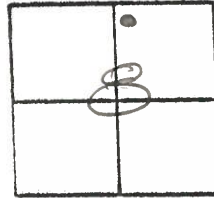

Fd. small R.R. spk @ surface
1.2' S. of & PAUT
10.8 to N.E.P.
9.6 to S.E.P.

Project sta ± 87+40

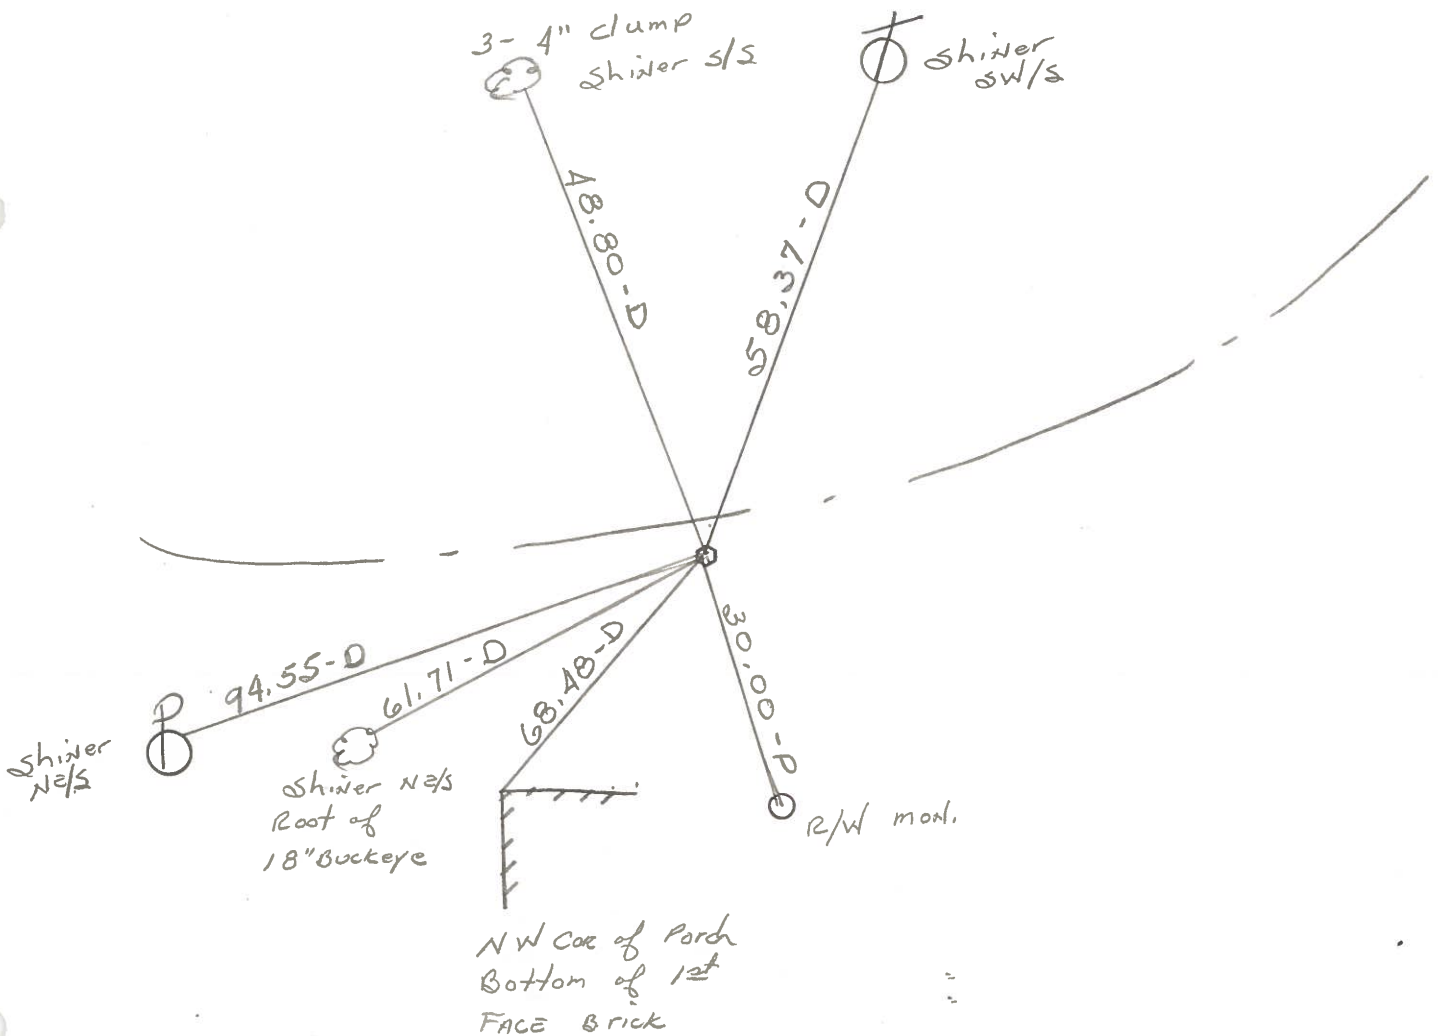

(P.C.C. STA 19+27.77 1931 plans)

O.D.O.T. DISTRICT 2 SURVEY OFFICE

SHEET _____ OF _____

County WOOD S.R. 65

Township GRAND RAPIDS

Section 8

T5N, R9E

Personnel BURNSIDE

SMITH

BOWERS


KIJOWSKI

BAGDONAS

Date 7-17-73

Weather CLEAR

Temp. 85°

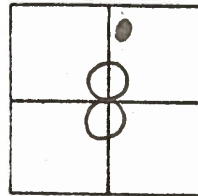


#4-A

Sta

P.C.C. (19+27.77 PLAN OF 1931)

SET SMALL
R.R. SPK. Fd

- 1.2 Soft
- 10.8 NEP
- 9.6 SEP

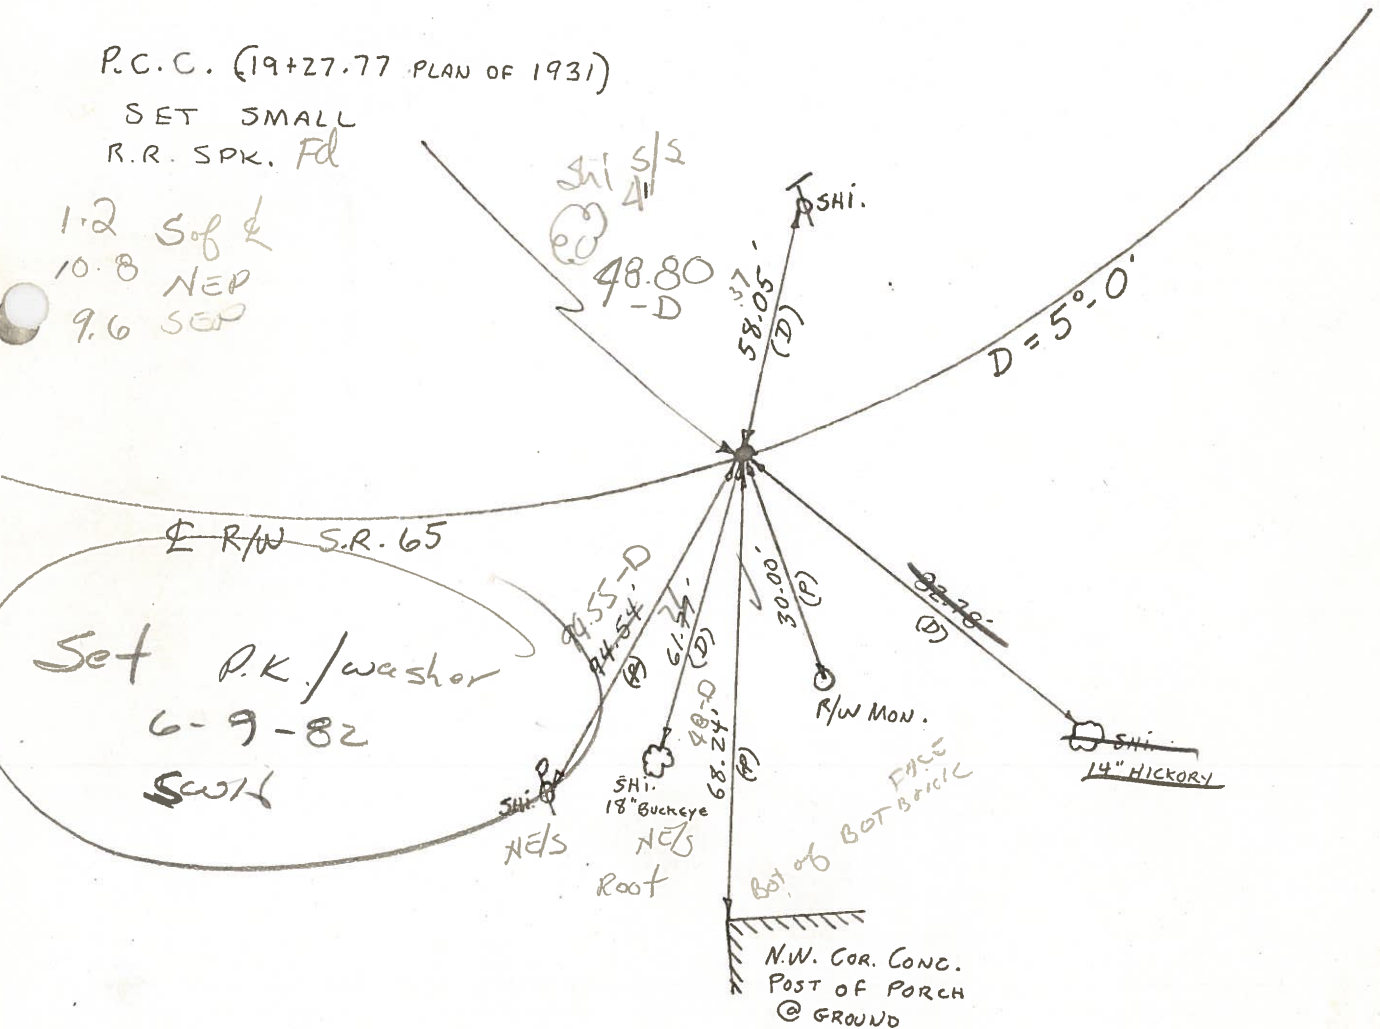

E R/W S.R. 65

Set P.K./washer
6-9-82
SCWH

SHI.
18" Buckeye
NE'S
Root

FACE
BOT BOT BRICK

N.W. COR. CONC.
POST OF PORCH
© GROUND

ODOT. DISTRICT 2 SURVEY OFFICE

SHEET _____ OF _____

County WOOD S.R. 65

Date 7-17-73

Township GRAND RAPIDS

Weather CLEAR

Section 8

Temp. 85°

T5N, R9E


Personnel BURNSIDE

SMITH

BOWERS

KIOWSKI

BAGDONAS

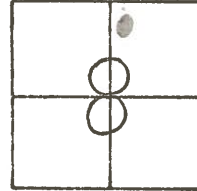

#4-A

P.C.C. (19+27.77 PLAN OF 1931)

SET SMALL
R.R. SPK.

