

O.D.O.T. DISTRICT 2 SURVEY OFFICE (USE ONLY)

PERSONNEL

REFERENCE NO. 5

SHEET 25 OF 40

NOTES RHOADES

DATE 3/29/22

ROUTE SR 65

H.C. NIESE

WEATHER CLEAR

COUNTY WOOD

R.C. AUBLE

TEMP. 35°

TOWNSHIP GRAND RAPIDS

KETNER, O'DONNELL

SECTION 5

DWG BY RHOADES

PID 95796

T 5 N R 9 E

TYPE MONUMENT MAG/WASHER

ON SURFACE - ~~BELOW~~ ON

OFFSET 6.1' TO LT EDGE PAVEMENT


STATION: 105+27.14

HORZ.DATUM: NAD83 2011


GEOID: NAVD88 2018

GRID: NORTHING: 640543.082

EASTING: 1598388.102

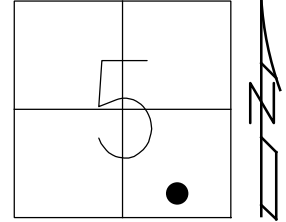

RECORD: P.I.
 STA. 4+75.4
 $\Delta = 6^\circ 05'$
 R = 1432.69
 T = 76.12
 L = 152.02'
 $\Delta = 6^\circ 41'$ RT MEAS.
 1973
 FD P.K./WASHER
 6/22/04, DCH
 SET MAG/WASHER
 9/17/04, RGN
 FD MAG/WASHER
 REF5
 11/2/20, JFO
 SET MAG/WASHER
 10/5/22, TDN

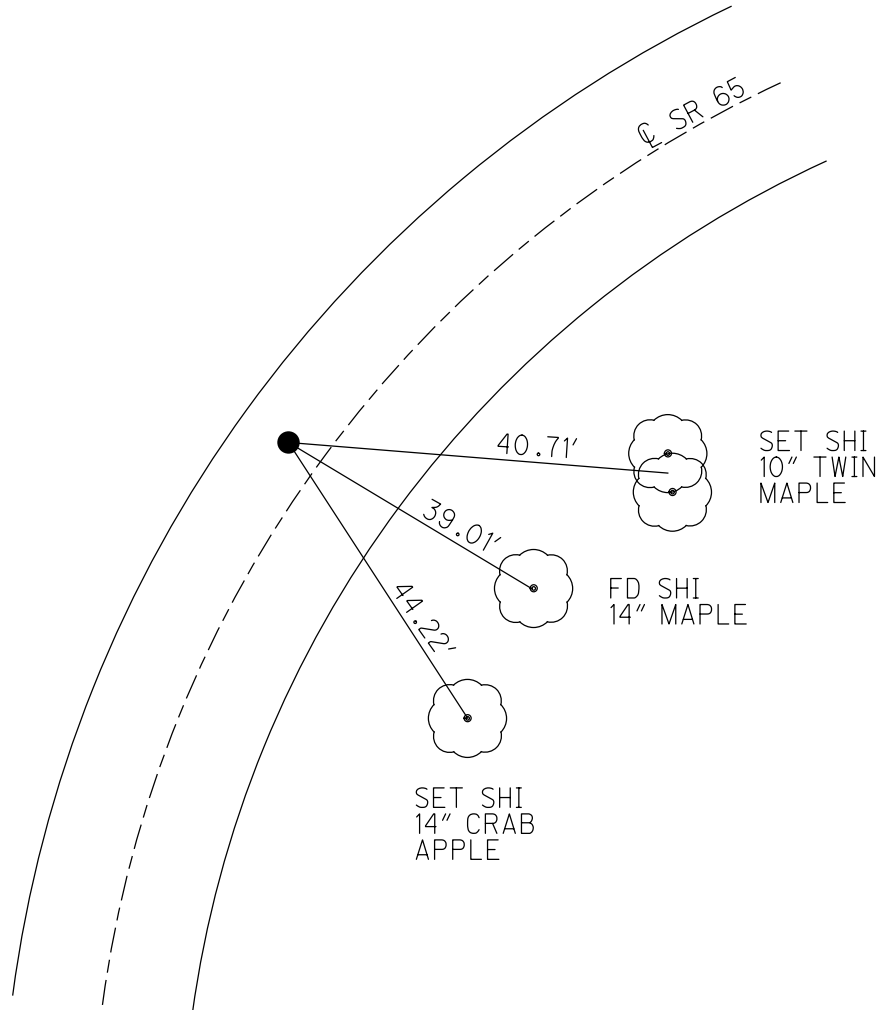

O.D.O.T. DISTRICT 2 SURVEY OFFICE

PERSONNEL _____

REFERENCE NO. 5

SHEET 18 OF 49

NOTES Nuhfor

H.C. Homan

R.C. Huss

DATE 6-22-04

WEATHER Sun.

TEMP. 73°F

ROUTE S.R. 65

COUNTY Wood

TOWNSHIP Grand Rapids

SECTION 5

T5 N R 9 E


TYPE MONUMENT Pt(A), Pt(B) PK/W - both

ON SURFACE - ~~UNKNOWN~~ surface - both


LEFT - 0 PAV T. - RIGHT Pt(A) - 4.0 Lt. / Pt(B) 0.3' Lt

① - 6.0' Lt.
② - 9.9' TO RT. EDGE PAVEMENT

S.L.M. Pt(B) - 102+11 Pt(A) - 105+38

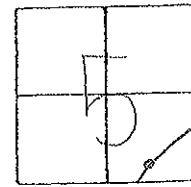

Record: 1923-1924 Plans
 PI Sta = 4+75.4
 $\Delta = 60^{\circ} - 05'$
 $R = 1432.69$
 $T = 76.12$
 $L = 152.02$
 $\Delta = 60^{\circ} - 41'$ Rt Meas, 1973

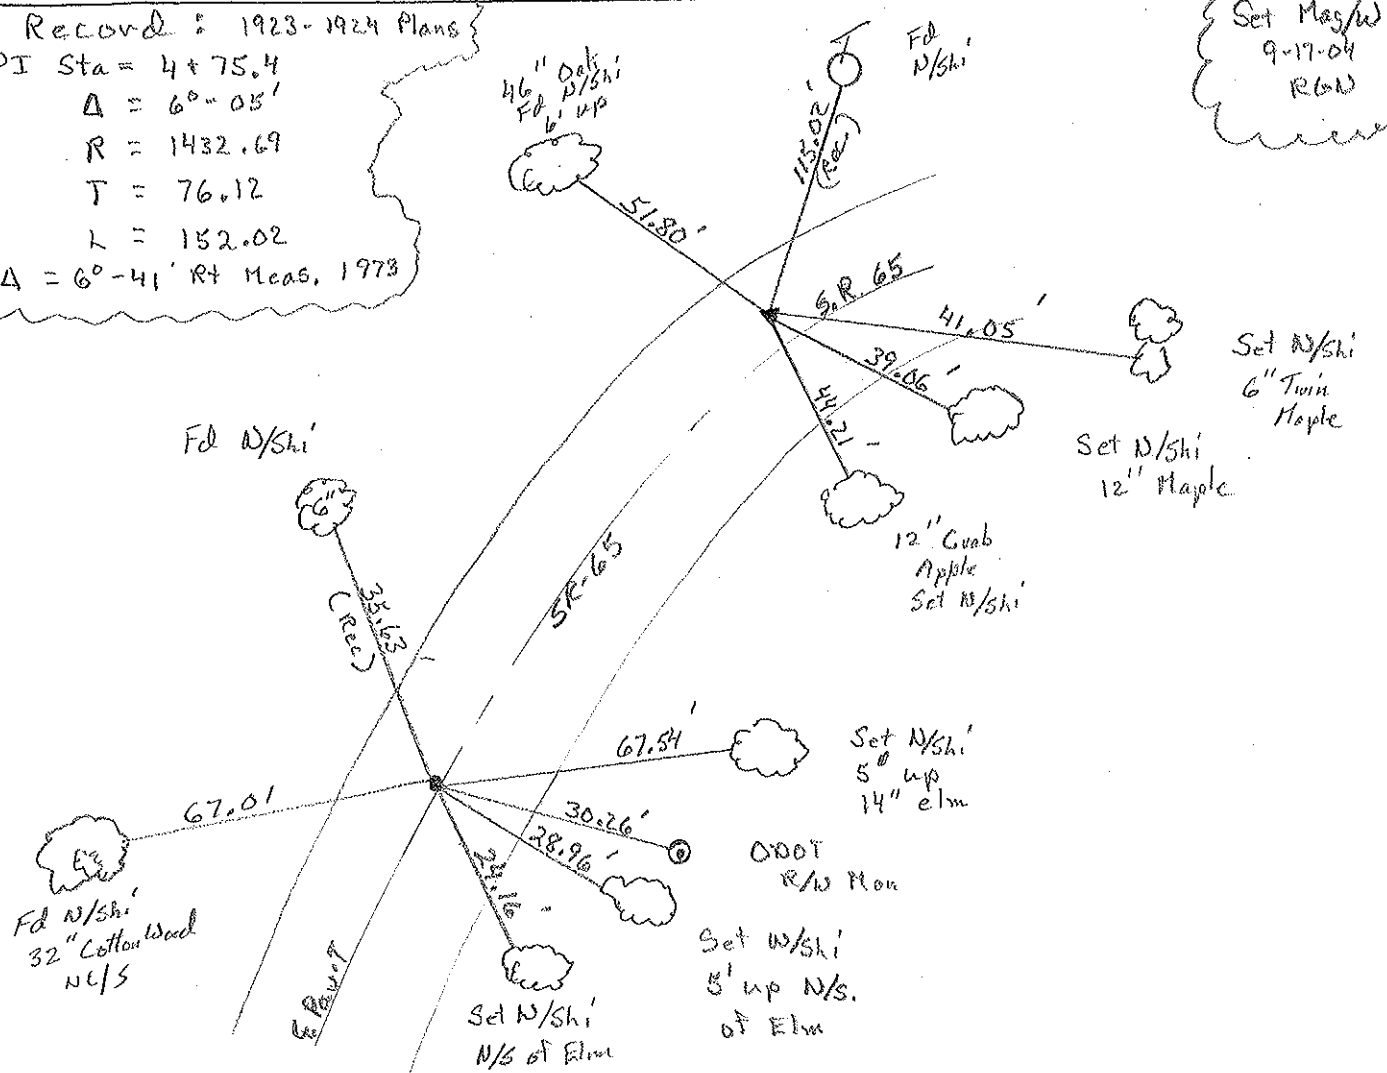

O.D.O.T. DISTRICT 2 SURVEY OFFICE

PERSONNEL

REFERENCE NO. 5

SHEET 3 OF 34

NOTES BARNHISEL

H.C. CURTIS

R.C. VAN DUSEN

Loehrke

Romeo

DATE 4-22-92

WEATHER Cloudy

TEMP. +50°

ROUTE SR 65

COUNTY WOOD


TOWNSHIP GRAND RAPIDS

SECTION 5

T5 NR 9 E


TYPE MONUMENT PT "A" & PT "B" ~ PK'S & WASHERS
 ON SURFACE - BELOW YES ~ YES
 LEFT- & PAW'T. - RIGHT ON E ~ 3.8

Set
 PK'S & WASHERS
 5-4-92
 C.L.

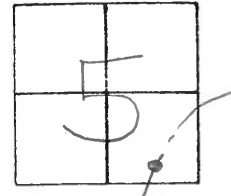

A-9.4
 B-3.7 TO LT EDGE PAVEMENT
 S.L.M. PT "B" 102+04 Pt A 105+28

RECORD: 1933-1924 PLANS
 P.I. STA. = 4+75.4
 $\Delta = 6^{\circ} - 05'$
 $R = 1432.69$
 $T = 76.12$
 $L = 152.02$
 $\Delta = 6^{\circ} - 41'$ RT MEAS. 1973

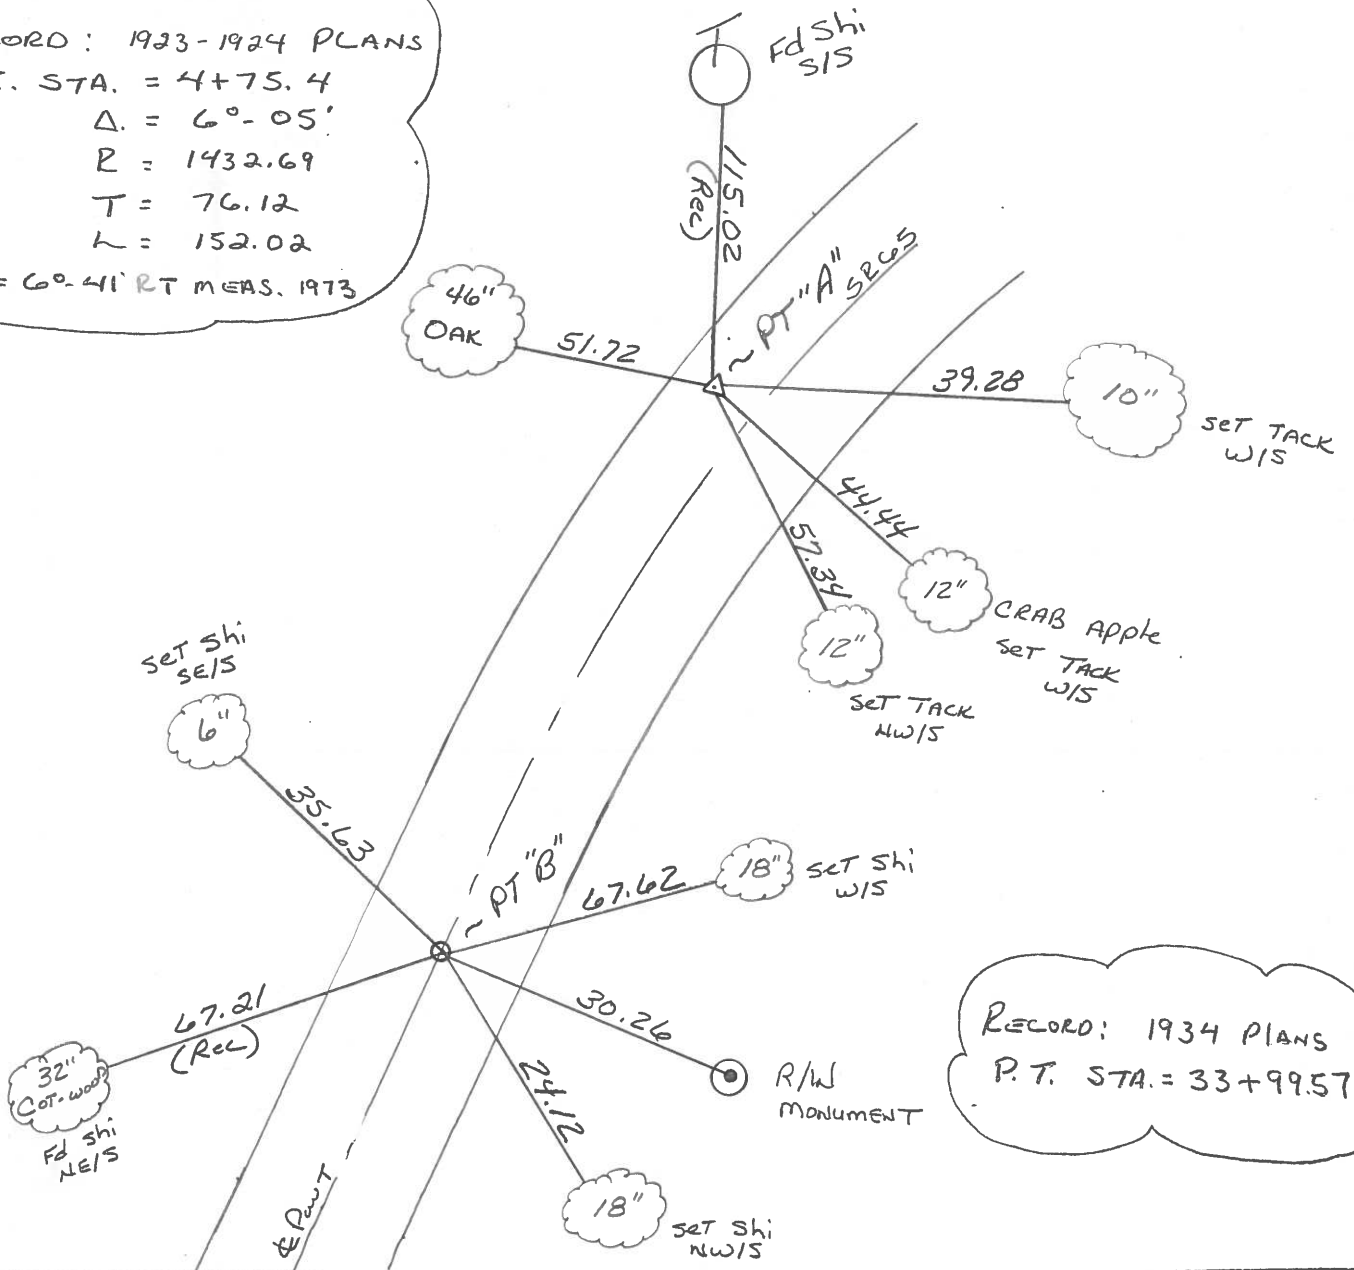

RECORD: 1934 PLANS
 P.T. STA. = 33+99.57

O.D.O.T. DISTRICT 2 SURVEY OFFICE

SHEET 11 OF

County Wood S.R. 65

Date 6-9-82
12-9-81

Township Grand Rapids

Weather cloudy

Section 5

Temp. +30°


T5N, R9E

Personnel Hoffman

Loehke


Householder

#5

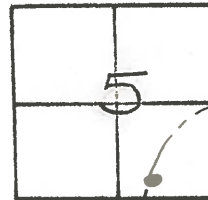

St. "A" Fd P.K. @ surface @ & PAVT - Project STA ± 102+13

St. "B" Fd. small R.R. SPK
@ surface
3.7' W (2+) of & PAVT
5.3 to W.E.P.
12.6 to R.E.P.
Project STA ± 105+38

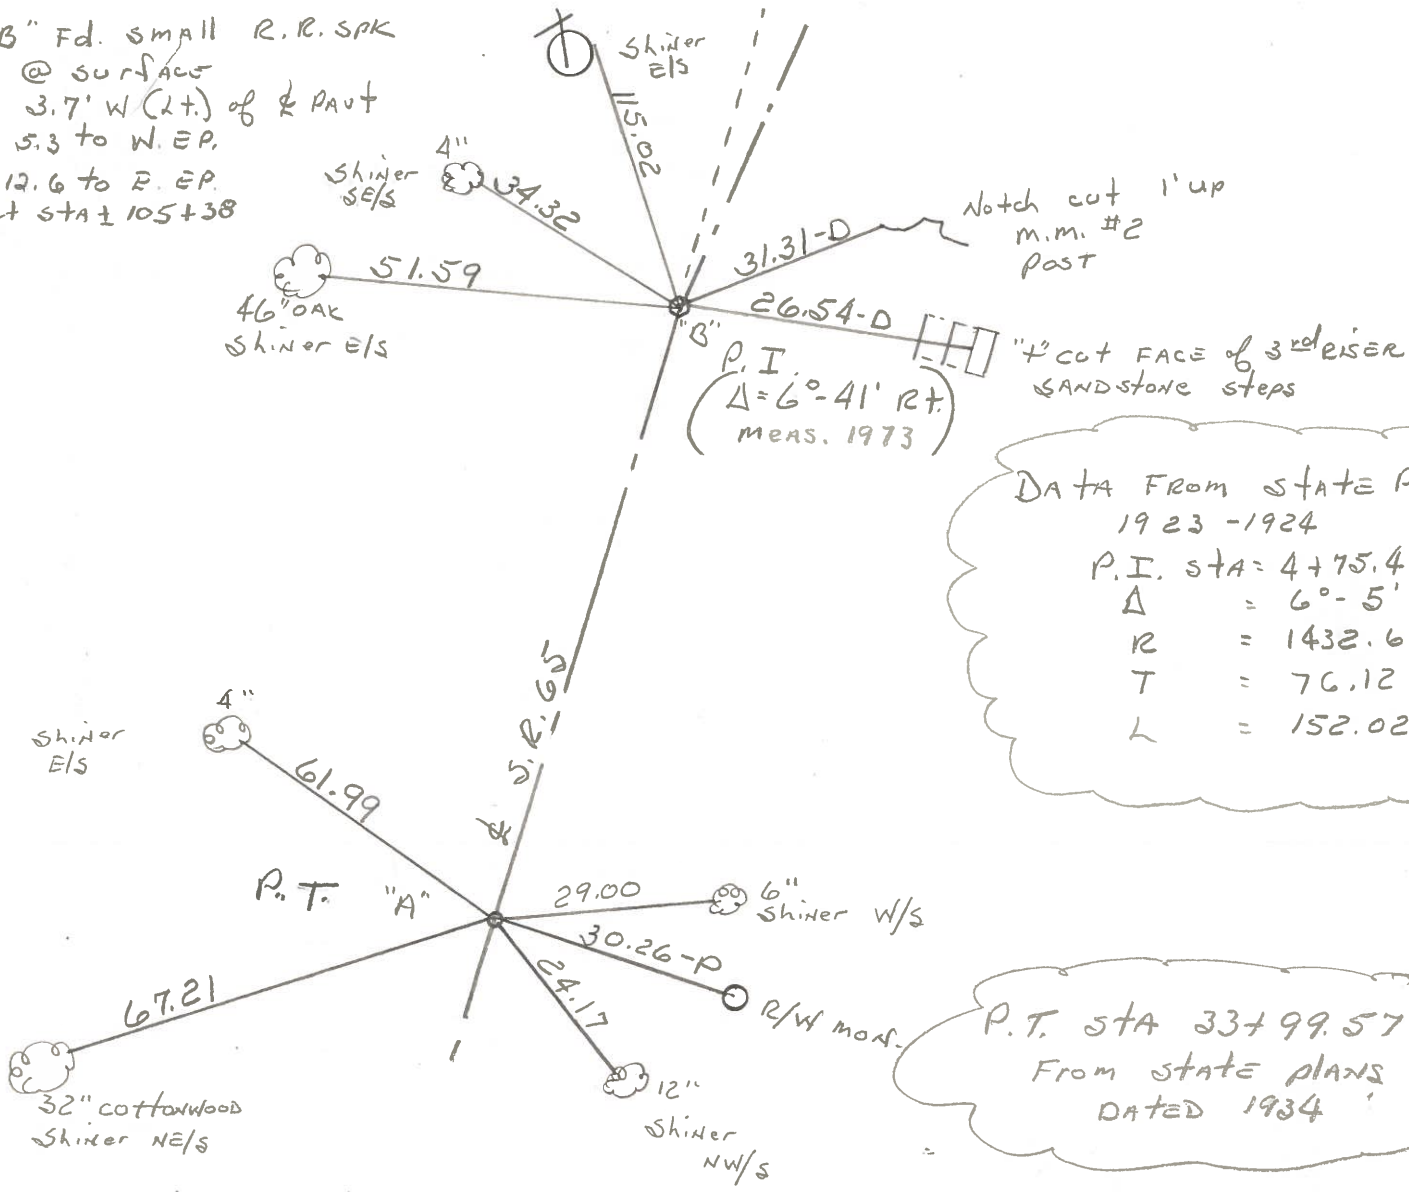

DATA FROM STATE PLAN
 1923 - 1924
 P.I. STA = 4+75.4
 Δ = 6°-5'
 R = 1432.69'
 T = 76.12
 L = 152.02

P.T. STA 33+99.57
 From state plans
 DATED 1934

County WOOD S.R. 65

Township GRAND RAPIDS

Section X

T5N, R9E

Personnel BURNSIDE


SMITH

BOWERS

Date 9-27-72

Weather CLOUDY

Temp. 63°

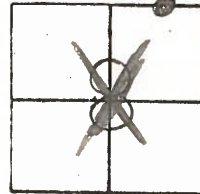

#5

P.I. STA. 4+75.4

SET SMALL R.R. SPK.
3.3'± LT. OF & PAUT.

$\Delta = 6^{\circ}-41'$ RT. (MEAS.)

3.7 H of &
53 to XED

12.4 To Sep ~~105+38~~

105+38

CURVE DATA FROM
STATE PLAN - 1923-1924

P.I. STA. 4+75.4

$\Delta = 6^{\circ}-5'$

R = 1432.69'

T = 76.12

L = 152.02

2mm notch cut
up
+ cut
face
3rd
old stone
and
steps

P.K. Hit SPK
Nail to set
concr Nail/Shi
@ X over SPK
6-9-82
SWA


Set PK/washer
6-9-82 SWA

SHI. 30"
COTTONWOOD

P.T. STA. 33+99.57

SET P.K. NAIL IN CTR.
PAUT.

NOTE: P.T. STA.
TAKEN FROM STATE
PLAN DATED 1934

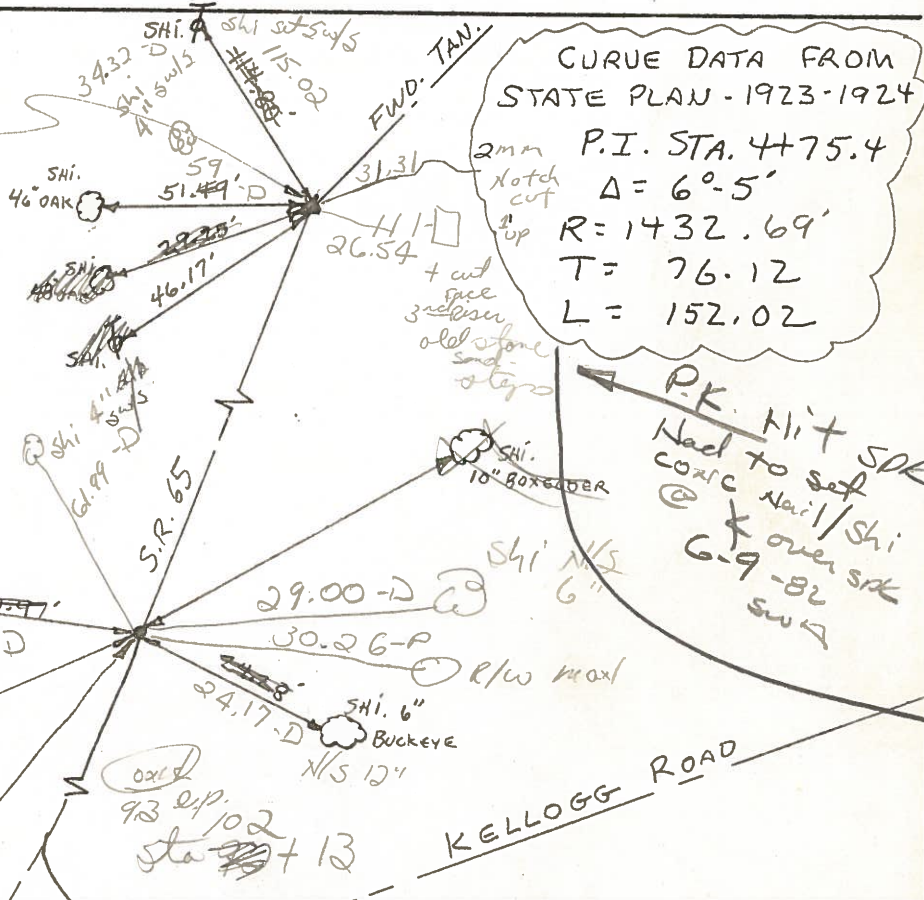

ODOT. DISTRICT 2 SURVEY OFFICE

SHEET _____ OF _____

County WOOD S.R. 65

Date 9-27-72

Township GRAND RAPIDS

Weather CLOUDY

Section 8


Temp. 63°

T5N, R9E

Personnel BURNSIDE

SMITH


BOWERS

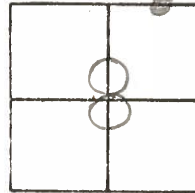

#5

P.I. STA. 4+75.4
 SET SMALL R.R. SPK.
 3.3' ± LT. OF & PAUT.
 Δ = 6°-41' RT. (MEAS.)

CURVE DATA FROM
 STATE PLAN - 1923-1924
 P.I. STA. 4+75.4
 Δ = 6°-5'
 R = 1432.69'
 T = 76.12
 L = 152.02

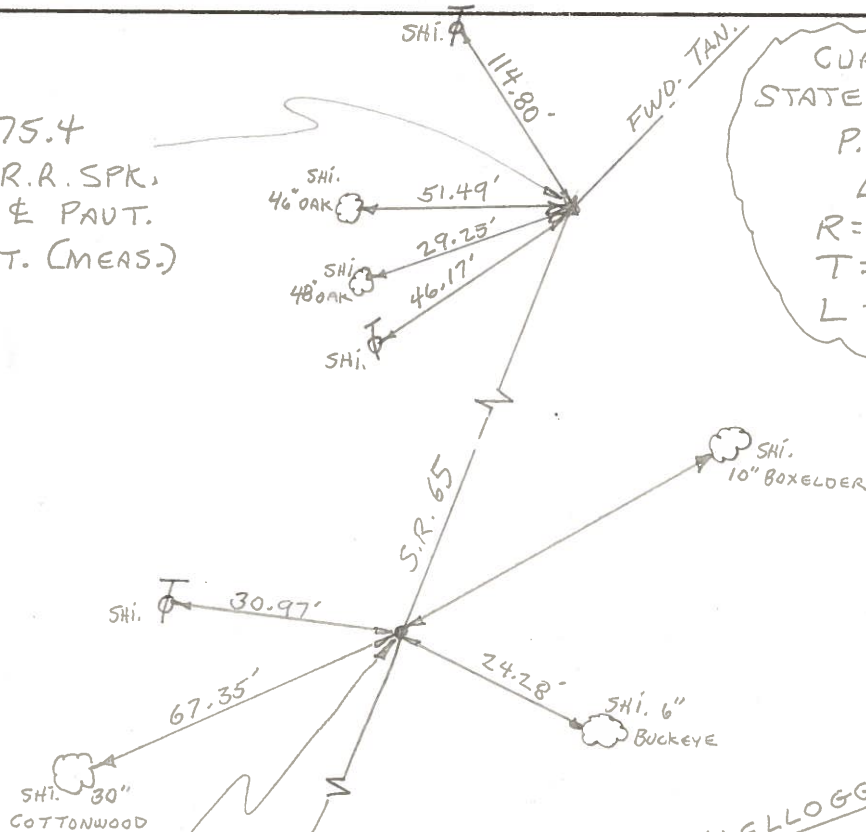

P.T. STA. 3+99.57
 SET P.K. NAIL IN CTR.
 PAUT.

NOTE: P.T. STA.
 TAKEN FROM STATE
 PLAN DATED 1934