

O.D.O.T. DISTRICT 2 SURVEY OFFICE (USE ONLY)

PERSONNEL

REFERENCE NO. 6

SHEET 26 OF 40

NOTES RHOADES

DATE 3/29/22

ROUTE SR 65

H.C. AUBLE

WEATHER CLEAR

COUNTY WOOD

R.C. KETNER

TEMP. 35°

TOWNSHIP GRAND RAPIDS

NIESE, O'DONNELL

SECTION 5

DWG BY RHOADES

PID 95796

T 5 N R 9 E

TYPE MONUMENT MAG NAIL

ON SURFACE - ~~BELOW~~ ON

OFFSET Q PAVEMENT 1.8' LT : ~~RT~~

8.5' TO LT EDGE PAVEMENT



STATION: 110+72.17

HORIZ.DATUM: NAD83 2011

GEOID: NAVD88 2018

GRID: NORTHING: 641009.630

EASTING: 1598670.228

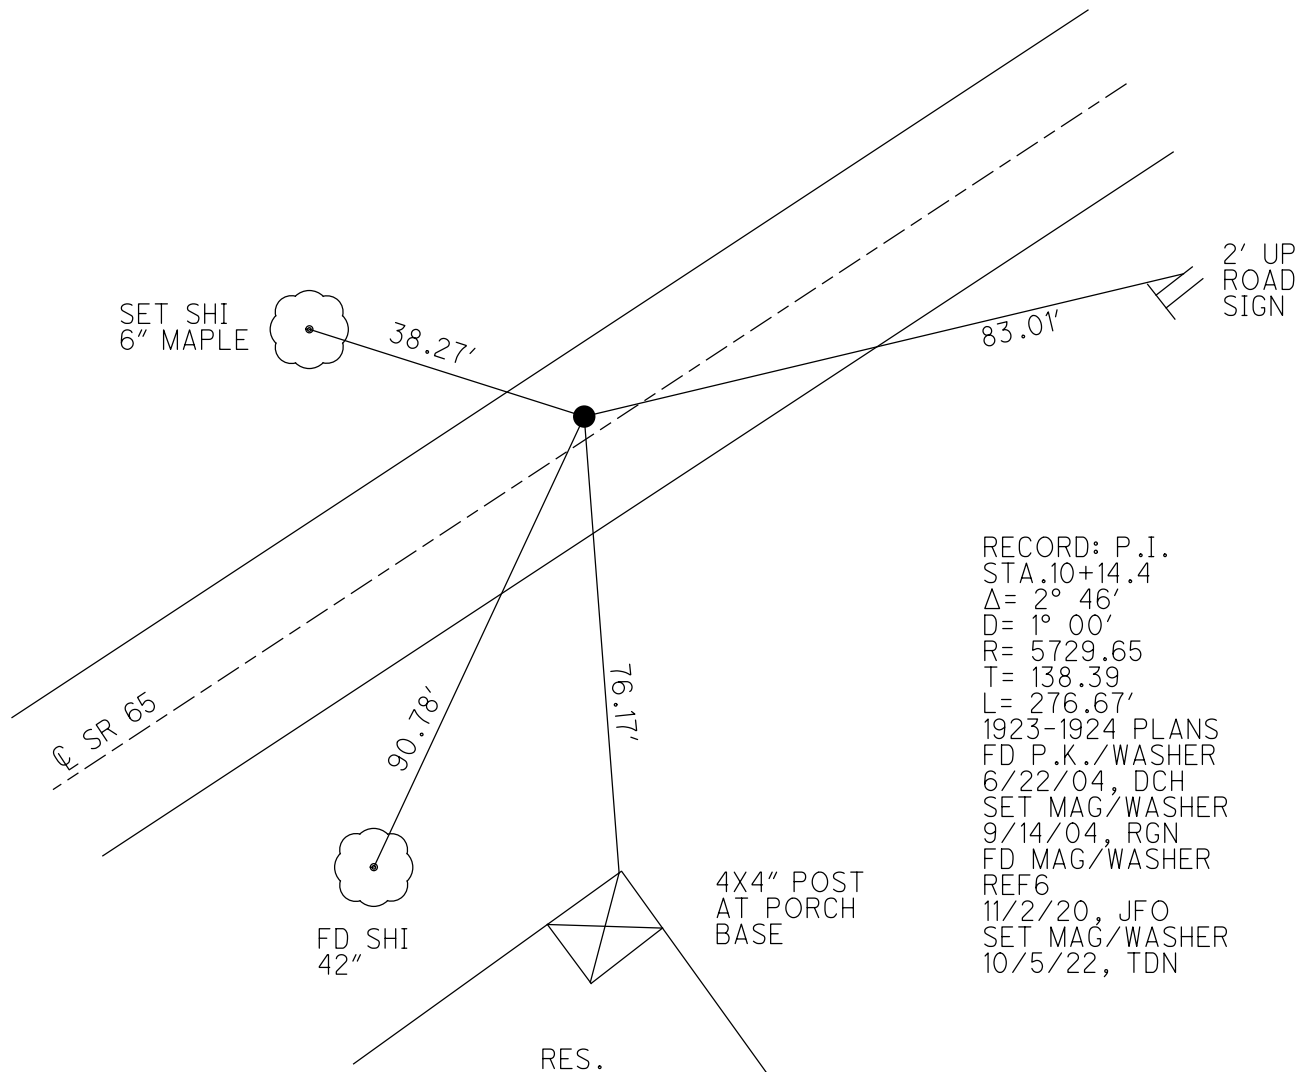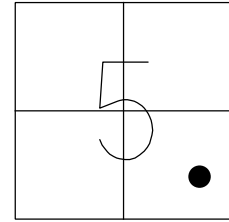

RECORD: P.I.  
 STA. 10+14.4  
 $\Delta = 2^\circ 46'$   
 $D = 1^\circ 00'$   
 $R = 5729.65$   
 $T = 138.39$   
 $L = 276.67'$   
 1923-1924 PLANS  
 FD P.K./WASHER  
 6/22/04, DCH  
 SET MAG/WASHER  
 9/14/04, RGN  
 FD MAG/WASHER  
 REF6  
 11/2/20, JFO  
 SET MAG/WASHER  
 10/5/22, TDN

# O.D.O.T. DISTRICT 2 SURVEY OFFICE

PERSONNEL \_\_\_\_\_

REFERENCE NO. 6

SHEET 19 OF 49

NOTES Nutten

H.C. Homan

R.C. Huss

DATE 6-22-04

WEATHER Sun.

TEMP. 76°F

ROUTE S.R. 65

COUNTY Wood

TOWNSHIP Grand Rapids

SECTION 5

T 5 N R 9 E


TYPE MONUMENT Fd. PK/w

~~ON SURFACE~~ - ~~BELOW~~ Surface

~~LEFT~~ - ~~RIGHT~~ 1.8' Lt.


8.5' TO Lt. EDGE PAVEMENT

S.L.M. 110 + 83

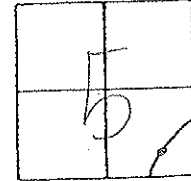

Record: 1923-1924 plans  
 P.T. = 10 + 14.4  
 $\Delta = 2^\circ 46'$   
 $D = 1^\circ 00'$   
 $R = 5729.65$   
 $T = 138.39$   
 $L = 276.67$

Set Mag/w,  
 9-14-04  
 SAH

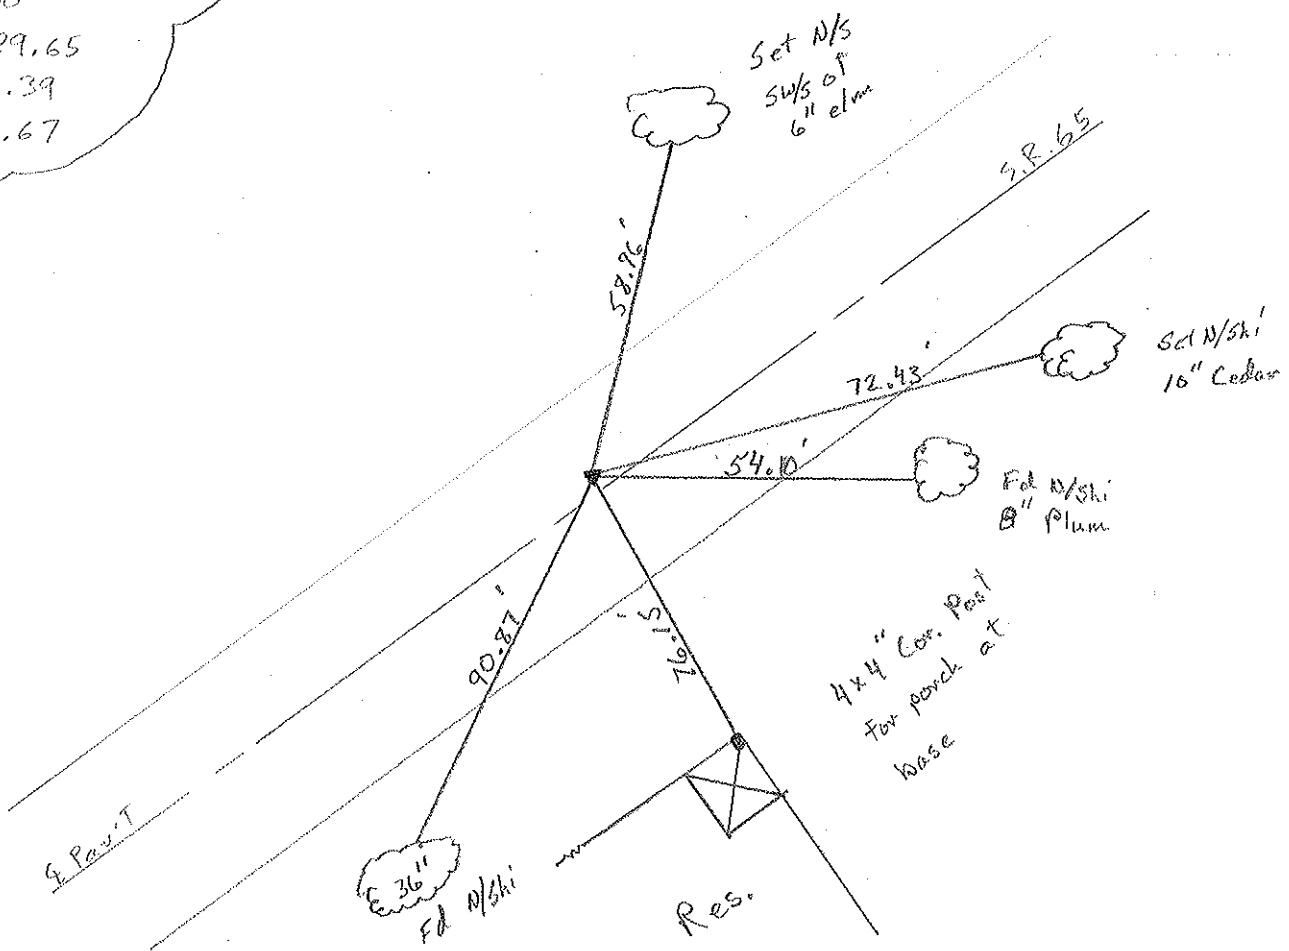

# O.D.O.T. DISTRICT 2 SURVEY OFFICE

PERSONNEL

REFERENCE NO. 6

SHEET 4 OF 34

NOTES BARNHISEL

H.C. CURTIS

R.C. VAN DUSEN

Lochake

Romero

DATE 4-22-92

WEATHER cloudy

TEMP. +50°

ROUTE SR 65

COUNTY WOOD

TOWNSHIP GRAND RAPIDS

SECTION 5

T5 N R 9 E

TYPE MONUMENT PK & WASHER set


5-4-92  
C.L.

ON SURFACE - BELOW yes

LEFT- & PAV'T. - RIGHT 1.5


8.1 TO LT EDGE PAVEMENT

S.L.M. 110+73

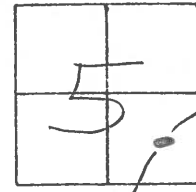

RECORD: 1923-1924 PLANS

- P.I. = 10+14.4
- Δ = 2°-46'
- D = 1°-00'
- R = 5729.65
- T = 138.39
- L = 276.67

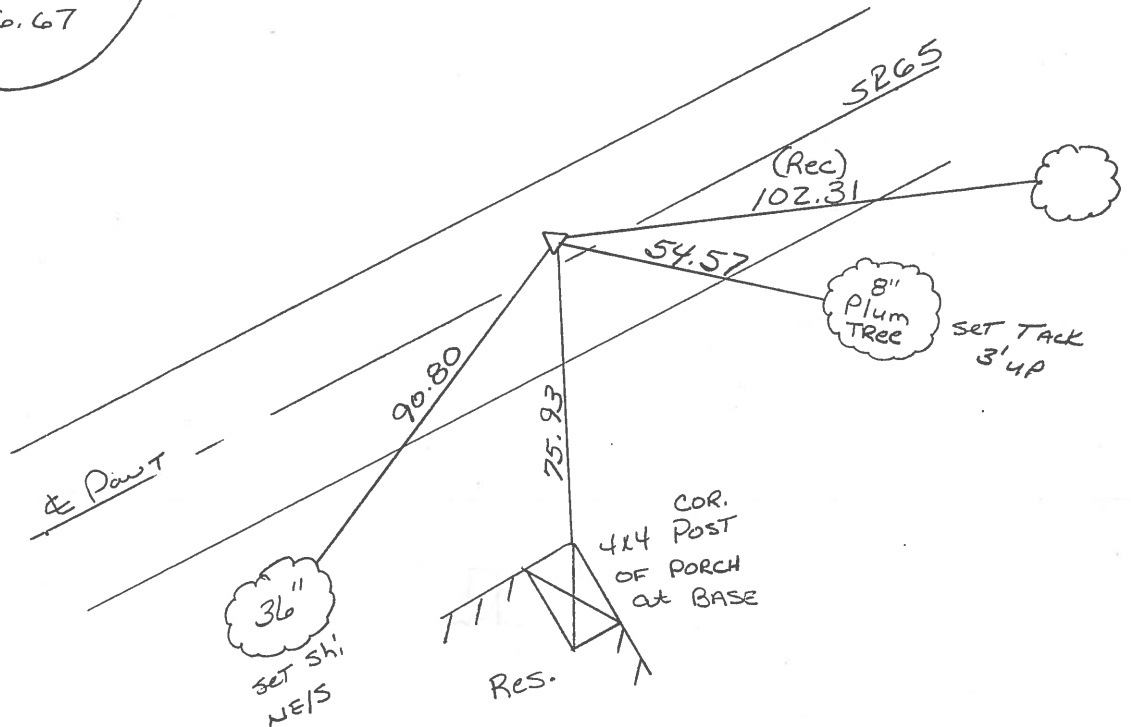

County Wood S.R. 65

Date 6-14-82  
12-10-81

Township Grand Rapids

Weather clear

Section 5

Temp. +24°


T5N, R9E

Personnel Hoffman

Loehke


Householder

6

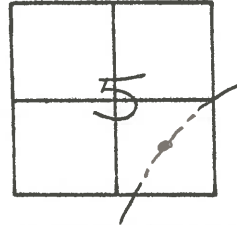

Fd. small R.R. SPK @ SURFACE  
1.8' Lt. of & PAUT  
8' to N.E.P.  
11' to S.E.P.

Project sta ± 110+83

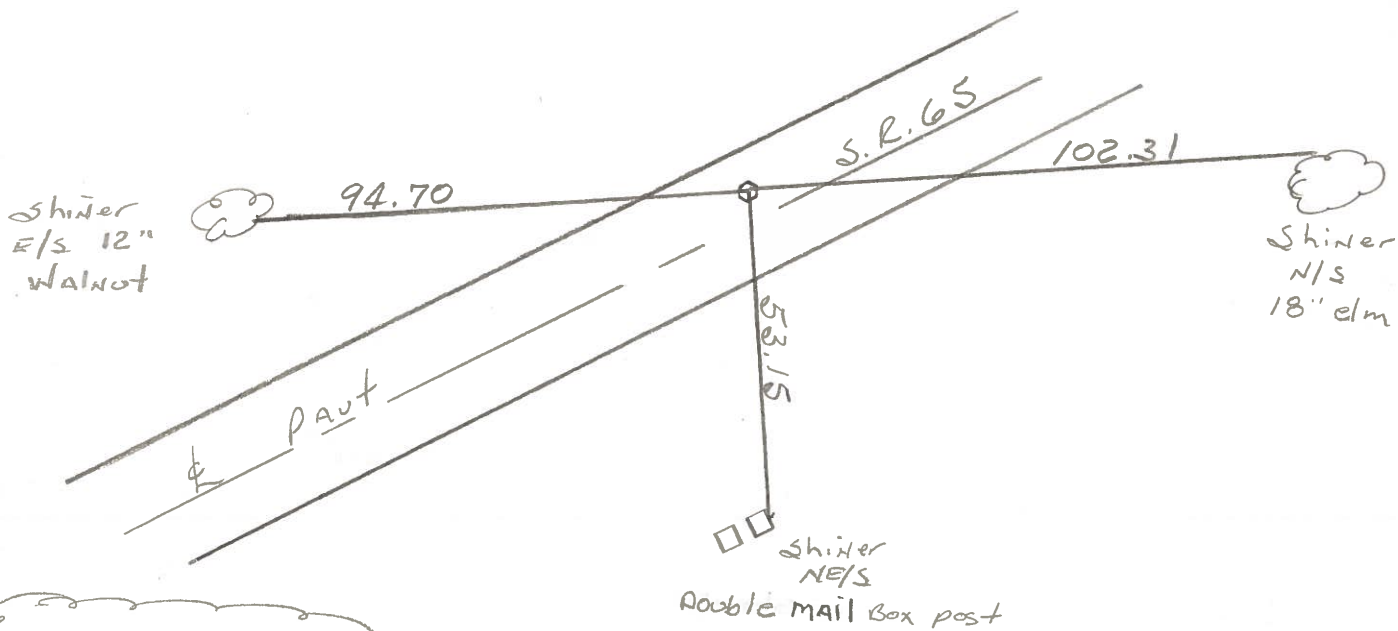

1923-24 PLANS  
P.I. 10+14.4  
 $\Delta = 2^{\circ}-46'$   
D = 10-0'  
R = 5729.65  
T = 138.39'  
L = 276.67'

County Wood S.R. 65

Date 12-10-81

Township Grand Rapids

Weather Clear

Section 5

Temp. +24°


T5N, R9E

Personnel Hoffman

Loehrke

Householder


6

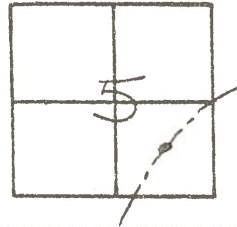

1. SMALL R.R. SPK @ SURFACE  
 1.8' Lt. of & PAUT  
 8' to N.E.P.  
 11' to S.E.P.

Protect Sta ± 110+83

Set P.K. washer  
 6-14-82  
 Sewd

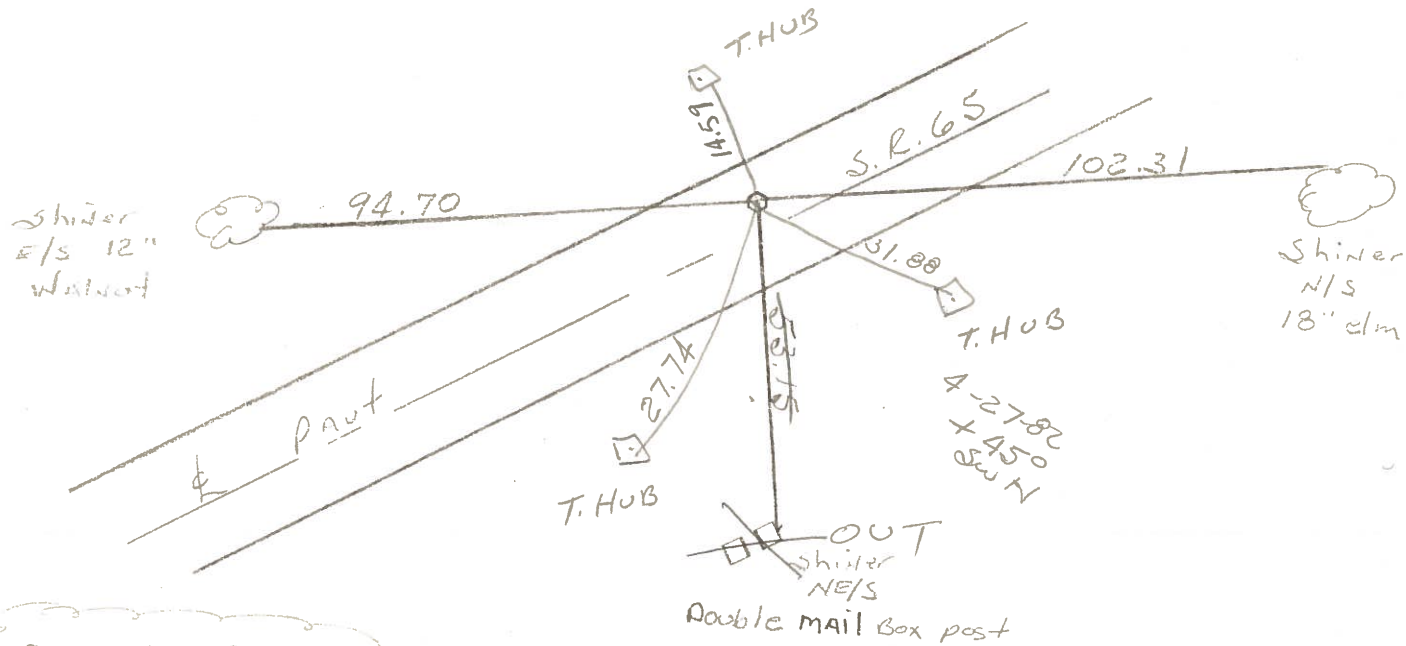

1923-24 PLANS  
 P.I. 10+14.4  
 $\Delta = 2^{\circ}-46'$   
 $D = 1^{\circ}-0'$   
 $R = 5729.65$   
 $T = 138.37'$   
 $L = 276.67'$