


O.D.O.T. DISTRICT 2 SURVEY OFFICE (USE ONLY)


PERSONNEL	REFERENCE NO. <u>7</u>	SHEET <u>27</u> OF <u>40</u>
NOTES <u>RHOADES</u>	DATE <u>3/29/22</u>	ROUTE <u>SR 65</u>
H.C. <u>NIESE</u>	WEATHER <u>CLEAR</u>	COUNTY <u>WOOD</u>
R.C. <u>KETNER</u>	TEMP. <u>35°</u>	TOWNSHIP <u>GRAND RAPIDS</u>
<u>AUBLE, O'DONNELL</u>		SECTION <u>5</u>
DWG BY <u>RHOADES</u>	PID <u>95796</u>	T <u>5</u> N R <u>9</u> E

TYPE MONUMENT MAG/WASHER  
 ON SURFACE - ~~BELOW~~ ON  
 OFFSET ☉ PAVEMENT 4.0' LT : ~~RT~~  
5.8' TO LT EDGE PAVEMENT  
 STATION: 114+51.42

HORZ. DATUM: NAD83 2011 GEOID: NAVD88 2018  
 GRID: NORTHING: 641324.276 EASTING: 1598882.054

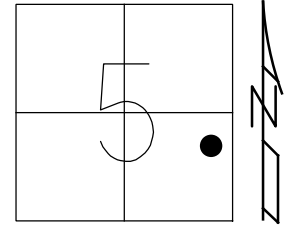

RECORD: P.I.  
 STA. 13+96  
 $\Delta = 7^\circ 17' RT$   
 $D = 4^\circ 00'$   
 $R = 1432.69$   
 $T = 91.55$   
 $L = 182.08'$   
 1923 PLANS  
 FD P.K./WASHER  
 6/22/04, DCH  
 SET MAG/WASHER  
 9/17/04, RGN  
 FD MAG/WASHER  
 REF7  
 11/2/20, JFO  
 SET MAG/WASHER  
 10/5/22, TDN

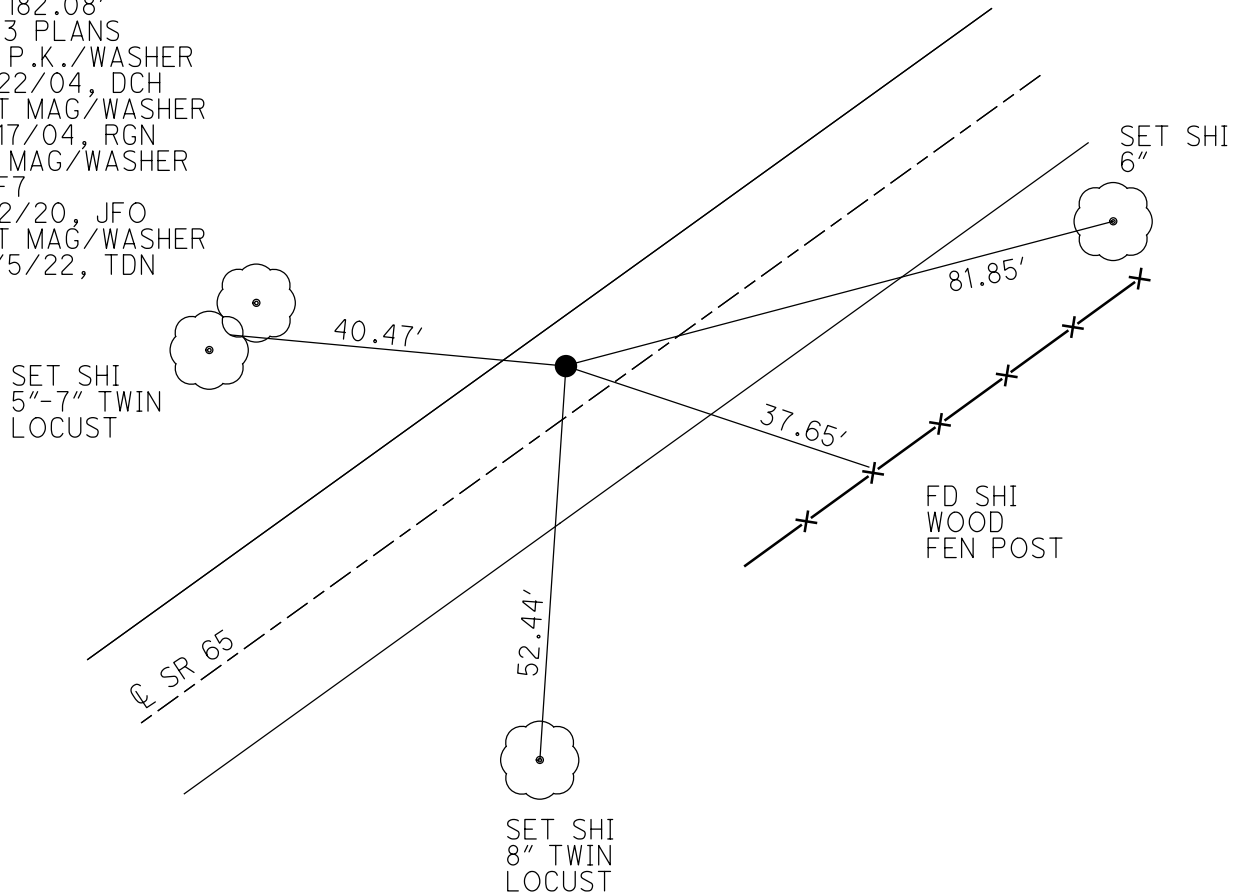

# O.D.O.T. DISTRICT 2 SURVEY OFFICE

PERSONNEL \_\_\_\_\_

REFERENCE NO. 7

SHEET 20 OF 49

NOTES Nuhter

H.C. Homan

R.C. Huss

DATE 6-22-04

WEATHER SUN.

TEMP. 76°

ROUTE S.R. 65

COUNTY Wood

TOWNSHIP Grand Rapids

SECTION 5

T. 5 N. R. 9 E.


TYPE MONUMENT PK/W

ON SURFACE - ~~PAV'T~~ Surface

LEFT - ~~PAV'T~~ RIGHT 4.0' Lt


5.8' TO Lt. EDGE PAVEMENT

S.L.M. 114+52

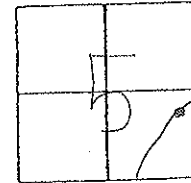

Records: 1923 Plans  
 P.I. = 13+96  
 $\Delta = 7^{\circ}17' RT$   
 $D = 4.00'$   
 $R = 1432.69$   
 $T = 91.55$   
 $L = 182.08$

Set Mas/W  
 9-17-04  
 RGN

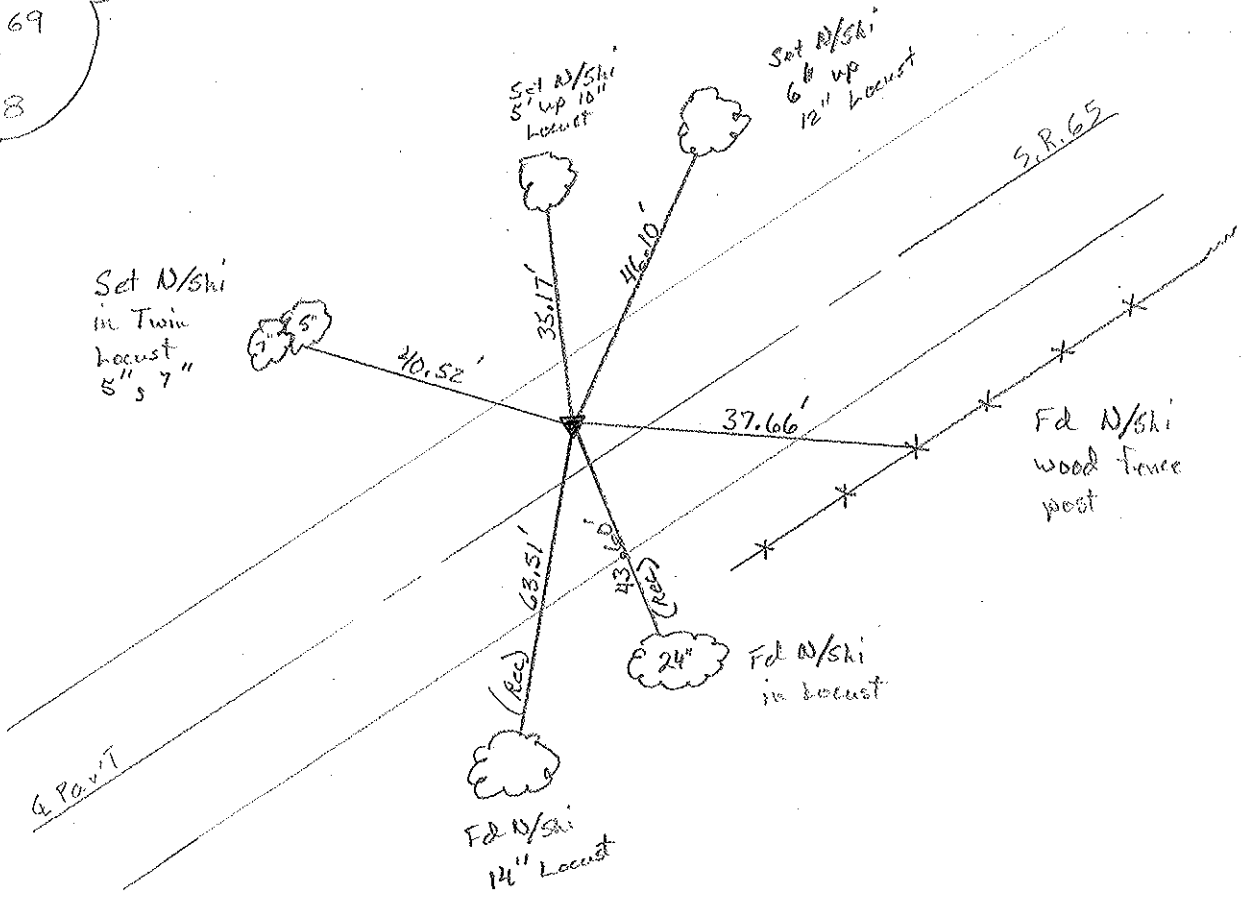

# O.D.O.T. DISTRICT 2 SURVEY OFFICE

PERSONNEL

REFERENCE NO. 7

SHEET 5 OF 34

NOTES BARNHISEL

H.C. CURTIS

R.C. VAN DUSEN

Lochke

RomeTO

DATE 4-22-92

WEATHER Cloudy

TEMP. +50°

ROUTE SR 65

COUNTY WOOD

TOWNSHIP GRAND RAPIDS

SECTION 5

T 5 N R 9 E

TYPE MONUMENT PK & WASHER Reset


5-4-92  
C.L.

ON SURFACE - BELOW yes

LEFT- & PAV'T. - RIGHT 3.9

5.6 TO LT EDGE PAVEMENT

S.L.M. 114+52

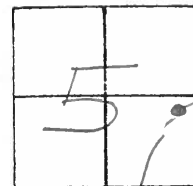

RECORD: 1923 PLANS

P. I. = 13+96


$\Delta = 7^\circ - 17' RT.$

D = 4° - 00'

R = 1432.69

T = 91.55

L = 182.08

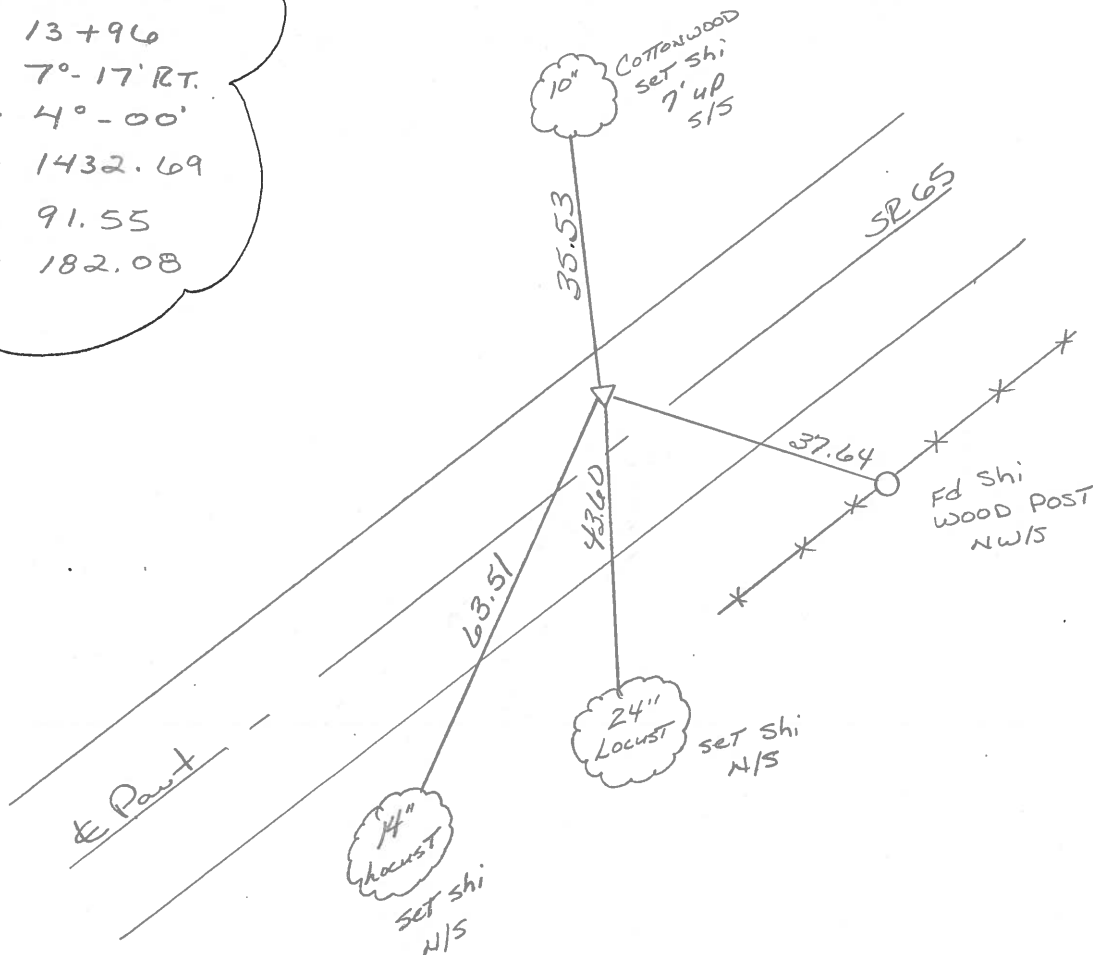

OD.O.T. DISTRICT 2 SURVEY OFFICE

SHEET 13 OF     

6-9-82

Date 12-10-81

Weather clear

Temp. +24°

County Wood S.R. 65

Township Grand Rapids

Section 5


EN, R9E

Personnel Hoffman

Loehrke

Hooseholder

①

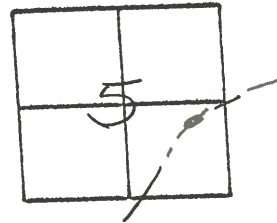

Fd. small R.R. spk @ surface

4.2' Lt of & PAUT

5.1' to N.E.P.

13.0' to S.E.P.

Protect sta ± 114+62

1923 PLANS

P.I. 13+96


$\Delta = 7^\circ - 17' \text{ Rt.}$

D = 4°-0'

R = 1432.69

T = 91.55

L = 182.08

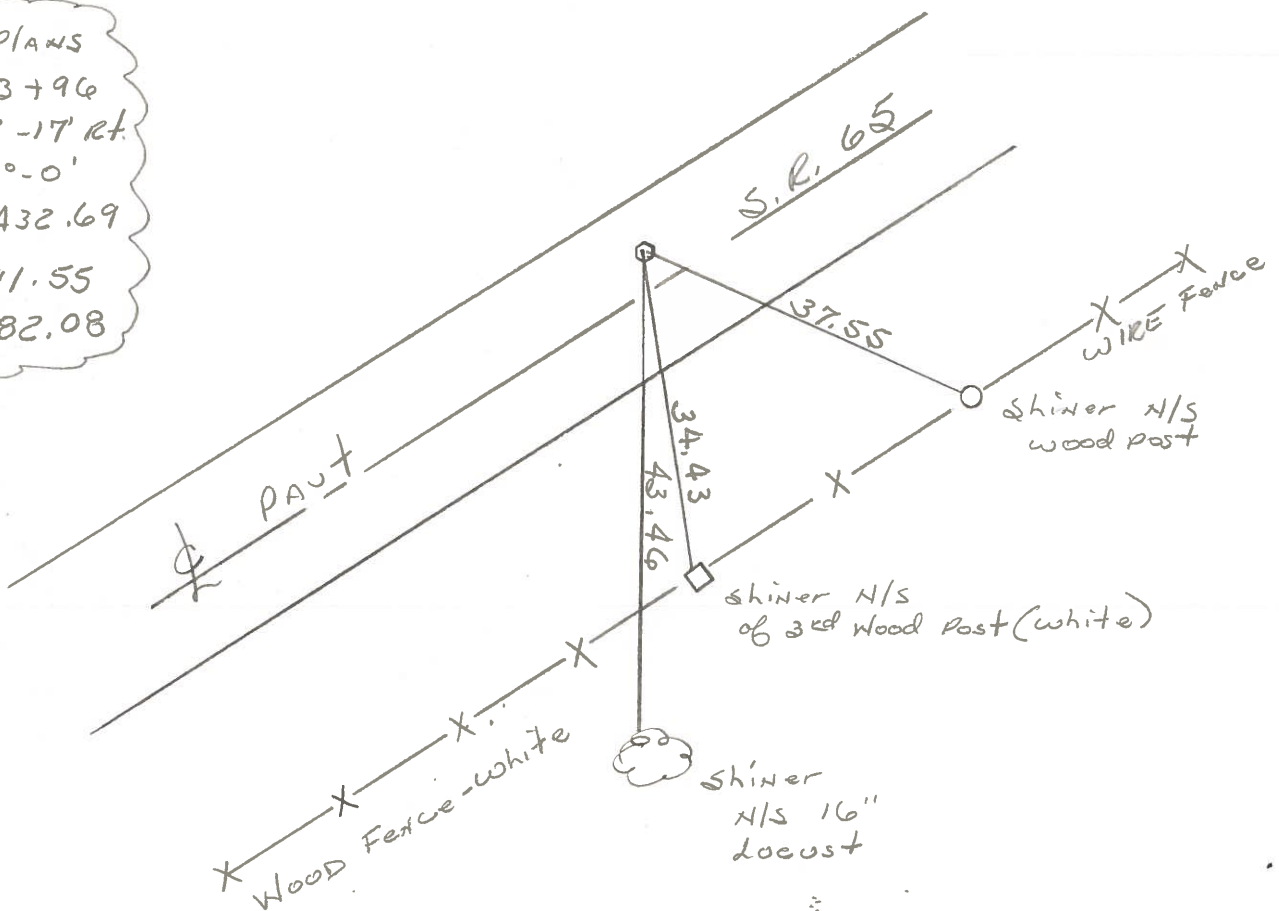


PERSONNEL	TITLE	PERSONNEL	TITLE
BURNSIDE			
SMITH			
BOWERS			

COUNTY WOOD DATE 9-27-72

S. R. 65 WEATHER CLOUDY


SEC. GRAND RAPIDS TWP TEMP. +63°

DESCRIPTION ESTABLISH P.I. JOB NO. 24°

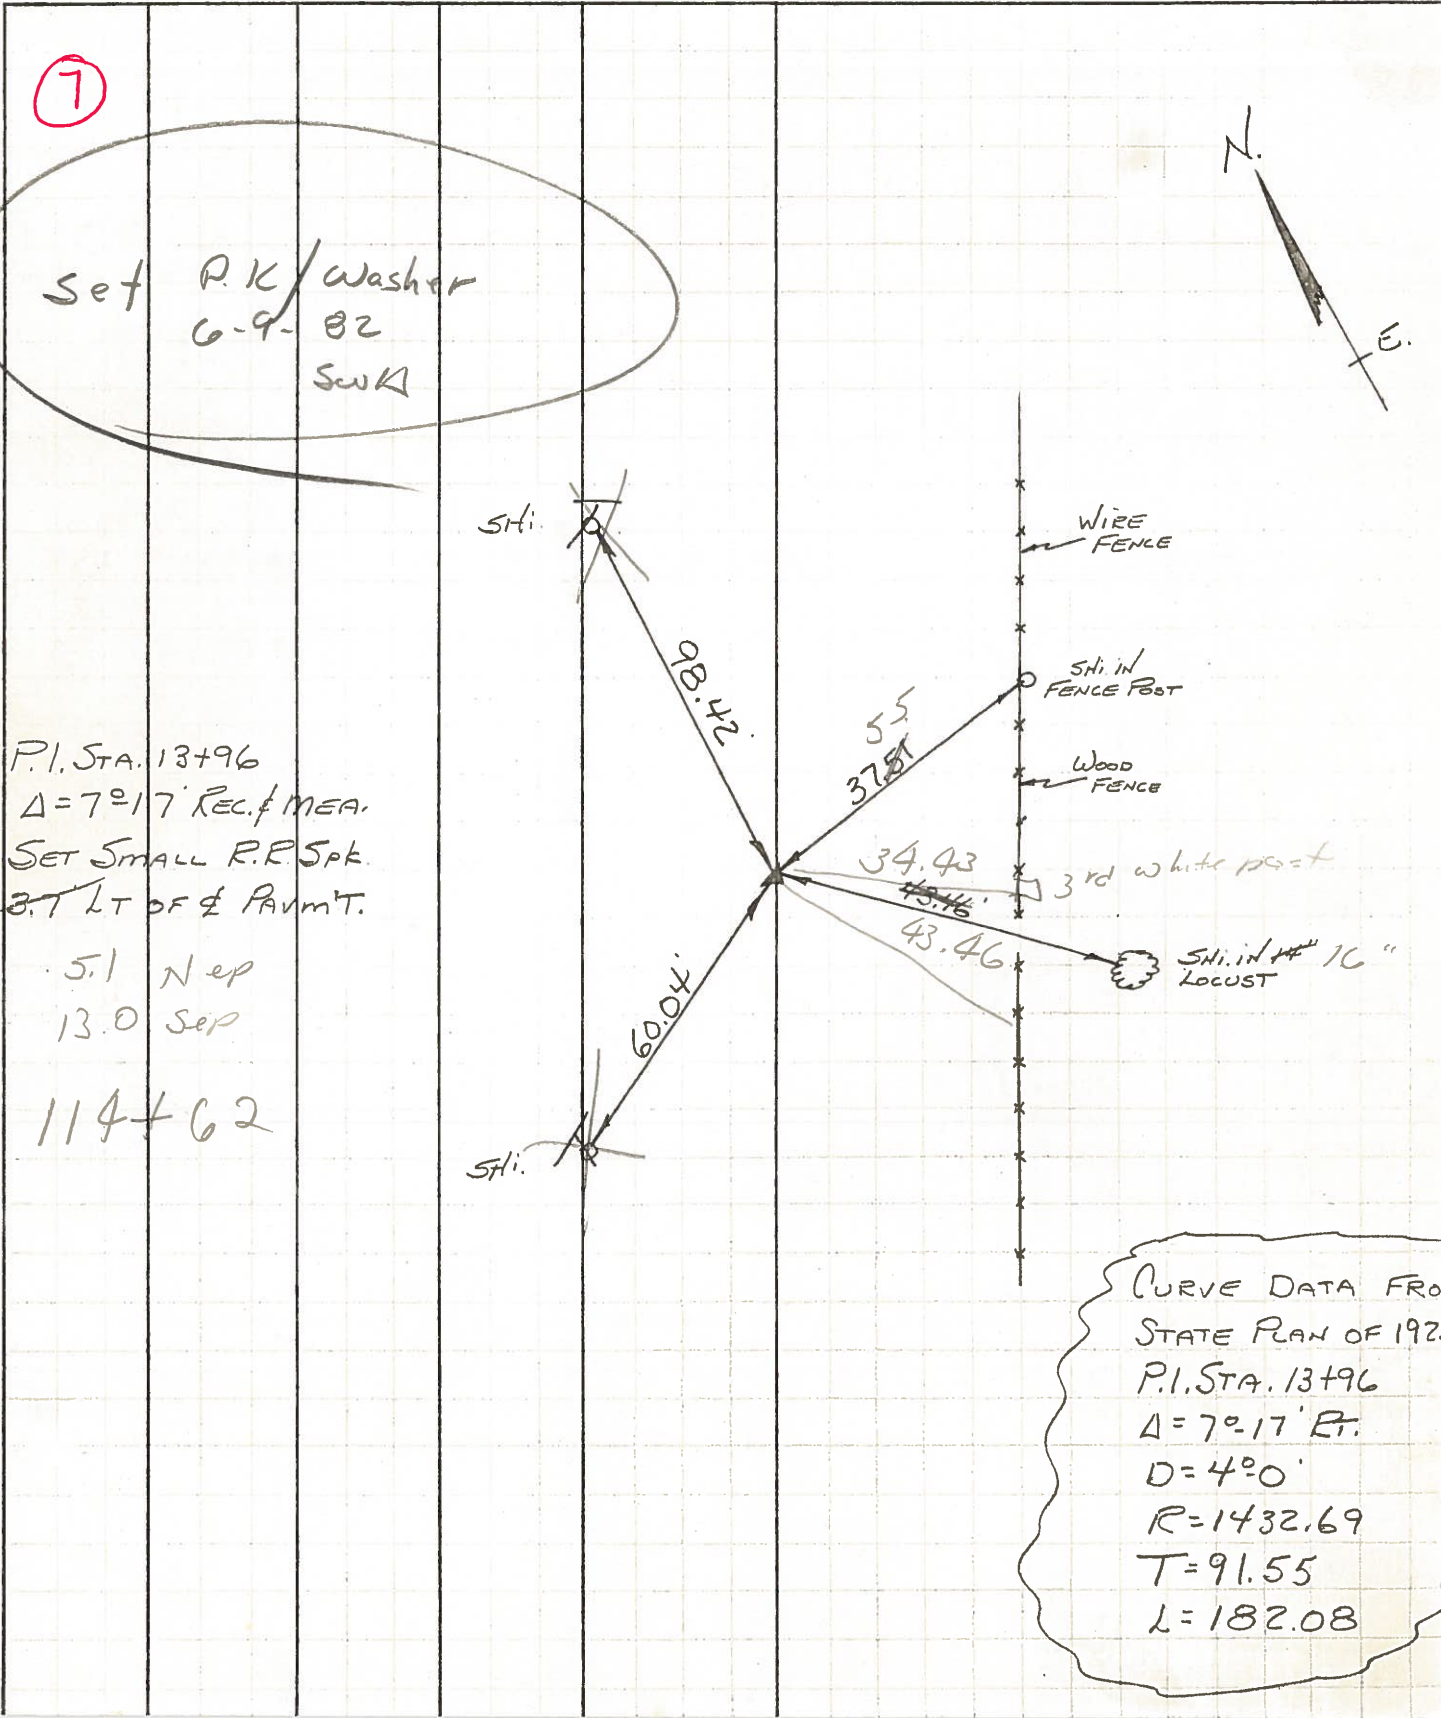

⑦

Set P.K. washer  
6-9-82  
SWK

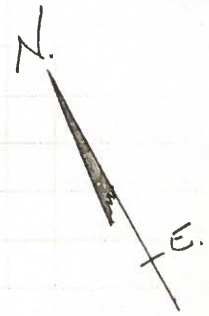

P.I. STA. 13+96  
 $\Delta = 7^\circ 17'$  REC. & MEAS.  
 SET SMALL R.F. SPK.  
 4.2 B.T. LT OF E. PERMIT.  
 5.1 N ep  
 13.0 Sep  
 114+62

CURVE DATA FROM  
 STATE PLAN OF 192.  
 P.I. STA. 13+96  
 $\Delta = 7^\circ 17'$  ET.  
 $D = 4^\circ 0'$   
 $R = 1432.69$   
 $T = 91.55$   
 $L = 182.08$

PERSONNEL	TITLE	PERSONNEL	TITLE
BURNSIDE			
SMITH			
BOWERS			

COUNTY Wood DATE 9-27-72  
 S. R. 65 WEATHER Cloudy  
 SEC. GRAND RAPIDS TWP TEMP. +63°

DESCRIPTION Establish P.I. JOB NO. \_\_\_\_\_

