

O.D.O.T. DISTRICT 2 SURVEY OFFICE (USE ONLY)

PERSONNEL

REFERENCE NO. 7 A

SHEET 28 OF 40

NOTES RHOADES  
 H.C. NIESE  
 R.C. KETNER  
AUBLE

DATE 3/30/22  
 WEATHER CLOUDY  
 TEMP. 40°

ROUTE SR 65  
 COUNTY WOOD  
 TOWNSHIP GRAND RAPIDS  
 SECTION 5  
T 5 N R 9 E

DWG BY RHOADES PID 95796

TYPE MONUMENT MAG/WASHER

ON SURFACE - ~~BELOW~~ ON

OFFSET Q PAVEMENT 9.0' LT : ~~RT~~  
1.4' TO LT EDGE PAVEMENT


STATION: 119+56.12

HORIZ.DATUM: NAD83 2011


GEOID: NAVD88 2018

GRID: NORTHING: 641704.249

EASTING: 1599214.602

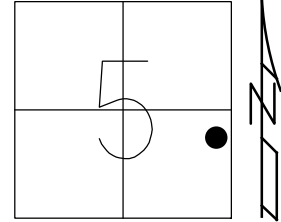

RECORD: P.I.  
 STA. 19+01.4  
 $\Delta = 12^\circ 40'$  RT  
 $D = 4^\circ 20'$   
 $R = 1322.53$   
 $T = 146.80$   
 $L = 292.48$   
 1923-1924 PLANS  
 FD P.K./WASHER  
 6/22/04, DCH  
 SET MAG/WASHER  
 9/14/04, RGN  
 FD MAG NAIL  
 REFA7  
 11/2/20, JFO  
 SET MAG/WASHER  
 10/5/22, TDN

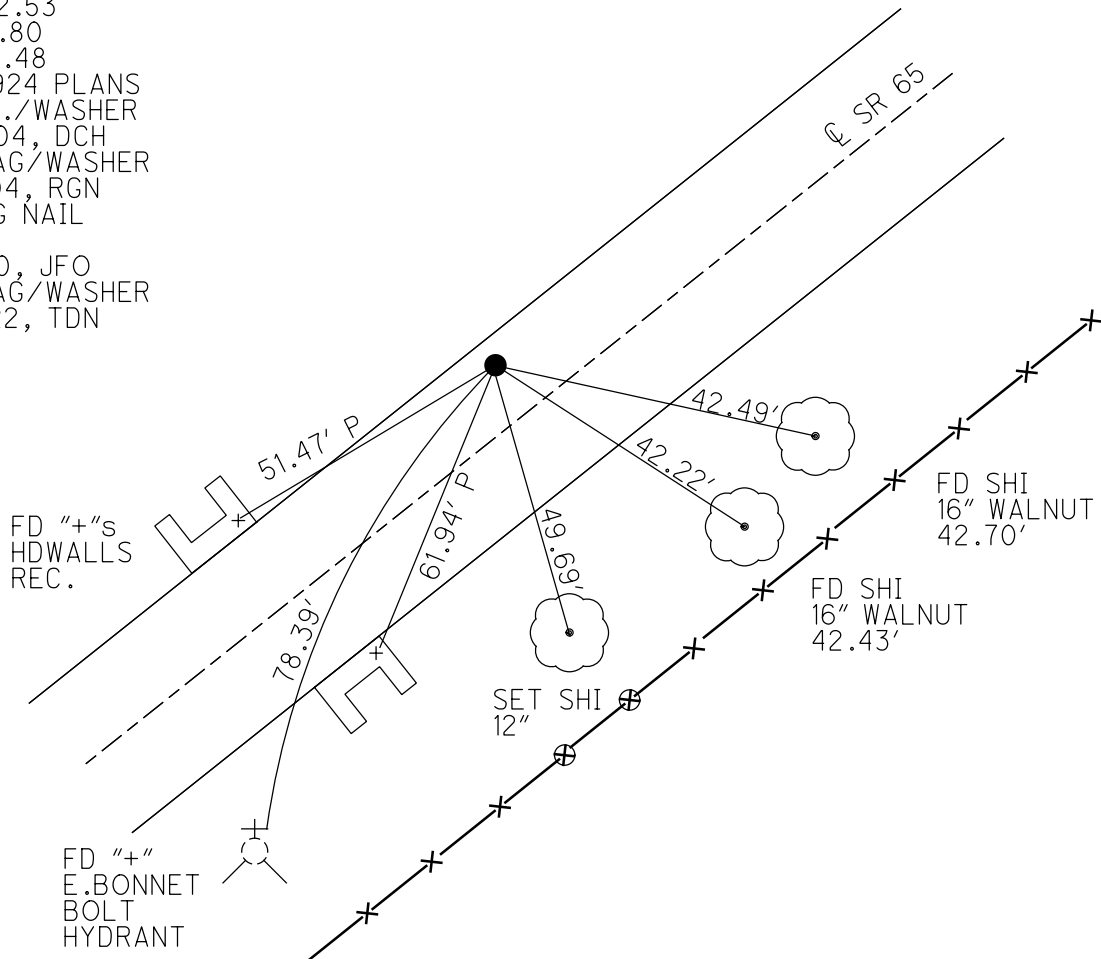

# O.D.O.T. DISTRICT 2 SURVEY OFFICE

PERSONNEL

REFERENCE NO. 7A

SHEET 21 OF 49

NOTES Nuhter

H.C. Homan

R.C. Huss

DATE 6-22-04

WEATHER Sun

TEMP. 78°F

ROUTE S.R. 65

COUNTY Wood

TOWNSHIP Grand Rapids

SECTION 5

T5 N R 9 E



TYPE MONUMENT Fd PK/w

ON SURFACE - ~~BELOW~~ Surface

LEFT - ℄ PAW'T. - RIGHT 9.0'


1.4' TO RT. EDGE PAVEMENT

S.L.M. 119 + 86

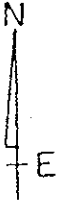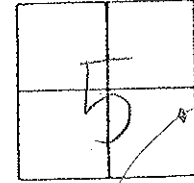

Record: 1923-1924 Plans  
 P.I. = 19 + 01.4  
 $\Delta = 12^\circ - 40' RT$   
 $D = 4^\circ - 20'$   
 $R = 1322.53$   
 $T = 146.80$   
 $L = 292.48$

Set Mas/w  
 9-14-04  
 RGA

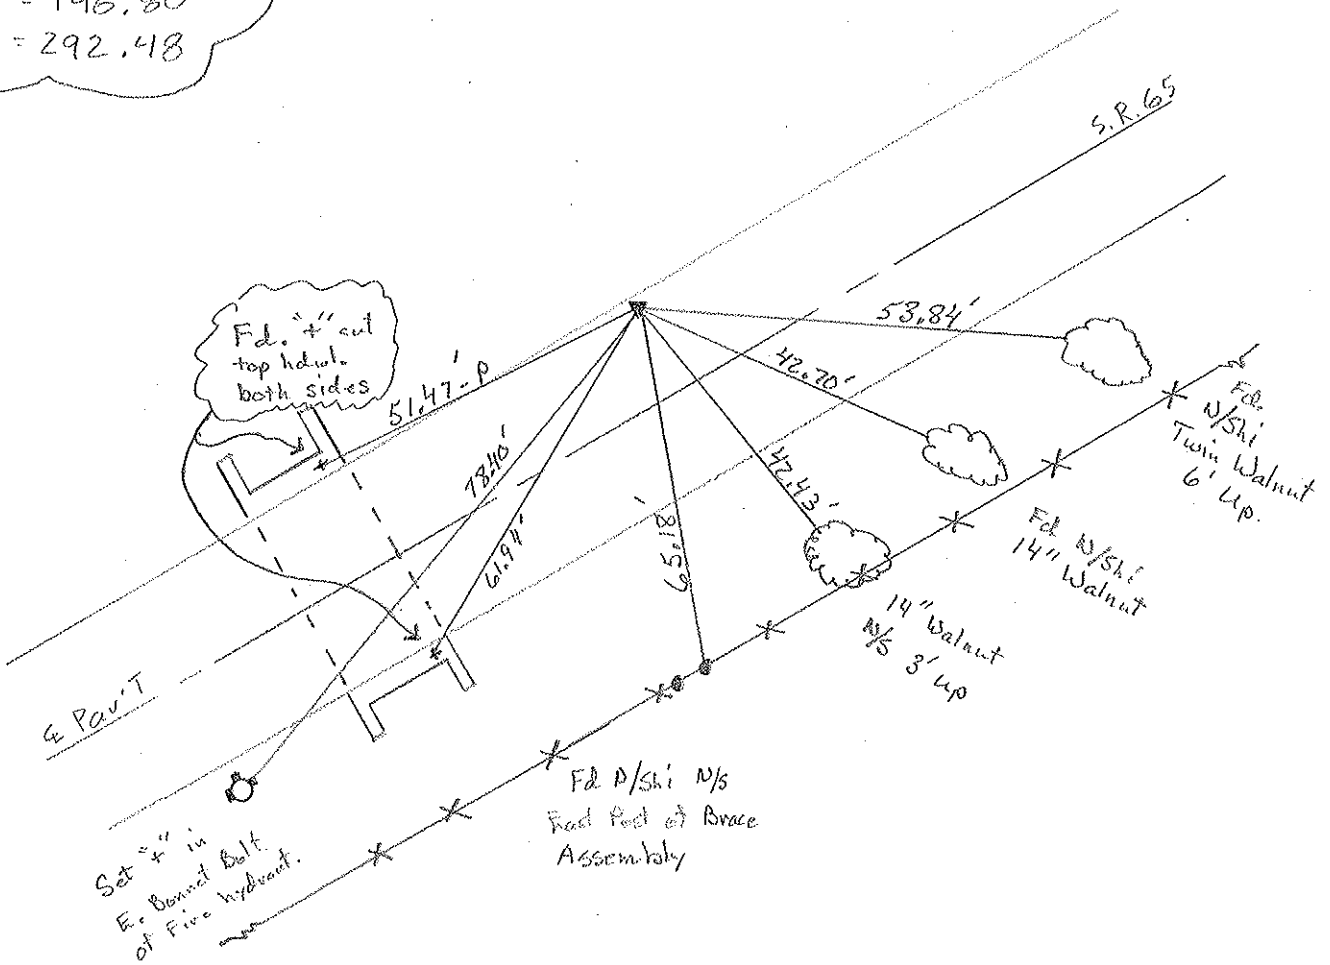

# O.D.O.T. DISTRICT 2 SURVEY OFFICE

PERSONNEL

REFERENCE NO. 7A

SHEET 6 OF 34

NOTES BARNHISEL

H.C. CURTIS

R.C. VAN DUSEN

Loehrke

Romero

DATE 4-22-92

WEATHER cloudy

TEMP. +50°

ROUTE SR 65

COUNTY Wood

TOWNSHIP GRAND RAPIDS

SECTION 5

T5 N R 9 E

Reset

TYPE MONUMENT PK & WASHER

5-4-92

ON SURFACE - BELOW

yes


C.L.

LEFT- & PAV'T. - RIGHT

8.6

0.7 TO LT EDGE PAVEMENT

S.L.M. 119+56

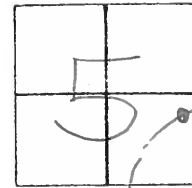

RECORD: 1923-1924 PLANS

P.I. = 19+01.4


$\Delta = 12^\circ - 40' 27''$

D = 4°-20'

R = 1322.53

T = 146.80

L = 292.48

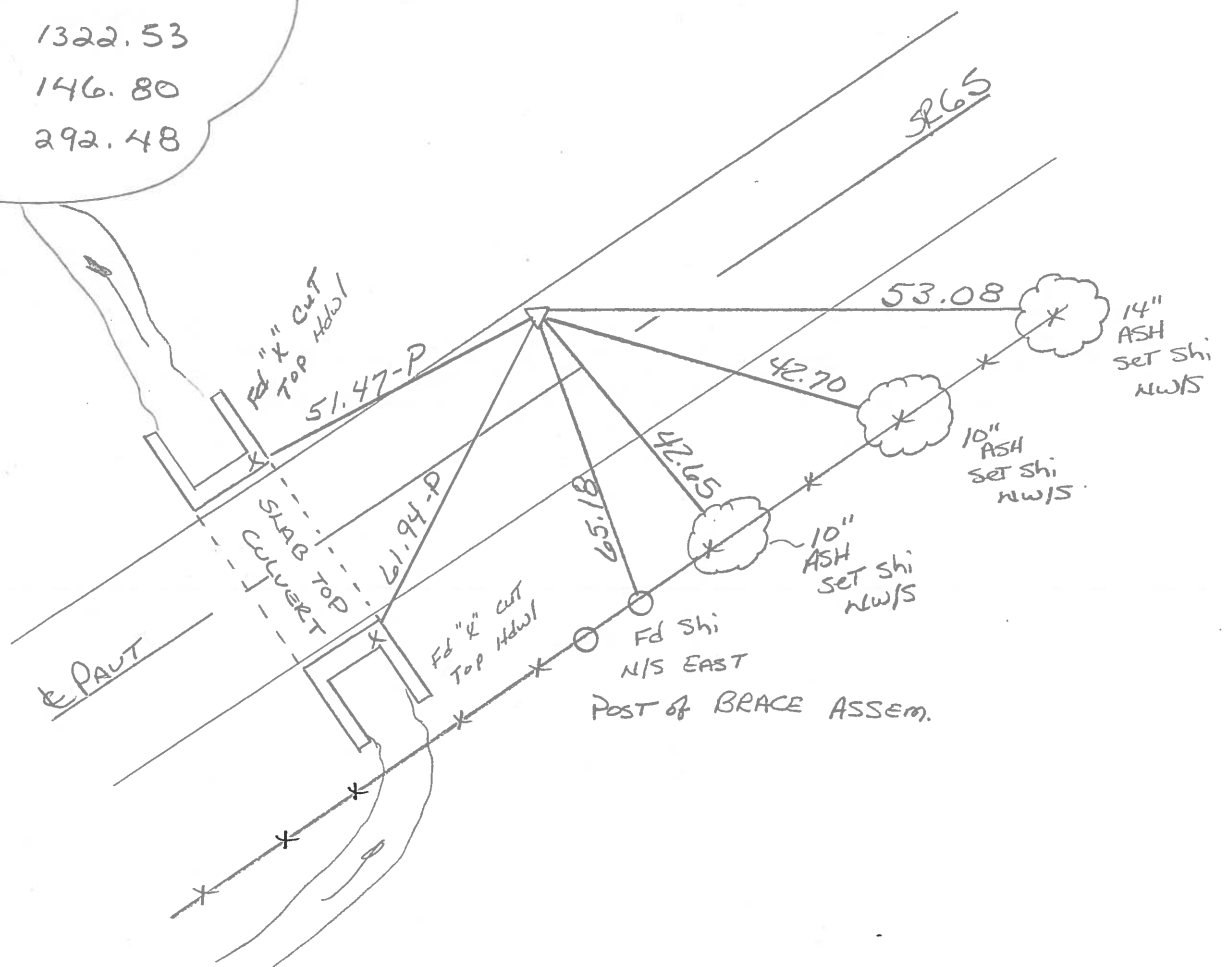

OD.O.T. DISTRICT 2 SURVEY OFFICE

SHEET 14 OF       

County Wood S.R. 65

Date 6-9-82  
12-10-81

Township Grand Rapids

Weather clear

Section 5

Temp.       


5N, R9E

Personnel Hoffman

Loehke


Householder

7-A

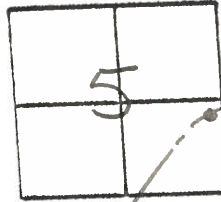

Fd. small R.R. SPK @ Surface  
8.6' Lt. of  $\frac{1}{2}$  PAUT  
@ N.E.P.

Project Sta ± 119+76

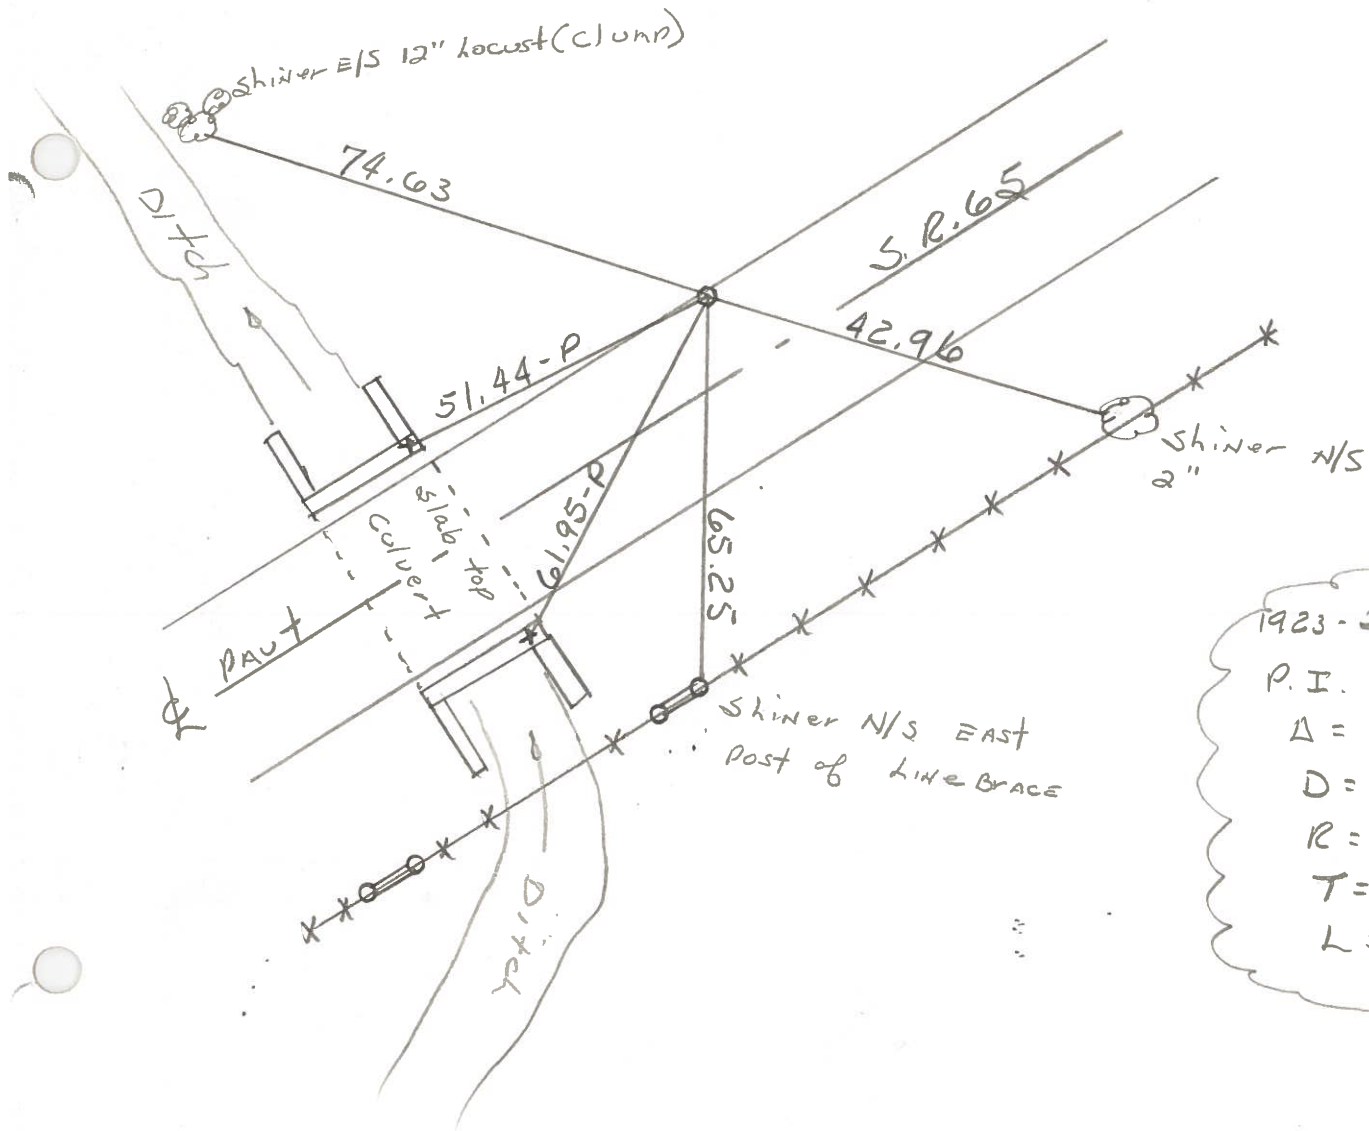


1923-24 PLANS  
P.I. 19+01.4  
 $\Delta = 12^\circ - 40' RT$   
D = 4°-20'  
R = 1322.53  
T = 146.80  
L = 292.48

PERSONNEL	TITLE	PERSONNEL	TITLE
BURNSIDE			
SMITH			
BOWERS			

COUNTY WOOD DATE 9-28-72  
 S. R. 65 WEATHER CLOUDY  
 SEC. GRAND RAPIDS TWP TEMP. +60°

DESCRIPTION ESTABLISH P.I. LEFT CENTER LINE RIGHT JOB NO.

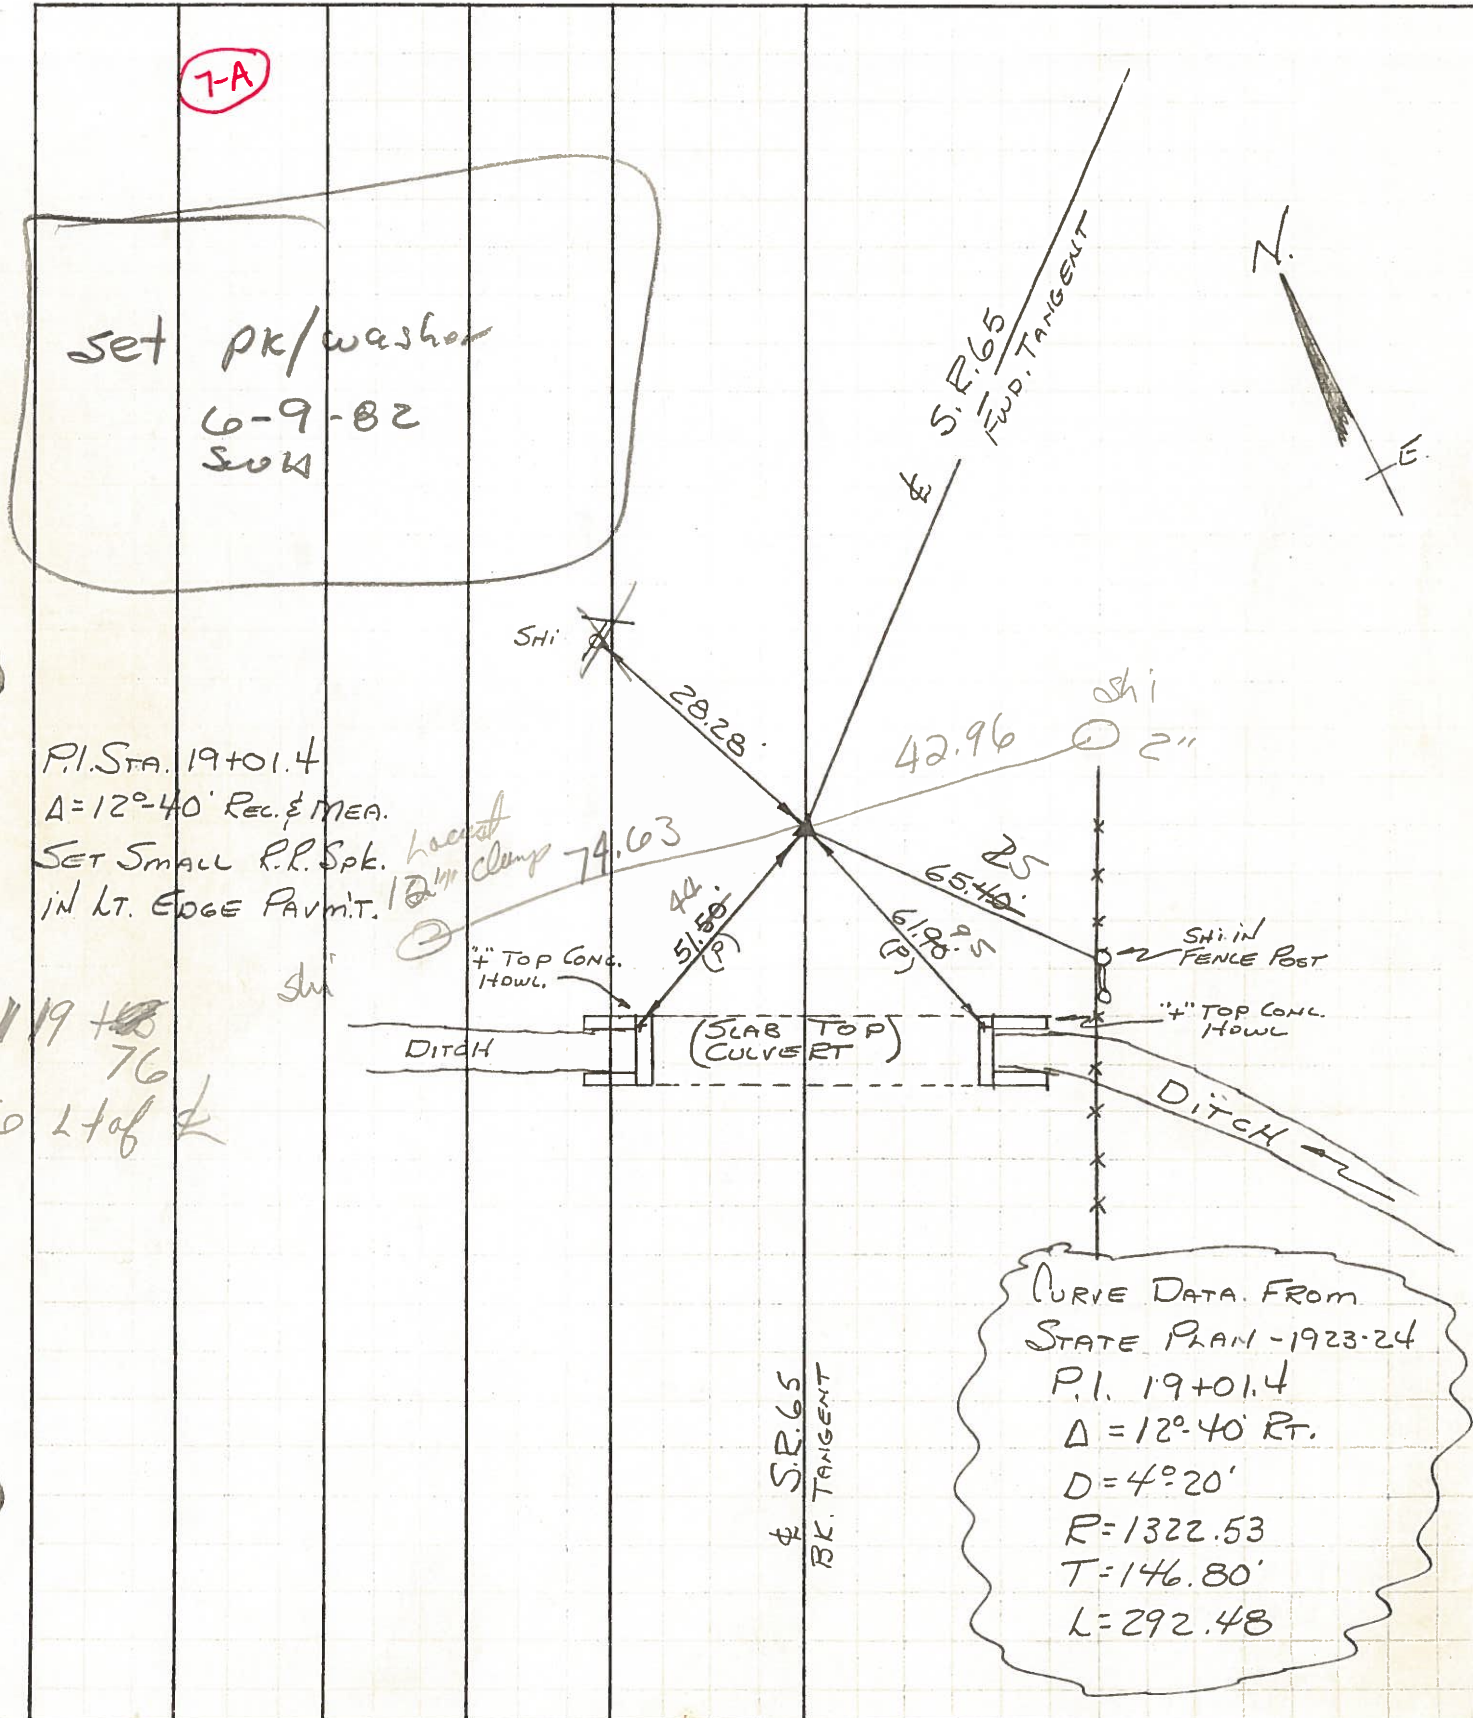

7-A

set pk/washer  
 6-9-82  
 SWK



P.I. STA. 19+01.4  
 $\Delta = 12^\circ 40'$  REC. & MEA.  
 SET SMALL R.R. SPK. IN LT. EDGE PERMIT.

119 + 76  
 B.6 Lt of

CURVE DATA FROM  
 STATE PLAN - 1923-24  
 P.I. 19+01.4  
 $\Delta = 12^\circ 40'$  RT.  
 $D = 4^\circ 20'$   
 $R = 1322.53$   
 $T = 146.80'$   
 $L = 292.48$



PERSONNEL TITLE PERSONNEL TITLE COUNTY WOOD DATE 9-28-72  
BURNSIDE \_\_\_\_\_  
SMITH \_\_\_\_\_ S. R. 65 WEATHER CLOUDY  
BOWERS \_\_\_\_\_ SEC. GRAND RAPIDS TWP TEMP. +60°

DESCRIPTION ESTABLISH P.I. JOB NO. \_\_\_\_\_

