

O.D.O.T. DISTRICT 2 SURVEY OFFICE (USE ONLY)

PERSONNEL

REFERENCE NO. 7 B

SHEET 29 OF 40

NOTES RHOADES

DATE 3/30/22

ROUTE SR 65

H.C. NIESE

WEATHER CLOUDY

COUNTY WOOD

R.C. KETNER

TEMP. 40°

TOWNSHIP GRAND RAPIDS

AUBLE

SECTION 4

DWG BY RHOADES

PID 95796

T 5 N R 9 E

TYPE MONUMENT MAG/WASHER

ON SURFACE - ~~BELOW~~ ON

OFFSET Q PAVEMENT 3.5' LT : ~~RT~~

7.5' TO LT EDGE PAVEMENT


STATION: 126+23.68

HORZ.DATUM: NAD83 2011


GEOID: NAVD88 2018

GRID: NORTHING: 642098.608

EASTING: 1599754.709

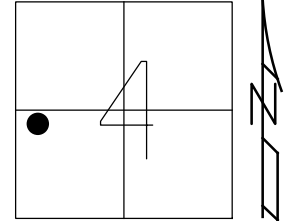

RECORD: P.I.  
 STA. 25+70.5  
 $\Delta = 5^\circ 27' \text{ RT}$   
 $D = 3^\circ 00'$   
 $R = 1910.08$   
 $T = 91.30$   
 $L = 181.66'$   
 FD P.K./WASHER  
 6/22/04, DCH  
 SET MAG/WASHER  
 9/16/04, SAH  
 FD MAG/WASHER  
 REFB7  
 11/2/20, JFO  
 SET MAG/WASHER  
 10/5/22, TDN

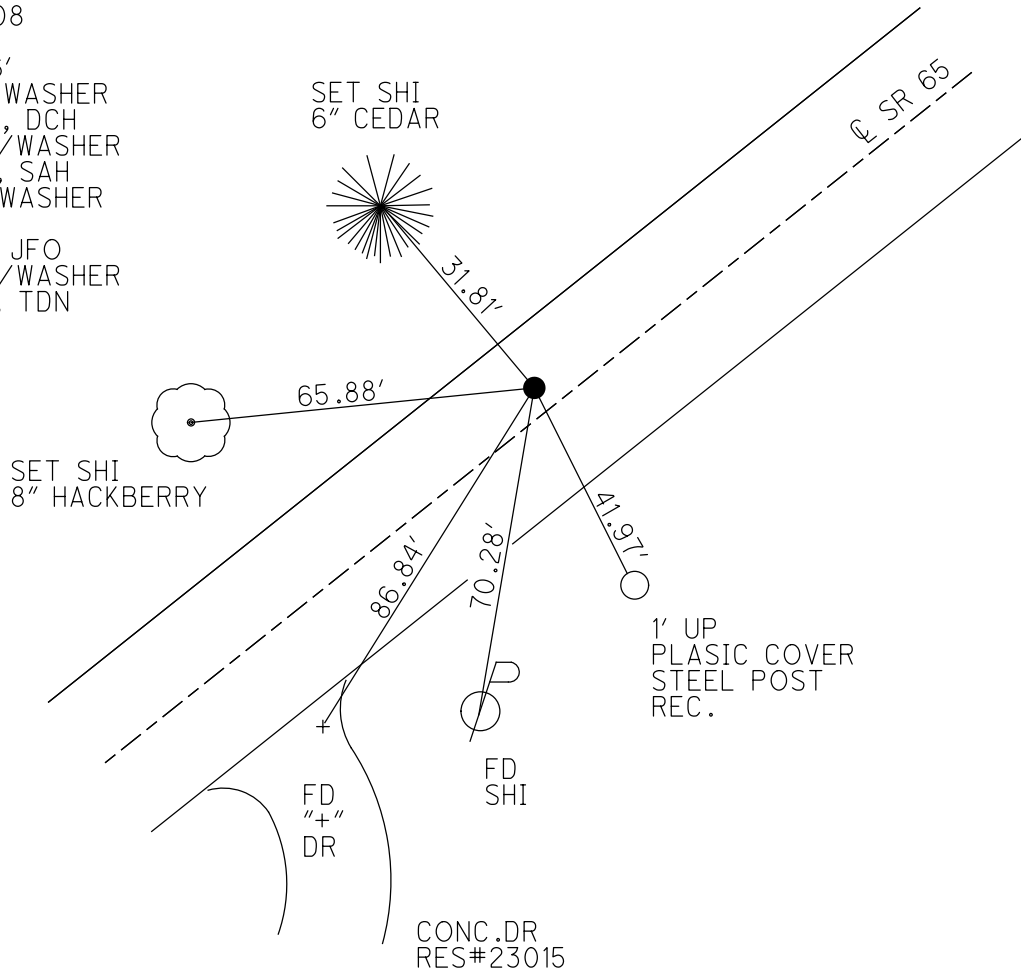

# O.D.O.T. DISTRICT 2 SURVEY OFFICE

PERSONNEL \_\_\_\_\_

REFERENCE NO. 7 B

SHEET 22 OF 49

NOTES Duhter

H.C. Homar

R.C. Huss

DATE 6-22-04

WEATHER Sun

TEMP. 78°F

ROUTE S.R. 65

COUNTY Wood

TOWNSHIP Grand Rapids

SECTION 4

T 5 N 9 E


TYPE MONUMENT \_\_\_\_\_ PK/W \_\_\_\_\_

~~ON SURFACE~~ ~~BEND~~ surface

~~LEFT~~ ~~RIGHT~~ 3.0' LT


7.5' TO Lt. EDGE PAVEMENT

S.L.M. 126+2.5

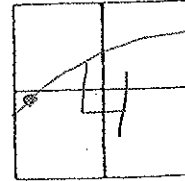

Record:  
 P.I. = 25+70.5  
 $\Delta = 5^{\circ}-27'$  RT  
 $D = .3^{\circ}-00'$   
 $R = 1910.08$   
 $T = 91.30$   
 $L = 181.66$

Set Mag/w  
 9-16-04  
 SAH

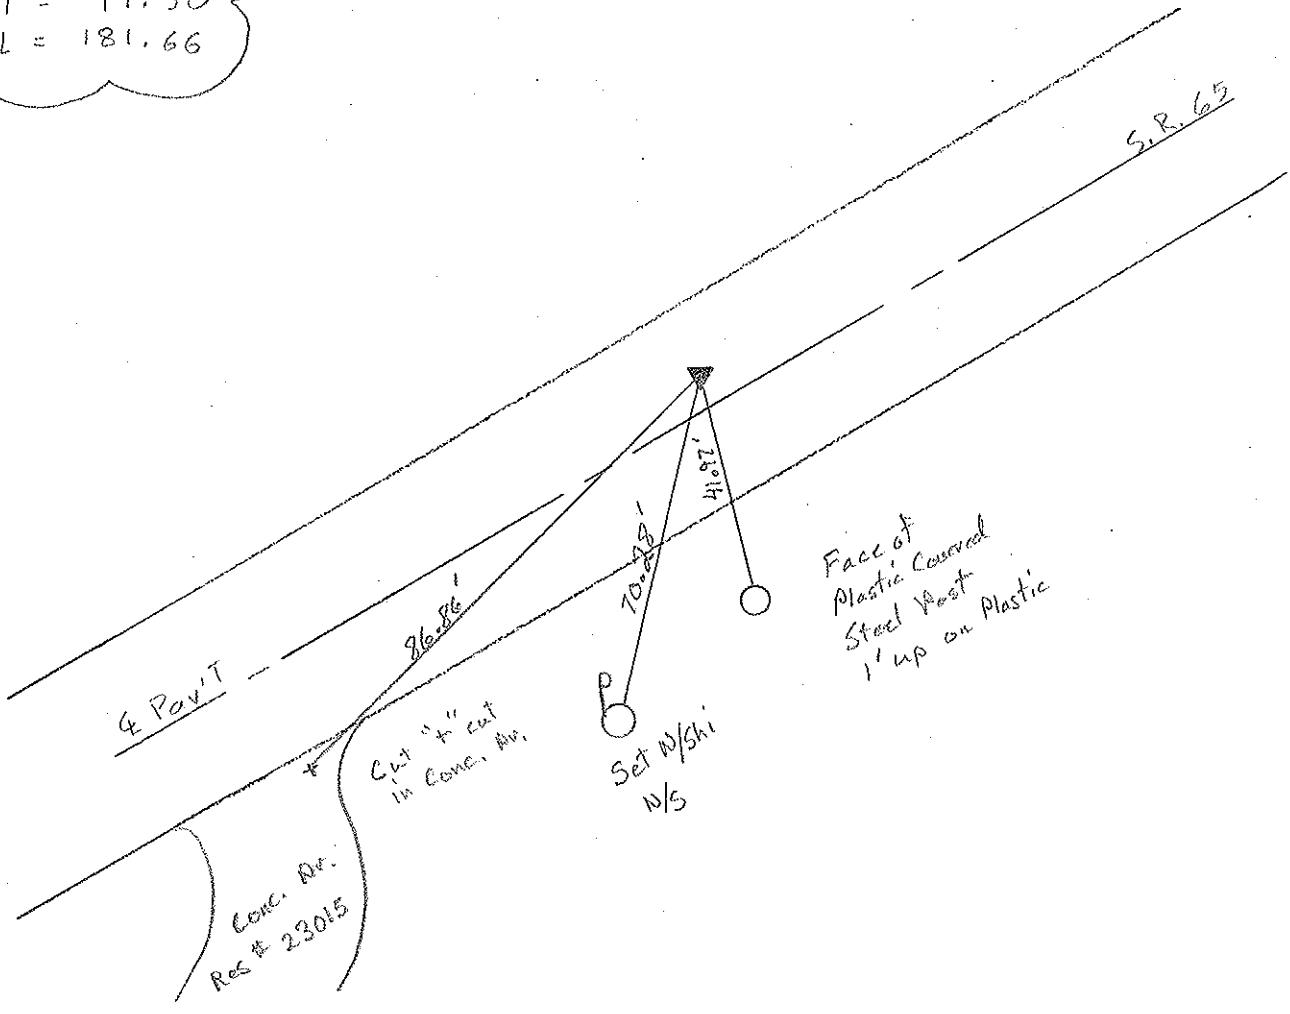

O.D.O.T. DISTRICT 2 SURVEY OFFICE

PERSONNEL

REFERENCE NO. 7 B

SHEET 7 OF 34

NOTES BARNHISEL

H.C. CURTIS

R.C. VAN DUSEN

Lochake

Rometo

DATE 4-22-92

WEATHER cloudy

TEMP. +50°

ROUTE SR 65

COUNTY WOOD

TOWNSHIP GRAND RAPIDS

SECTION 4

T 5 N R 9 E

Reset

TYPE MONUMENT PK & WASHER

5-4-92


ON SURFACE - BELOW yes

C.L.

LEFT- & PAV'T. - RIGHT 2.5

6.7 TO LT EDGE PAVEMENT

S.L.M. 126 + 23

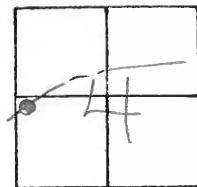

RECORD:

P.I. = 25 + 70.5


$\Delta = 5^{\circ} - 27' RT$

D = 3° - 00'

R = 1910.08

T = 91.30

L = 181.66

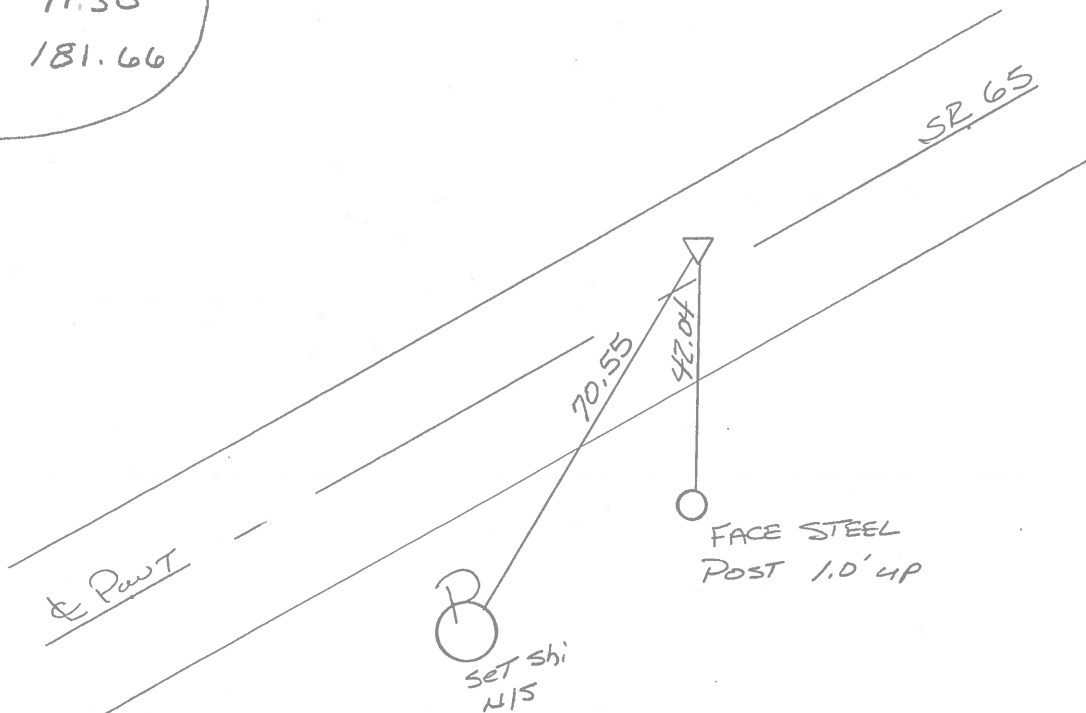

OD.O.T. DISTRICT 2 SURVEY OFFICE

SHEET 15 OF

County Wood S.R. 65

Township Grand Rapids

Section 4

Range 12N, R9E

Personnel Hoffman

Loehrke


Householder

7-B

Date 6-14-82  
12-10-81

Weather clear

Temp. +30°

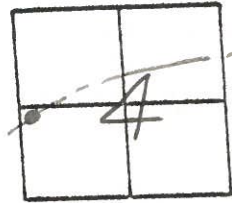


Fd. small R.R. spk @ surface

Project sta ± 126 +35

2.6' Lt. of  $\perp$  Paut

6.3' to N.E.R.

11.8' to S.E.R.

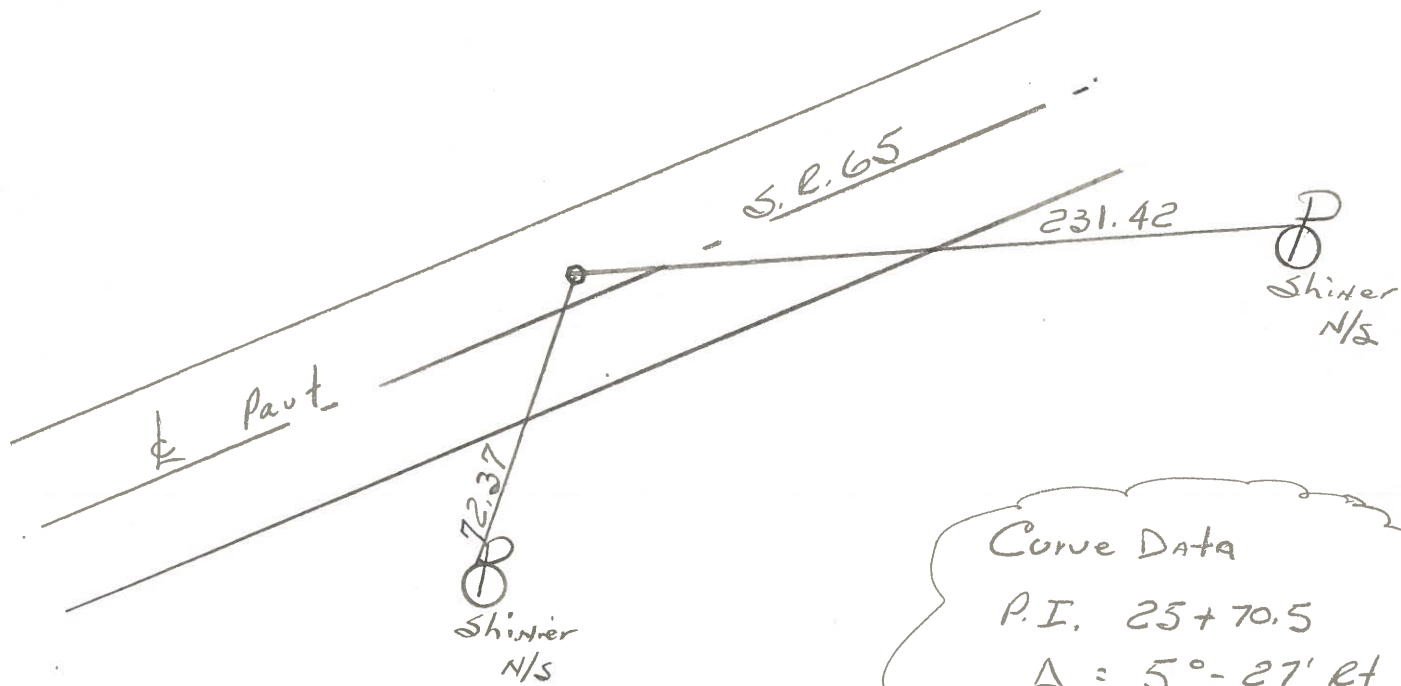

Curve Data  
 P.I. 25+70.5  
 $\Delta = 5^\circ - 27' \text{ Rt.}$   
 $D = 3^\circ - 0'$   
 $R = 1910.08$   
 $T = 91.30$   
 $L = 181.66$

OD.O.T. DISTRICT 2 SURVEY OFFICE

SHEET 15 OF

County Wood S.R. 65

Township Grand Rapids

Section 4

Section, R9E

Personnel Hoffman

Loehrke


Householder

Date 12-10-81

Weather clear

Temp. +30°

7-B

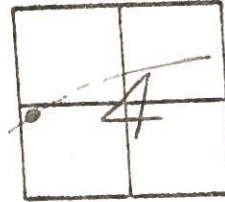

Found small R.R. spike @ surface


2.6' Lt. of  $\frac{1}{2}$  post

6.3' to N.E.R.

11.8' to S.E.R.

Project sta  $\pm$  126 +35

Set P.K/washer  
6-14-82  
sw 4

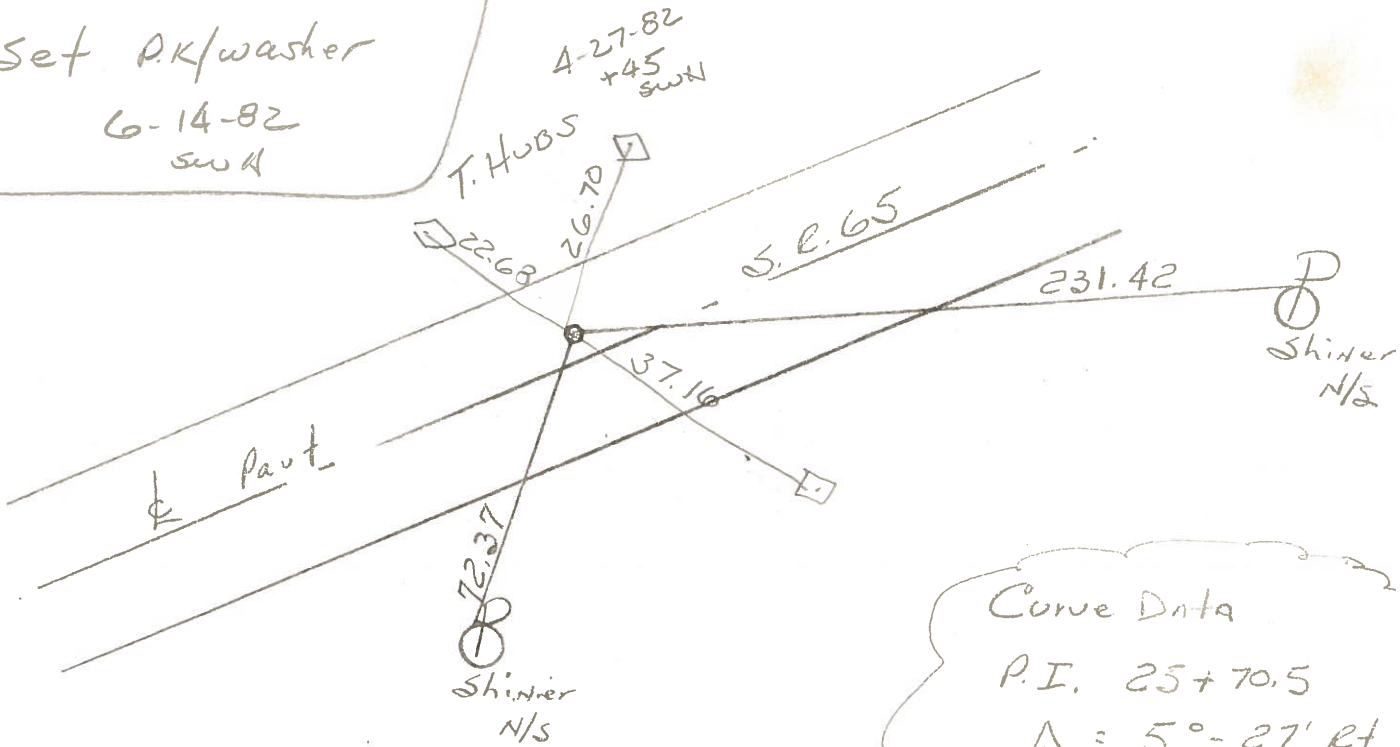

Curve Data  
P.I. 25+70.5  
 $\Delta = 5^\circ - 27' \text{ Rt.}$   
 $D = 3^\circ - 0'$   
 $R = 1910.08$   
 $T = 91.30$   
 $L = 181.66$


PERSONNEL TITLE PERSONNEL TITLE  
BURNSIDE \_\_\_\_\_  
SMITH \_\_\_\_\_  
BOWERS \_\_\_\_\_

COUNTY WOOD DATE 9-28-72

S. R. 65 WEATHER CLOUDY

SEC. GRAND RAPIDS TWP TEMP. +60°

DESCRIPTION ESTABLISH P.I.'S JOB NO. \_\_\_\_\_

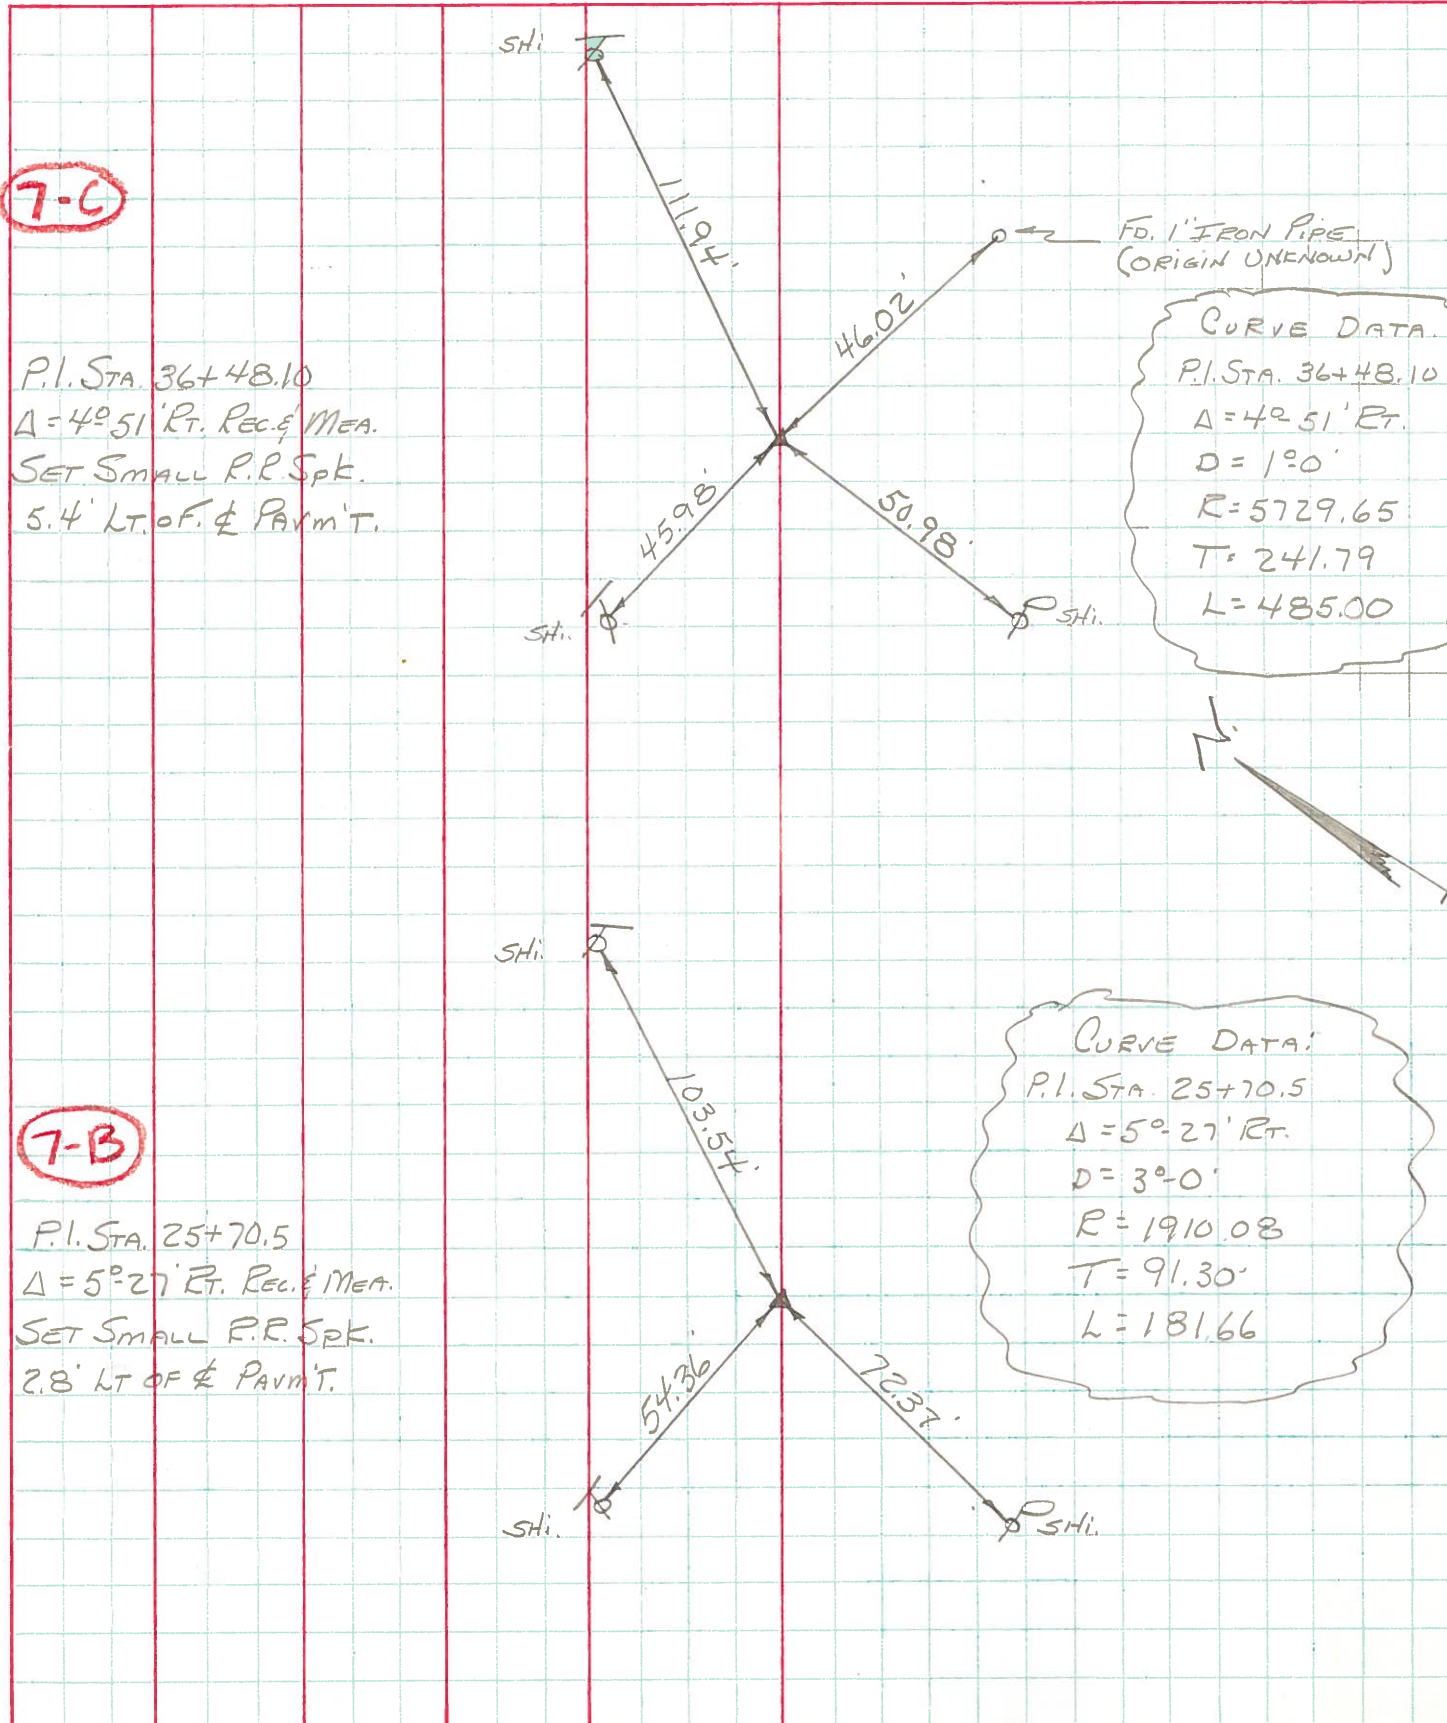


**7-C**

P.I. STA. 36+48.10  
 $\Delta = 42^\circ 51' \text{ Rt.}$  Rec. & Mea.  
 SET SMALL R.R. SPK.  
 5.4' LT. OF P. & PAVM'T.

FD. 1" IRON PIPE  
 (ORIGIN UNKNOWN)

CURVE DATA:  
 P.I. STA. 36+48.10  
 $\Delta = 42^\circ 51' \text{ Rt.}$   
 $D = 1^\circ 0'$   
 $R = 5729.65$   
 $T = 241.79$   
 $L = 485.00$

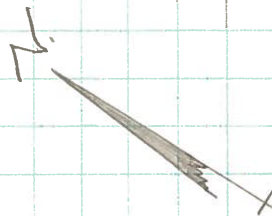

**7-B**

P.I. STA. 25+70.5  
 $\Delta = 5^\circ 27' \text{ Rt.}$  Rec. & Mea.  
 SET SMALL R.R. SPK.  
 2.8' LT OF P. & PAVM'T.

CURVE DATA:  
 P.I. STA. 25+70.5  
 $\Delta = 5^\circ 27' \text{ Rt.}$   
 $D = 3^\circ 0'$   
 $R = 1910.08$   
 $T = 91.30$   
 $L = 181.66$