

O.D.O.T. DISTRICT 2 SURVEY OFFICE (USE ONLY)

PERSONNEL

REFERENCE NO. 7 C

SHEET 30 OF 40

NOTES RHOADES

DATE 3/30/22

ROUTE SR 65

H.C. NIESE

WEATHER CLOUDY

COUNTY WOOD

R.C. KETNER

TEMP. 40°

TOWNSHIP GRAND RAPIDS

AUBLE

SECTION 4

DWG BY RHOADES

PID 95796

T 5 N R 9 E

TYPE MONUMENT MAG/WASHER

ON SURFACE - ~~BELOW~~ ON

OFFSET 6' LT : ~~RT~~

5.3' TO LT EDGE PAVEMENT


STATION: 137+01.39

HORZ.DATUM: NAD83 2011


GEOID: NAVD88 2018

GRID: NORTHING: 642648.544

EASTING: 1600681.714

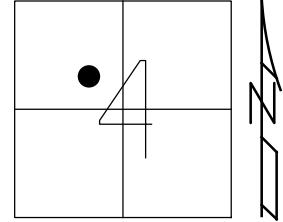

RECORD: P.I.
 STA.36+48.10
 $\Delta = 4^\circ 51' RT$
 $D = 1^\circ 00'$
 $R = 5729.65$
 $T = 241.79$
 $L = 485.00'$
 FD P.K./WASHER
 6/22/04, DCH
 SET MAG/WASHER
 9/16/04, SAH
 FD MAG/WASHER
 REFC7
 11/2/20, JFO
 SET MAG/WASHER
 10/5/22, TDN

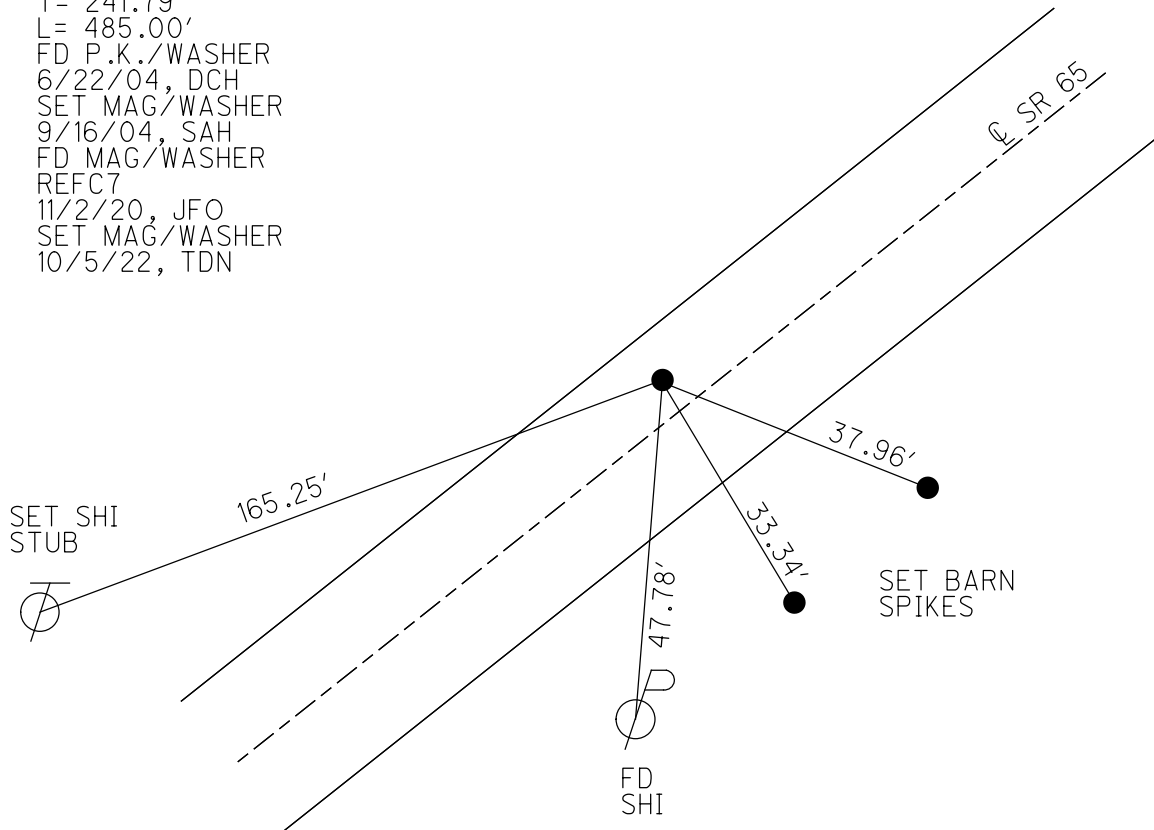

O.D.O.T. DISTRICT 2 SURVEY OFFICE

PERSONNEL _____

REFERENCE NO. 7C

SHEET 23 OF 49

NOTES Nuhter

H.C. Homan

R.C. Huss

DATE 6-22-04

WEATHER Sun.

TEMP. 78°F

ROUTE S.R. 65

COUNTY Wood

TOWNSHIP Grand Rapids

SECTION 4

T 5 N R 9 E



TYPE MONUMENT PK/w

ON SURFACE - ~~BELOW~~ surface

LEFT - ~~RIGHT~~ RIGHT 5.3' Lt.

5.3' TO Lt. EDGE PAVEMENT

S.L.M. 137+03

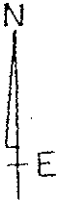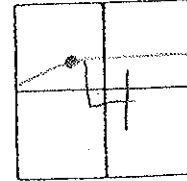

Record

P.I = 36+48.10

A = 4°-51' RT


D = 1°-00'

R = 5729.65

T = 241.79

L = 485.00

Set Mag/w,
9-16-04
SAH

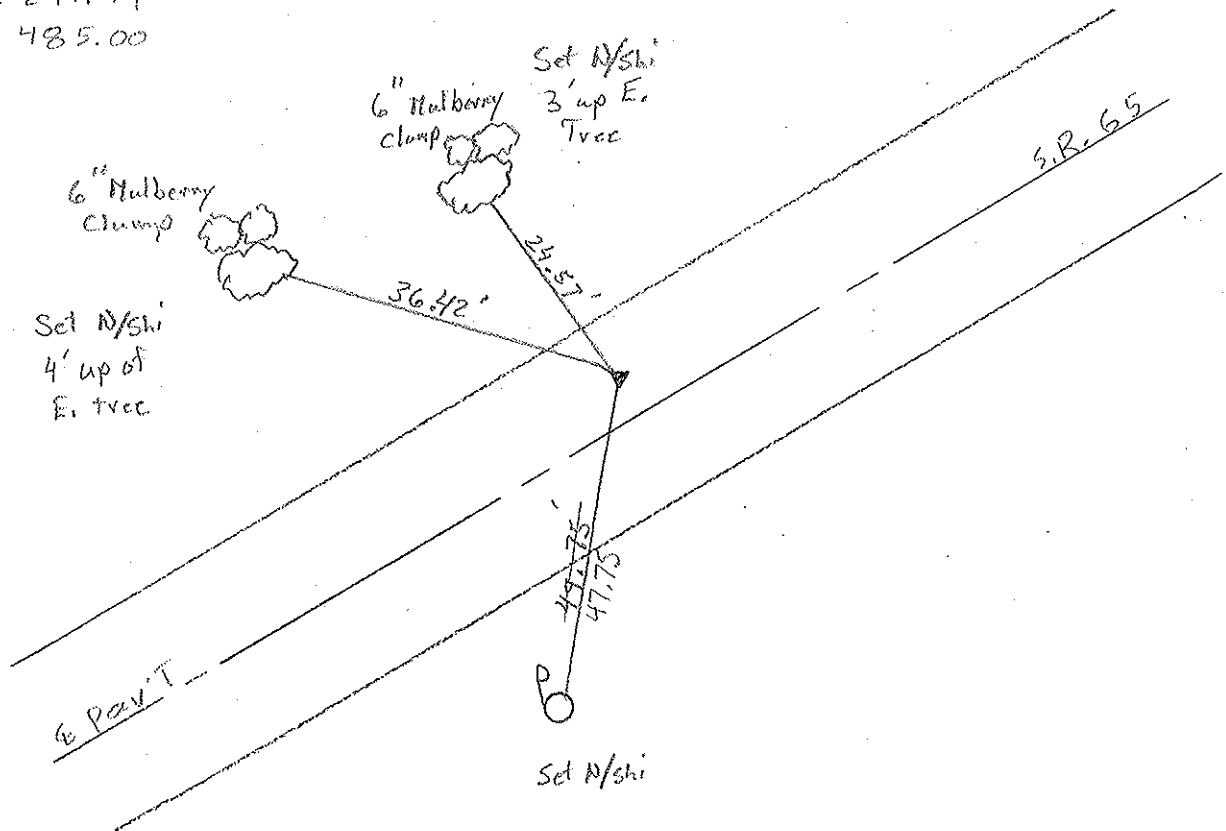

O.D.O.T. DISTRICT 2 SURVEY OFFICE

PERSONNEL

REFERENCE NO. 7c

SHEET 8 OF 34

NOTES BARNHISEL

H.C. CURTIS

R.C. VAN DUSEN

LOCHERKE

ROMETS

DATE 4-21-92

WEATHER Cloudy

TEMP. +65°

ROUTE SR 65

COUNTY WOOD

TOWNSHIP GRAND RAPIDS

SECTION 4

TS N R 9 E

TYPE MONUMENT PK $\frac{1}{2}$ WASHER Reset


ON SURFACE - BELOW YES

LEFT-0 PAV'T. - RIGHT 5.4


4.6 TO LT EDGE PAVEMENT

S.L.M. 137+03

5-4-92
C.L.

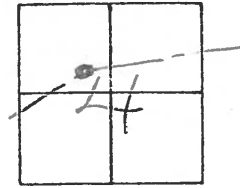

RECORD:
P.I. 36+48.10
 $\Delta = 4^\circ - 51' 21''$
D = 10'-00"
R = 5729.65
T = 241.79
L = 485.00

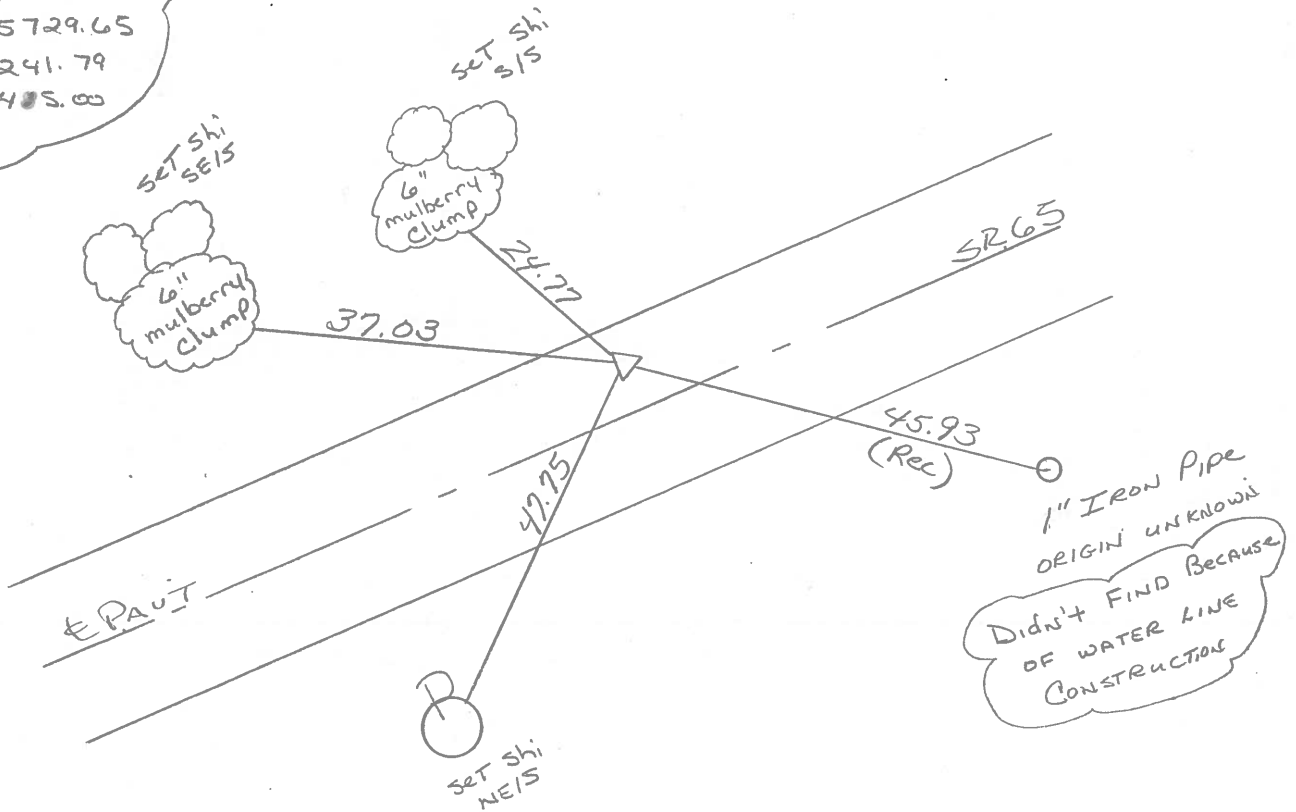

1" IRON PIPE
ORIGIN UNKNOWN
DIDN'T FIND BECAUSE
OF WATER LINE
CONSTRUCTION

OD.O.T. DISTRICT 2 SURVEY OFFICE


SHEET 16 OF

County Wood S.R. 65
 Township Grand Rapids
 Section 4

Date 6-14-82
12-10-81
 Weather Clear
 Temp. +30°


Personnel HOFFMAN
Loehrke
Householder

7-C

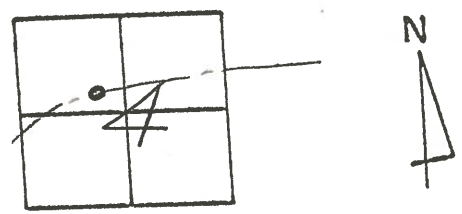

Fd. Small R.R. spk @ surface
 5.7' Lt. of & Pavt.
 3.6 to N.E.P.
 14.8 to S.E.P.

Project Sta ± 137+13

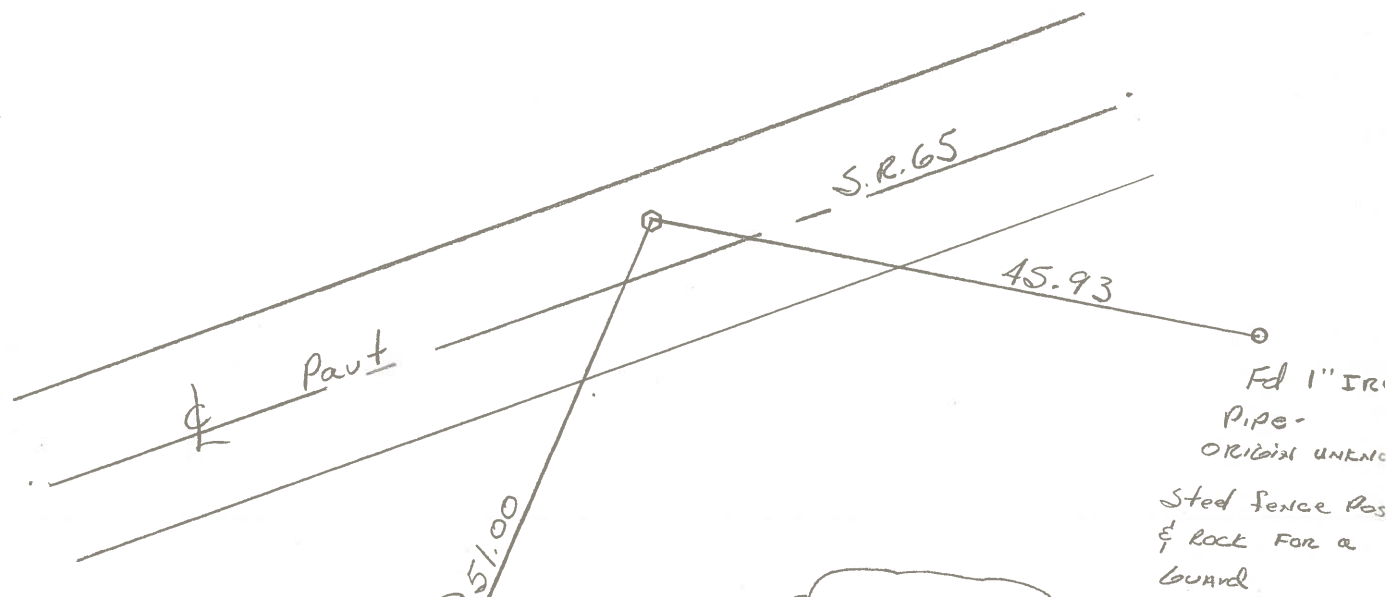

Curve DATA
 P.I. 36+48.10
 $\Delta = 4^{\circ} 51' \text{ Rt.}$
 $D = 120'$
 $R = 5729.65'$
 $T = 241.79'$
 $L = 485.00'$

OD.O.T. DISTRICT 2 SURVEY OFFICE

SHEET 16 OF

County Wood S.R. 65

Township Grand Rapids

Section 4

Section, R9E

Personnel HOFFMAN

Loehrke


Householder

7-C

Date 12-10-81

Weather Clear


Temp. +30°

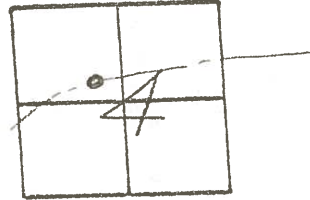

- 1. Small P.R. spike @ surface
- 5.7' Lt. of & Pavt.
- 3.6 to N.E.P.
- 14.8 to S.E.P.

Project Sta ± 137+13


Set P.K/washer
6-14-82
Suxl

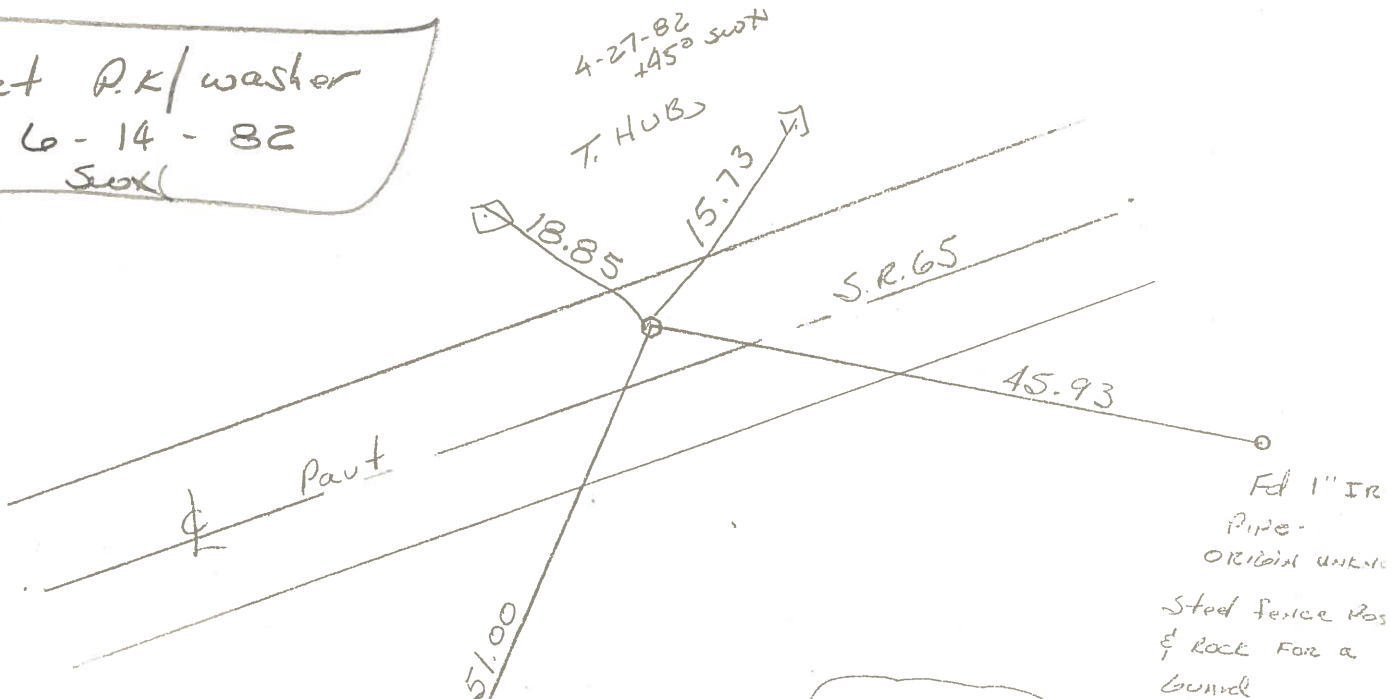

Curve DATA
 P.I. 25+70.5
 $\Delta = 5^{\circ} - 27' \text{ Rt.}$
 $D = 3^{\circ} - 0'$
 $R = 1910.08$
 $T = 91.30$
 $L = 181.66$

PERSONNEL BURNSIDE TITLE _____ PERSONNEL SMITH TITLE _____
 COUNTY WOOD DATE 9-28-72
 S. R. 65 WEATHER CLOUDY
 SEC. GRAND RAPIDS TWP TEMP. +60°

DESCRIPTION ESTABLISH P.I.'S JOB NO. _____

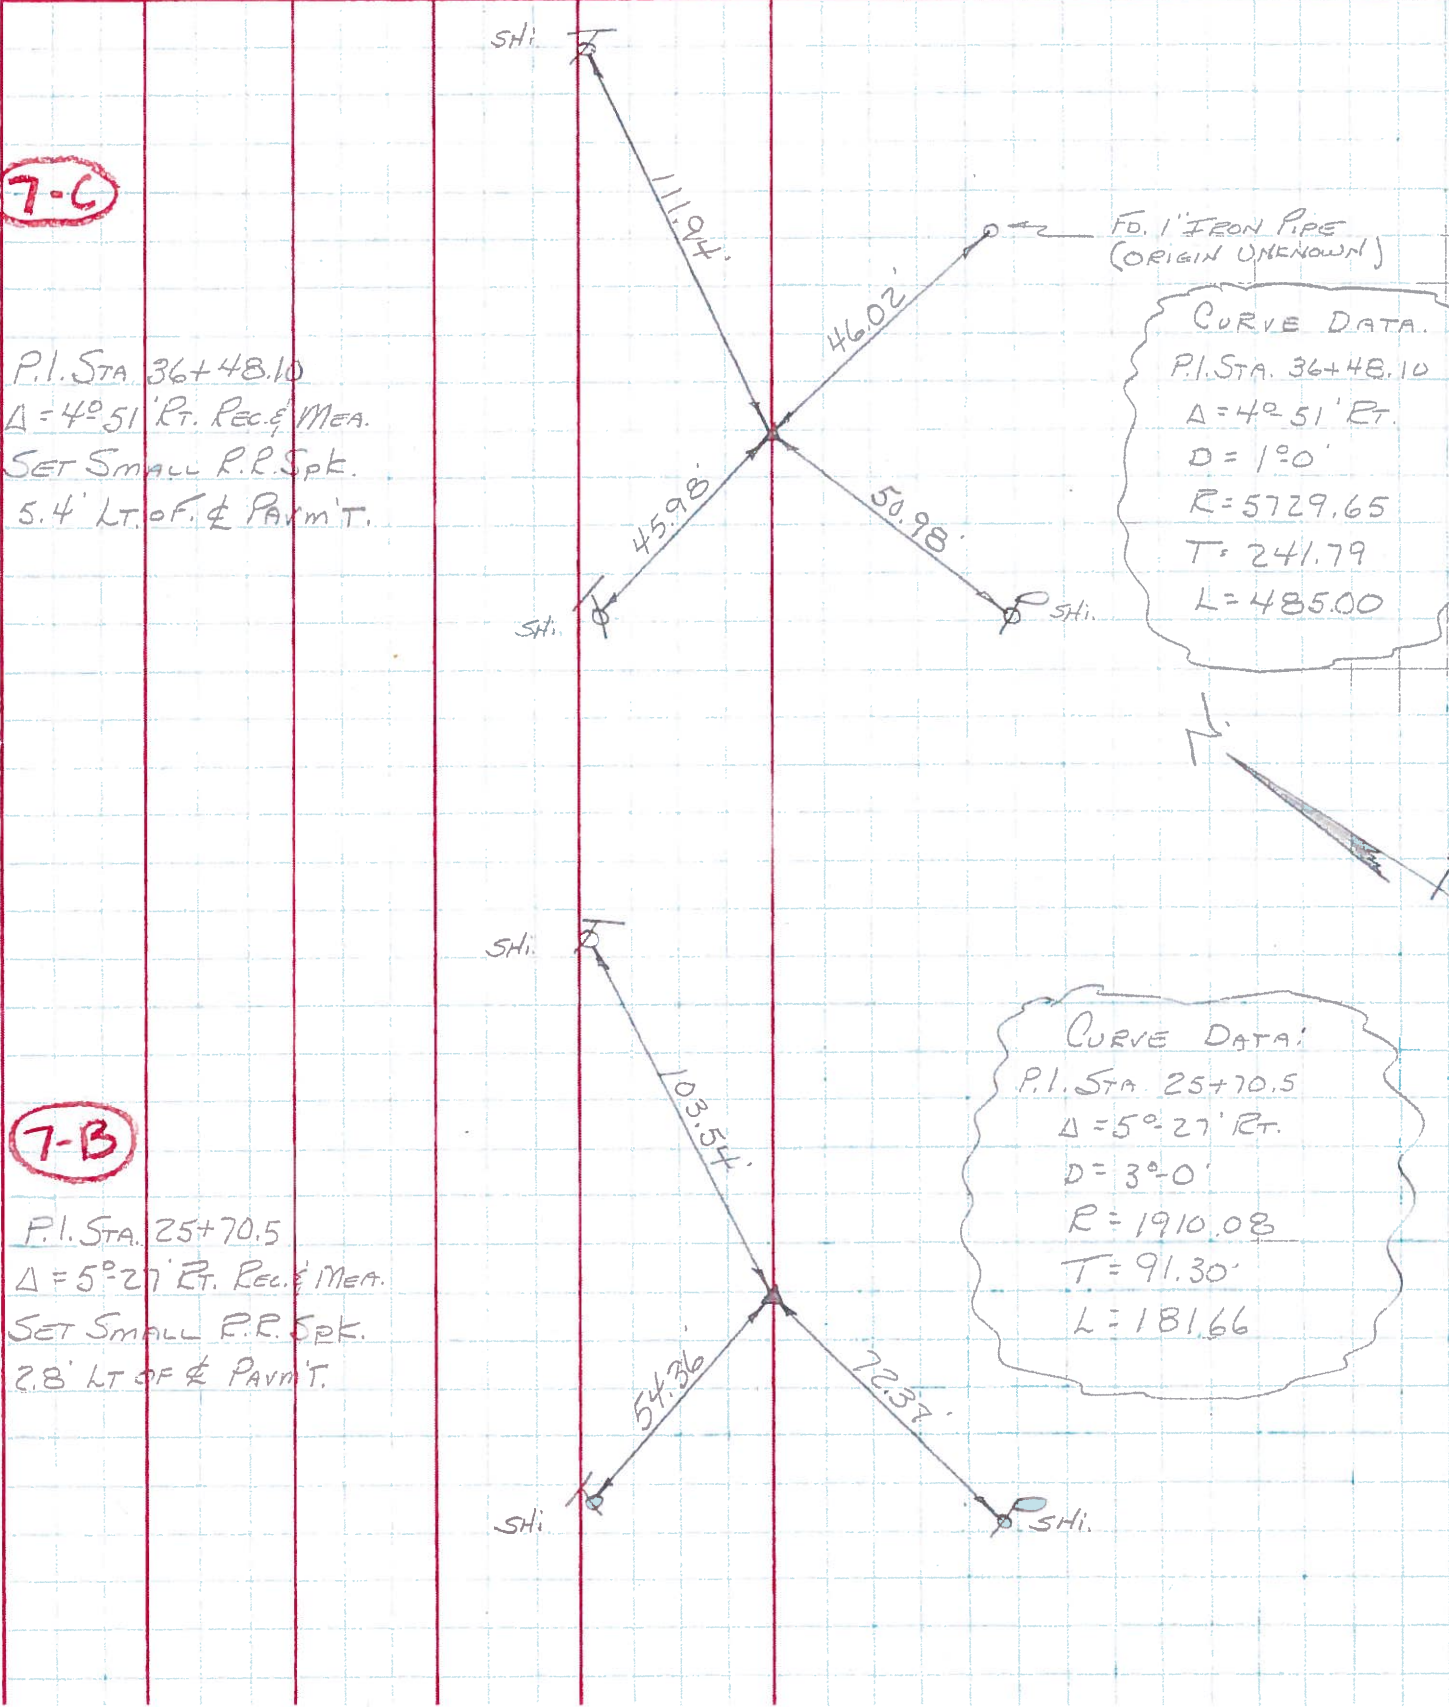

7-C

P.I. STA. 36+48.10
 $\Delta = 40^{\circ} 51' \text{ RT. REC. \& MEAS.}$
 SET SMALL R.R. SPK.
 5.4' LT. OF ϕ PAVM'T.

FD. 1" IRON PIPE
 (ORIGIN UNKNOWN)

CURVE DATA:
 P.I. STA. 36+48.10
 $\Delta = 40^{\circ} 51' \text{ RT.}$
 $D = 1^{\circ} 0'$
 $R = 5729.65$
 $T = 241.79$
 $L = 485.00$

7-B

P.I. STA. 25+70.5
 $\Delta = 5^{\circ} 27' \text{ RT. REC. \& MEAS.}$
 SET SMALL R.R. SPK.
 2.8' LT. OF ϕ PAVM'T.

CURVE DATA:
 P.I. STA. 25+70.5
 $\Delta = 5^{\circ} 27' \text{ RT.}$
 $D = 3^{\circ} 0'$
 $R = 1910.08$
 $T = 91.30'$
 $L = 181.66$