

O.D.O.T. DISTRICT 2 SURVEY OFFICE (USE ONLY)

PERSONNEL

REFERENCE NO. 7 D

SHEET 31 OF 40

NOTES RHOADES

DATE 3/30/22

ROUTE SR 65

H.C. NIESE

WEATHER CLOUDY

COUNTY WOOD

R.C. KETNER

TEMP. 40°

TOWNSHIP GRAND RAPIDS

AUBLE

SECTION 4

DWG BY RHOADES PID 95796

T 5 N R 9 E

TYPE MONUMENT MAG/WASHER

ON SURFACE - ~~BELOW~~ ON

OFFSET 1.7' ~~LT~~ : RT

7.3' TO RT EDGE PAVEMENT


STATION: 146+62.99

HORIZ.DATUM: NAD83 2011


GEOID: NAVD88 2018

GRID: NORTHING: 643067.514

EASTING: 1601547.563

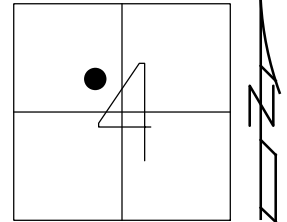

RECORD: P.I.
 STA. 46+10.30
 $\Delta = 1^\circ 26'$
 FD P.K./WASHER
 6/22/04, DCH
 SET MAG/WASHER
 9/17/04, RGN
 FD MAG/WASHER
 REFD7
 11/2/20, JFO
 SET MAG/WASHER
 10/5/22, TDN

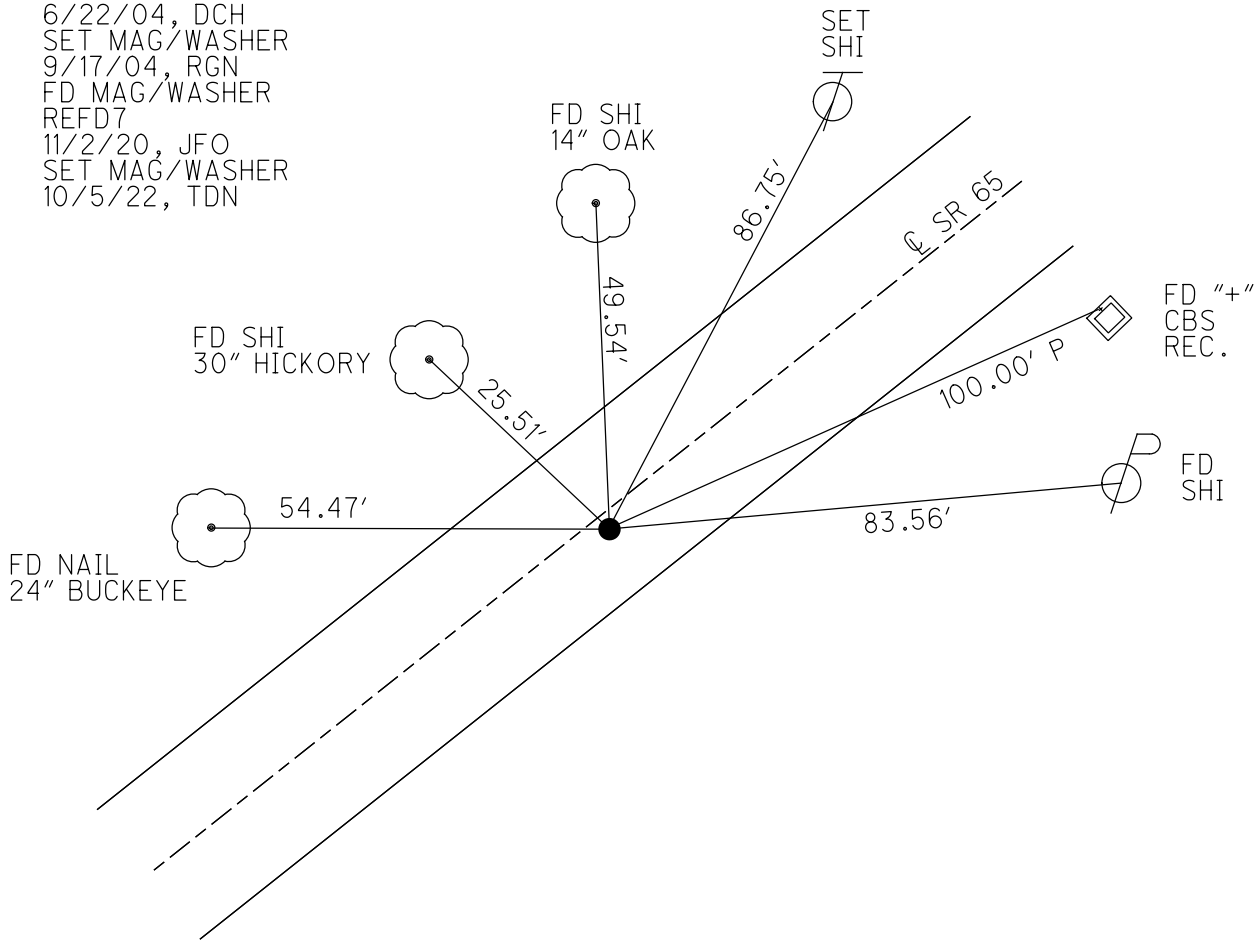

O.D.O.T. DISTRICT 2 SURVEY OFFICE

PERSONNEL

REFERENCE NO. 7D

SHEET 24 OF 49

NOTES Nuhfer

H.C. Homan

R.C. Huss

DATE 6-22-04

WEATHER Sunny

TEMP. 78° F

ROUTE S.R. 65

COUNTY Wood

TOWNSHIP Grand Rapids

SECTION 4

T 5 N R 9 E


TYPE MONUMENT PK/w

ON SURFACE - ~~BELOW~~ surface

~~NEET TO PAV'T~~ - (RIGHT) 1.7' Rt.


7.3' TO Rt. EDGE PAVEMENT

S.L.M. 146 + 63

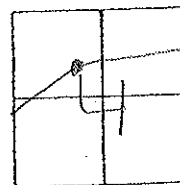

Record:
P.I. = 46 + 10.30
 $\Delta = 1^{\circ} 26'$

Set Mag/w
9-17-04
RGN

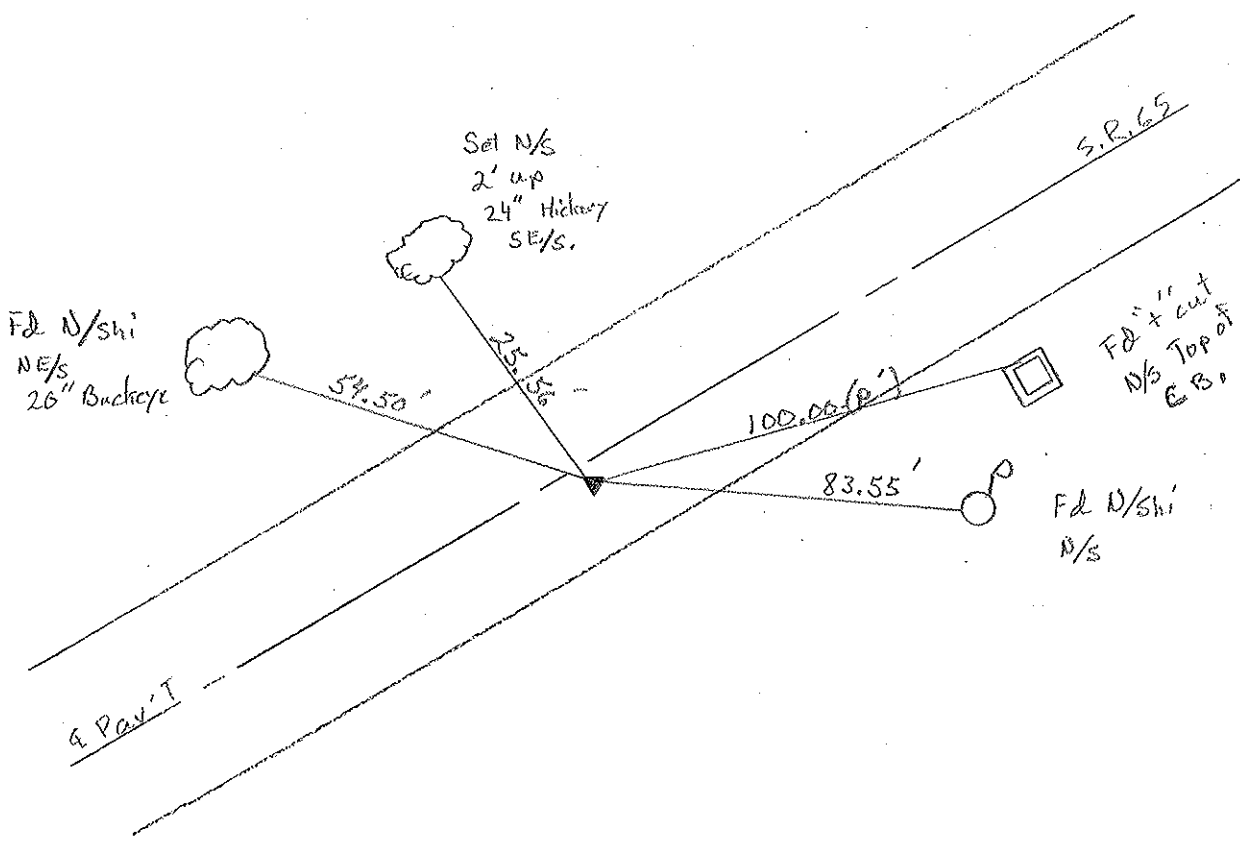

O.D.O.T. DISTRICT 2 SURVEY OFFICE

PERSONNEL

REFERENCE NO. 7D

SHEET 9 OF 34

NOTES BARNHISEL

H.C. CURTIS

R.C. VAN DUSEN

Loehrke

Romero

DATE 4-21-92

WEATHER Cloudy

TEMP. +65°

ROUTE SR 65

COUNTY WOOD

TOWNSHIP GRAND RAPIDS

SECTION 4

T 5 N R 9 E

TYPE MONUMENT Reset PK & WASHER


5-4-92
C.L.

ON SURFACE - ~~BELOW~~ YES


~~LEFT - C~~ PAV'T. - RIGHT 1.9

2.3 TO RT EDGE PAVEMENT

S.L.M. 146+63

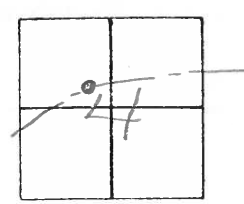

RECORD:
P.I. 46+10.30
 $\Delta = 1^{\circ}-26'$

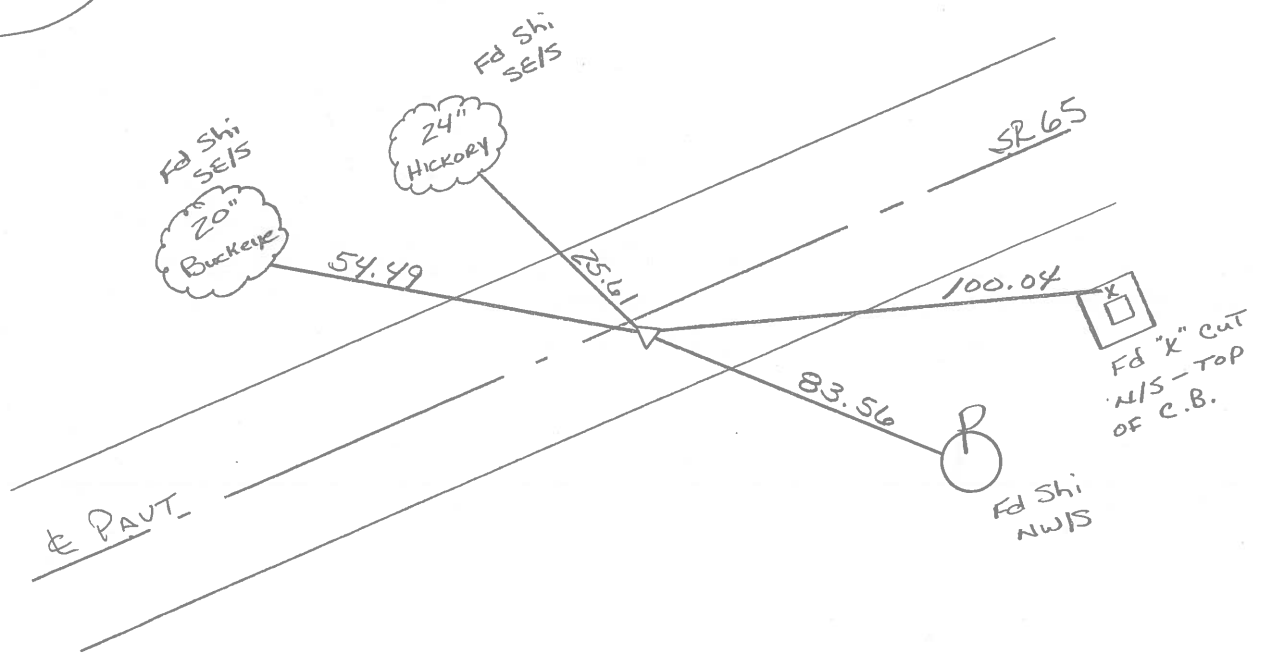

OD.O.T. DISTRICT 2 SURVEY OFFICE

SHEET 17 OF

County Wood S.R. 65

Township Grand Rapids

Section 4

SEN, R1E

Personnel Hoffman

Loehrke


Householder

Date 6-9-82
12-10-81

Weather clear


Temp. +30°

7-D

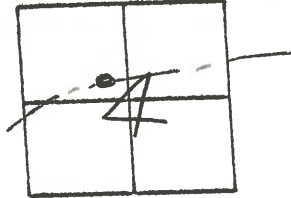

Fd. small R.R. Spk @ surface
1.5' Rt. of & PAUT.
7.7' TO S.E.P.
10.4' to N.E.P.

Project sta ± 146 + 74

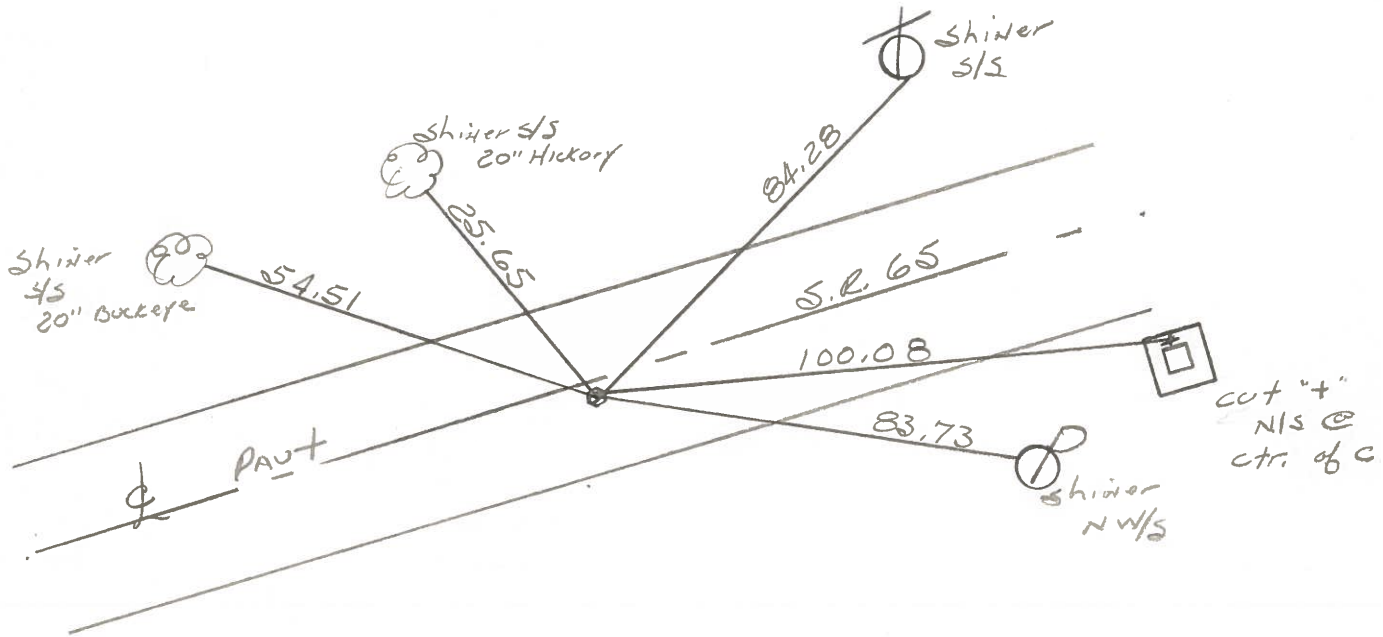


P.I. sta 46 + 10.30

$\Delta = 1^{\circ} - 26'$ - Rec

PERSONNEL TITLE PERSONNEL TITLE
BURNSIDE _____
SMITH _____
BOWERS _____

COUNTY WOOD DATE 9-28-72
 S. R. 65 WEATHER CLOUDY
 SEC. GRAND RAPIDS TWP TEMP. +58

DESCRIPTION ESTABLISH P.I.S JOB NO. _____

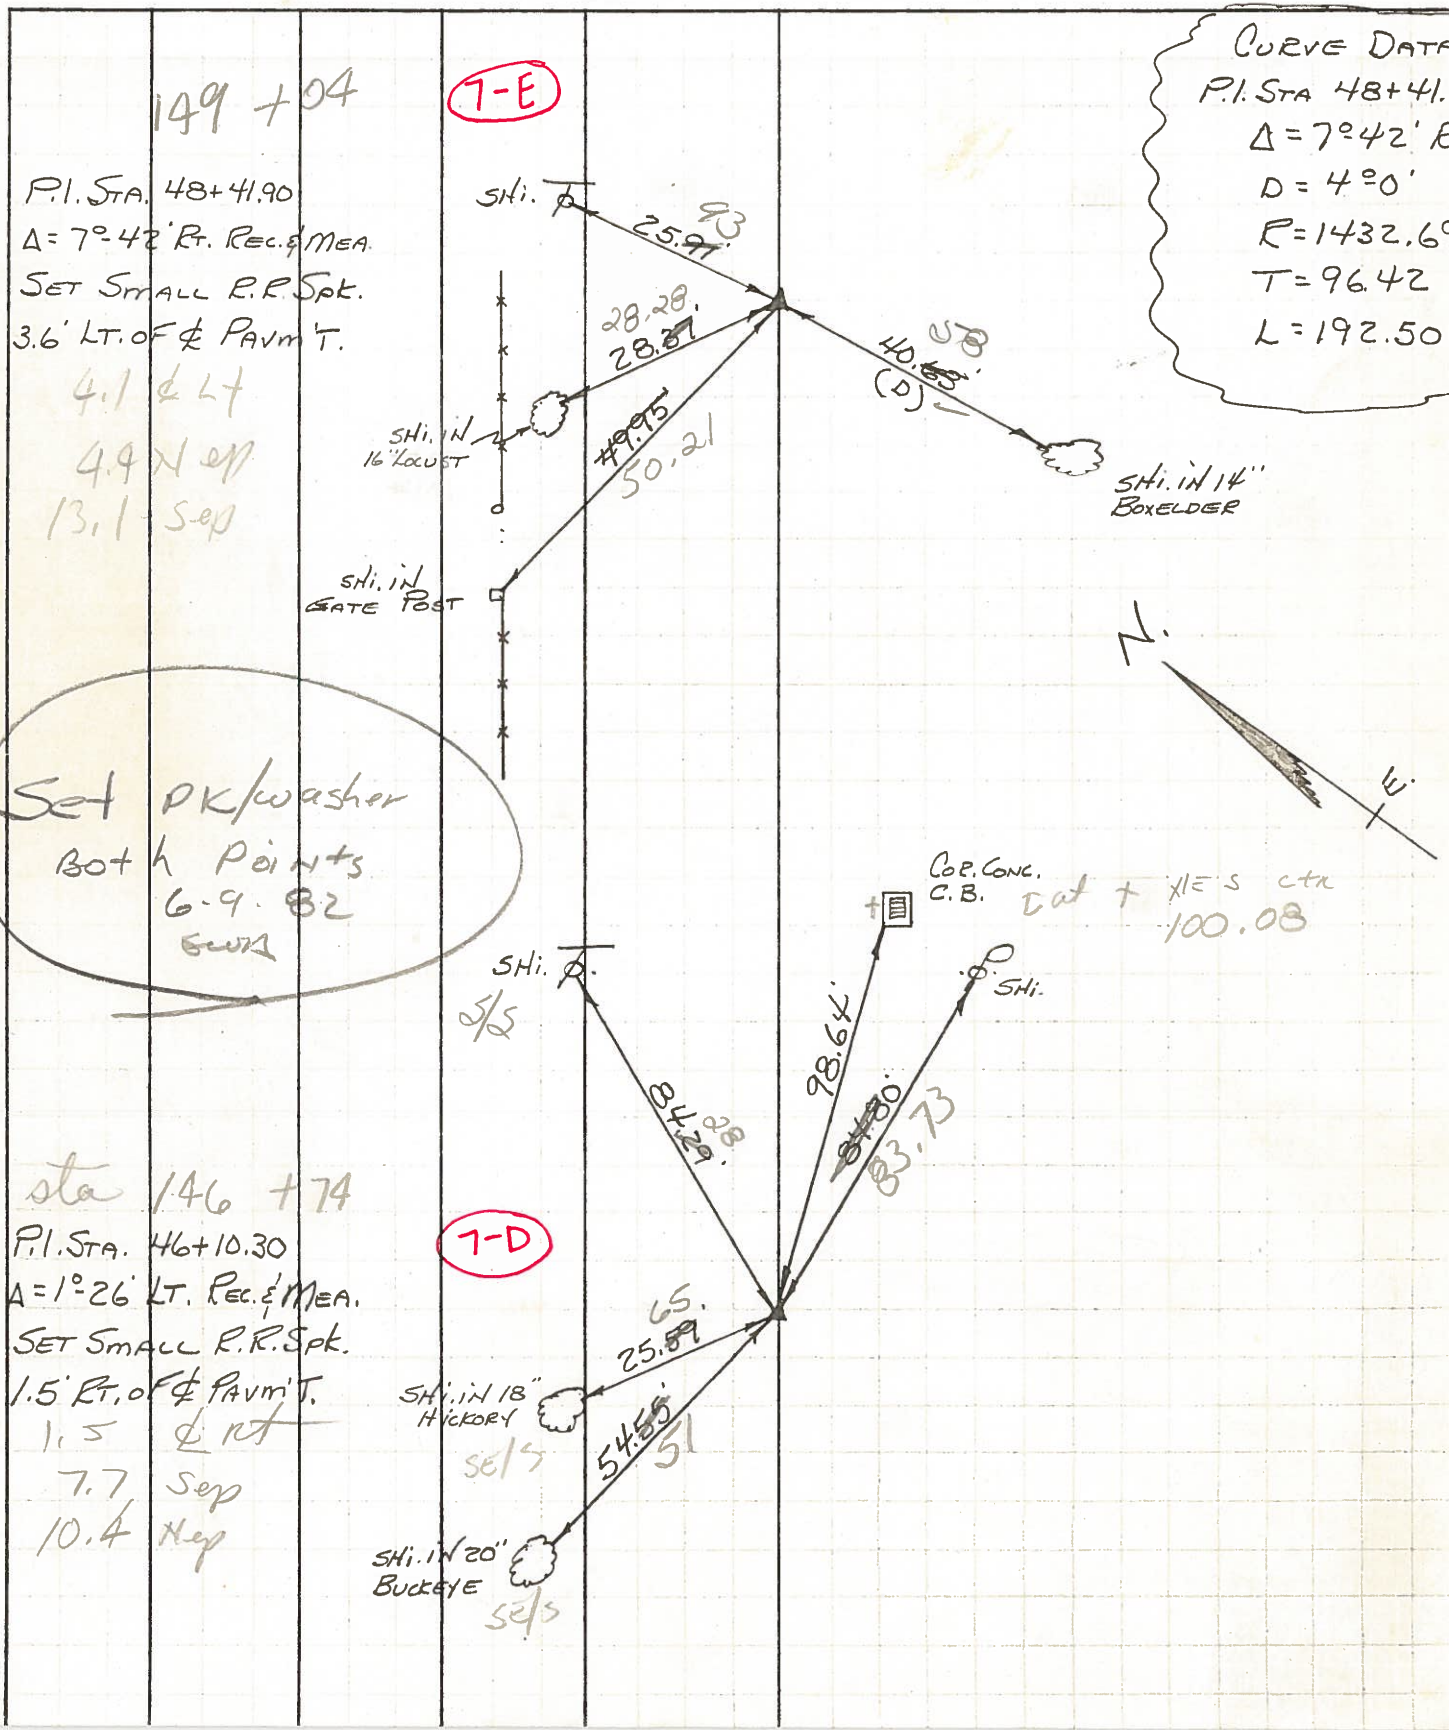

CURVE DATA
 P.I. STA 48+41.
 Δ = 7°42' R
 D = 4°0'
 R = 1432.6'
 T = 96.42
 L = 192.50

Set PK/washer
 Bot h points
 6-9-82
 SWR

sta 146 + 74
 P.I. STA. 46+10.30
 Δ = 1°26' Lt. Rec. & Mea.
 SET SMALL R.R. Spt.
 1.5 Rt. of & Pavm't.
 1.5 & rt
 7.7 Sep
 10.4 May


PERSONNEL TITLE PERSONNEL TITLE
 BURNSIDE
 SMITH
 BOWERS

COUNTY Wood DATE 9-28-72
 S. R. 65 WEATHER Cloudy
 SEC. GRAND RAPIDS TWP TEMP. + 58


DESCRIPTION ESTABLISH P.I.S. LEFT CENTER LINE RIGHT JOB NO.

7-E

P.I. STA. 48+41.90
 $\Delta = 7^{\circ}42'$ Rt. REC. & MEA.
 SET SMALL R.R. Spt.
 3.6' LT. OF & PAVM'T.

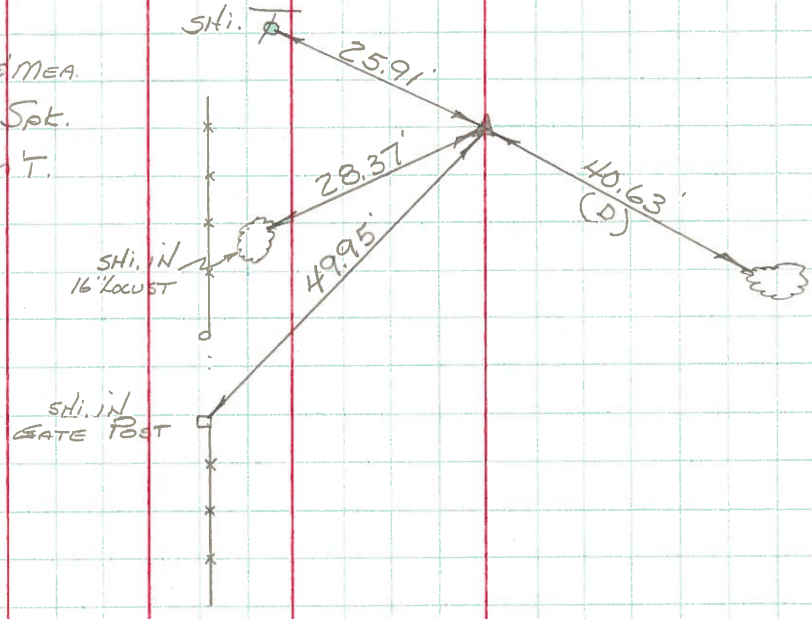

CURVE DATA
 P.I. STA 48+41.9
 $\Delta = 7^{\circ}42'$ R
 $D = 4^{\circ}0'$
 $R = 1432.69$
 $T = 96.42$
 $L = 192.50$

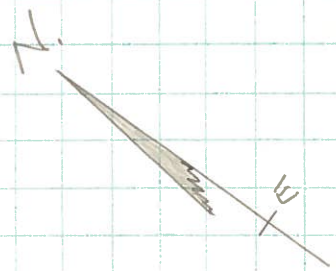

7-D

P.I. STA. 46+10.30
 $A = 1^{\circ}26'$ LT. REC. & MEA.
 SET SMALL R.R. Spt.
 1.5' RT. OF & PAVM'T.

