

O.D.O.T. DISTRICT 2 SURVEY OFFICE (USE ONLY)

PERSONNEL

REFERENCE NO. 7 E

SHEET 32 OF 40

NOTES RHOADES

DATE 3/30/22

ROUTE SR 65

H.C. NIESE

WEATHER CLOUDY

COUNTY WOOD

R.C. KETNER

TEMP. 40°

TOWNSHIP GRAND RAPIDS

AUBLE

SECTION 4

DWG BY RHOADES

PID 95796

T 5 N R 9 E

TYPE MONUMENT MAG/WASHER

ON SURFACE - ~~BELOW~~ ON

OFFSET ϕ PAVEMENT 4.9' LT : ~~RT~~

5.7' TO LT EDGE PAVEMENT



STATION: 148+92.50

HORZ.DATUM: NAD83 2011

GEOID: NAVD88 2018

GRID: NORTHING: 643172.350

EASTING: 1601751.727

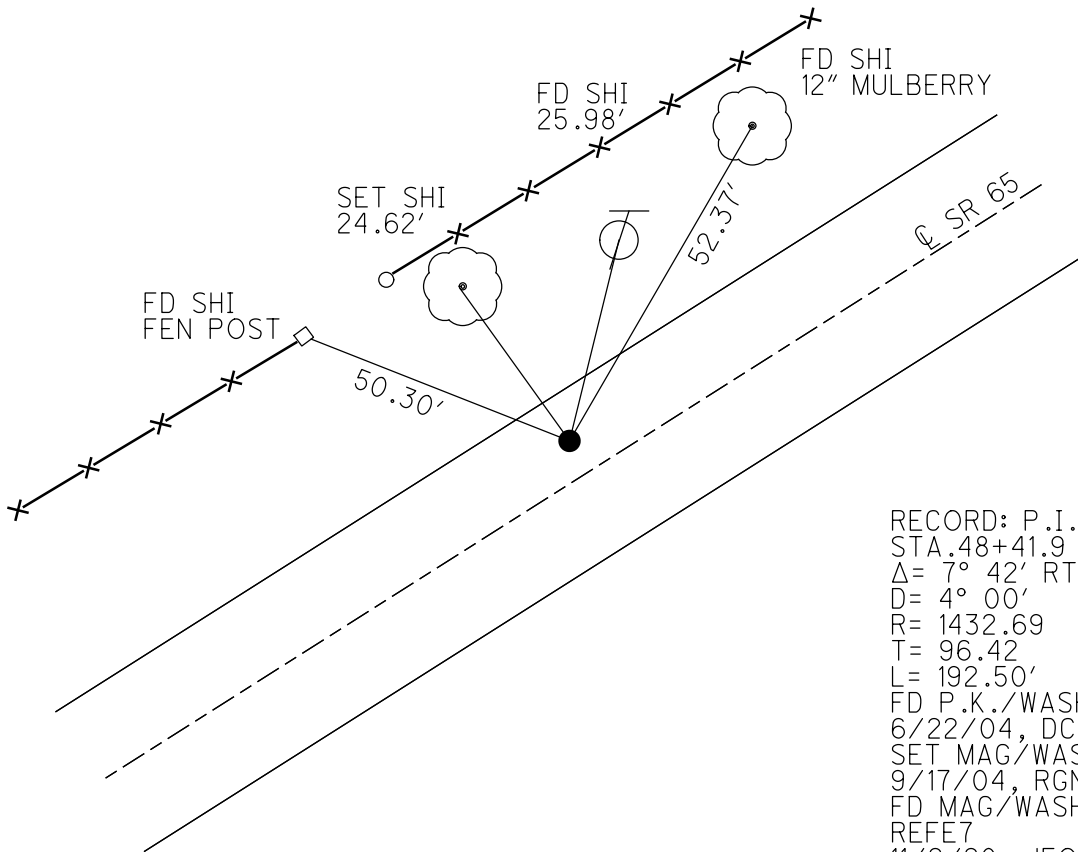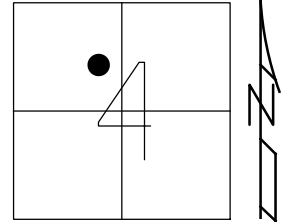

RECORD: P.I.
 STA. 48+41.9
 $\Delta = 7^\circ 42' RT$
 $D = 4^\circ 00'$
 $R = 1432.69$
 $T = 96.42$
 $L = 192.50'$
 FD P.K./WASHER
 6/22/04, DCH
 SET MAG/WASHER
 9/17/04, RGN
 FD MAG/WASHER
 REFE7
 11/2/20, JFO
 SET MAG/WASHER
 10/5/22, TDN

O.D.O.T. DISTRICT 2 SURVEY OFFICE

PERSONNEL _____

REFERENCE NO. 7E

SHEET 25 OF 49

NOTES Nuhter

H.C. Homan

R.C. Huss

DATE 6-22-04

WEATHER Sun.

TEMP. 80°F

ROUTE S.R. 65

COUNTY Wood

TOWNSHIP Grand Rapids

SECTION 4

T5 NLR 9 E


TYPE MONUMENT PK/W

ON (SURFACE) - BELOW surface

LEFT - ~~PAV'T~~ - RIGHT 4.9' Lt.


5.7 TO Lt. EDGE PAVEMENT

S.L.M. 148+93

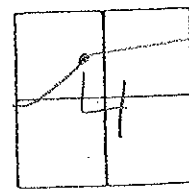

Record:
 P.I. = 48+41.9
 Δ = 7°-42' RT
 D = 4°-00'
 R = 1432.69
 T = 96.42
 L = 192.50

Set Mag/W
 9-17-04
 RGN

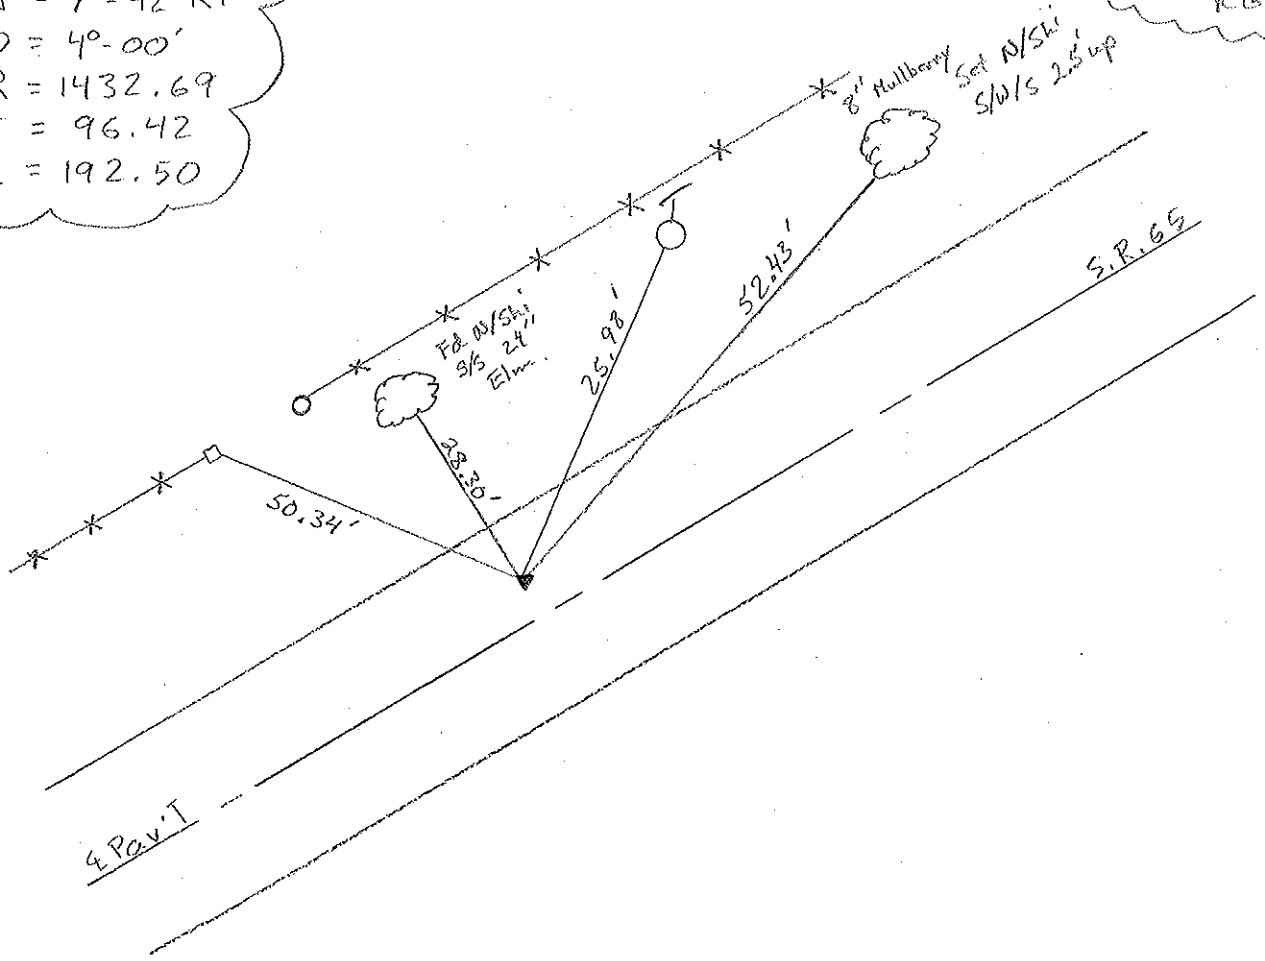

O.D.O.T. DISTRICT 2 SURVEY OFFICE

PERSONNEL

REFERENCE NO. 7 E

SHEET 10 OF 34

NOTES BARNHISEL

H.C. CURTIS

R.C. VAN DUSEN

Loehrke

Romero

DATE 4-21-92

WEATHER Cloudy

TEMP. +65°

ROUTE SR 65

COUNTY Wood

TOWNSHIP GRAND RAPIDS

SECTION 4

T5 N R 9 E

TYPE MONUMENT ^{Reset} PK & WASHER


ON SURFACE - BELOW YES

LEFT- & PAV'T. - RIGHT 4.5

S.I. TO LT EDGE PAVEMENT

S.L.M. 148+92

5-4-92
C.L.

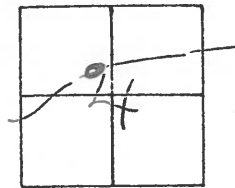

RECORD:

P.I. 48+41.9


$\Delta = 7^{\circ} - 42' \text{ RT.}$

D = 4° - 00'

R = 1432.69

T = 96.42

L = 192.50

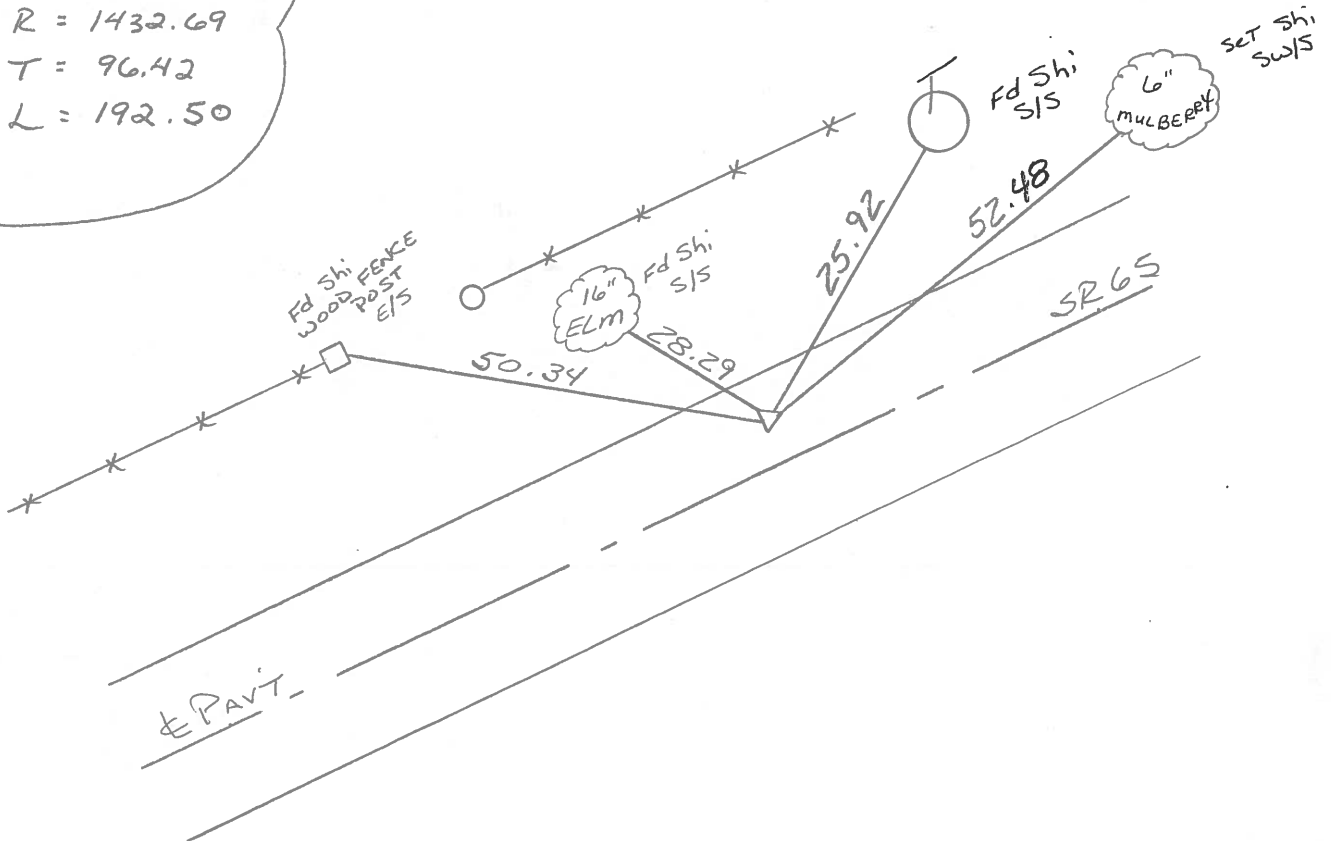

OD.O.T. DISTRICT 2 SURVEY OFFICE

SHEET 18 OF

County Woods S.R. 65

Date 6-9-82
12-10-81

Township Grand Rapids

Weather clear


Section 4

Temp. +30°

REN, RLE


Personnel Hoffman
Loehrke
Householder

7-E

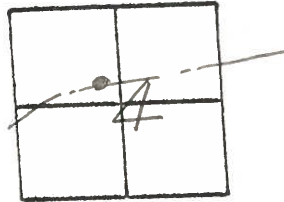

Fd. R.R. spk @ surface
4.1' Lt. of ϕ Pavt.
4.4' to N.E.P.
13.1' to S.E.P.

Project Sta \pm 149+04

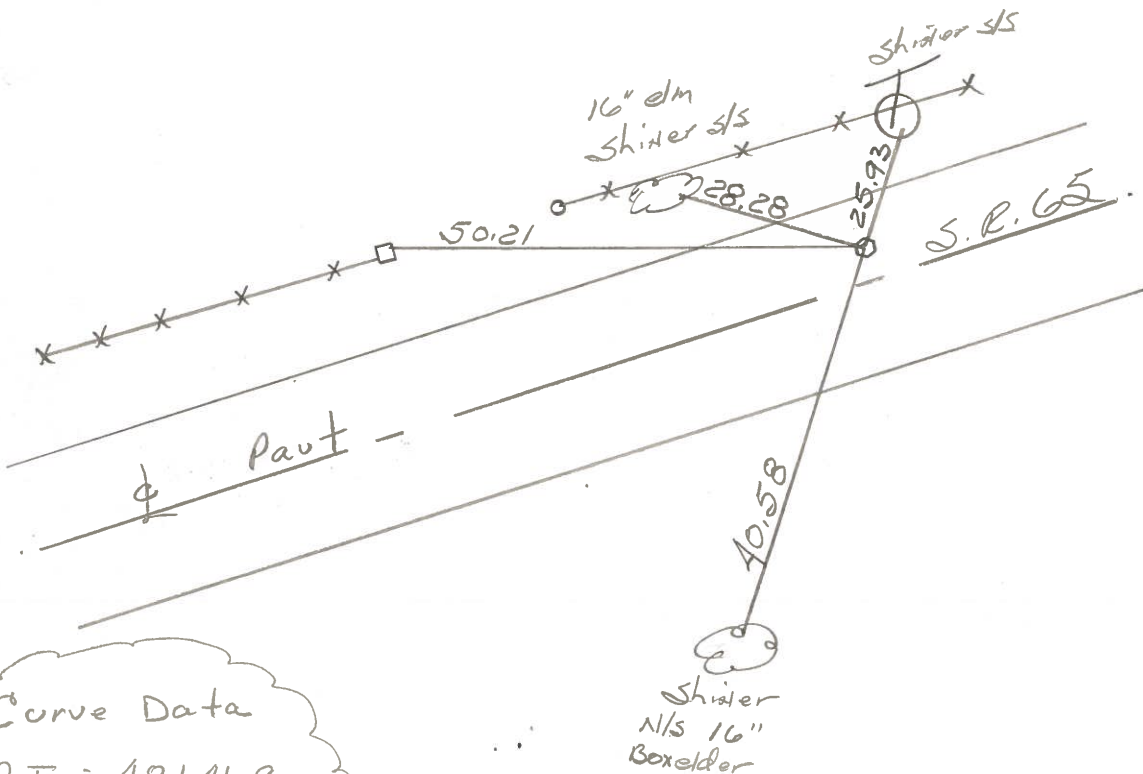

Curve Data
P.I. = 48+41.9
 $\Delta = 7^{\circ}-42'$ Rt.
D = 4'-0"
R = 1432.69
T = 96.42
L = 192.50


PERSONNEL BURNSIDE TITLE _____
 PERSONNEL SMITH TITLE _____
 PERSONNEL BOWERS TITLE _____

COUNTY WOOD DATE 9-28-72

S. R. 65 WEATHER CLOUDY

SEC. GRAND RAPIDS TWP TEMP. +58

DESCRIPTION ESTABLISH P.I.'S LEFT CENTER LINE RIGHT JOB NO. _____

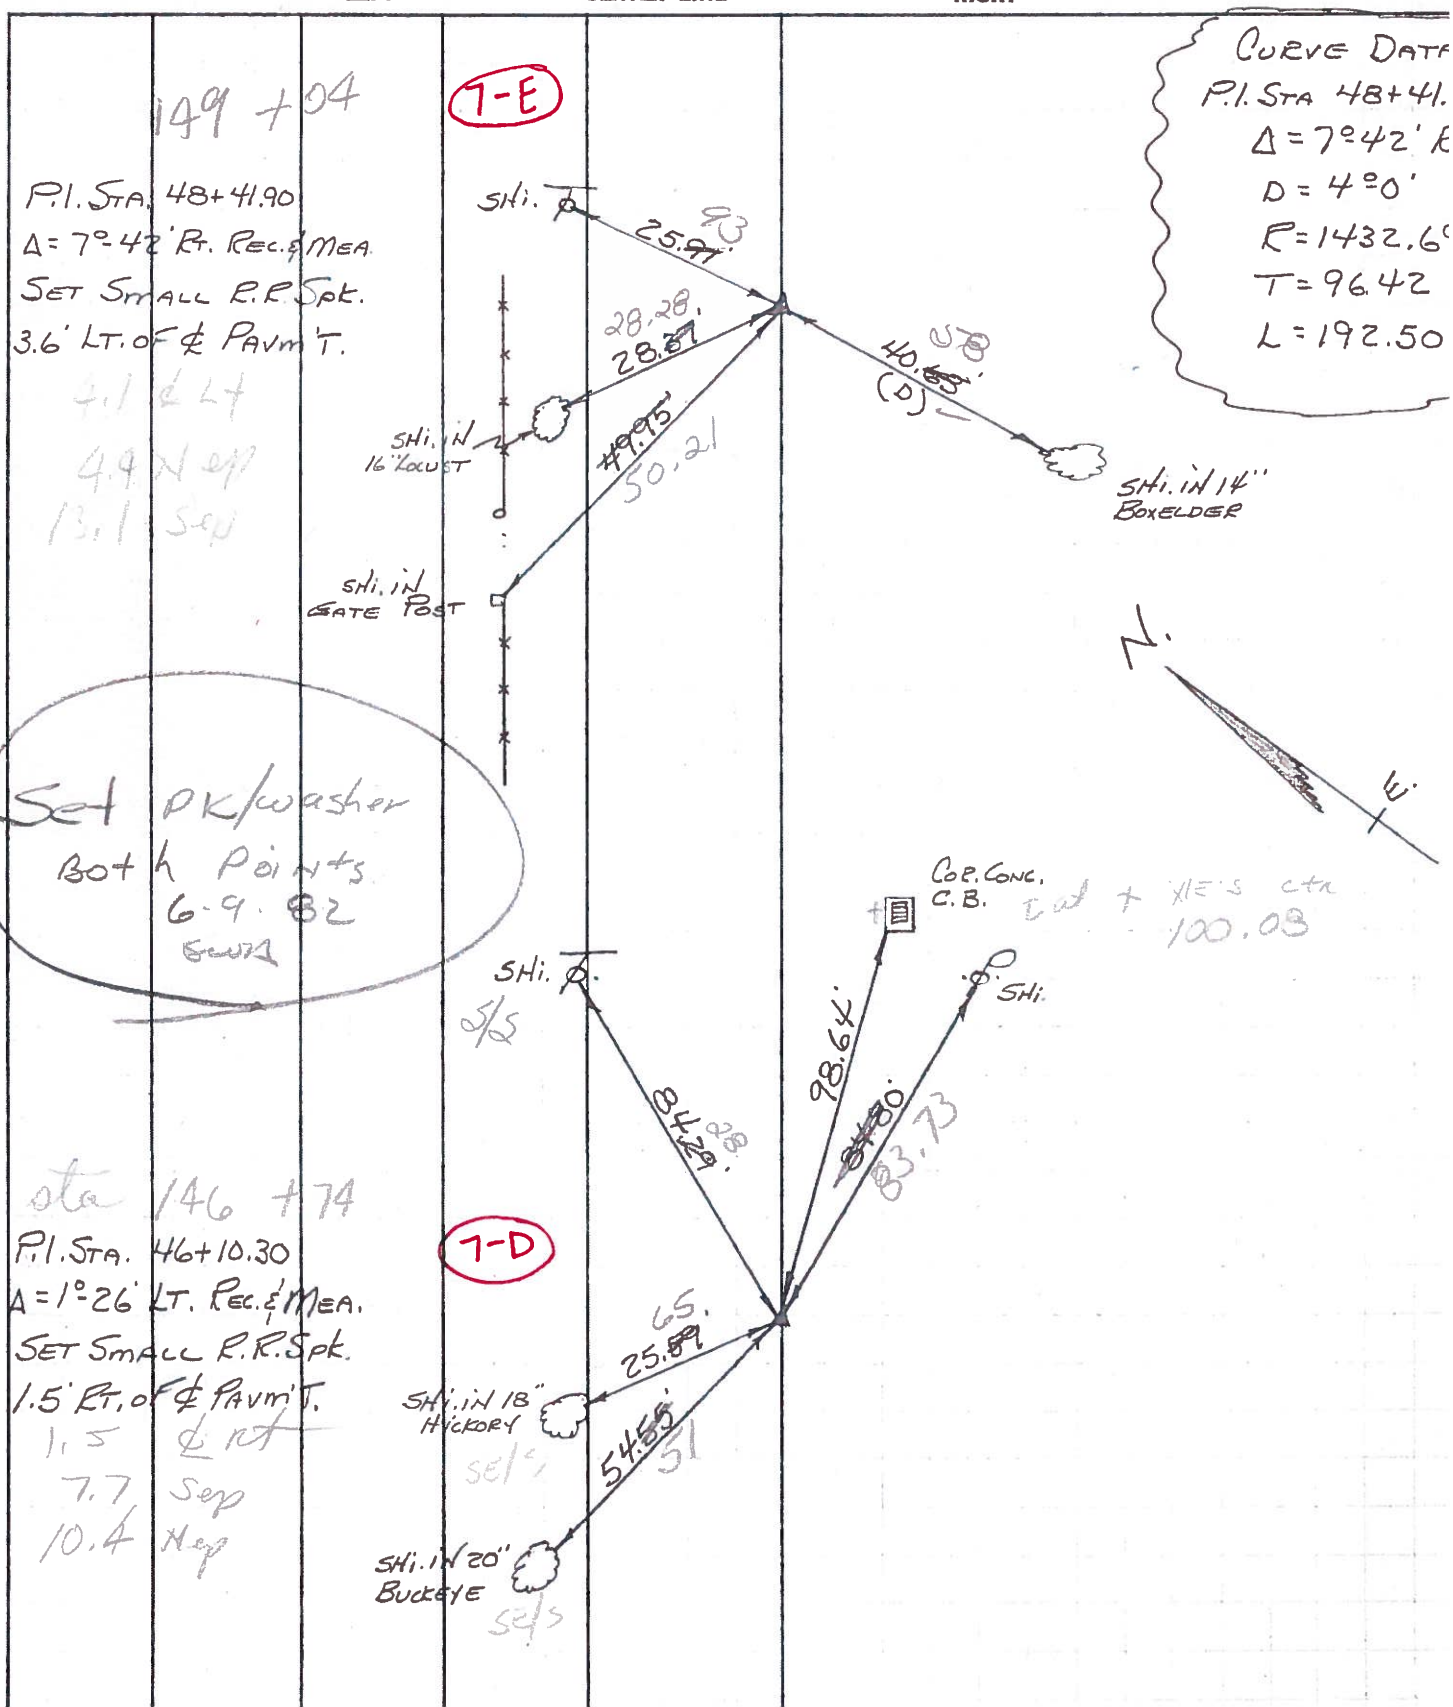

PERSONNEL TITLE PERSONNEL TITLE
BURNSIDE _____
SMITH _____
BOWERS _____

COUNTY WOOD DATE 9-28-72
 S. R. 65 WEATHER CLOUDY
 SEC. GRAND RAPIDS TWP TEMP. +58

DESCRIPTION ESTABLISH P.I.S JOB NO. _____
 LEFT CENTER LINE RIGHT

