

O.D.O.T. DISTRICT 2 SURVEY OFFICE (USE ONLY)

PERSONNEL

REFERENCE NO. 7 G

SHEET 35 OF 40

NOTES RHOADES

DATE 3/30/22

ROUTE SR 65

H.C. NIESE

WEATHER CLOUDY

COUNTY WOOD

R.C. KETNER

TEMP. 46°

TOWNSHIP GRAND RAPIDS

AUBLE

DWG BY RHOADES

PID 95796

SECTION 4

T 5 N R 9 E

TYPE MONUMENT P.K./WASHER

~~ON SURFACE~~ - BELOW 2 1/2"

OFFSET \odot PAVEMENT 0.6' \pm : RT

9.0' TO RT EDGE PAVEMENT


STATION: 165+62.66

HORZ.DATUM: NAD83 2011


GEOID: NAVD88 2018

GRID: NORTHING: 643573.328

EASTING: 1603368.727

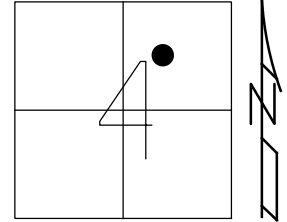

RECORD: P.O.T.
ORIGIN UNKNOWN
FD R.R.SPIKE
1" DOWN
FD P.K./WASHER
6/22/04, DCH
SET MAG/WASHER
9/17/04, RGN
FD P.K./WASHER
2 1/2" DOWN
REFG7
11/3/20, JFO
SET MAG/WASHER
10/5/22, TDN

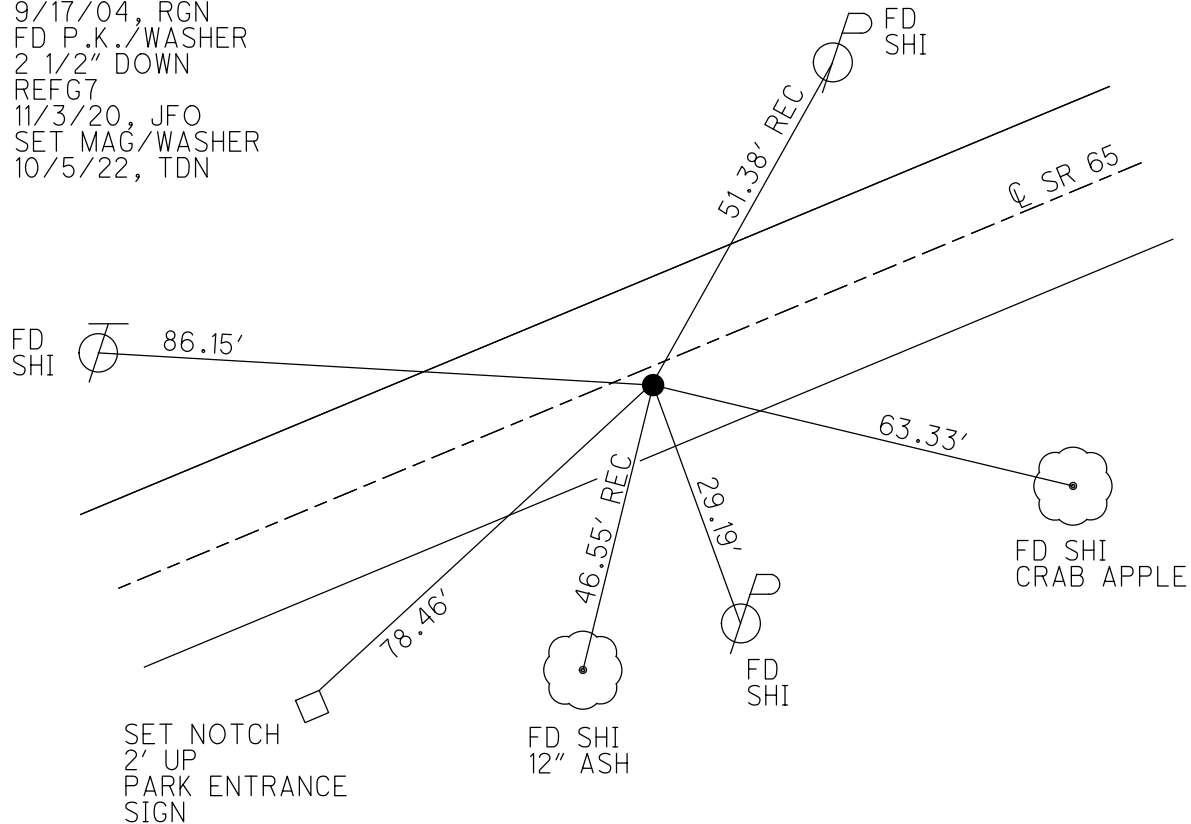

O.D.O.T. DISTRICT 2 SURVEY OFFICE

PERSONNEL

NOTES Nahler
 H.C. Homan
 R.C. Hooker


REFERENCE NO. 76

SHEET 77 OF 49

DATE 6-22-04
 WEATHER Sun.
 TEMP. 78°


ROUTE S.R. 65
 COUNTY Wood
 TOWNSHIP Grand Rapids
 SECTION 4
T 5 N R 9 E

TYPE MONUMENT PK/w
~~ON SURFACE~~ - BELOW 0.15'
~~LEFT OF PAV'T.~~ - RIGHT 0.6 ft.
9.0' TO Rt. EDGE PAVEMENT
 S.L.M. 165 + 61

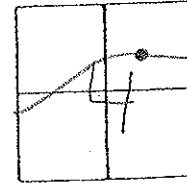

Record
 P.O.T
 Fd R.R. SpK
 Origin Unknown
 1' below
 1018.77' E of 1/2 sec
 line, sec 4

(Set Mas/W
 9-17-04
 R6N)

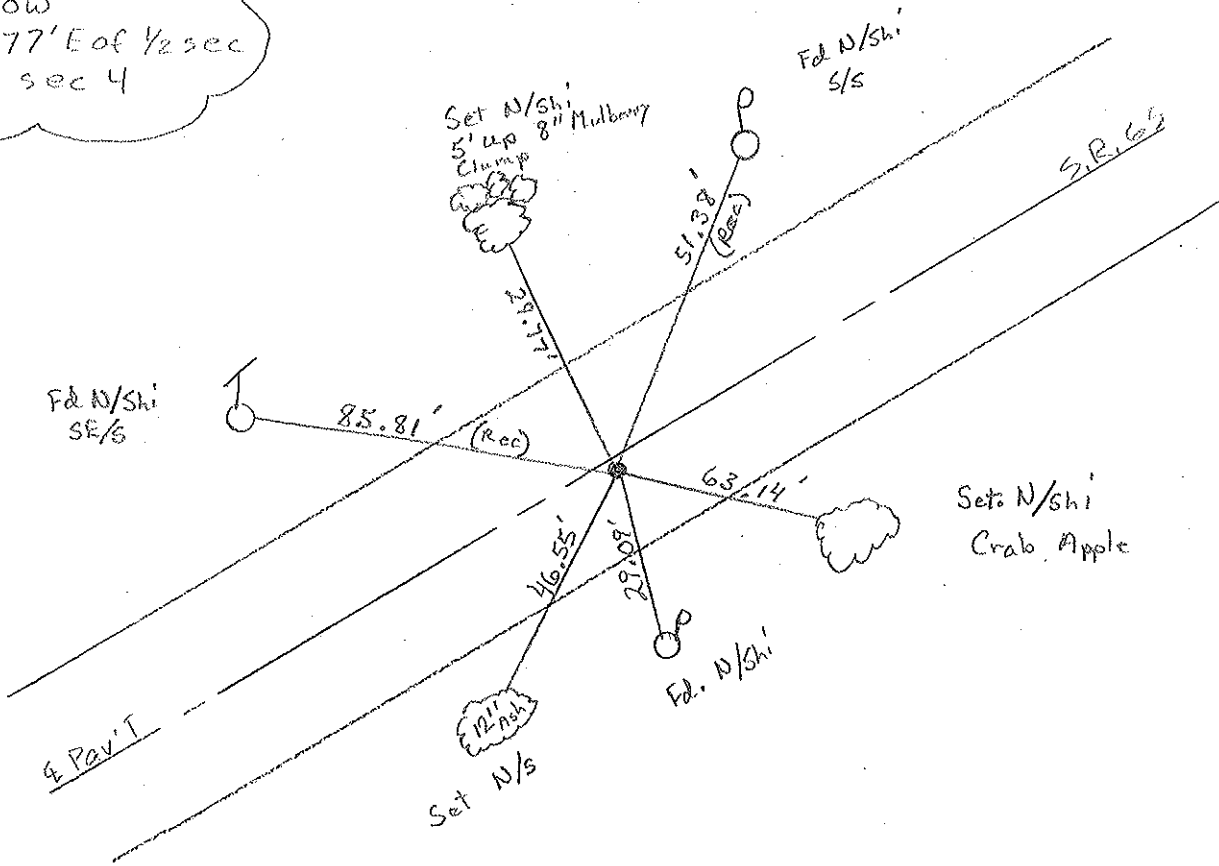

O.D.O.T. DISTRICT 2 SURVEY OFFICE

PERSONNEL

REFERENCE NO. 79

SHEET 12 OF 34

NOTES BARNHISEL

H.C. CURTIS

R.C. VAN DUSEN

Locheke

Romsto

DATE 4-21-92

WEATHER Cloudy

TEMP. +65°

ROUTE SR 65

COUNTY WOOD

TOWNSHIP GRAND RAPIDS

SECTION 4

T S N R 9 E

TYPE MONUMENT Reset P.K. & WASHER


ON SURFACE - BELOW YES

~~LEFT~~ - & PAV'T. - RIGHT 0.8

8.8 TO RT EDGE PAVEMENT

S.L.M. 165+62

5-4-92
C.L.

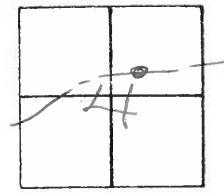

RECORD!

P.O.T.


FD. R.P. SPK

ORIGIN UNKNOWN

1" Below

1018.77' E. of 1/2 sec.

LINE, Sec. 4

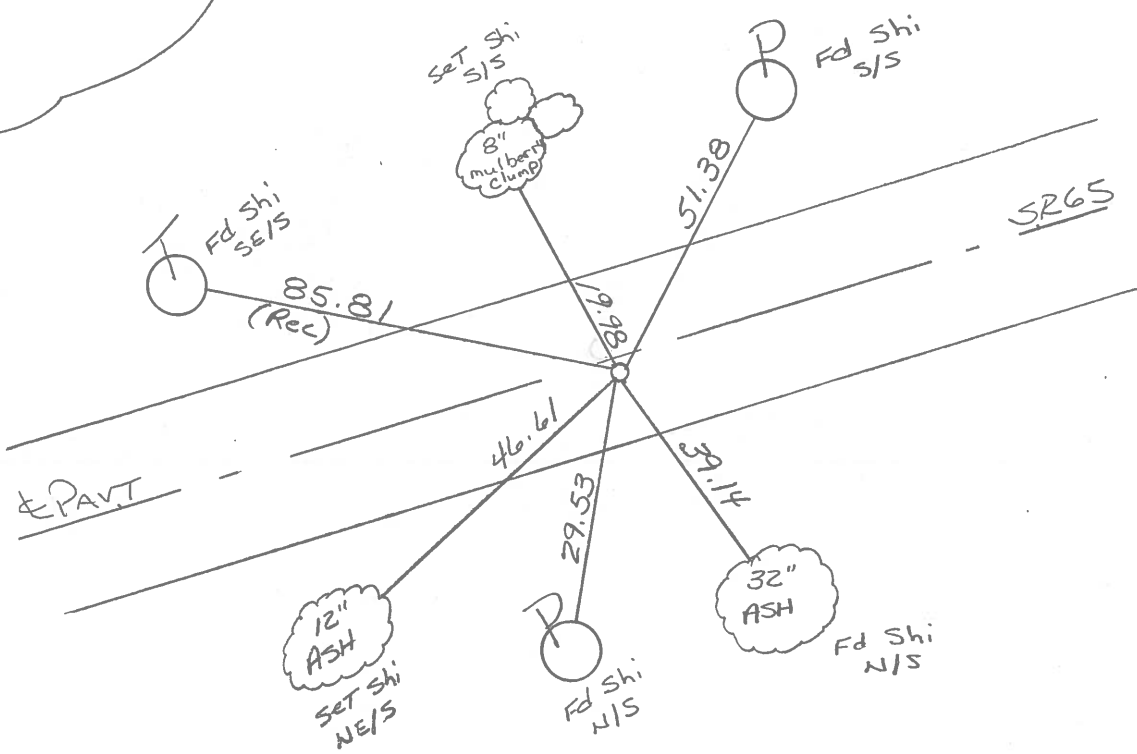

O.D.O.T. DISTRICT 2 SURVEY OFFICE

SHEET 20 OF _____

County Wood S.R. 65

Township Grand Rapids

Section 4

5N, R9E

Personnel Hoffman

Loehke


Householder

Date 6-9-82
12-10-81

Weather clear


Temp. +28°

(7-6)

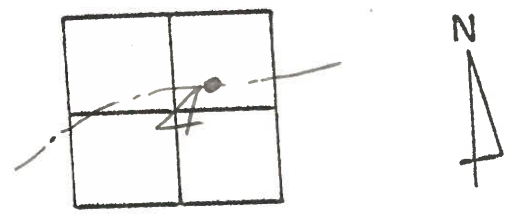

Fd. R.C. SPK - ORIGINAL UNKNOWN - 1" Below
Surface of ON & PAUT
9.8' to N.E.P.
8.1' to S.E.P.
1018.77' E. of 1/2 Sec Line,
Sec. 4

Project sta ± 165+75
P.O.T.

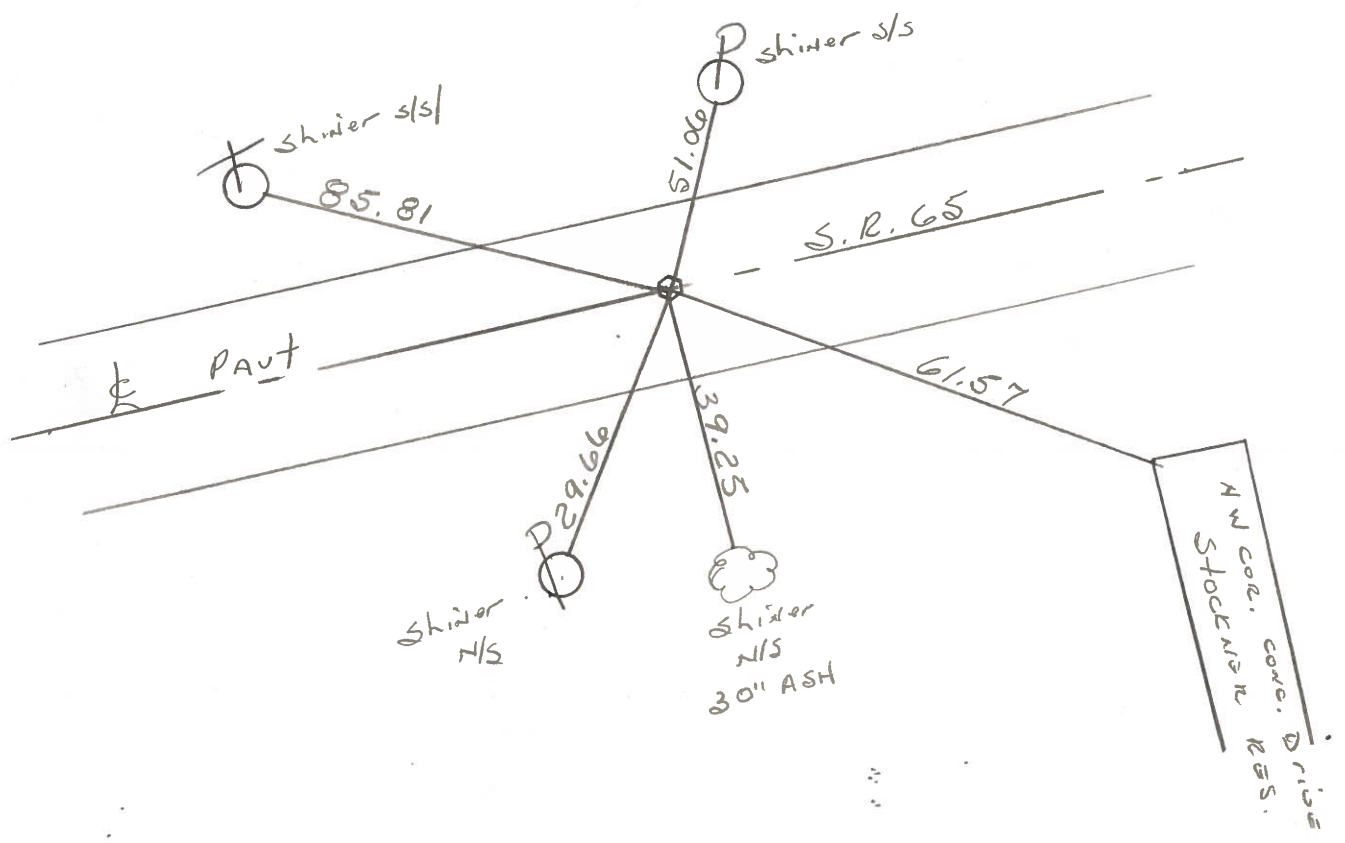

PERSONNEL TITLE PERSONNEL TITLE
 BUENOSIDE _____
 SMITH _____
 BOWERS _____

COUNTY Wood DATE 10-6-72
 S. R. 65 WEATHER Cloudy
 SEC. GRAND RAPIDS TWP TEMP. +55°

DESCRIPTION ESTABLISH P.I.² JOB NO. _____

