

O.D.O.T. DISTRICT 2 SURVEY OFFICE (USE ONLY)

PERSONNEL

REFERENCE NO. 7 H

SHEET 37 OF 40

NOTES RHOADES

DATE 3/30/22

ROUTE SR 65

H.C. NIESE

WEATHER CLOUDY

COUNTY WOOD

R.C. KETNER

TEMP. 45°

TOWNSHIP GRAND RAPIDS

AUBLE

DWG BY RHOADES

PID 95796

SECTION 4

T 5 N R 9 E

TYPE MONUMENT MAG SHANK

ON SURFACE - ~~BELOW~~ ON

OFFSET 7.4' LT : ~~RT~~

2.9' TO LT EDGE PAVEMENT


STATION: 189+12.14

HORIZ.DATUM: NAD83 2011


GEOID: NAVD88 2018

GRID: NORTHING: 644000.233

EASTING: 1605679.091

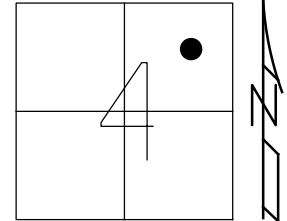

RECORD: P.I.  
 STA.88+76.9  
 $\Delta = 11^\circ 08' RT$   
 $D = 3^\circ 30'$   
 $R = 1637.28$   
 $T = 159.68$   
 $L = 315.14'$   
 FD R.R.SPIKE  
 1" DOWN  
 FD P.K./WASHER  
 0.2. DOWN  
 6/22/04, DCH  
 SET MAG/WASHER  
 9/17/04, RGN  
 FD MAG SHANK  
 REFH7  
 11/3/20, JFO  
 SET MAG/WASHER  
 10/5/22, TDN

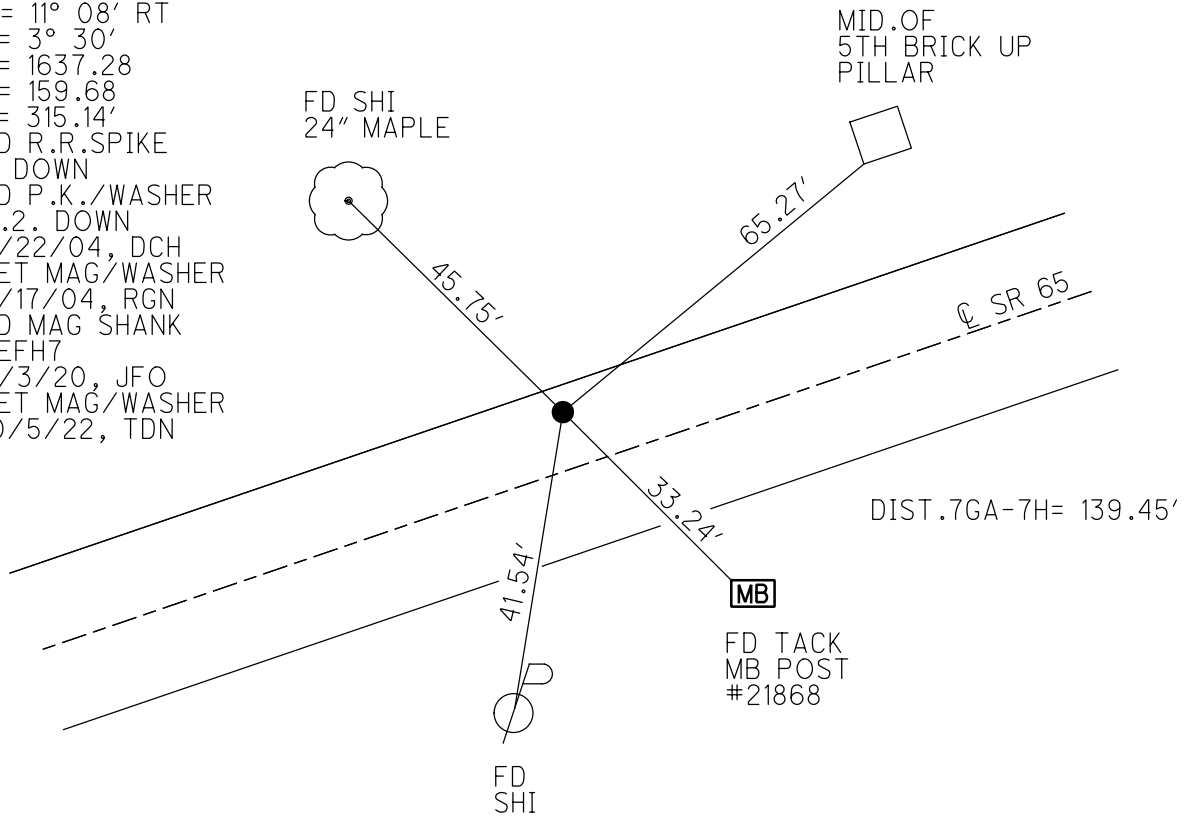

# O.D.O.T. DISTRICT 2 SURVEY OFFICE

PERSONNEL

REFERENCE NO. 74

SHEET 28 OF 49

NOTES Nuhter

H.C. Homan

R.C. Hooker

DATE 6-22-04

WEATHER Sun.

TEMP. 78°

ROUTE S.R. 65


COUNTY Wood

TOWNSHIP Grand Rapids

SECTION 4

T5 N R 9 E

TYPE MONUMENT Pts. (A) + (B) PK/W's  
 ON SURFACE - BELOW (A) - 0.2 below (B) - surface  
~~LEFT - (A) - 2.9'~~ ~~RIGHT - (B) - 3.6'~~  
 TO Lt. EDGE PAVEMENT (A) - 7.4' Lt. (B) - 2.0' Lt.  
 S.L.M. (A) - 187+80 (A) - 189+20

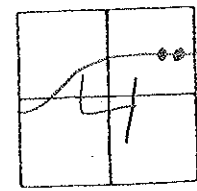


Record! 1923-1924 Plans

P.I. = 88+76.9  
 $\Delta = 11^{\circ}-08' RT$   
 $D = 3^{\circ}-30'$   
 $R = 1637.28$   
 $T = 159.68$   
 $L = 315.14$

Point "A"  
 P.I. Fd Spk set By  
 Poggemeyer 1" below  
 $\Delta$  Tuned 1972 =  $10^{\circ}-30' RT$   
 Point "B"  
 Fd RR Spk at surface  
 origin Unknown  
 P.O.T

Set Mag/W's  
 9-17-04  
 RGN

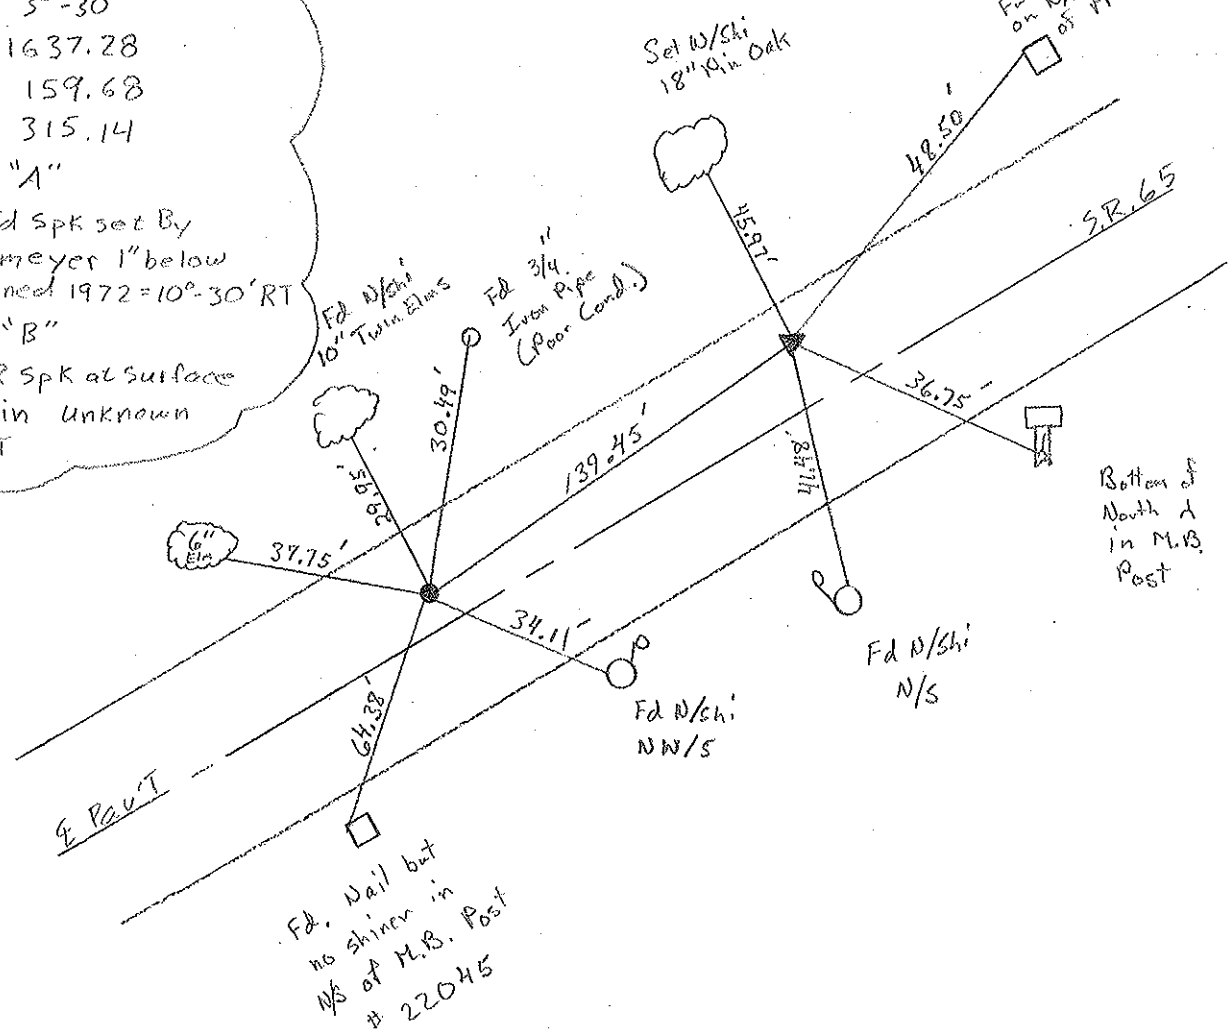

# O.D.O.T. DISTRICT 2 SURVEY OFFICE

PERSONNEL

REFERENCE NO. 7H

SHEET 13 OF 34

NOTES BARNHISEL  
 H.C. CURTIS  
 R.C. VAN DUSEN  
Loehrke  
Rometo


DATE 4-21-92  
 WEATHER cloudy  
 TEMP. +65°

ROUTE SR 65  
 COUNTY WOOD  
 TOWNSHIP GRAND RAPIDS  
 SECTION 4  
 T S N R 9 E

TYPE MONUMENT PT "A" & PT "B" ~ P.K. & WASHERS  
 ON SURFACE - BELOW yes ~ yes  
 LEFT- & PAV'T. - RIGHT 7.1 ~ 1.1  
A ~ 2.5  
B ~ 8.2  
TO LT EDGE PAVEMENT  
 S.L.M. PT "A" 189+13

Reset

5-4-92  
 C.L.

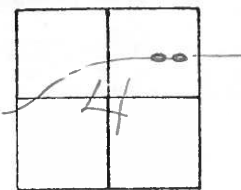


RECORDS: 1923-1924 PLANS

P.I. 88+76.9  
 $\Delta = 11^\circ 08' \text{ RT.}$   
 $D = 3^\circ - 30'$   
 $R = 1637.28$   
 $T = 159.68$   
 $L = 315.14$

POINT "A"  
 P.I. Fd. SPK set BY  
 Poggemeyer 1" Below  
 $\Delta$  TURNED 1972 =  $10^\circ - 30' \text{ RT.}$

POINT "B"  
 Fd R.R. SPK at SURFACE  
 ORIGINAL UNKNOWN  
 P.O.T.

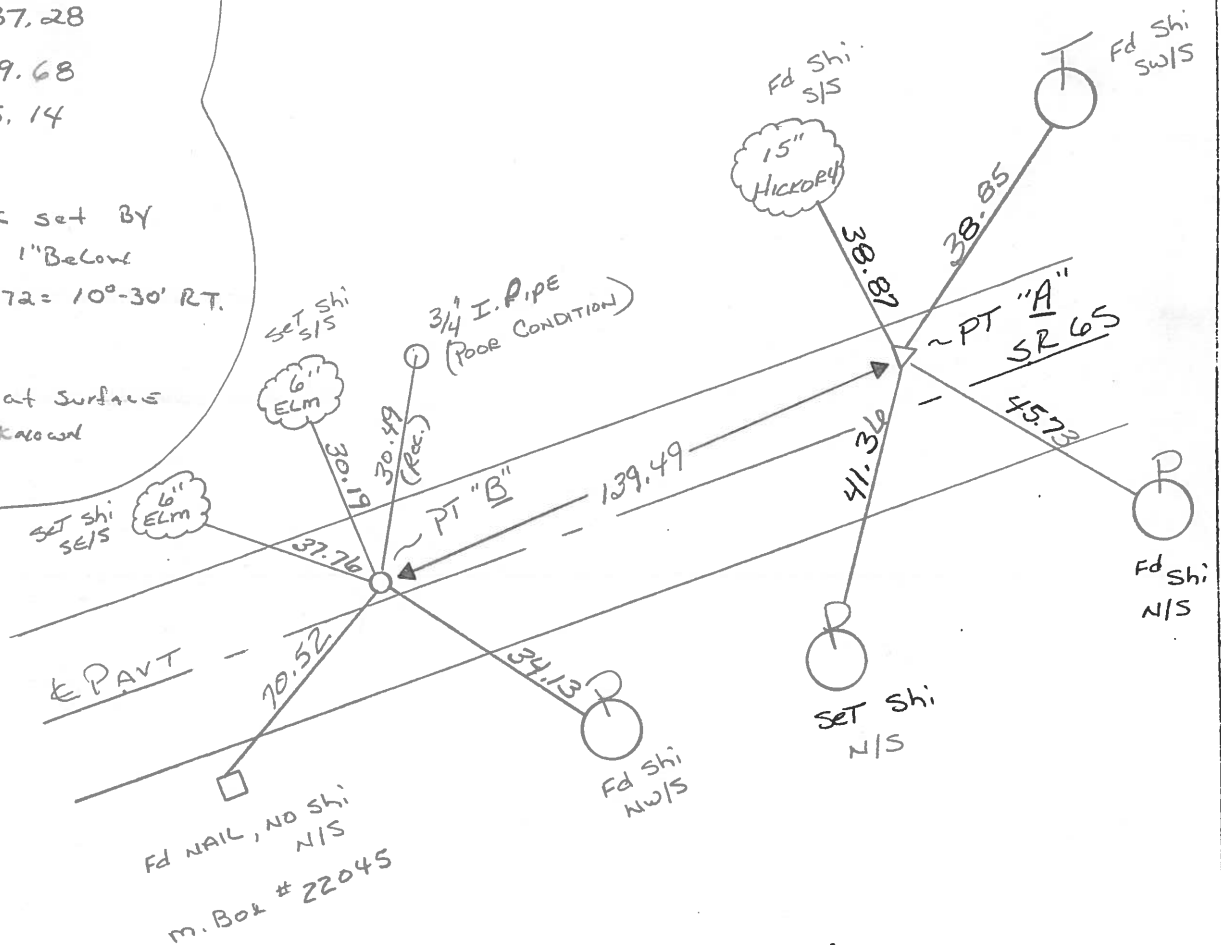

O.D.O.T. DISTRICT 2 SURVEY OFFICE

SHEET 21 OF       

County Wood S.R. 65

Township Grand Rapids

Section 4

Q1N, R9E

Personnel Hoffman

Loehrke


Householder

**7-H**

Date 6-9-82  
12-10-81

Weather clear

Temp. 30°

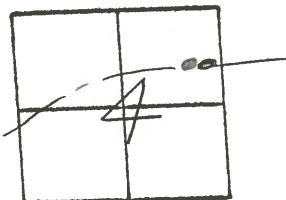

Pt. "A" Fd. P.I. Spk - set by Possemeyer

Project sta ± 189+23

1" below surface; Δ = 10°-30' Rt -1972

6.6' Lt. of & PAUT.

3.6' N. EP.

16.2' S. EP.

Pt. "B" original unknown - Fd. r.e. spk @ surface - Project sta ± 187+85

P.O.T.

0.8' Lt. of &

9.3' to N. EP.

10.2' to SEP

3/4" I. pipe

Clump  
Shiner 6"




8" maple Shiners  
45



15" Hickory



Shiner  
suts

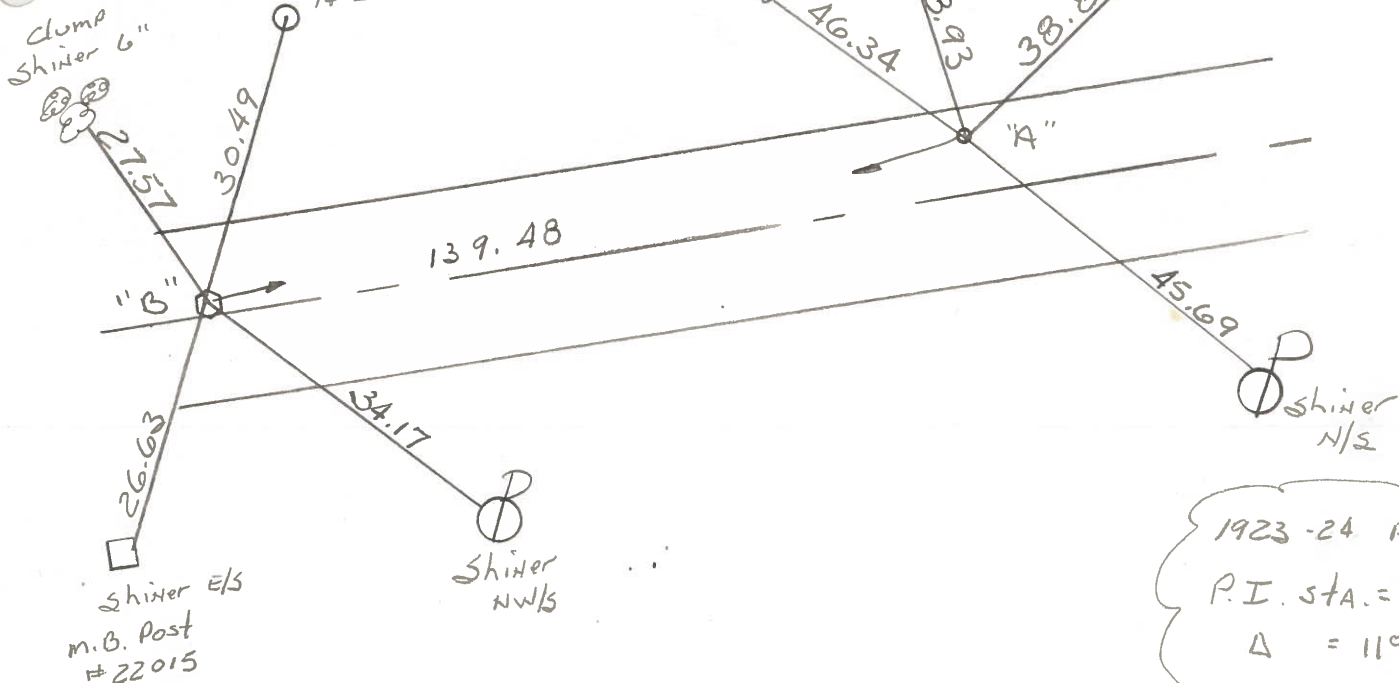

1923-24 PLANS

P.I. STA. = 88+76.

Δ = 11°-08'

D = 3°-30'

R = 1637.28


T = 159.63

L = 315.14

PERSONNEL TITLE PERSONNEL TITLE  
 BURNSIDE \_\_\_\_\_  
 SMITH \_\_\_\_\_  
 BOWERS \_\_\_\_\_

COUNTY WOOD DATE 10-6-72  
 S. R. 65 WEATHER CLOUDY  
 SEC. GRAND RAPIDS TWP TEMP. +58°

DESCRIPTION CONTROL TIES JOB NO. \_\_\_\_\_

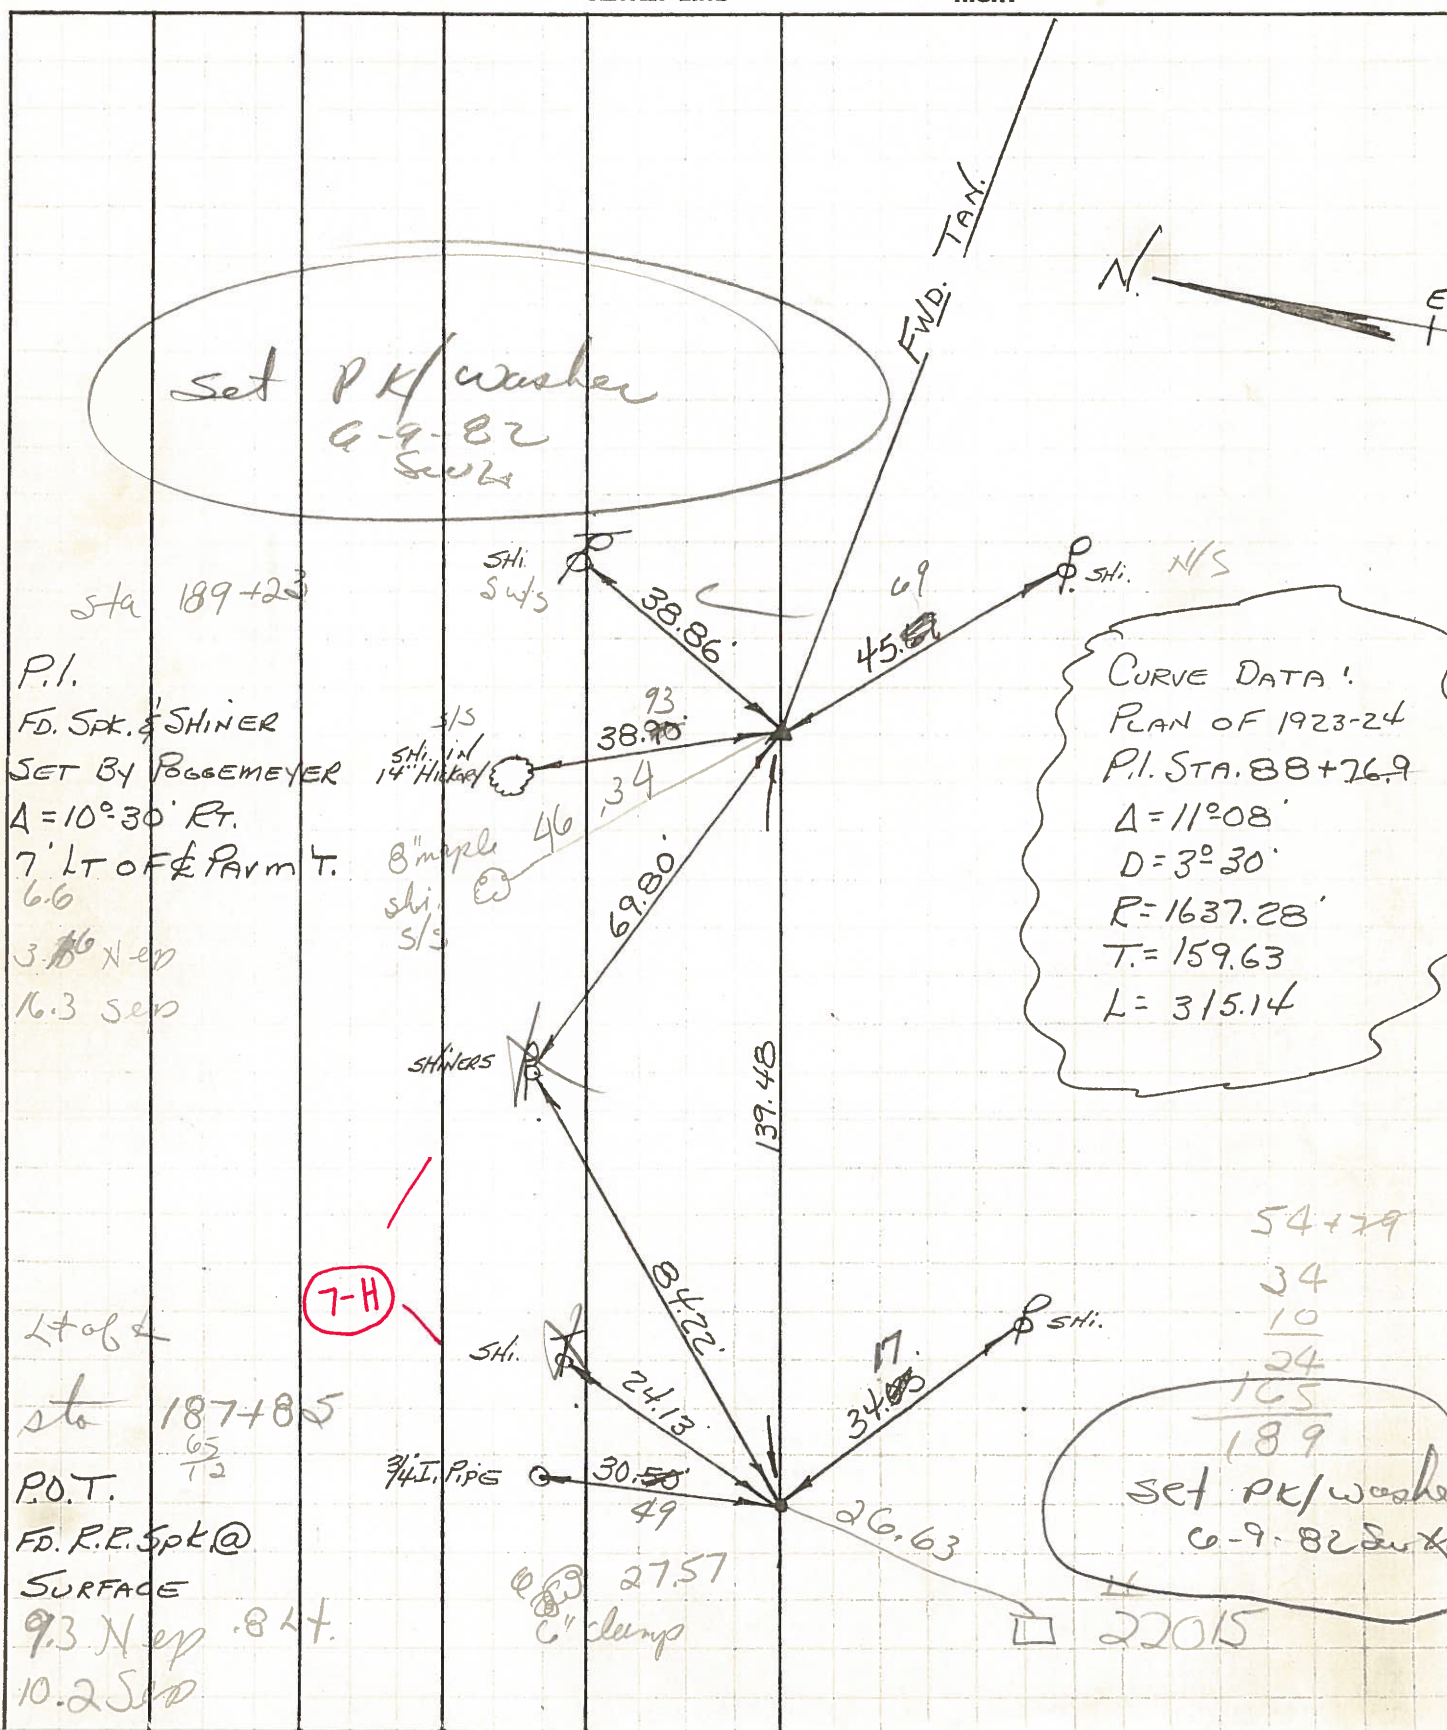

set PK/washer  
 6-9-82  
 SWS

Sta 189+23  
 P.I.  
 FD. SPT. & SHINER  
 SET BY BOGEMEYER  
 $\Delta = 10^\circ 30'$  RT.  
 7' LT OF E. PARM T.  
 6.6  
 3.16 N-ep  
 16.3 S-ep

Sta 187+85  
 P.O.T.  
 FD. R.E. SPT @  
 SURFACE  
 9.3 N-ep 8 ft.  
 10.2 S-ep

CURVE DATA:  
 PLAN OF 1923-24  
 P.I. STA. 88+76.9  
 $\Delta = 11^\circ 08'$   
 $D = 3^\circ 30'$   
 $R = 1637.28'$   
 $T = 159.63$   
 $L = 315.14$

54+79  
 34  
 10  
 24  
 165  
 189  
 set PK/washer  
 6-9-82 SWS  
 22015

7-H

PERSONNEL TITLE PERSONNEL TITLE  
BURNSIDE \_\_\_\_\_  
SMITH \_\_\_\_\_  
BOWERS \_\_\_\_\_

COUNTY Wood DATE 10-6-72

S. R. 65 WEATHER Cloudy

SEC. GRAND RAPIDS TWP TEMP. +58°

DESCRIPTION CONTROL TIES JOB NO. \_\_\_\_\_

