

O.D.O.T. DISTRICT 2 SURVEY OFFICE (USE ONLY)

PERSONNEL

REFERENCE NO. 8 AA

SHEET 40 OF 40

NOTES RHOADES

DATE 3/30/22

ROUTE SR 65

H.C. NIESE

WEATHER CLOUDY

COUNTY WOOD

R.C. KETNER
AUBLE

TEMP. 46°

TOWNSHIP GRAND RAPIDS

SECTION 3
T 5 N R 9 E

DWG BY RHOADES PID 95796

TYPE MONUMENT MAG/WASHER

ON SURFACE - ~~BELOW~~ ON

OFFSET 3' ± : RT

13.3' TO LT EDGE PAVEMENT


STATION: 200+17.36

HORZ. DATUM: NAD83 2011


GEOID: NAVD88 2018

GRID: NORTHING: 644200.639

EASTING: 1606749.021

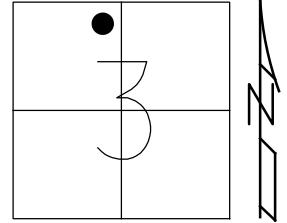

RECORD:
ORIGIN UNKNOWN
FD MAG/SHI
6/22/04, DCH
SET MAG/WASHER
9/17/04, RGN
FD MAG/WASHER
REFAA8
11/3/20, JFO
SET MAG/WASHER
10/5/22, TDN

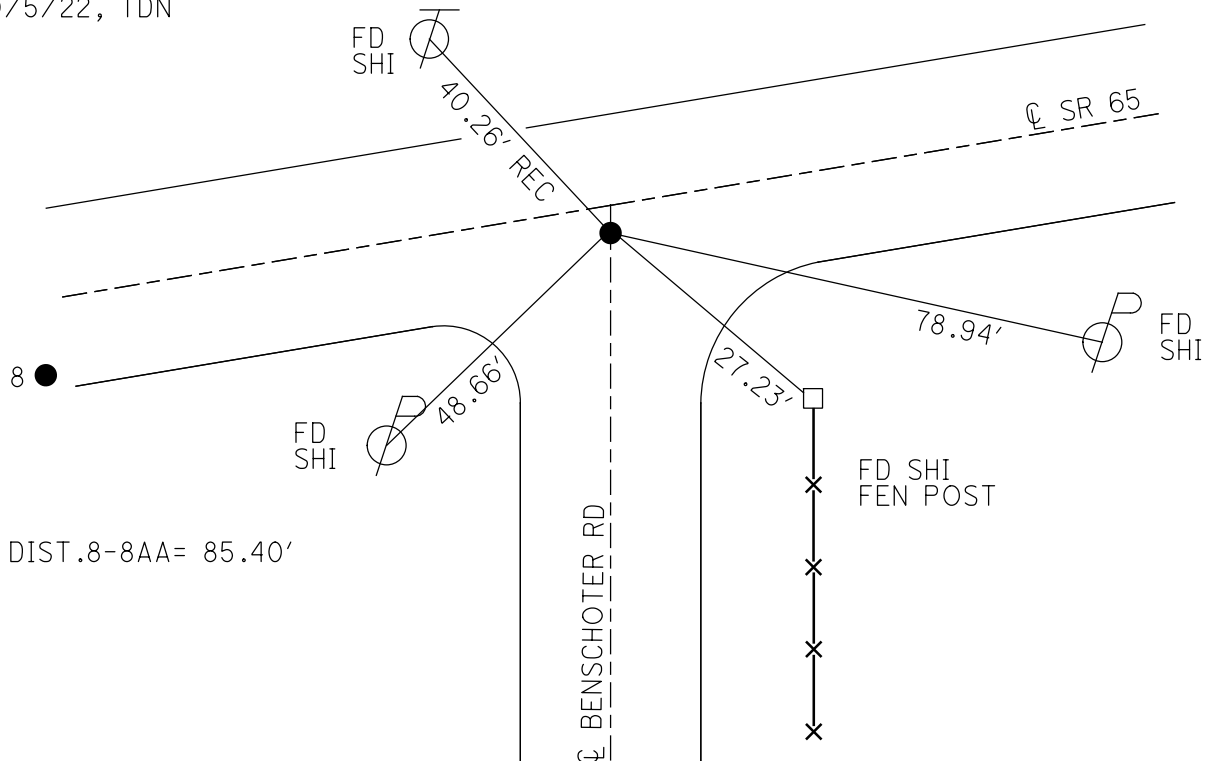

O.D.O.T. DISTRICT 2 SURVEY OFFICE

PERSONNEL _____

REFERENCE NO. 8

SHEET 30 OF 49

NOTES Nuh Fer

H.C. Homan

R.C. Huss

DATE 6-22-04

WEATHER Sun.

TEMP. 78°

ROUTE S.R. 65


COUNTY Wood

TOWNSHIP Grand Rapids

SECTION 3

T5 N R 9 E


TYPE MONUMENT (A) 1" iron pipe (B) Mag/shi
 ON SURFACE - BELOW (A) 4" below (B) Surface
 LEFT - E PAV'T. - RIGHT (A) 12' Rt. (B) 13.3' to Lt. EDP
 (A) 2.6' Rt. ^{of} Rt. EDGE PAVEMENT (B) 3' Rt of a
 S.L.M. (A) 199+34

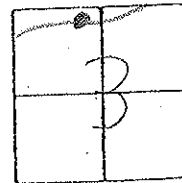

Record: 1923-1924 Plans
 P.I. = 98+97.9
 Δ = 14°-45' LT
 D = 6°-00'
 R = 955.37 T = 123.53
 L = 245.63
 Δ By Poggemeyer (= 15°-20')

"B" - original Max-wound

Set - Mag/W
 at Points A+B
 9-17-04
 RGN

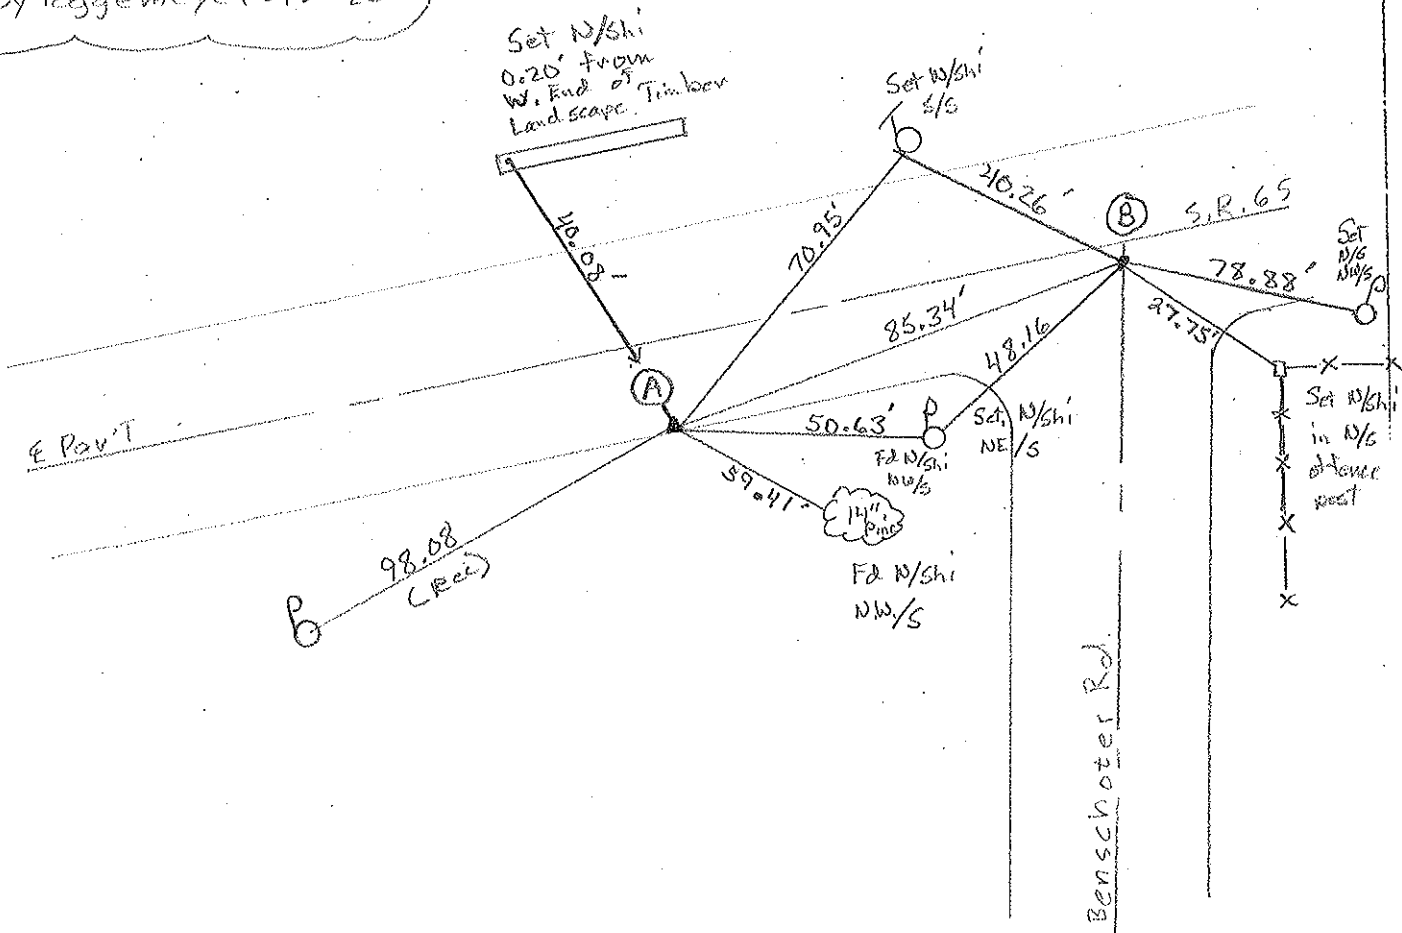

O.D.O.T. DISTRICT 2 SURVEY OFFICE

PERSONNEL

REFERENCE NO. 8

SHEET 15 OF 34

NOTES BARNHISEL

H.C. CURTIS

R.C. VAN DUSEN

Loehrke

Romero

DATE 4-21-92

WEATHER Cloudy

TEMP. +65°

ROUTE SR 65

COUNTY WOOD

TOWNSHIP Grand Rapids

SECTION 3

T5N R9E


TYPE MONUMENT 1" IRON PIPE

~~ON~~ SURFACE - BELOW 4"

~~LEFT~~ - ~~C~~ PAV'T. - RIGHT 12.0

~~2.8 RT~~ ^{OF} ~~TO~~ RT. EDGE PAVEMENT

S.L.M. 199+34

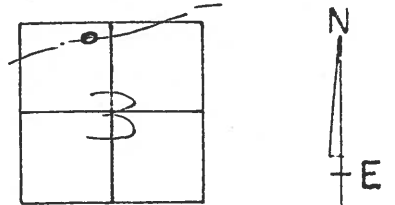

RECORD: 1923-1924 PLANS

P.I. 98+97.9

$\Delta = 14^{\circ}-45'LT.$


$D = 6^{\circ}-00'$

$R = 955.37$

$T = 123.53$

$L = 245.63$

Δ BY POGGEMEYER = $15^{\circ}-20'$

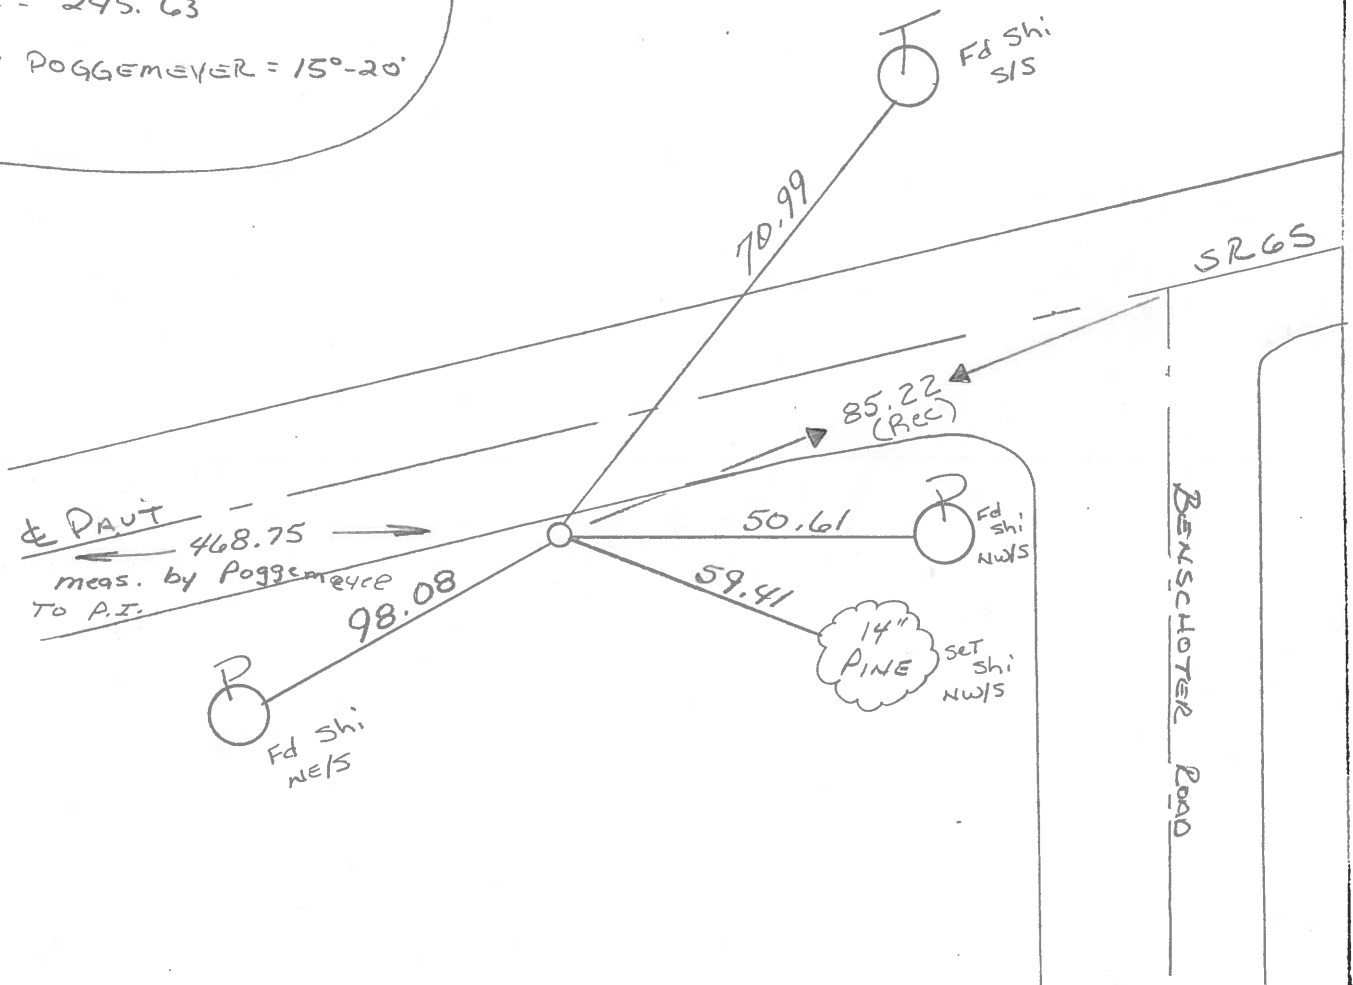

O.D.O.T. DISTRICT 2 SURVEY OFFICE

SHEET _____ OF _____

County WOOD S.R. 65

Township GRAND RAPIDS

Section 3

T5N, R9E

Personnel BURNSIDE H

SMITH H


_____ H

_____ H

Date 10-10-72 ¹²⁻¹⁰⁻⁸¹

Weather CLEAR ✓

Temp. 67° 30'

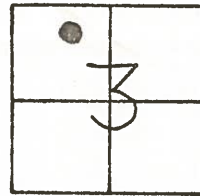


8

P.I. FD. TACKED HUB
SET BY POGGEMEYER,
REPLACED WITH 1" IRON **Fd pipe**
PIPE 4' S. OF S. EDGE PAUT.
 $\Delta = 19^{\circ}-00'$ (POGGEMEYER)

13.6 S. OF PAUT.

P.I. FD. TACKED HUB
BY POGGEMEYER REPLACED
WITH 1" IRON PIPE. **Fd pipe**
3.0-2.3'S OF S. EDGE PAUT.
 $\Delta = 15^{\circ}-20'$ (POGGEMEYER)

11.6 S. OF PAUT.

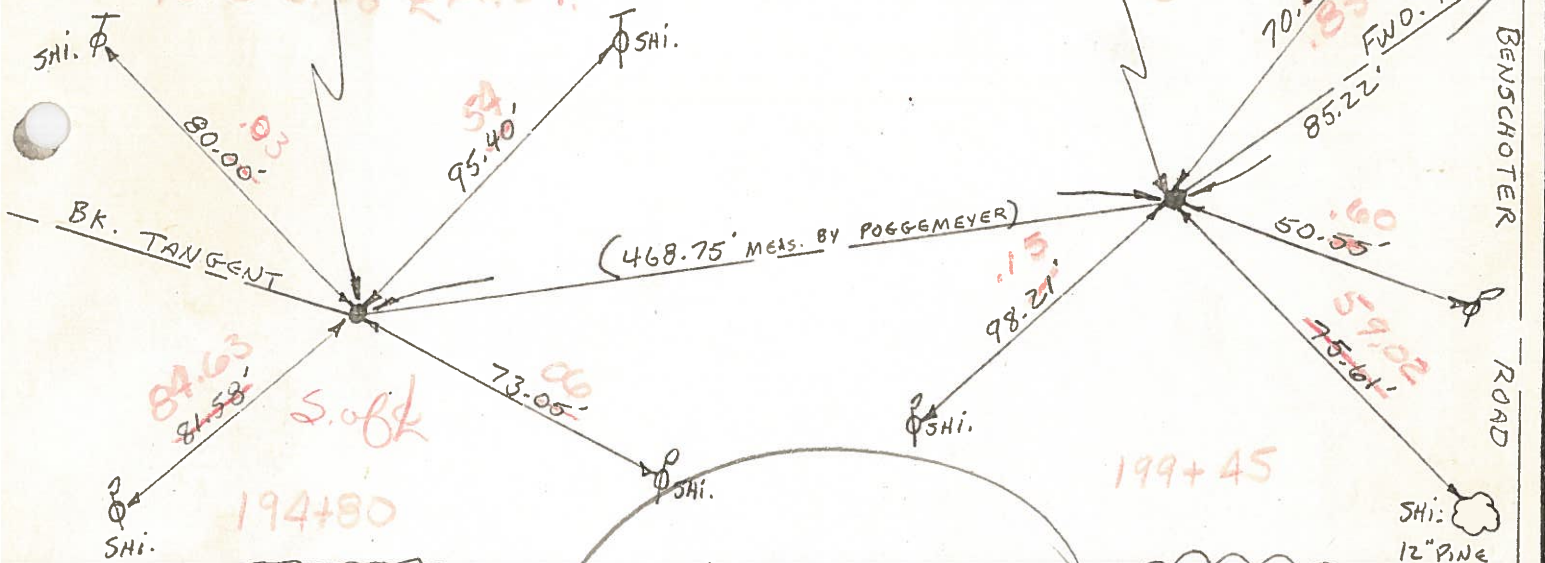

CURVE DATA
PLAN-1923-24
P.I. = STA. 94+13.3
 $\Delta = 20^{\circ}-22'$ LT.
D = 6'-00'
R = 955.37
T = 171.58'
L = 339.44

Located Both
Points - painted
→ 's on
S.E.P.
6-9-82
sm

CURVE DATA
PLAN-1923-24
P.I. = STA. 98+97.9
 $\Delta = 14^{\circ}-45'$ LT.
D = 6'-00'
R = 955.37
T = 123.53'
L = 245.63

(CONFRONTATION FARM)

OD.O.T. DISTRICT 2 SURVEY OFFICE

SHEET 23 OF

County Wood S.R. 65

Township Grand Rapids

Section 3

EN, R9E

Personnel Hoffman

Loehrke


Householder

88

Date 12-10-81


Weather Clear

Temp. +28°

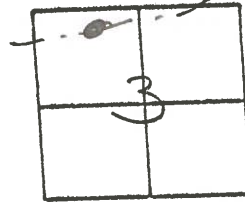

Project stat 199+45

Fd. 1" I.D. IRON pipe @ surface
 11.6' S. of & PAUT.
 3.0' S. of S.F.P.
 Δ = 15°-20' (By Possemeyer)

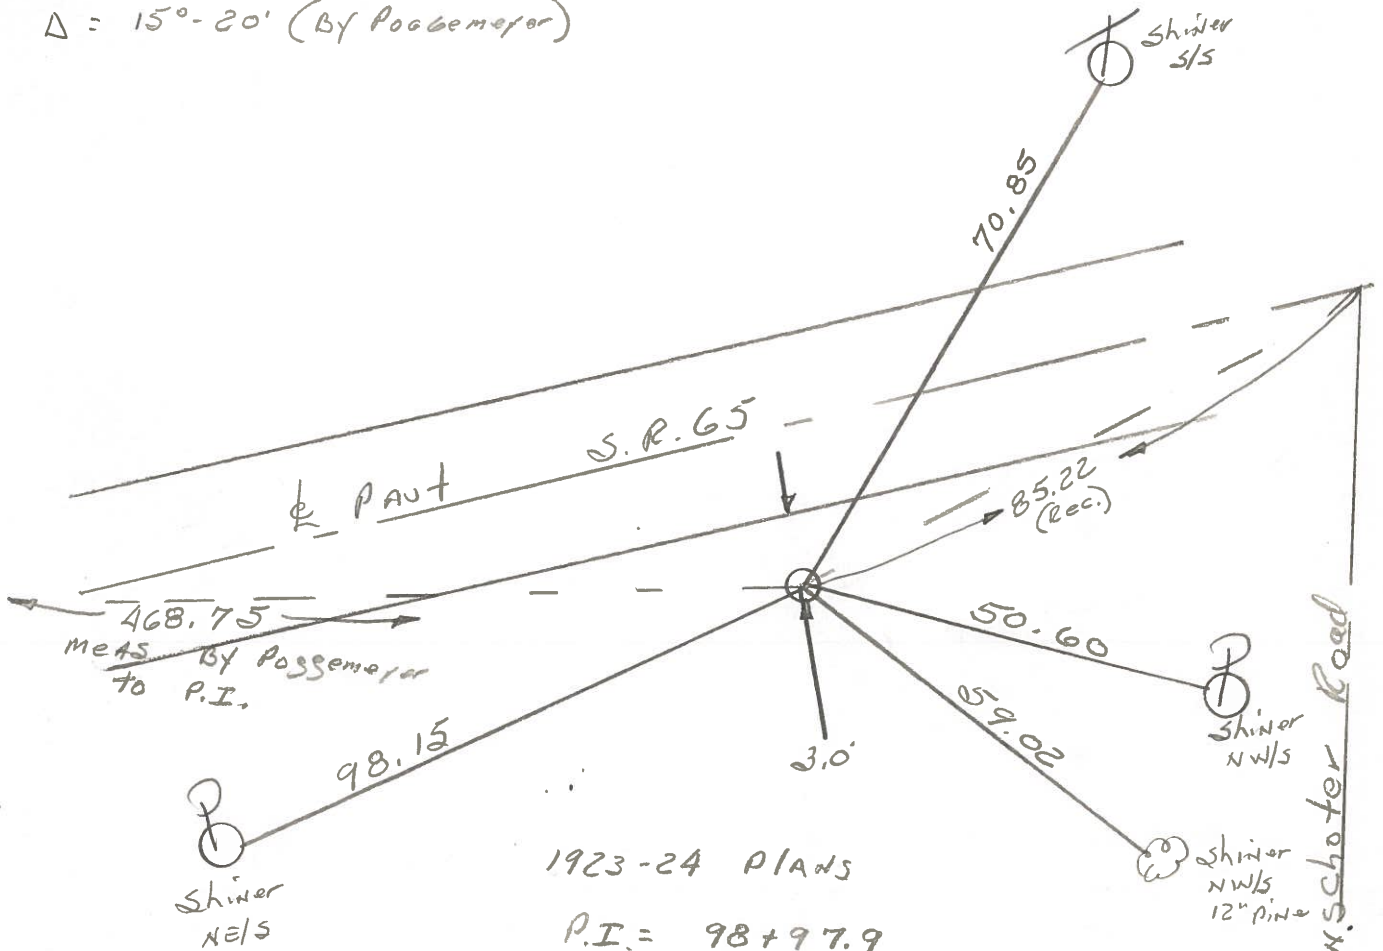

1923-24 PLANS

P.I. = 98+97.9

Δ = 14°-45' Lt.

D = 6°-00'

R = 955.37

T = 123.53

L = 245.63

Benschoter Road

OD.O.T. DISTRICT 2 SURVEY OFFICE

SHEET _____ OF _____

County WOOD S.R. 65

Township GRAND RAPIDS

Section 3

T5N, R9E


Personnel BURNSIDE

SMITH

Date 10-10-72

Weather CLEAR



Temp. 67°

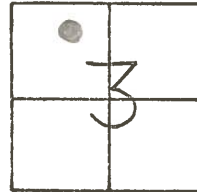

#8

P.I. FD. TACKED HUB
SET BY POGGEMEYER,
REPLACED WITH 1" IRON
PIPE 4' S. OF S. EDGE PAUT.
 $\Delta = 19^{\circ}-00'$ (POGGEMEYER)

P.I. FD. TACKED HUB
BY POGGEMEYER REPLACED
WITH 1" IRON PIPE.
2.3'S OF S. EDGE PAUT.
 $\Delta = 15^{\circ}-20'$ (POGGEMEYER)

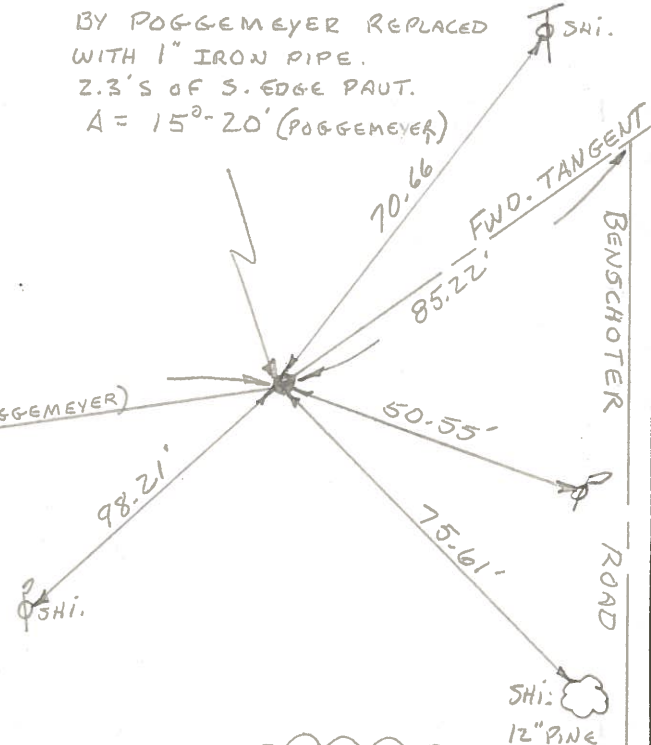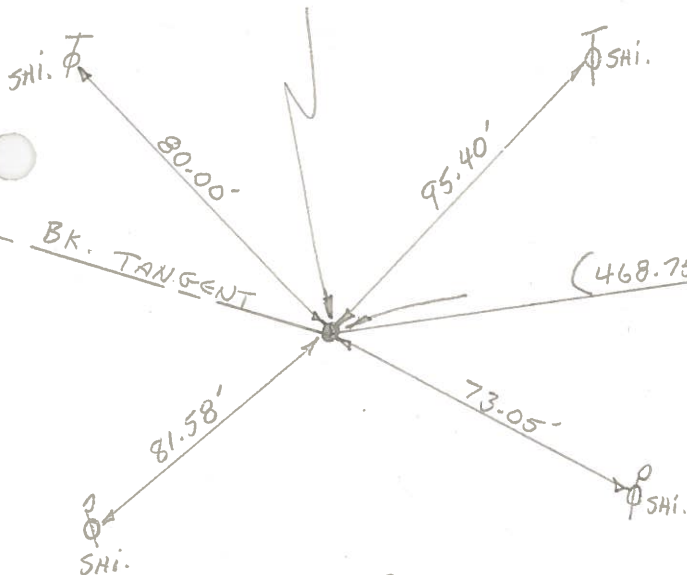

CURVE DATA
PLAN-1923-24
P.I. = STA. 94+13.3
 $\Delta = 20^{\circ}-22'$ LT.
D = 6°-00'
R = 955.37
T = 171.58'
L = 339.44

CURVE DATA
PLAN-1923-24
P.I. = STA. 98+97.9
 $\Delta = 14^{\circ}-45'$ LT.
D = 6°-00'
R = 955.37
T = 123.53'
L = 245.63

County WOOD S.R. 65

Township GRAND RAPIDS

Section 3

T5N, R9E


Personnel BURNSIDE

SMITH

Date 12-10-51
10-10-72

Weather CLEAR


Temp. 67°

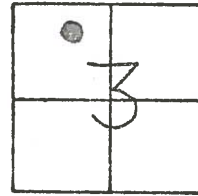

8

P.I. PD. TACKED HUB
SET BY POGGEMEYER,
REPLACED WITH 1" IRON **Fd pipe**
PIPE 4' S.OF S. EDGE PAUT.
 $\Delta = 19^{\circ}-00'$ (POGGEMEYER)

P.I. PD. TACKED HUB
BY POGGEMEYER REPLACED
WITH 1" IRON PIPE. **Fd pipe**
PIPE 2.3' S.OF S. EDGE PAUT.
 $\Delta = 15^{\circ}-20'$ (POGGEMEYER)

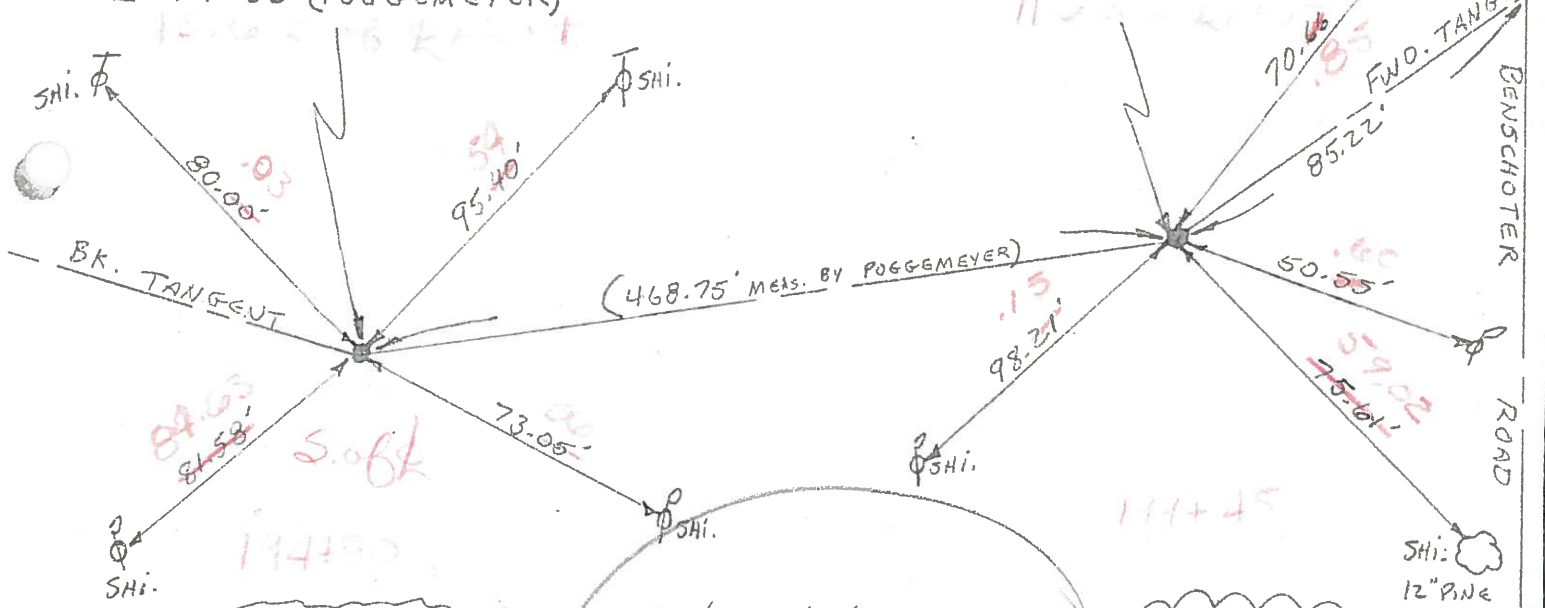

CURVE DATA
PLAN-1923-24
P.I. = STA. 94+13.3
 $\Delta = 20^{\circ}-22'$ LT.
D = 6'-00"
R = 955.37
T = 171.58'
L = 339.44

Located Both
Points - painted
→ 15' on
S.E.R.
6-9-82
SWR

CURVE DATA
PLAN-1923-24
P.I. = STA. 98+97.9
 $\Delta = 14^{\circ}-45'$ LT.
D = 6'-00"
R = 955.37
T = 123.53
L = 245.63

(CONTINUED)
FILM

PERSONNEL TITLE PERSONNEL TITLE

COUNTY Wood

DATE 4-9-57

S. R. #110

WEATHER

SEC. A, C

TEMP.

DESCRIPTION

LEFT

CENTER LINE

RIGHT

JOB NO.

P.I. Sta. 66+30.60

$\Delta = 0^\circ - 01' \text{ Rf.}$

on N. & S. line & E. & W. line
1' to S. edge pav't.

Fd. 1/2" I. rod 6" under pav't.

#505

(Benschoter Rd.)

Fd. I. pipe. Set R.P. spt.
18" in S.E. pav't.

#506

369.20'
Co. Distance

P.I. Sta. 79+

$\Delta = ?$ Cor. stone 2" under
pav't. 'X' in top, - P.K. nail

P.I. Sta. 92+93.31


$\Delta = 0^\circ - 02' \text{ Rf.}$

(Armbruster Rd.)

Fd. R.P. spt.

#507

monument S.W.	36.93'
monument S.E.	37.10'
N. to shi. in oak stump	40.58'
N.E. to shi. T.P.	44.49'

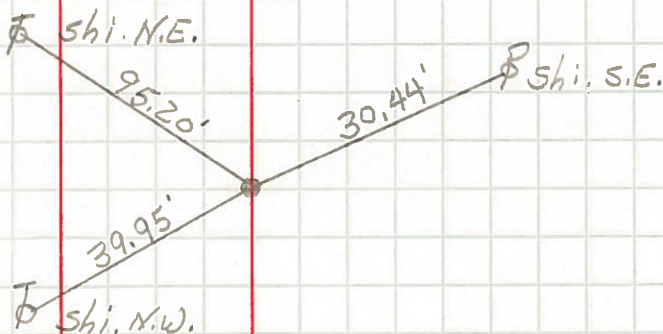

Shiner in T.P. N.W.	56.90
Shiner in P.P. S.E.	32.95'
R/W mon. S.E.	47.03'
R/W mon. N.E.	47.05'
N.E. cor. brick Ho. S.W. 1 st brick	52.50'

