


O.D.O.T. DISTRICT 2 SURVEY OFFICE (USE ONLY)


PERSONNEL	REFERENCE NO. <u>8 AB</u>	SHEET <u>1</u> OF <u>22</u>
NOTES <u>RHOADES</u>	DATE <u>3/30/22</u>	ROUTE <u>SR 65</u>
H.C. <u>NIESE</u>	WEATHER <u>WINDY</u>	COUNTY <u>WOOD</u>
R.C. <u>AUBLE</u>	TEMP. <u>61°</u>	TOWNSHIP <u>GRAND RAPIDS</u>
<u>KETNER</u>		SECTION <u>3</u>
DWG BY <u>RHOADES</u>	PID <u>95796</u>	T <u>5</u> N R <u>9</u> E

TYPE MONUMENT MAG/WASHER
 ON SURFACE - ~~BELOW~~ ON _____
 OFFSET C PAVEMENT 5' LT : ~~RT~~
4.5' TO LT EDGE PAVEMENT
 STATION: 207+41.18

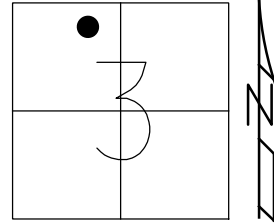

HORZ. DATUM: NAD83 2011 GEOID: NAVD88 2018
 GRID: NORTHING: 644608.937 EASTING: 1607347.095

RECORD: P.I.
 STA. 106+90
 $\Delta = 9^\circ 28'$ MEAS
 STA. 207+54
 6/9/82
 SET SM.R.R.SPIKE
 10/12/72
 SET P.K./WASHER
 6/8/92
 FD MAG/WASHER
 REFAB8
 3/30/22, TDN
 SET MAG/WASHER
 10/6/22, TDN

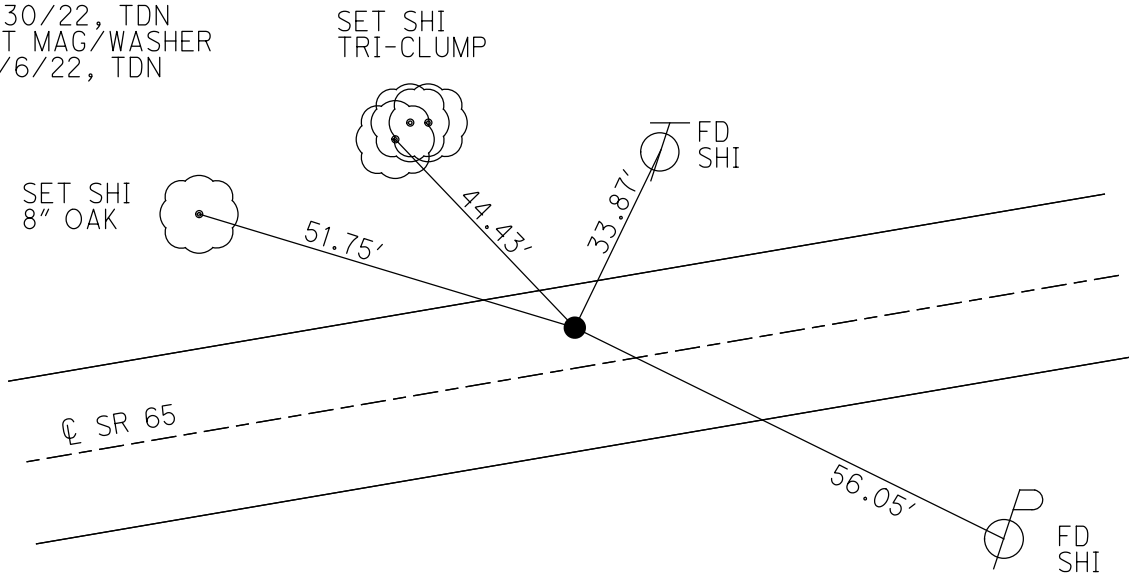

O.D.O.T. DISTRICT 2 SURVEY OFFICE

PERSONNEL

REFERENCE NO. 8-1

SHEET 31 OF 49

NOTES Nuhter

H.C. Homan

R.C. Huss

DATE 6-22-04

WEATHER Sunny

TEMP. +75°F

ROUTE S.R. 65

COUNTY Wood

TOWNSHIP Grand Rapids

SECTION 3

T 5 N R 9 E


TYPE MONUMENT PK/w

~~ON SURFACE~~ ~~BELOW~~ Surface

~~LEFT~~ ~~RIGHT~~ 6.3 Lt.

3.8' TO Lt. EDGE PAVEMENT

S.L.M. 207 + 40

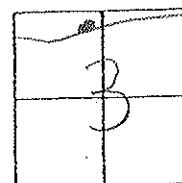

Record: 1923-1924 Plans

P.I. = 106+90

A = 90-33' RT

D = 40-00'


R = 1432.69

T = 119.49

L = 238.75

Ameas 1972 = 90-28'

Set Mag/w
9-16-04
SAH

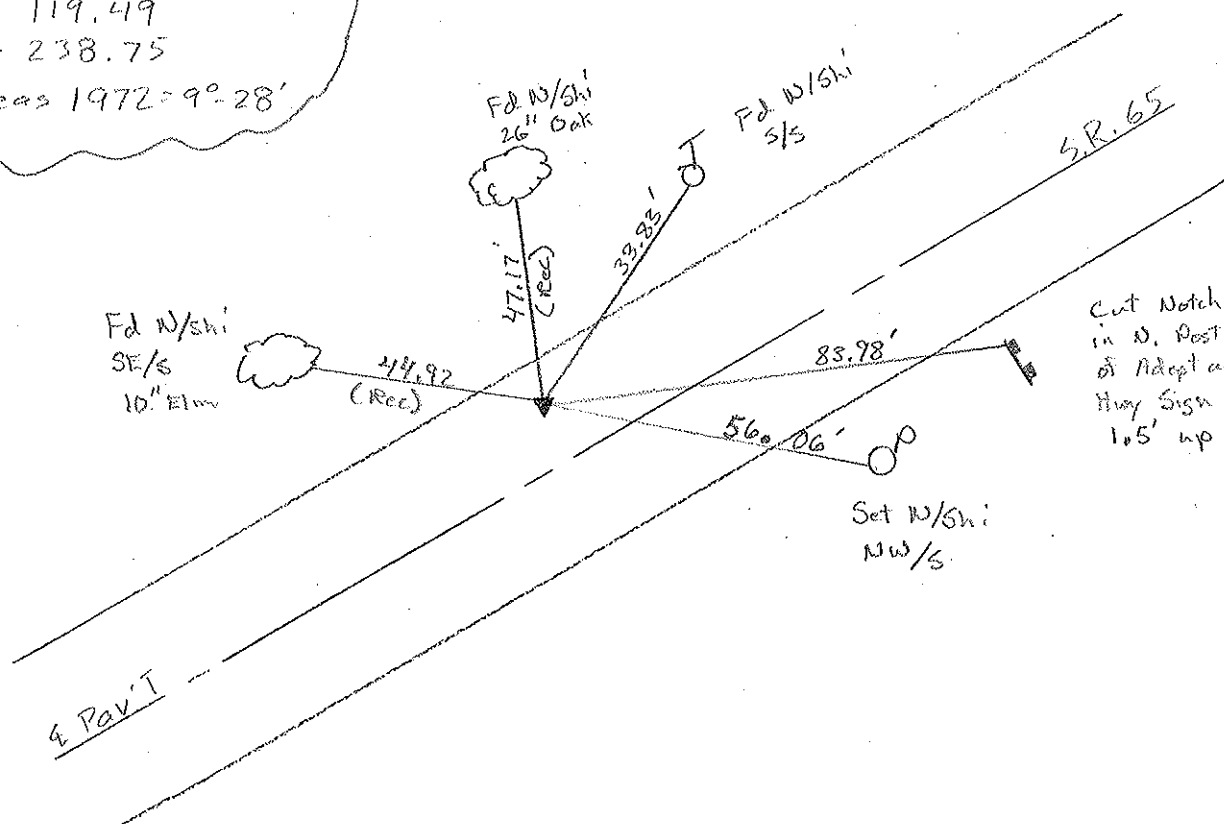

O.D.O.T. DISTRICT 2 SURVEY OFFICE

PERSONNEL

REFERENCE NO. BA

SHEET 16 OF 34

NOTES BARNHISEL

H.C. VAN DUSEN

R.C. BARNHISEL

DATE 4-20-92

WEATHER SUNNY

TEMP. +75°

ROUTE SR 65

COUNTY WOOD

TOWNSHIP GRAND RAPIDS

SECTION 3

T.S. N 9 E

TYPE MONUMENT Sm RR Spk

~~ON SURFACE~~ - BELOW 1 1/2"


LEFT- C PAV'T. - ~~RIGHT~~ 6.3

3.3 TO LT. EDGE PAVEMENT

S.L.M. 207+41

Set Pk. / WASHER

5-4-92
C.L.

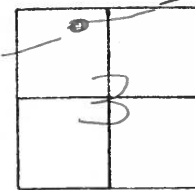

RECORD: 1923-1924 PLANS

P.I. 106+90

$\Delta = 9^{\circ}-33' RT.$


$D = 4^{\circ}-00'$

$R = 1432.69$

$T = 119.49$

$L = 238.75$

Δ MEAS. 1972 = $9^{\circ}-28'$

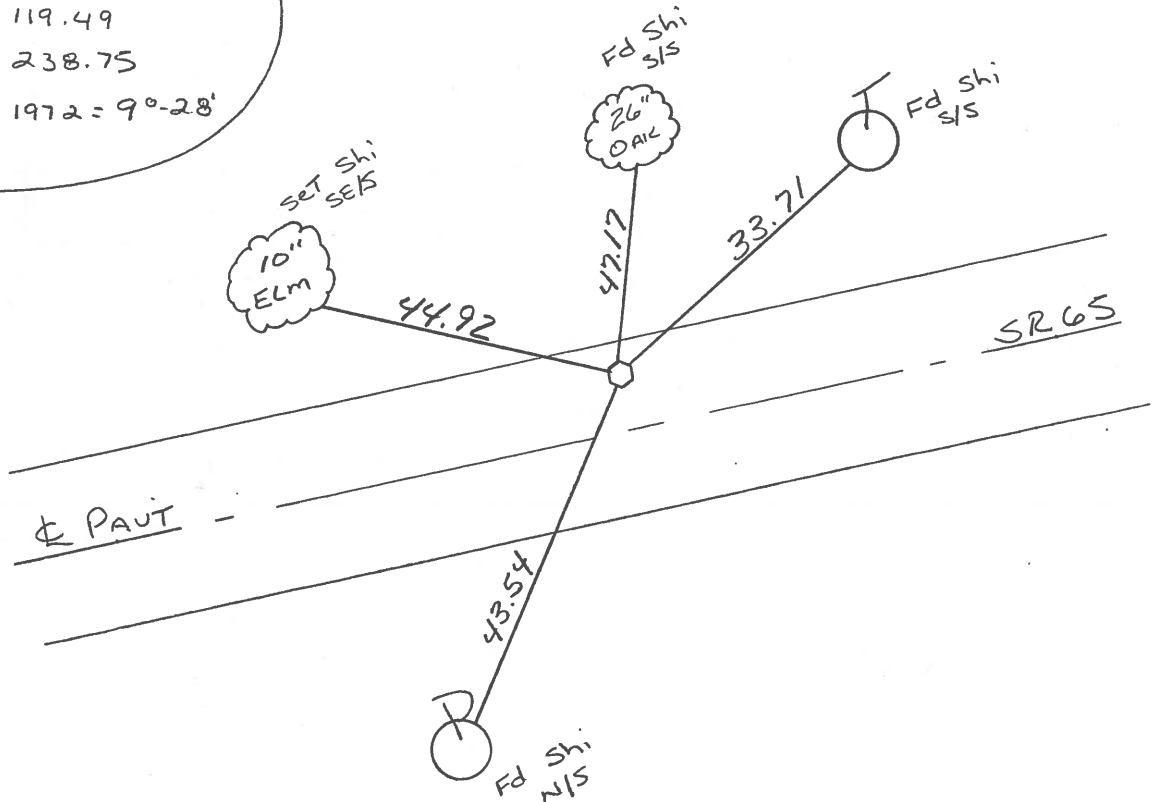

ODOT. DISTRICT 2 SURVEY OFFICE

SHEET 24 OF

County Wood S.R. 65

Township Grand Rapids

Section 3

Q1N, R9E


Personnel Hoffman
Loehrke
Householder

8-A


Date 6-9-82
12-11-81

Weather clear

Temp. 30°

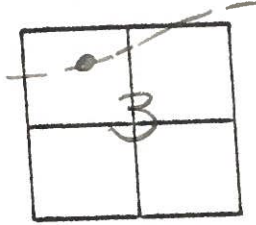

Fd. P.K. Nail @ surface (over small R.R. spk?) Project Sta ± 207+54
 5.6' Lt. of k PAUT
 3.8' To N.E.P.
 14.5' To S.E.P.
 $\Delta = 90-28'$ (MEAS. 1972)

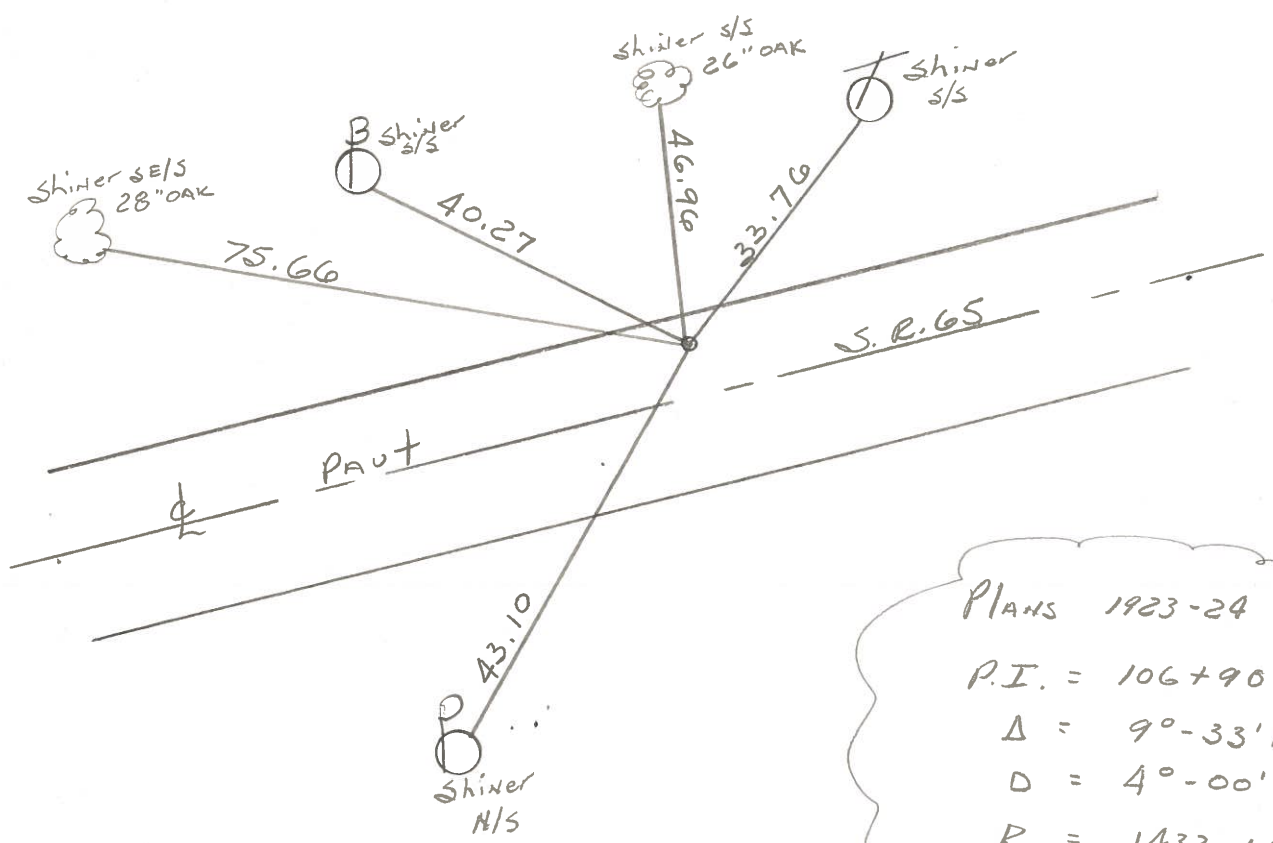


PLANS 1923-24
 P.I. = 106+90
 $\Delta = 90-33'$ RT.
 $D = 40-00'$
 $R = 1432.69$
 $T = 119.49$
 $L = 238.75$

PERSONNEL TITLE PERSONNEL TITLE
 BURNSIDE _____
 SMITH _____
 BOWERS _____

COUNTY WOOD DATE 10-12-72
 S. R. 65 WEATHER CLOUDY
 SEC. GRAND RAPIDS TWP TEMP. +60°

DESCRIPTION ESTABLISH & REFERENCE P.I.'S JOB NO. _____

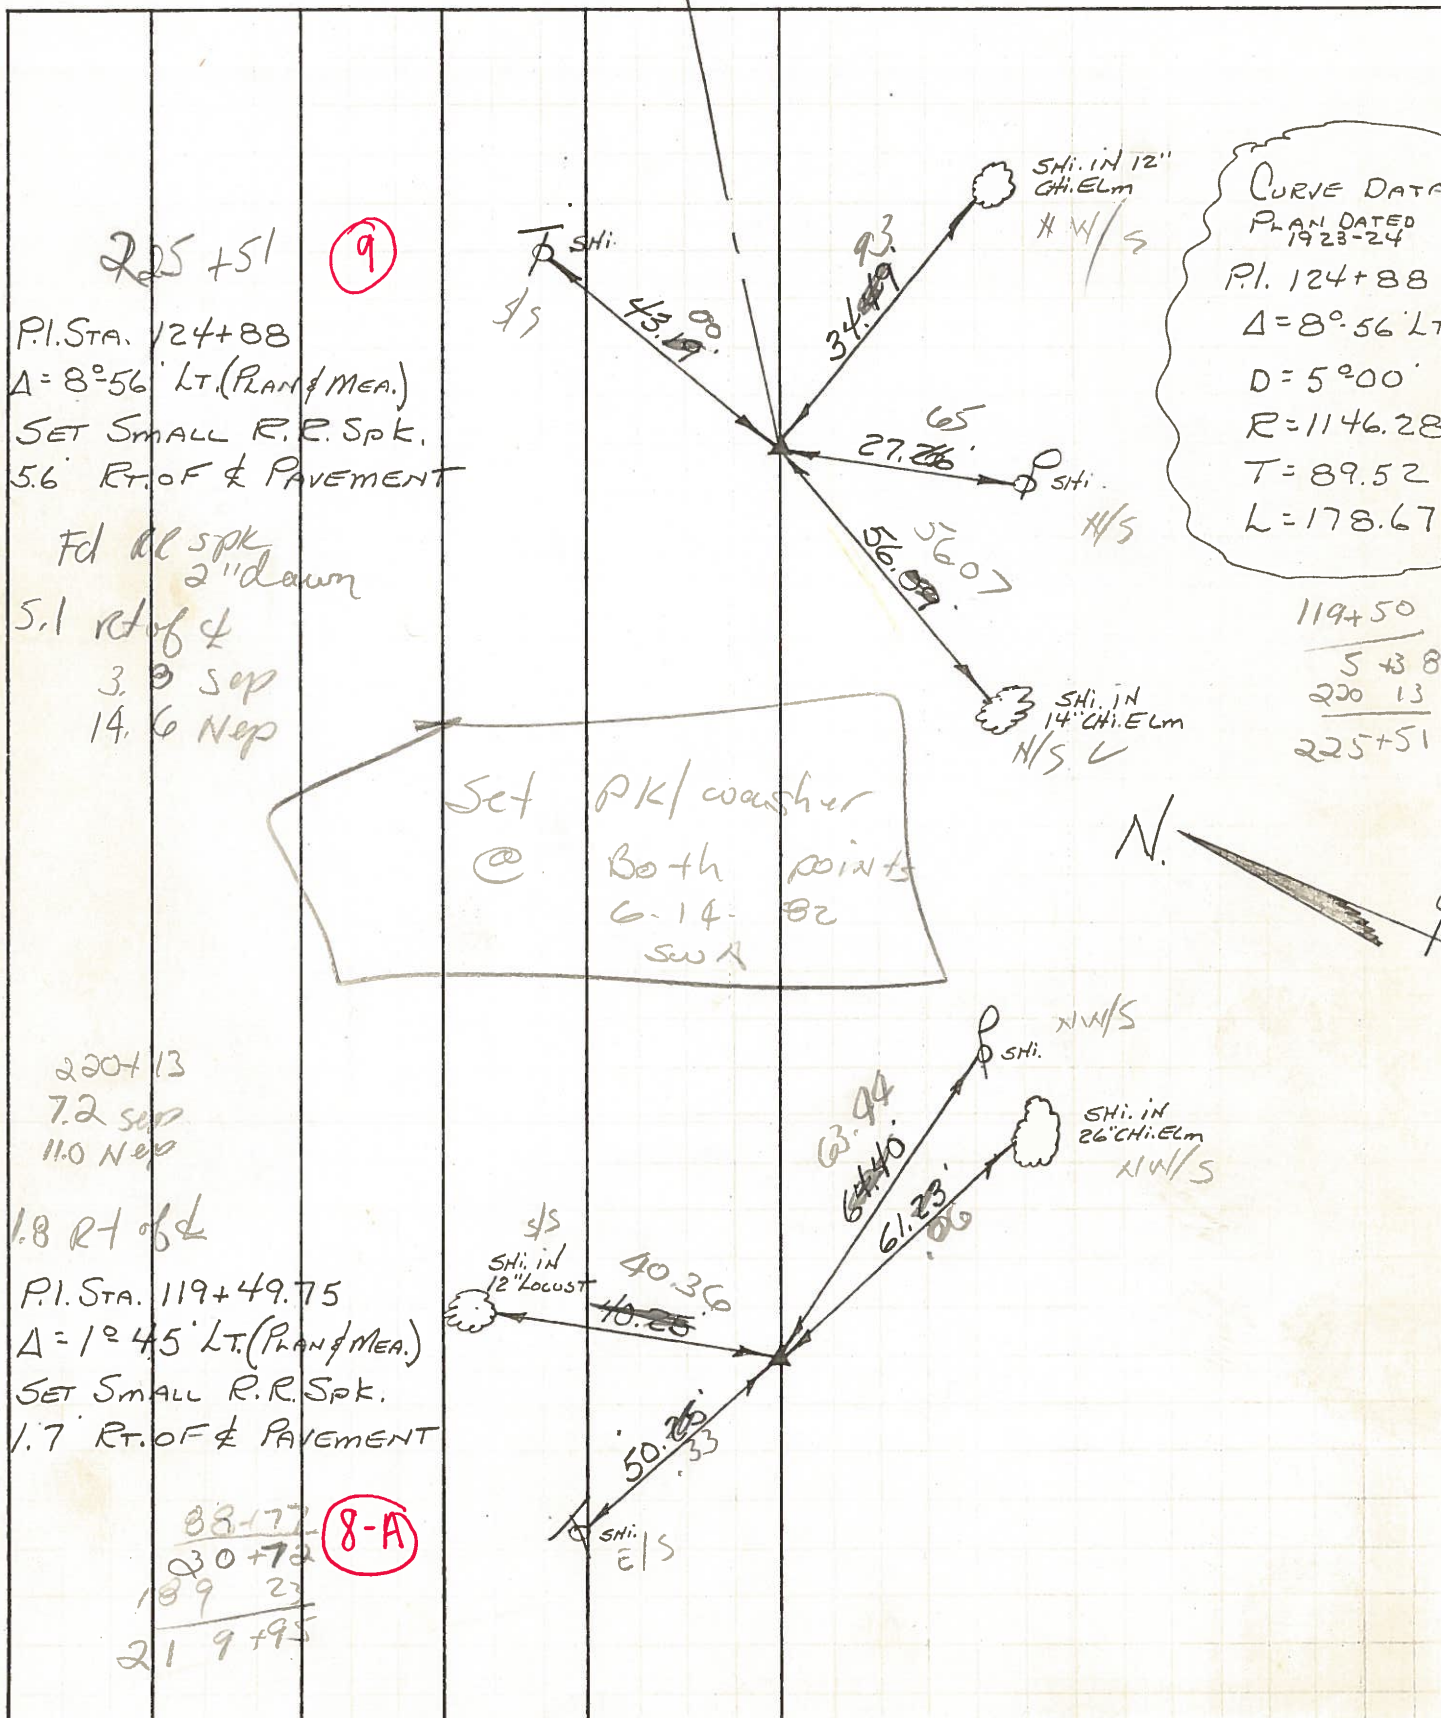


225+51 (9)
 P.I. STA. 124+88
 $\Delta = 8^{\circ}56'$ LT. (PLAN & MEAS.)
 SET SMALL R.R. SPK.
 5.6 RT. OF & PAVEMENT
 Fd R.R. SPK
 2" down
 5.1 rt of &
 3.9 sop
 14.6 Nep

200+13
 7.2 sop
 11.0 Nep
 1.8 RT of &
 P.I. STA. 119+49.75
 $\Delta = 1^{\circ}45'$ LT. (PLAN & MEAS.)
 SET SMALL R.R. SPK.
 1.7 RT. OF & PAVEMENT

88+72
 30+72
 189 22
 219+95 (8-A)

CURVE DATA
 PLAN DATED 1923-24
 P.I. 124+88
 $\Delta = 8^{\circ}56'$ LT
 $D = 5^{\circ}00'$
 $R = 1146.28$
 $T = 89.52$
 $L = 178.67$
 119+50
 5+38
 200+13
 225+51

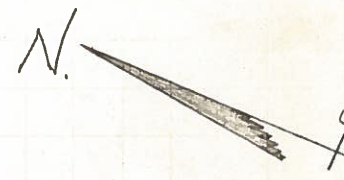

PERSONNEL TITLE PERSONNEL TITLE
 BURHSIDE _____
 SMITH _____
 BOWERS _____

COUNTY Wood DATE 10-12-72
 S. R. 65 WEATHER Cloudy
 SEC. GRAND RAPIDS Twp TEMP. +60°

DESCRIPTION ESTABLISH & REFERENCE P.I.'S JOB NO. _____

