

O.D.O.T. DISTRICT 2 SURVEY OFFICE (USE ONLY)

PERSONNEL \_\_\_\_\_ REFERENCE NO. 8 B SHEET 2 OF 22  
 NOTES RHOADES DATE 4/11/22 ROUTE SR 65  
 H.C. NIESE WEATHER RAIN COUNTY WOOD  
 R.C. KETNER TEMP. 63° TOWNSHIP GRAND RAPIDS  
O'DONNELL SECTION 3  
 DWG BY RHOADES PID 95796 T 5 N R 9 E

TYPE MONUMENT P.K.SHANK

~~ON SURFACE~~ - BELOW 1"

OFFSET 0.9' LT : RT

8.7' TO RT EDGE PAVEMENT


STATION: 212+11.49

HORZ.DATUM: NAD83 2011


GEOID: NAVD88 2018

GRID: NORTHING: 644806.600

EASTING: 1607774.524

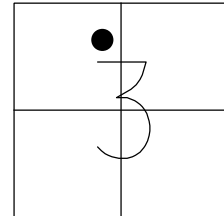

RECORD: P.I.  
 1923-1924 PLANS  
 STA. 111+60.8  
 $\Delta = 1^\circ 01' \text{ LT}$   
 FD P.K./WASHER  
 6/23/04, DCH  
 SET P.K./WASHER  
 9/17/04, RGN  
 FD P.K.SHANK  
 1" DOWN  
 ( REFAC8 )  
 4/11/22, TDN  
 SET MAG/WASHER  
 10/6/22, TDN

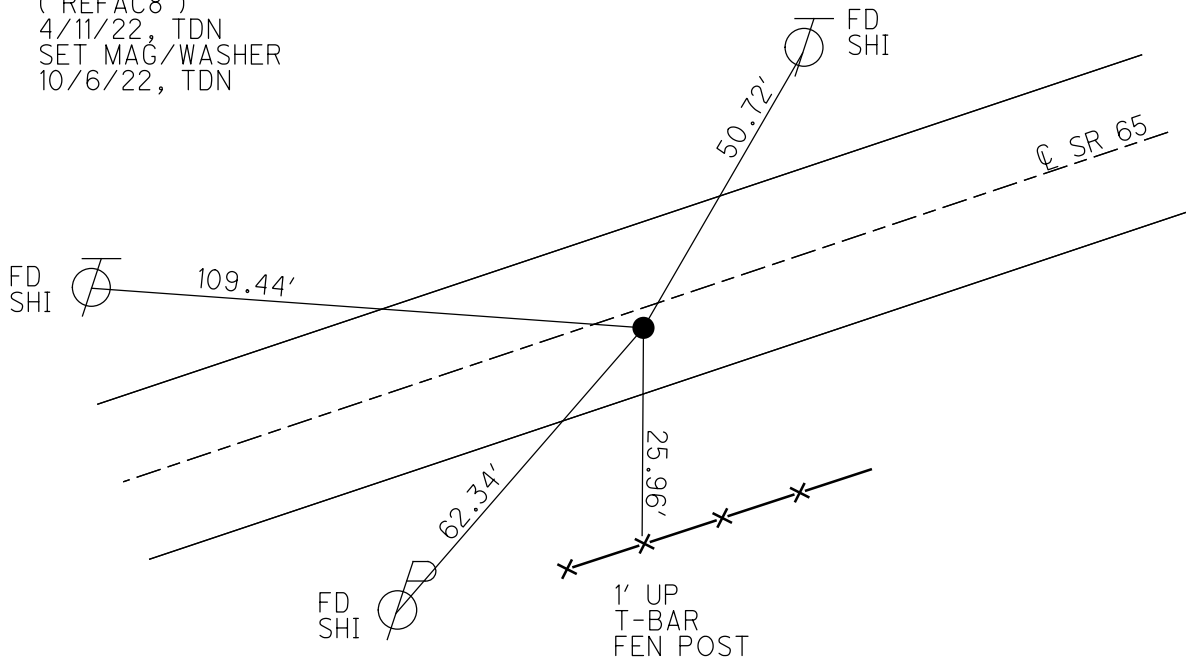

# O.D.O.T. DISTRICT 2 SURVEY OFFICE

PERSONNEL

REFERENCE NO. 813

SHEET 32 OF 49

NOTES Nuhter

H.C. Homan

R.C. Adkins

DATE 6-23-04

WEATHER Sunny

TEMP. +70° F

ROUTE S.R. 65

COUNTY Wood

TOWNSHIP Grand Rapids

SECTION 3

T 5 N R 9 E


TYPE MONUMENT PK/W

ON SURFACE - ~~BELOW~~ surface

~~LEFT & PAV'T.~~ RIGHT 0.9' Rt.

8.7' TO Rt. EDGE PAVEMENT

S.L.M. 212 +13

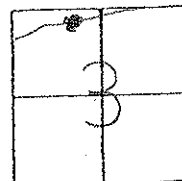


Record Plans 1923-1924

P.I. = 111460.8

$\Delta = 1^{\circ}01' LT$

$\Delta$  meas 1972 =  $1^{\circ}01'$

Set PK/W  
9-17-04  
RGN

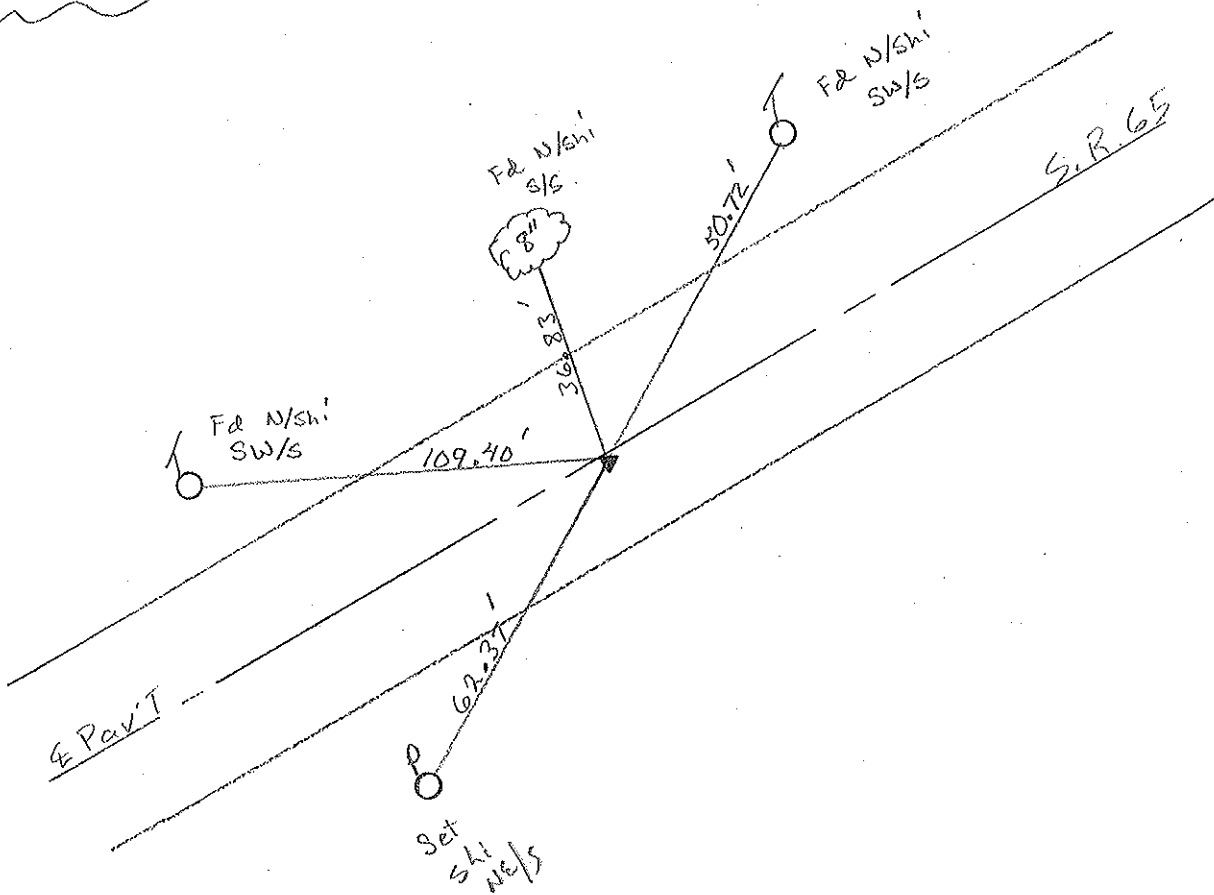

# O.D.O.T. DISTRICT 2 SURVEY OFFICE

PERSONNEL

REFERENCE NO. 8 B

SHEET 17 OF 34

NOTES BARNHISEL

H.C. VAN PUSEN

R.C. BARNHISEL

DATE 4-20-92

WEATHER SUNNY

TEMP. +75°

ROUTE SR 65

COUNTY WOOD

TOWNSHIP GRAND RAPIDS

SECTION 3

T 5 N R 9 E


TYPE MONUMENT P.K. E WASHER

ON SURFACE - ~~BELOW~~ YES

~~LEFT~~ - E PAVT. - RIGHT 0.6

0.9 TO RT EDGE PAVEMENT

S.L.M. 212+11

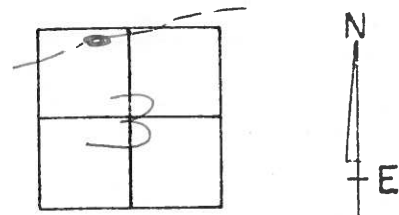


RECORD: PLANS 1923-1924

P.I. STA 111+60.8

$\Delta = 1^{\circ}-01'LT$

$\Delta$  MEAS. 1972 =  $1^{\circ}-01'$

SET PK E WASHER  
5-1-92  
MB

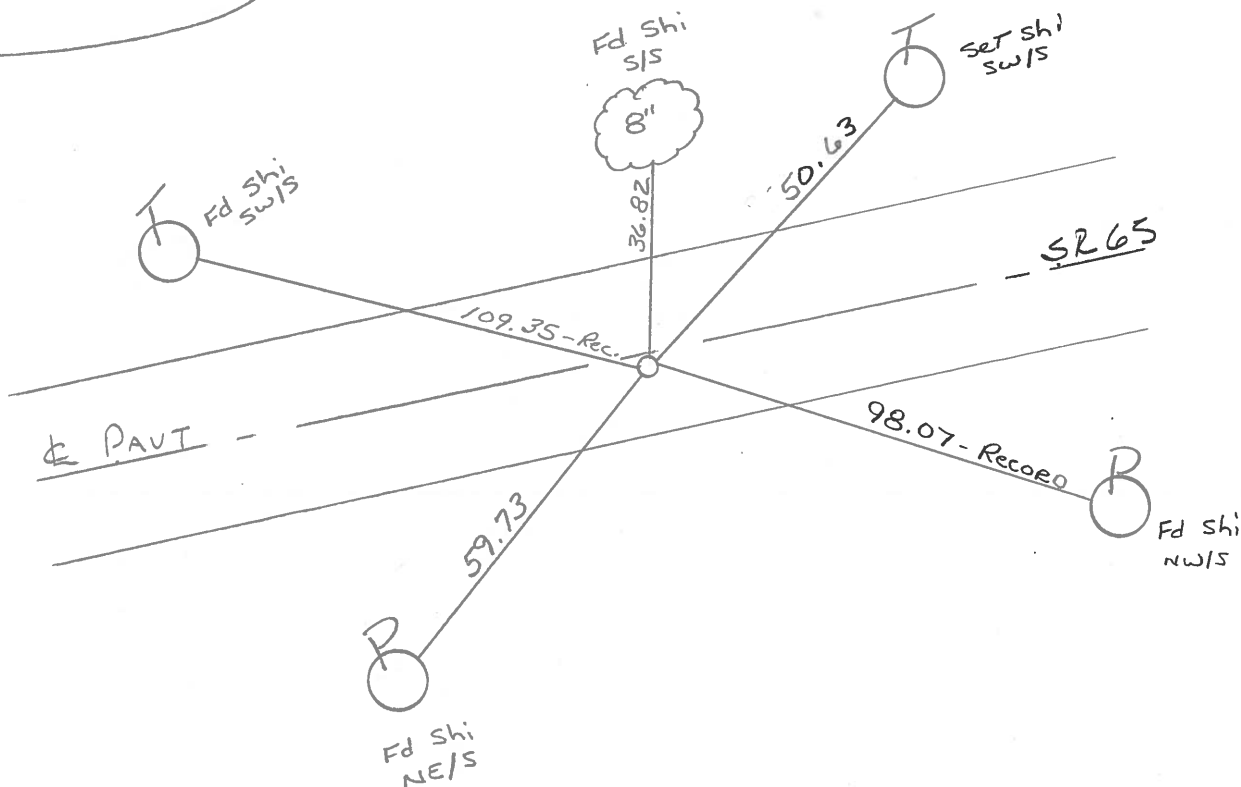

OD.O.T. DISTRICT 2 SURVEY OFFICE

SHEET 25 OF       

County Wood S.R. 65

Date 6-9-82  
12-11-81

Township Grand Rapids

Weather clear

Section 3

Temp. +30°


Q5N, R9E

Personnel Hoffman

Loehke

Householder

8-B

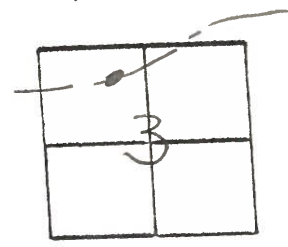

Fd small R.R. SPK @ surface  
 0.6' Rt. of & PAUT.  
 8.2' S. EP.  
 10.3' N. EP.  
 $\Delta = 1^\circ - 01' \text{ Lt. } = \text{PLAN}$   
 - MEAS 1972  
 P.I. STA. 111+60.8

Project STA  $\pm$  212+24

