

O.D.O.T. DISTRICT 2 SURVEY OFFICE (USE ONLY)

PERSONNEL

REFERENCE NO. 9

SHEET 4 OF 22

NOTES RHOADES

DATE 3/30/22

ROUTE SR 65

H.C. NIESE

WEATHER WINDY

COUNTY WOOD

R.C. KETNER

TEMP. 64°

TOWNSHIP GRAND RAPIDS

AUBLE

SECTION 3

DWG BY RHOADES

PID 95796

T 5 N R 9 E

TYPE MONUMENT MAG/WASHER

ON SURFACE - ~~BELOW~~ ON

OFFSET Q PAVEMENT 5.6' ~~±~~ : RT

4.1' TO RT EDGE PAVEMENT


STATION: 225+38.40

HORIZ.DATUM: NAD83 2011


GEOID: NAVD88 2018

GRID: NORTHING: 645401.648

EASTING: 1608960.267

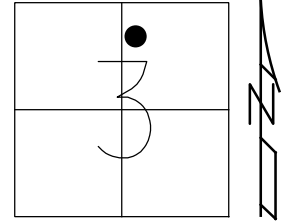

RECORD: P.I.
 1923-1924 PLANS
 STA. 124+88
 $\Delta = 8^{\circ} 56' \text{ LT}$
 $D = 5^{\circ} 00'$
 $R = 1146.28$
 $T = 89.52$
 $L = 178.67$
 FD P.K./WASHER
 6/23/04, DCH
 SET MAG/WASHER
 9/17/04, RGN
 FD MAG/WASHER
 4/20/15, EBW
 FD MAG/WASHER
 REF9
 11/3/20, JFO
 SET MAG/WASHER
 10/6/22, TDN

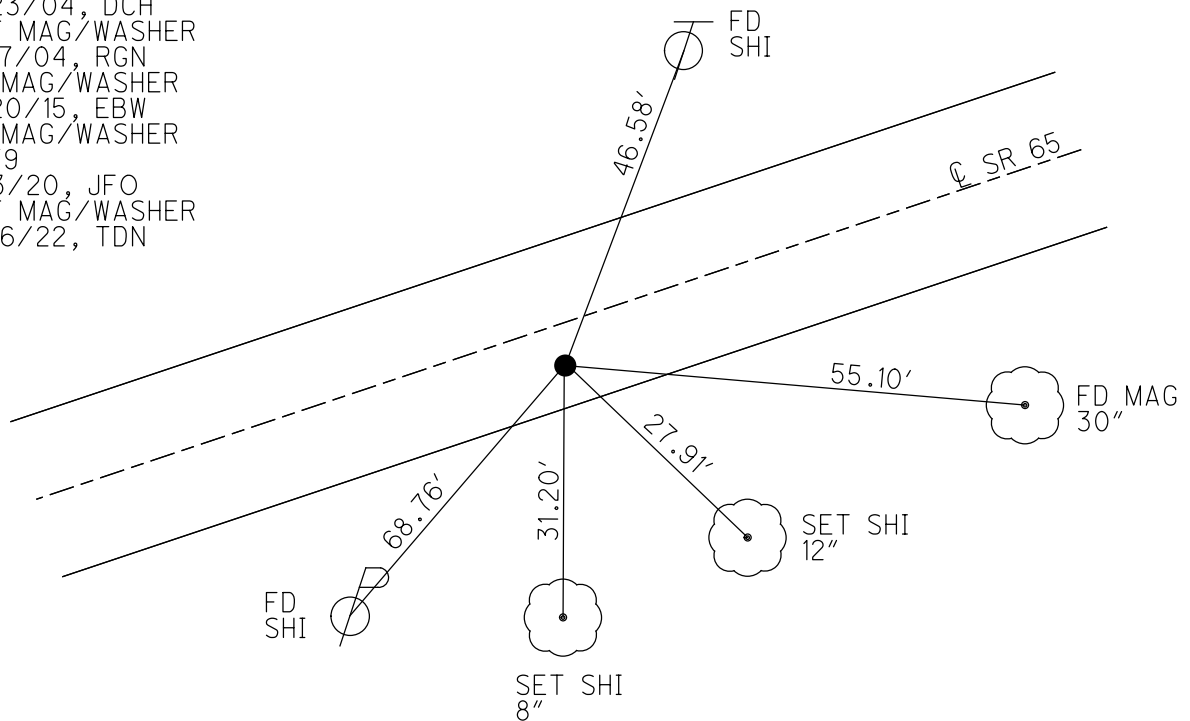

O.D.O.T. DISTRICT 2 SURVEY OFFICE (USE ONLY)

PERSONNEL _____ REFERENCE NO. 9 SHEET 2 OF 6

NOTES RHOADES DATE 4/20/15 ROUTE SR 65
 H.C. WESTFALL WEATHER WINDY COUNTY WOOD
 R.C. O'DONNELL TEMP. 55° TOWNSHIP GRAND RAPIDS
 _____ SECTION 3
 _____ T 5 N R 9 E

TYPE MONUMENT MAG/WASHER


ON SURFACE - ~~BELOW~~ ON _____

~~LEFT~~ - ℄ PAV'T - RIGHT 5.6'


4.1' TO RT EDGE PAVEMENT

S.L.M. 225+60.59

Grid: Northing: _____ Easting: _____

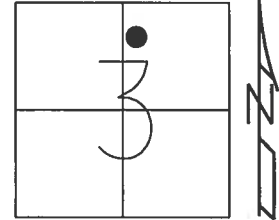

RECORD: P.I.
 1923-1924 PLANS
 STA. 124+88
 $\Delta = 8^\circ 56' \text{ LT}$
 $D = 5^\circ 00'$
 $R = 1146.28$
 $T = 89.52$
 $L = 178.67$
 FD P.K./WASHER
 6/23/04, DCH
 SET MAG/WASHER
 9/17/04, RGN
 FD MAG/WASHER
 4/20/15, EBW

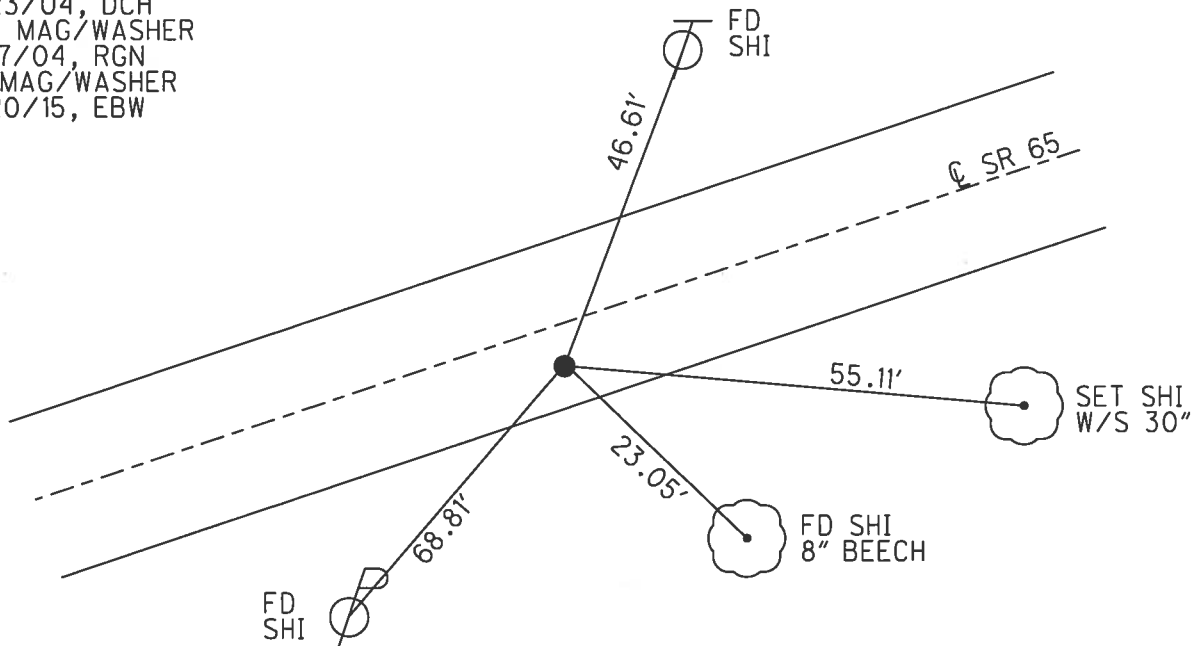

O.D.O.T. DISTRICT 2 SURVEY OFFICE

PERSONNEL _____

REFERENCE NO. 9

SHEET 34 OF 49

NOTES Nuhfer

H.C. Homan

R.C. Adkins

DATE 6-23-04

WEATHER Sunny

TEMP. + 70°F

ROUTE S.R. 65

COUNTY Wood

TOWNSHIP Grand Rapids

SECTION 3

T. 5 N. R. 9 E.


TYPE MONUMENT PK/w

ON SURFACE - ~~BELOW~~ surface

~~NEAR/IN/PAV'T~~ RIGHT 5.6' Rt.

4.1' TO Rt. EDGE PAVEMENT

S.L.M. 225 + 39

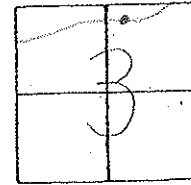

Records: 1923-1924 Plans

P.I. 124+88

$\Delta = 8^{\circ} - 56' LT$

D = 5'-00'

R = 1146.28


T = 89.52

L = 178.67

Set Mag/W

9-17-04

RGN

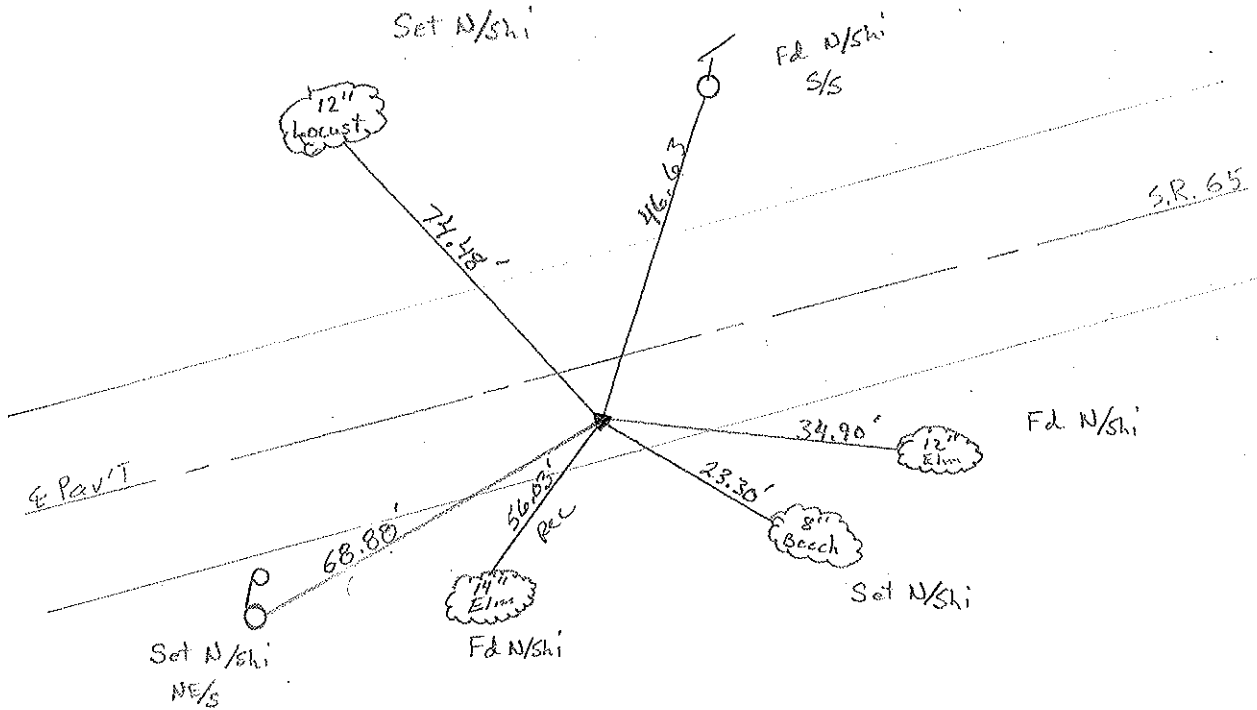

O.D.O.T. DISTRICT 2 SURVEY OFFICE

PERSONNEL

REFERENCE NO. 9

SHEET 19 OF 34

NOTES BARNHISEL

H.C. VAN DUSEN

R.C. BARNHISEL

DATE 4-20-92

WEATHER SUNNY

TEMP. +75°

ROUTE SR 65

COUNTY WOOD

TOWNSHIP GRAND RAPIDS

SECTION 3

T 5 N R 9 E


TYPE MONUMENT PK & WASHER

ON SURFACE - ~~BELOW~~ yes

~~LEFT~~ - & PAV'T. - RIGHT 5.5

4.0 TO RT EDGE PAVEMENT

S.L.M. 225+39

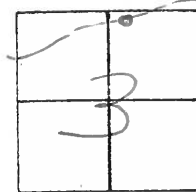

RECORD: 1923-1924 PLANS

P.I. 124+88

$\Delta = 8^{\circ}-56'LT.$


$D = 5^{\circ}-00'$

$R = 1146.28$

$T = 89.52$

$L = 178.67$

Set PK & WASHER
5-1-92
MB

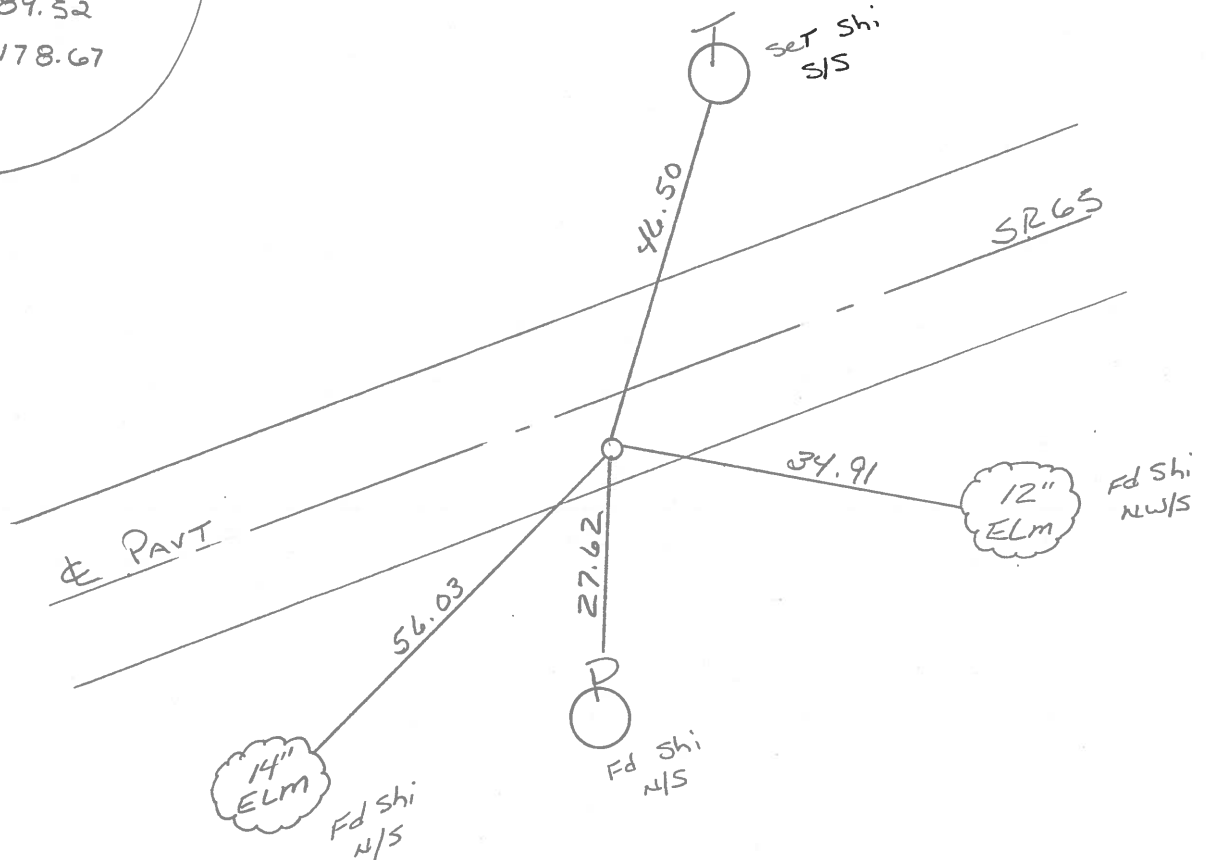

OD.O.T. DISTRICT 2 SURVEY OFFICE

SHEET 27 OF

Date 6-14-82
12-10-81

Weather Clear

Temp. +30°

County Wood S.R. 65

Township Grand Rapids

Section 3


EN, R9E

Personnel Hoffman

Loehke

Householder


9

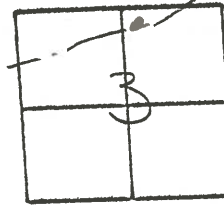

Fd. R.R. SPK 2" Below surface
5.1' rt of & PAUT
3.8' TO S.E.P.
14.6' TO N.E.P.

Project sta ± 225+51


1923-24 PLANS
P.I. 124+88
 $\Delta = 8^{\circ}-56' \text{ Lt.}$
 $D = 50.00'$
 $R = 1146.28$
 $T = 89.52$
 $L = 178.67$

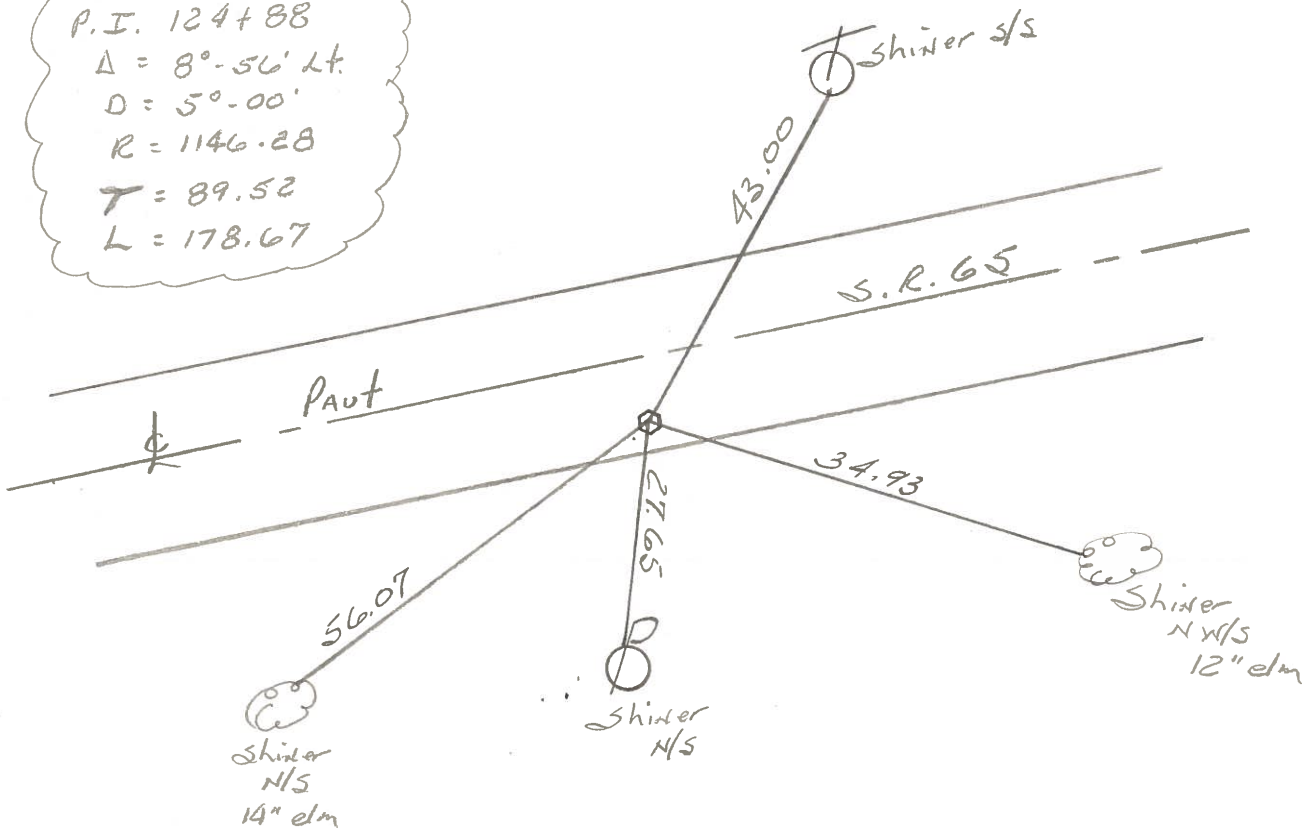

PERSONNEL TITLE PERSONNEL TITLE
 BURNSIDE _____
 SMITH _____
 BOWERS _____

COUNTY WOOD DATE 10-12-72
 S. R. 65 WEATHER CLOUDY
 SEC. GRAND RAPIDS TWP TEMP. +60°


DESCRIPTION ESTABLISH & REFERENCE P.I.'S JOB NO. _____

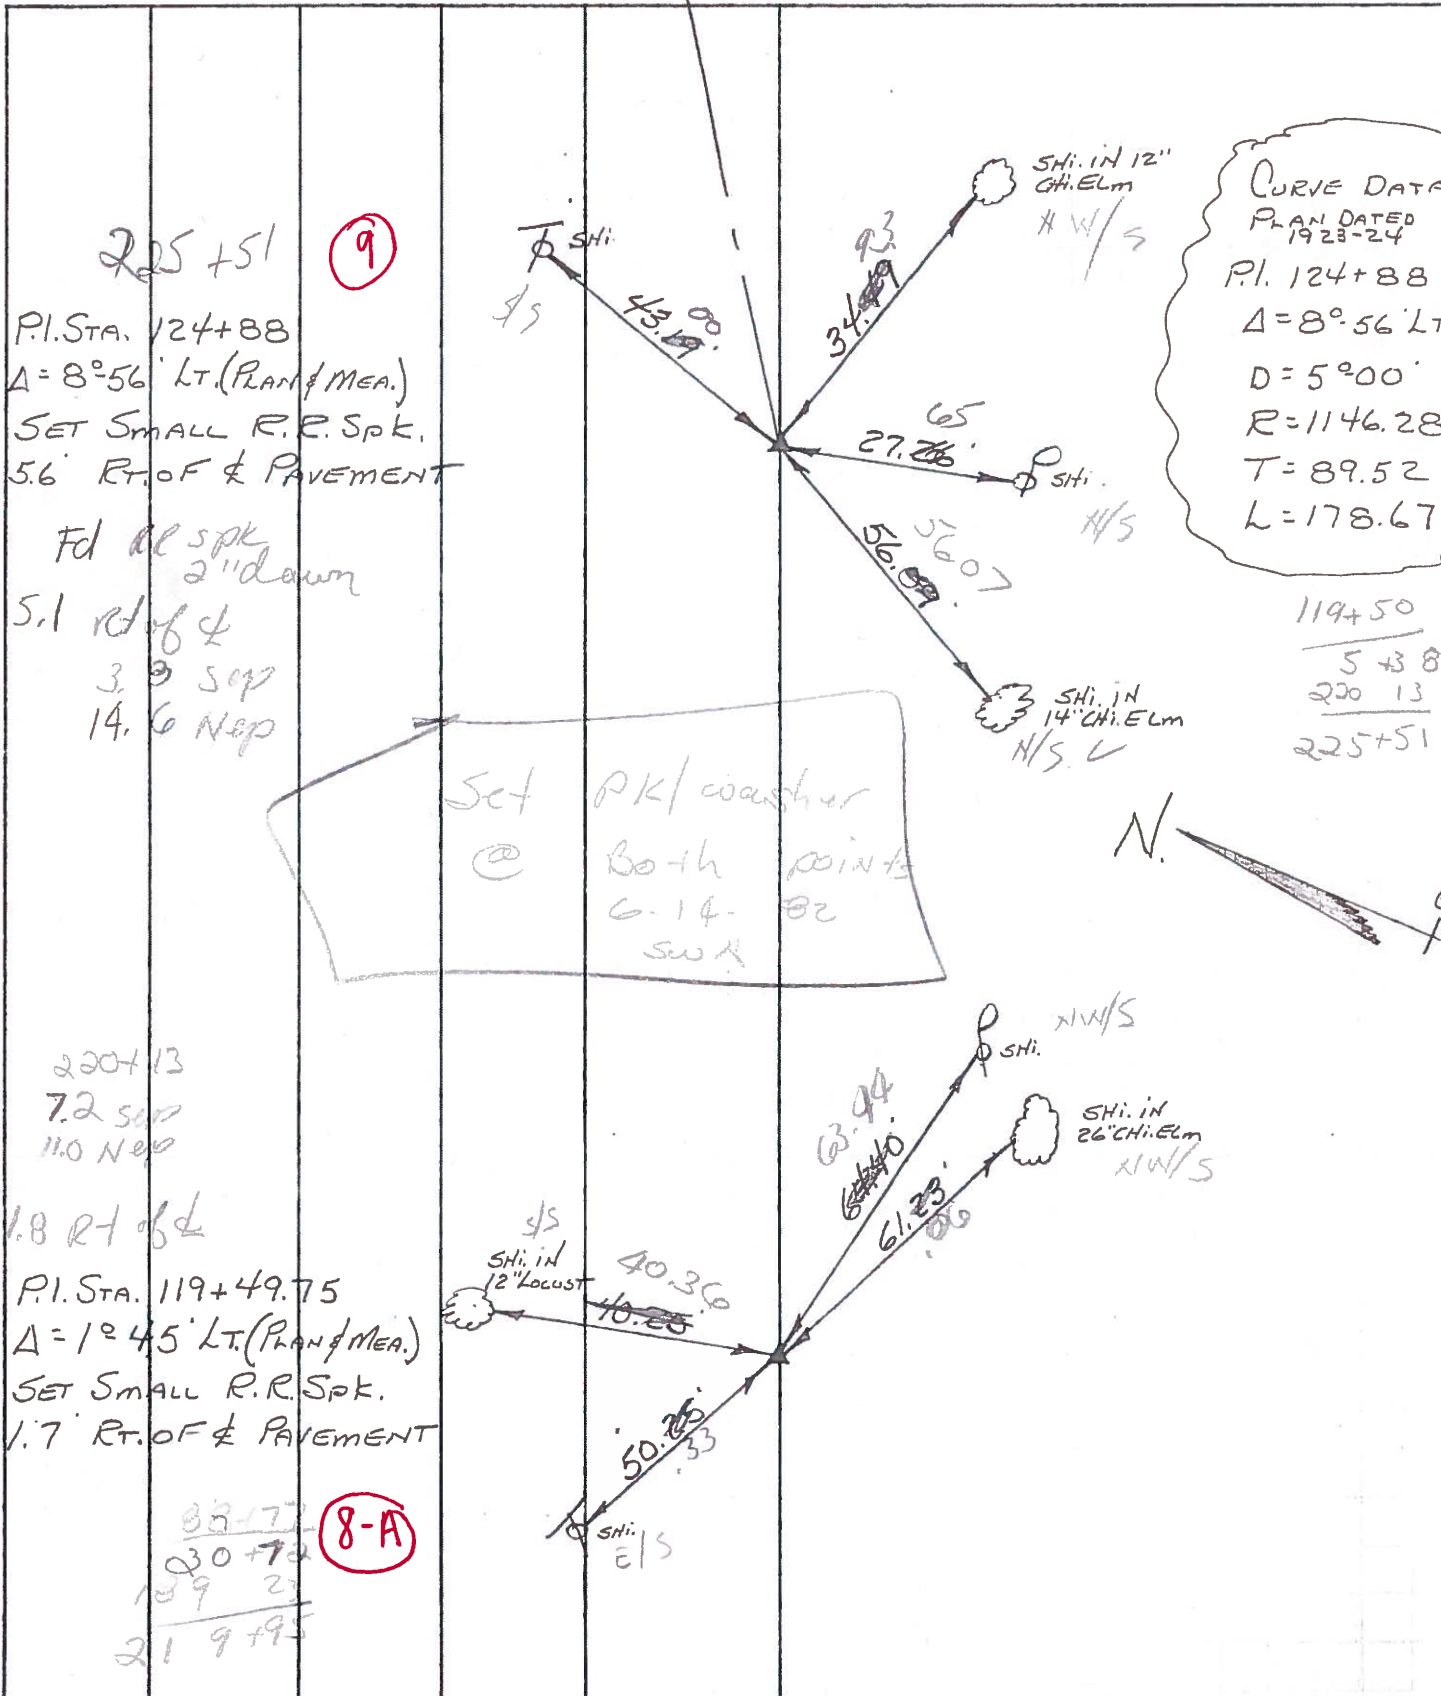

PERSONNEL TITLE PERSONNEL TITLE
 BURNSIDE _____
 SMITH _____
 POWERS _____

COUNTY Wood DATE 10-12-72
 S. R. 65 WEATHER Cloudy
 SEC. GRAND RAPIDS TWP TEMP. +60°

DESCRIPTION ESTABLISH & REFERENCE P.I.'S JOB NO. _____

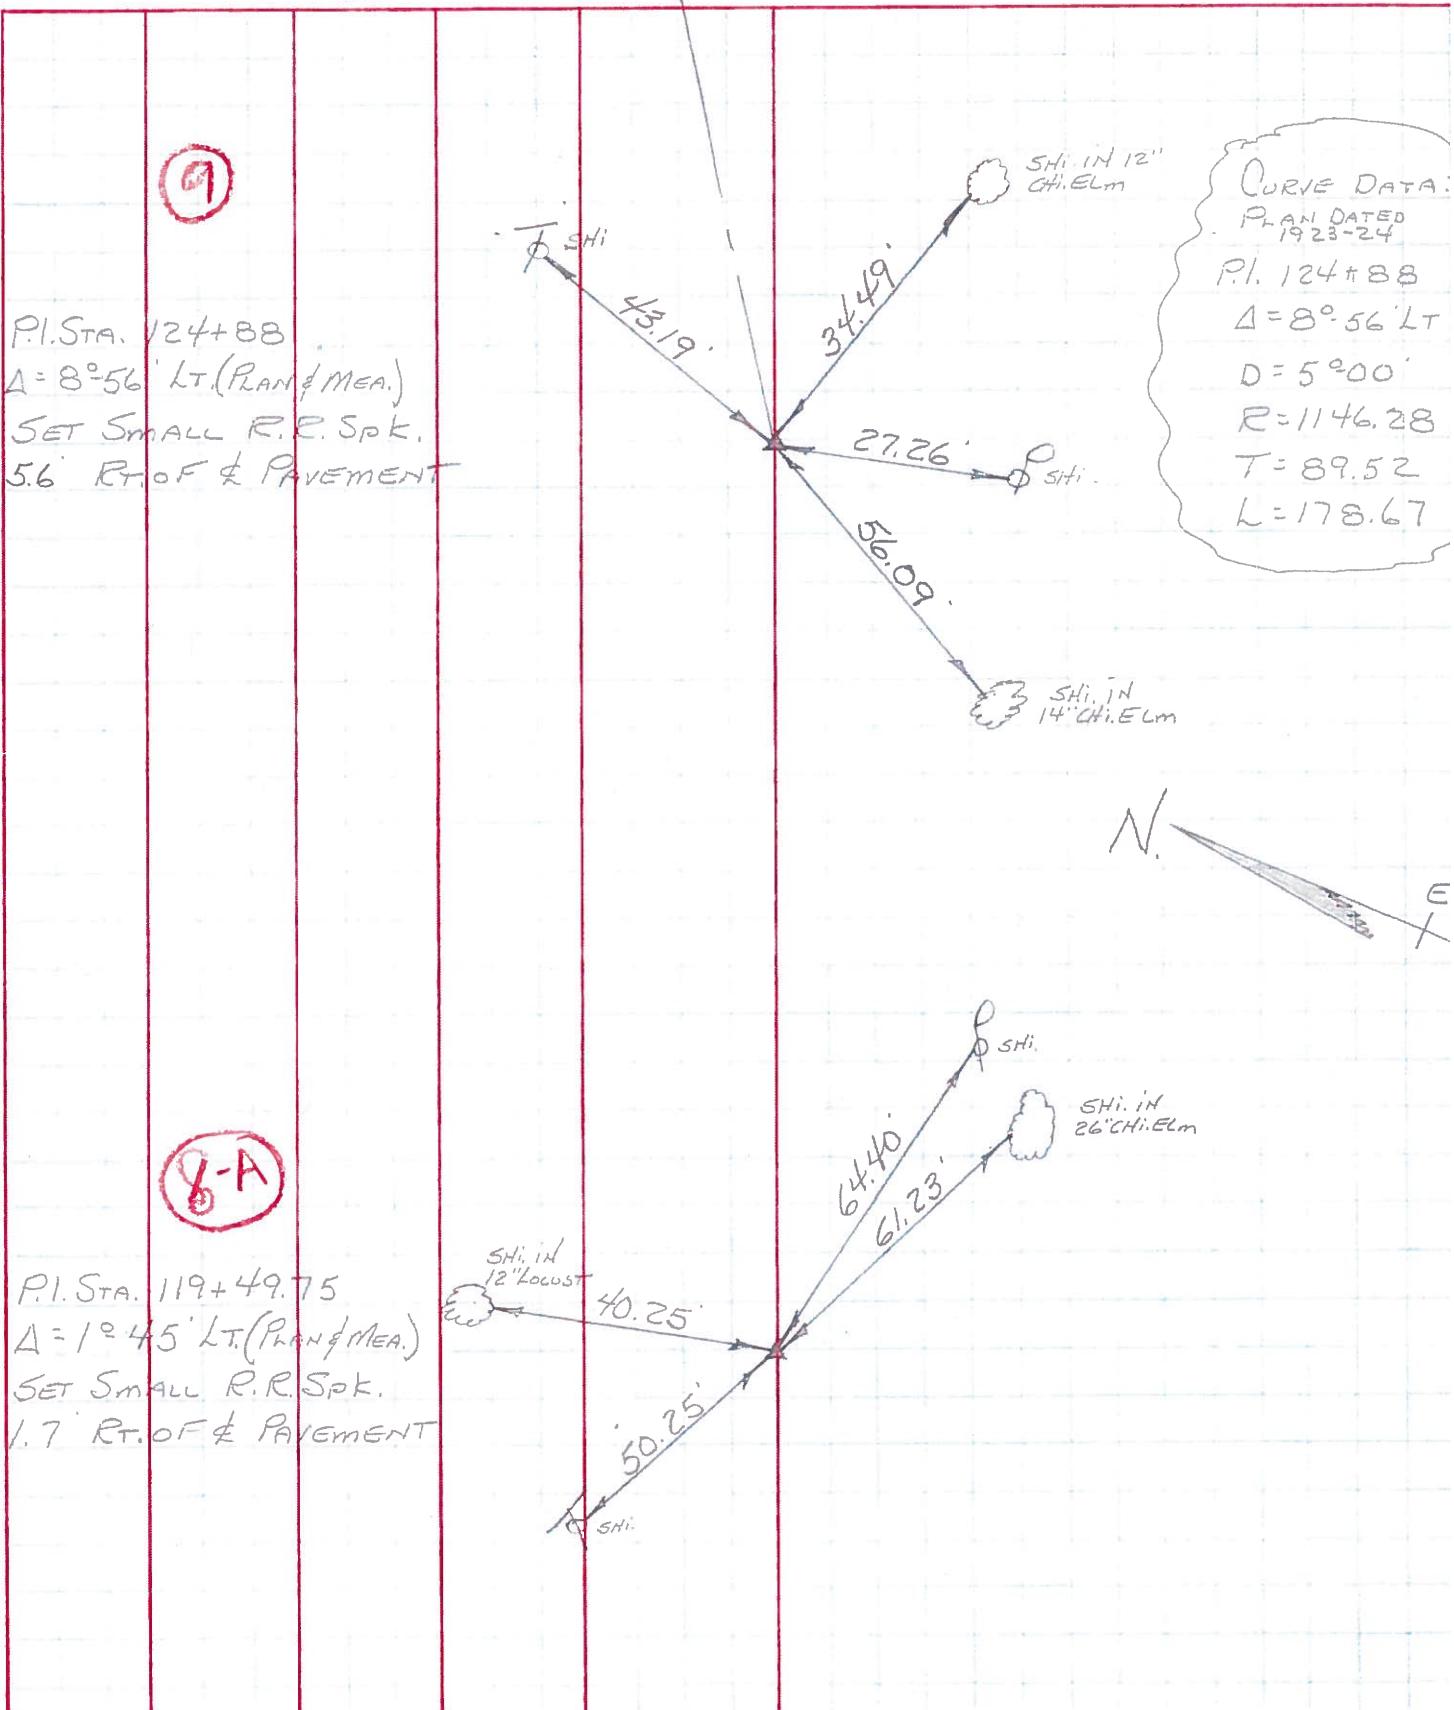

9
 P.I. STA. 124+88
 Δ = 8°56' LT. (PLAN & MEA.)
 SET SMALL R.R. Spk.
 5.6 RT. OF & PAVEMENT

8-A
 P.I. STA. 119+49.75
 Δ = 1°45' LT. (PLAN & MEA.)
 SET SMALL R.R. Spk.
 1.7 RT. OF & PAVEMENT

CURVE DATA:
 PLAN DATED 1923-24
 P.I. 124+88
 Δ = 8°56' LT
 D = 5°00'
 R = 1146.28
 T = 89.52
 L = 178.67

