

O.D.O.T. DISTRICT 2 SURVEY OFFICE (USE ONLY)

PERSONNEL

REFERENCE NO. 9 A

SHEET 5 OF 22

NOTES RHOADES

DATE 4/11/22

ROUTE SR 65

H.C. NIESE

WEATHER FAIR

COUNTY WOOD

R.C. KETNER

TEMP. 55°

TOWNSHIP WASHINGTON

O'DONNELL

DWG BY RHOADES

PID 95796

SECTION 34

T 5 N R 9 E

TYPE MONUMENT MAG/WASHER

ON SURFACE - ~~BELOW~~ ON

OFFSET ☉ PAVEMENT 1.2' ± : RT

8.8' TO RT EDGE PAVEMENT


STATION: 231+16.82

HORZ. DATUM: NAD83 2011


GEOID: NAVD88 2018

GRID: NORTHING: 645746.163

EASTING: 1609425.335

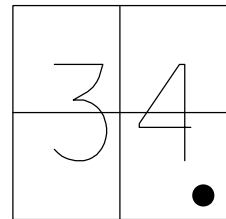


RECORD: P.I.  
 STA. 130+65.5  
 $\Delta = 0^\circ 50'$  LT PLAN  
 $\Delta = 0^\circ 50'$  LT MEASURE  
 FD P.K.SHANK  
 1" BELOW  
 6/23/04, DCH  
 SET MAG/WASHER  
 9/17/04, RGN  
 FD MAG/WASHER  
 4/20/15, EBW  
 SET MAG/WASHER  
 NEWREF A9  
 9/16/15, JFO  
 FD MAG/WASHER  
 NEWREF A9  
 11/3/20, JFO  
 SET MAG/WASHER  
 10/6/22, TDN

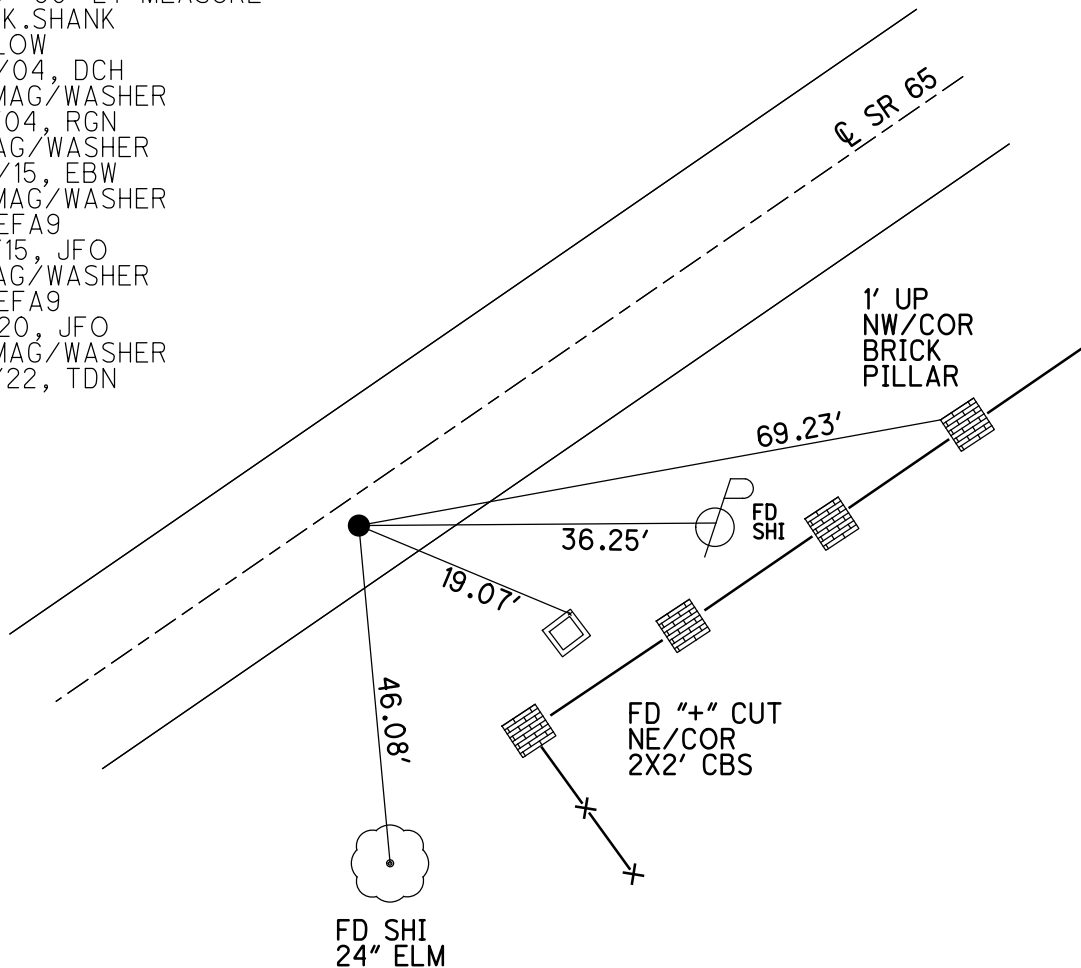

O.D.O.T. DISTRICT 2 SURVEY OFFICE (USE ONLY)


PERSONNEL \_\_\_\_\_ REFERENCE NO. 9 A SHEET 3 OF 6  
 NOTES RHOADES DATE 4/20/15 ROUTE SR 65  
 H.C. WESTFALL WEATHER WINDY COUNTY WOOD  
 R.C. O'DONNELL TEMP. 55° TOWNSHIP WASHINGTON  
 \_\_\_\_\_ SECTION 34  
 \_\_\_\_\_ T 6 N R 9 E

TYPE MONUMENT MAG/WASHER  
 ON SURFACE - ~~BELOW~~ ON \_\_\_\_\_  
~~LEFT~~ - CL PAV'T - RIGHT 1.2'  
8.8' TO RT EDGE PAVEMENT  
 S.L.M. 231+39.10

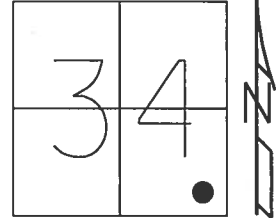

Grid: Northing: 645746.215 Easting: 1609425.359

RECORD: P.I.  
 STA. 130+65.5  
 $\Delta = 0^\circ 50'$  LT PLAN  
 $\Delta = 0^\circ 50'$  LT MEASURE  
 FD P.K.SHANK  
 1" BELOW  
 6/23/04, DCH  
 SET MAG/WASHER  
 9/17/04, RGN  
 FD MAG/WASHER  
 4/20/15, EBW  
 SET MAG/WASHER  
 NEWREF A9  
 9/16/15, JFO

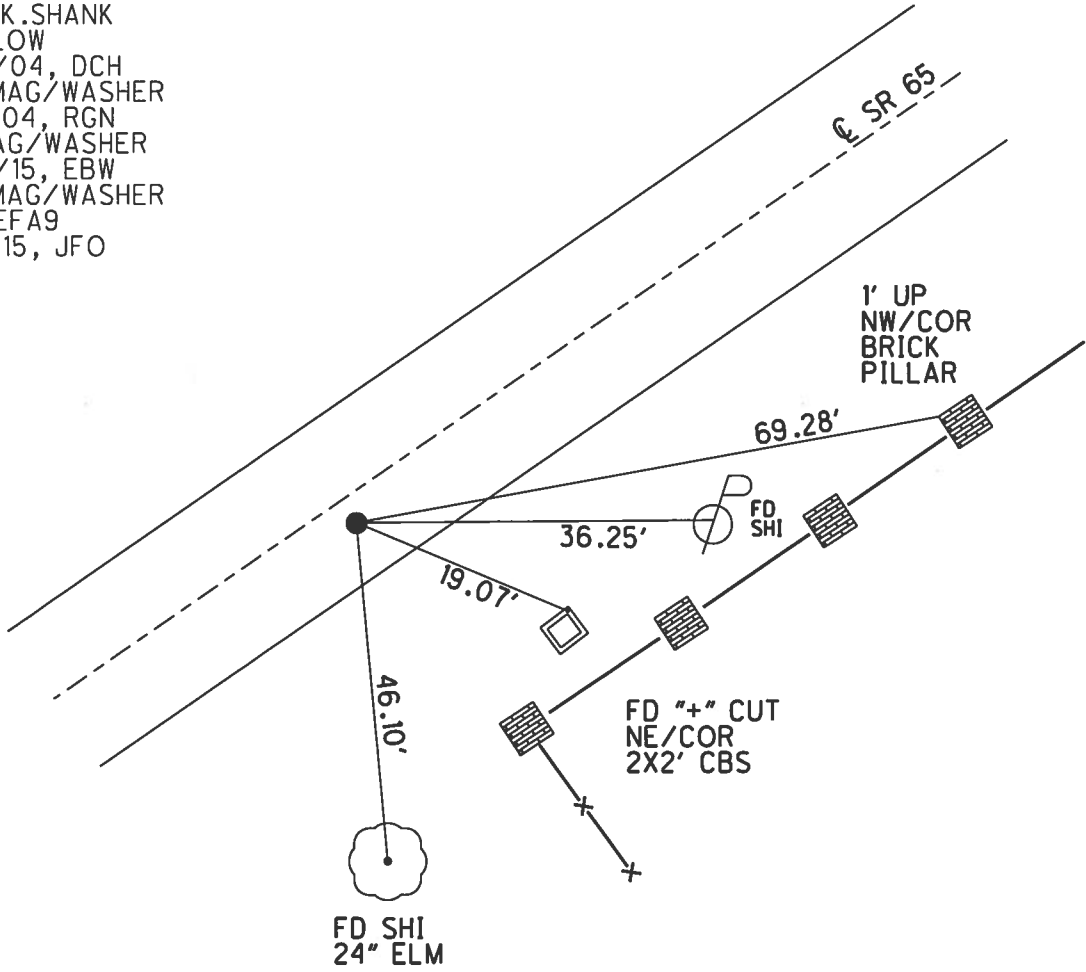

# O.D.O.T. DISTRICT 2 SURVEY OFFICE

PERSONNEL

REFERENCE NO. 94


SHEET 35 OF 49

NOTES Nuhter  
 H.C. Homan  
 R.C. Atkins

DATE 6-23-04  
 WEATHER Sunny  
 TEMP. 70° F


ROUTE S.R. 65  
 COUNTY Wood  
 TOWNSHIP Washington  
 SECTION 34  
 T6 NLR 9 E

TYPE MONUMENT PK "Shank"  
~~ON SURFACE~~ - (BELOW) 1" below  
~~RIGHT~~ - (RIGHT) 1.2' Rt  
8.8' TO Rt. EDGE PAVEMENT  
 S.L.M. 231+17

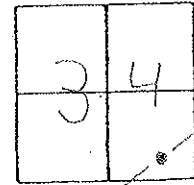

Record:  
 P.I. Sta 130+65.5  
 $\Delta = 0^\circ - 50' \text{ LT Plan}$   
 $\Delta \text{ meas } 1972 = 0^\circ - 50' \text{ Lt}$

Set Mag/W  
 9-17-04  
 RGN

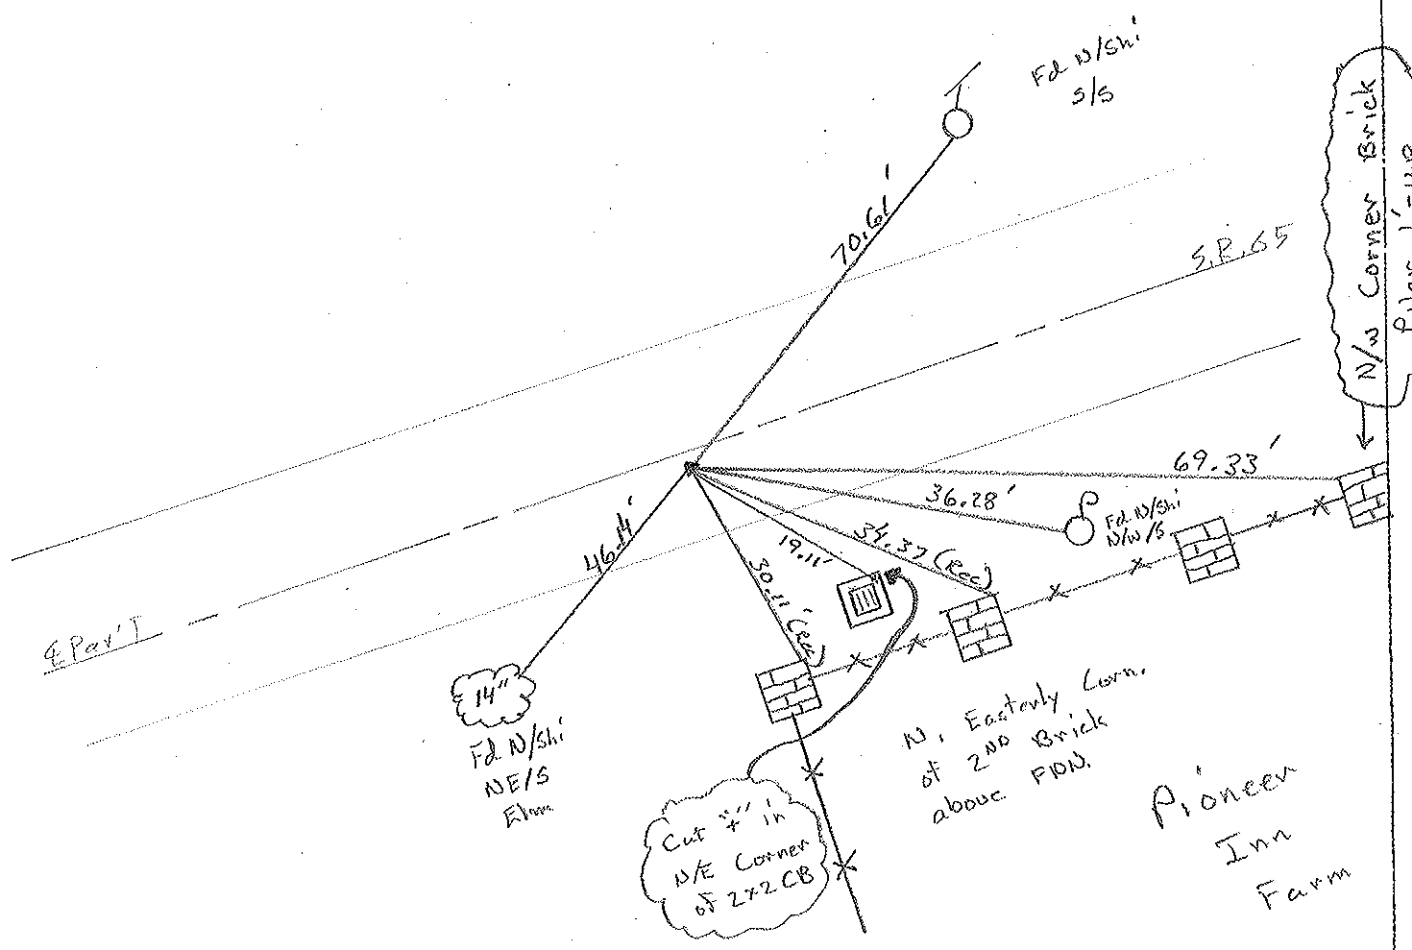

# O.D.O.T. DISTRICT 2 SURVEY OFFICE

PERSONNEL

REFERENCE NO. 9 A

SHEET 20 OF 34

NOTES BARNHISEL

H.C. VAN DUSEN

R.C. BARNHISEL

DATE 4-20-92

WEATHER SUNNY

TEMP. +75°

ROUTE SR 65

COUNTY WOOD

TOWNSHIP WASHINGTON

SECTION 34

T 6 N R 9 E


TYPE MONUMENT PK "Shank"

ON SURFACE - ~~BELOW~~ Yes

~~LEFT - & PAV'T. - RIGHT~~ 0.5

0.9 TO RT EDGE PAVEMENT

S.L.M. 231+17

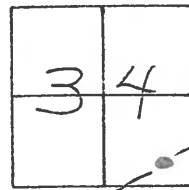


RECORD:

P.I. sta 130+65.5

$\Delta = 0^\circ - 50' \text{ LT PLAN}$

$\Delta \text{ MEAS 1972} = 0^\circ - 50' \text{ LT}$

Set PK & WASHER  
5-1-92  
MB

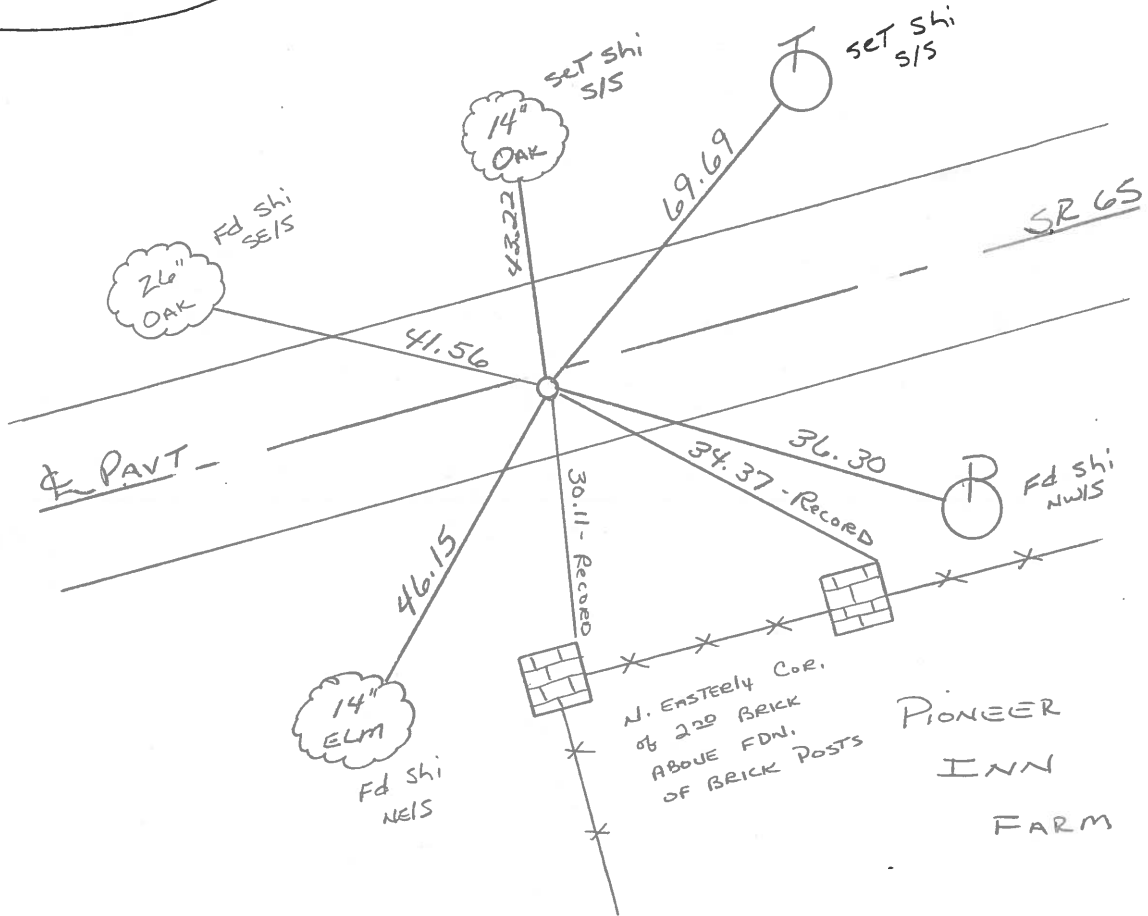

OD.O.T. DISTRICT 2 SURVEY OFFICE

SHEET 28 OF       

County Wood S.R. 65

Township Washington

Section 34

C.N, R.E

Personnel Hoffman

Loehrke

Howeholder

Date 6-14-82  
12-11-81

Weather clear

Temp. +30°

9-A



Fd. small. R.R. spk @ surface

0.5 rt. of & PAUT

8.1 TO S.E.P.


10.2 TO N.E.P.

$\Delta = 0^\circ - 50' \pm$  - PLAN E

meas 1972

P.I. STA. 130+65.5

Project stat 231+30

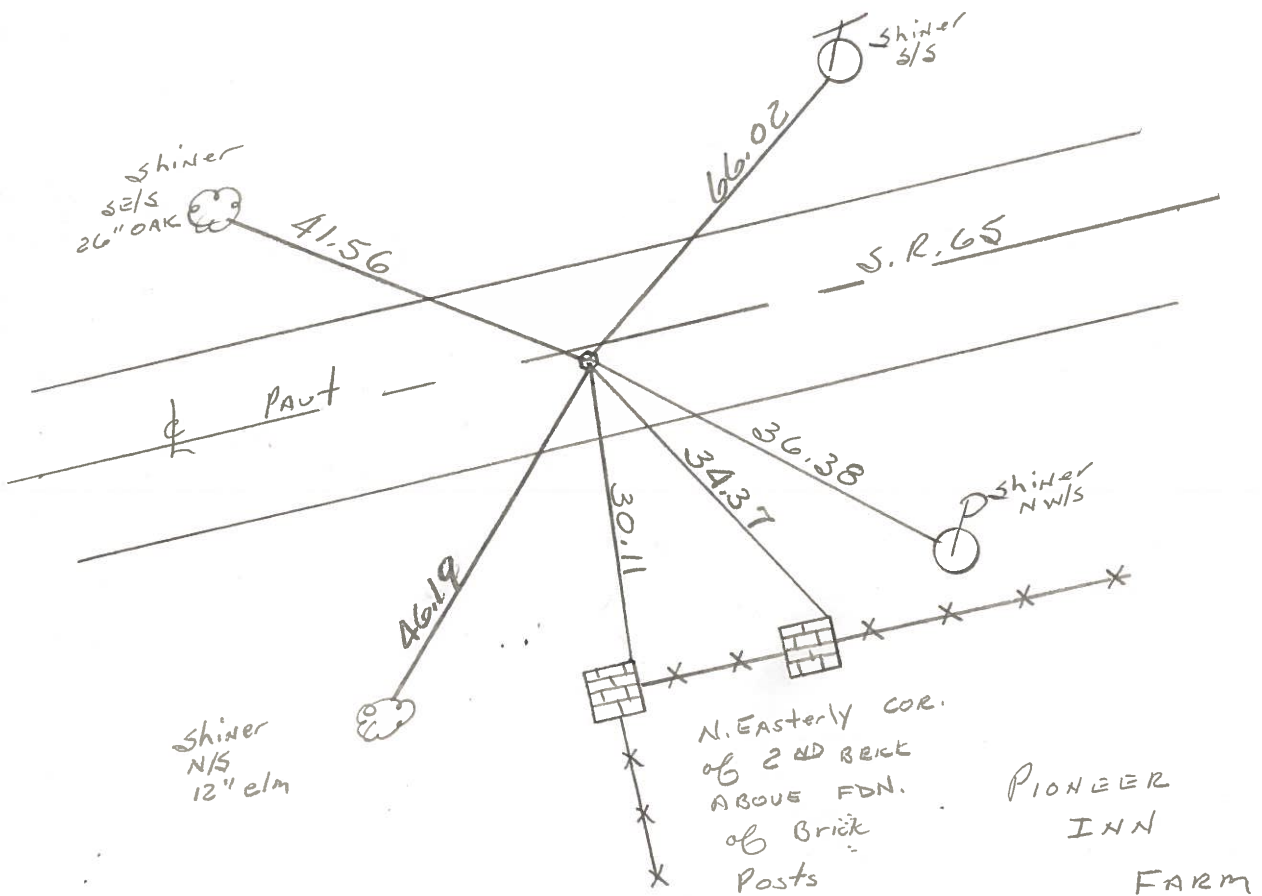


PERSONNEL TITLE PERSONNEL TITLE  
 BURNSIDE  
 SMITH  
 BOWERS

COUNTY WOOD DATE 10-12-72


S. R. 65 WEATHER PT. CLOUDY

SEC. GRAND RAPIDS TWP. TEMP. +60°

DESCRIPTION ESTABLISH & REFERENCE P.I.'S LEFT CENTER LINE RIGHT JOB NO.

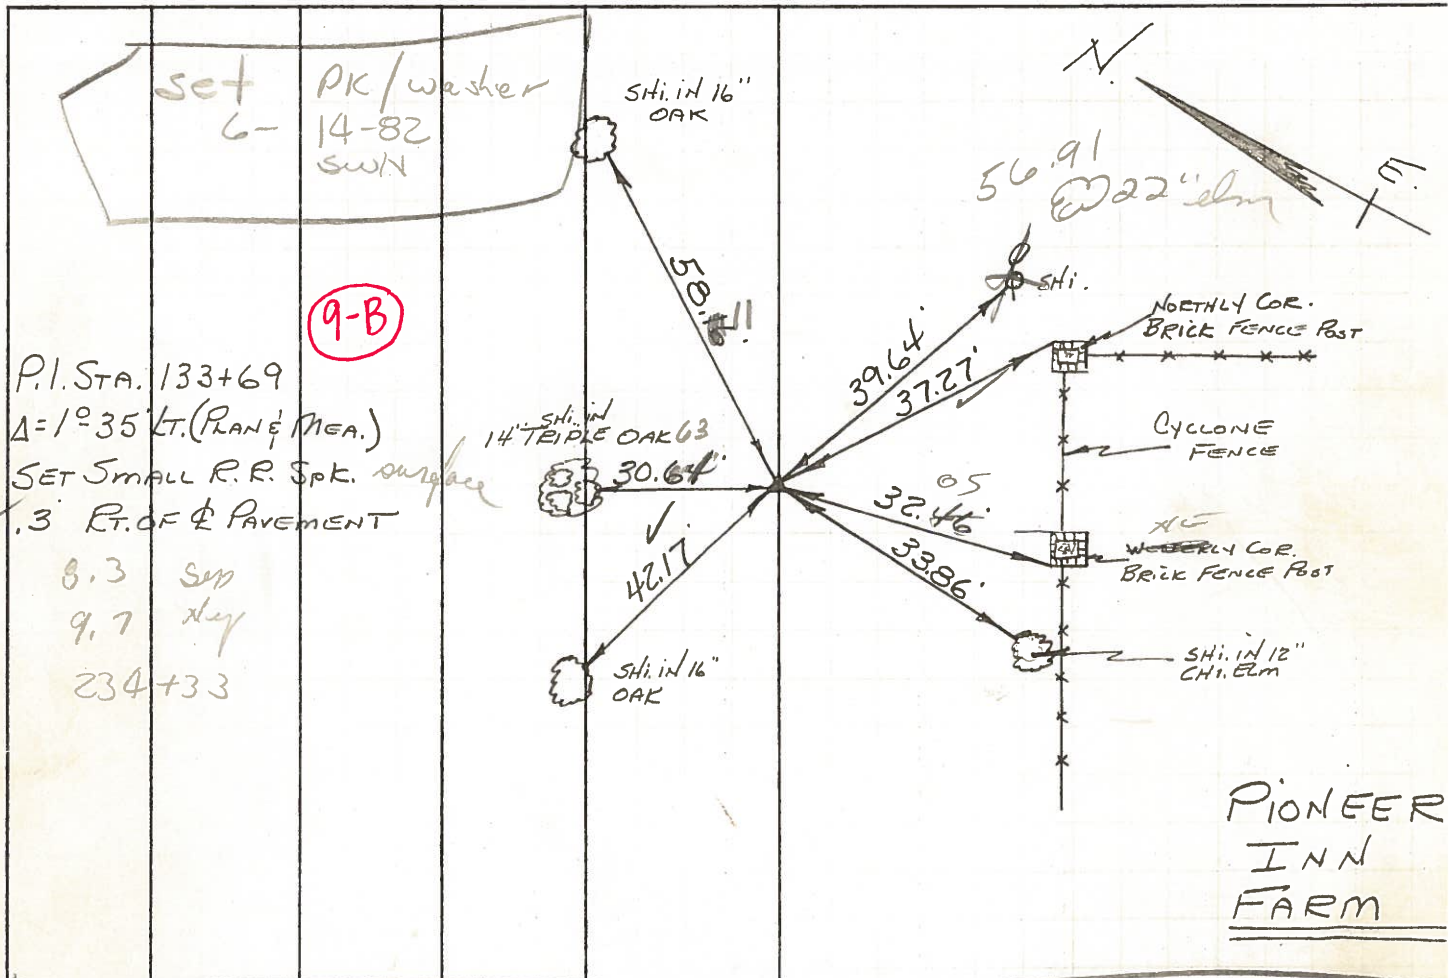

PIONEER INN FARM

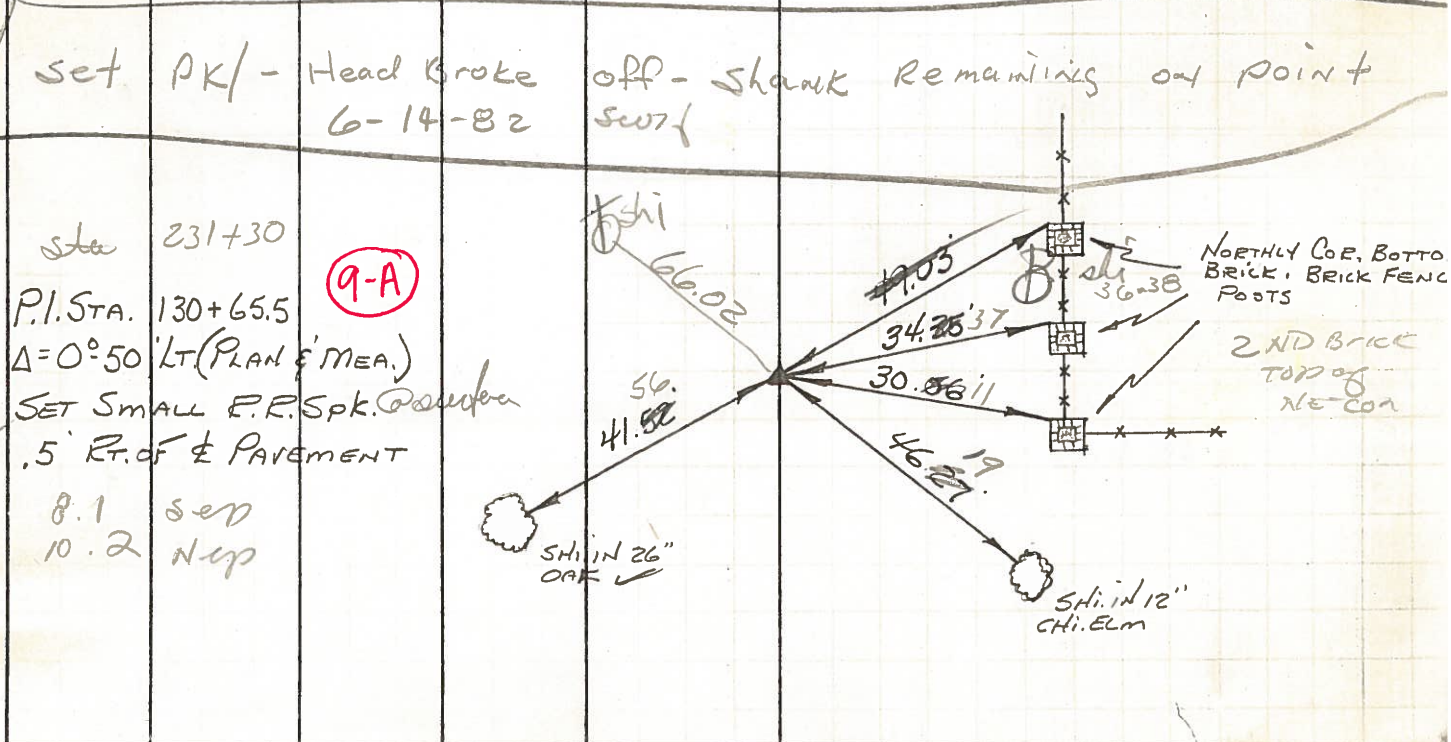

PIONEER INN FARM

PERSONNEL TITLE PERSONNEL TITLE  
 BURNSIDE \_\_\_\_\_  
 SMITH \_\_\_\_\_  
 BOWERS \_\_\_\_\_

COUNTY WOOD DATE 10-12-72


S. R. 65 WEATHER PT. CLOUDY

SEC. GRAND RAPIDS TWP TEMP. +60°

DESCRIPTION ESTABLISH & REFERENCE P.I.'S JOB NO. \_\_\_\_\_

**9-B**

P.I. STA. 133+69  
 $\Delta = 1^{\circ}35'$  LT. (PLAN & MEAS.)  
 SET SMALL R.R. SPK.  
 .3 RT. OF  $\Phi$  PAVEMENT

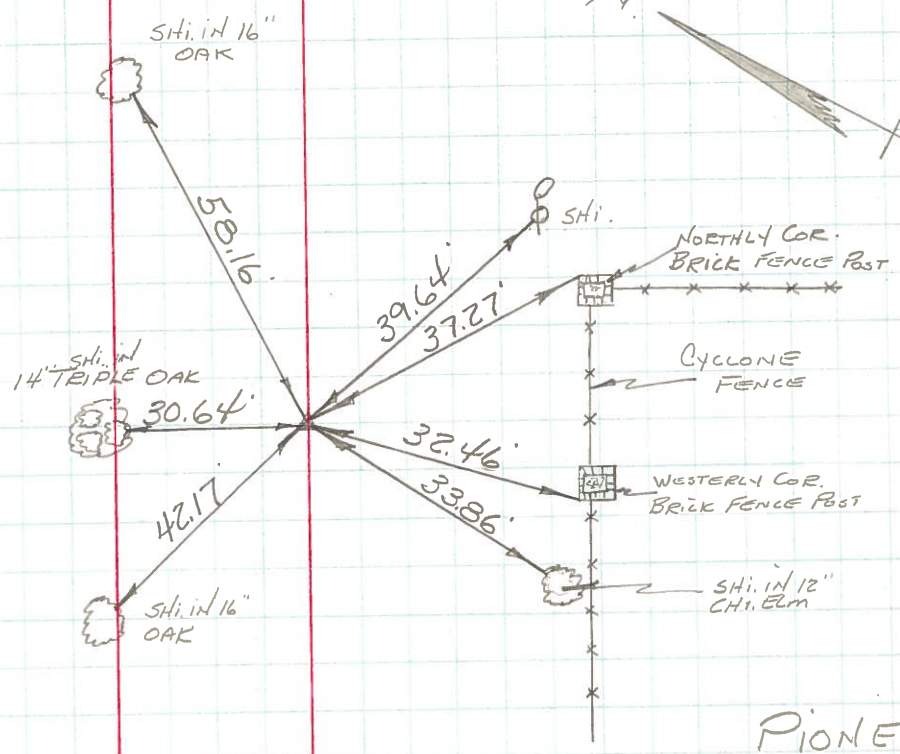

PIONEER  
INN  
FARM

**9-A**

P.I. STA. 130+65.5  
 $\Delta = 0^{\circ}50'$  LT. (PLAN & MEAS.)  
 SET SMALL R.R. SPK.  
 .5 RT. OF  $\Phi$  PAVEMENT

