


O.D.O.T. DISTRICT 2 SURVEY OFFICE (USE ONLY)


PERSONNEL _____ REFERENCE NO. 10 A SHEET 8 OF 22
 NOTES RHOADES DATE 4/11/22 ROUTE SR 65
 H.C. NIESE WEATHER FAIR COUNTY WOOD
 R.C. KETNER TEMP. 55° TOWNSHIP WASHINGTON
O'DONNELL SECTION 35
 DWG BY RHOADES PID 95796 T 5 N R 9 E

TYPE MONUMENT P.K./WASHER
 ON SURFACE - ~~BELOW~~ ON _____
 OFFSET 0.8' C PAVEMENT LT : ~~RT~~
9.4' TO LT EDGE PAVEMENT
 STATION: 244+28.96

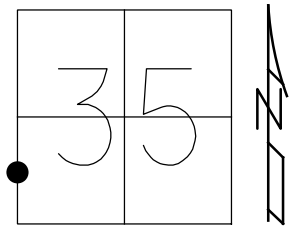

HORZ. DATUM: NAD83 2011 GEOID: NAVD88 2018
 GRID: NORTHING: 646565.852 EASTING: 1610449.844

RECORD:
 ORIGIN UNKNOWN
 FD P.K./WASHER
 6/23/04, DCH
 SET P.K./WASHER
 9/17/04, RGN
 FD P.K./WASHER
 4/20/15, EBW
 FD MAG/WASHER
 REFA10
 11/3/20, JFO
 SET MAG/WASHER
 10/6/22, TDN

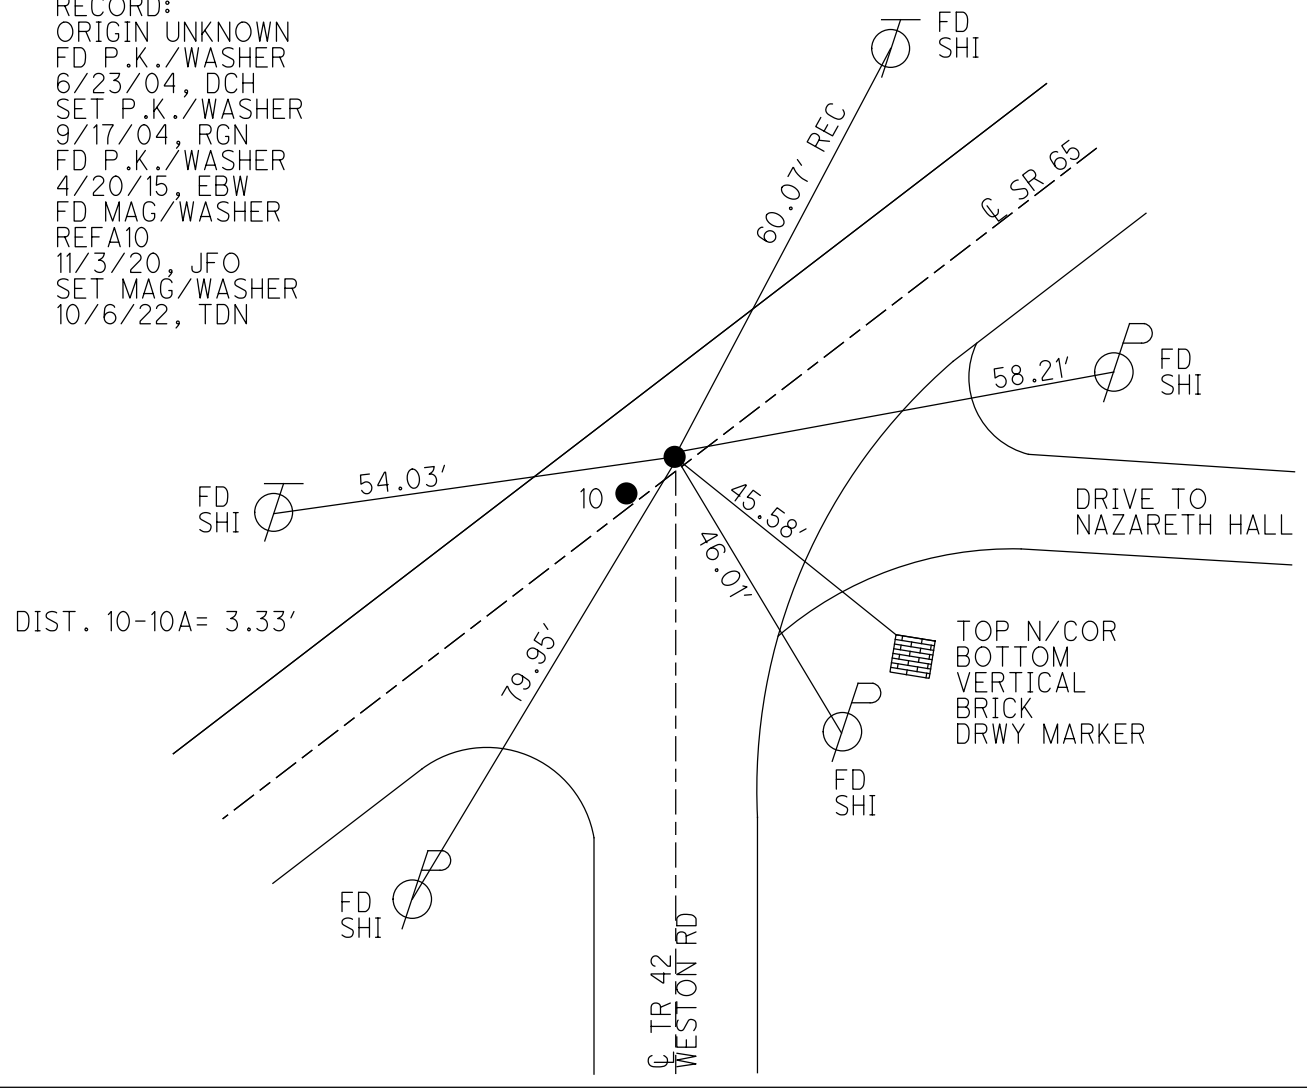


O.D.O.T. DISTRICT 2 SURVEY OFFICE (USE ONLY)

PERSONNEL _____ REFERENCE NO. 10 A SHEET 6 OF 6


NOTES RHOADES DATE 4/20/15 ROUTE SR 65
 H.C. WESTFALL WEATHER WINDY COUNTY WOOD
 R.C. O'DONNELL TEMP. 55° TOWNSHIP WASHINGTON
 _____ SECTION 35
 _____ T 6 N R 9 E

TYPE MONUMENT P.K./WASHER
 ON SURFACE - ~~BELOW~~ ON _____
 LEFT - ☉ PAV'T - ~~RIGHT~~ 0.8'
9.4' TO LT EDGE PAVEMENT
 S.L.M. 244+51.31

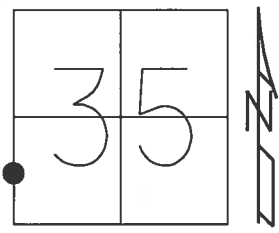

Grid: Northing: _____ Easting: _____

RECORD:
 ORIGIN UNKNOWN
 FD P.K./WASHER
 6/23/04, DCH
 SET P.K./WASHER
 9/17/04, RGN
 FD P.K./WASHER
 4/20/15, EBW

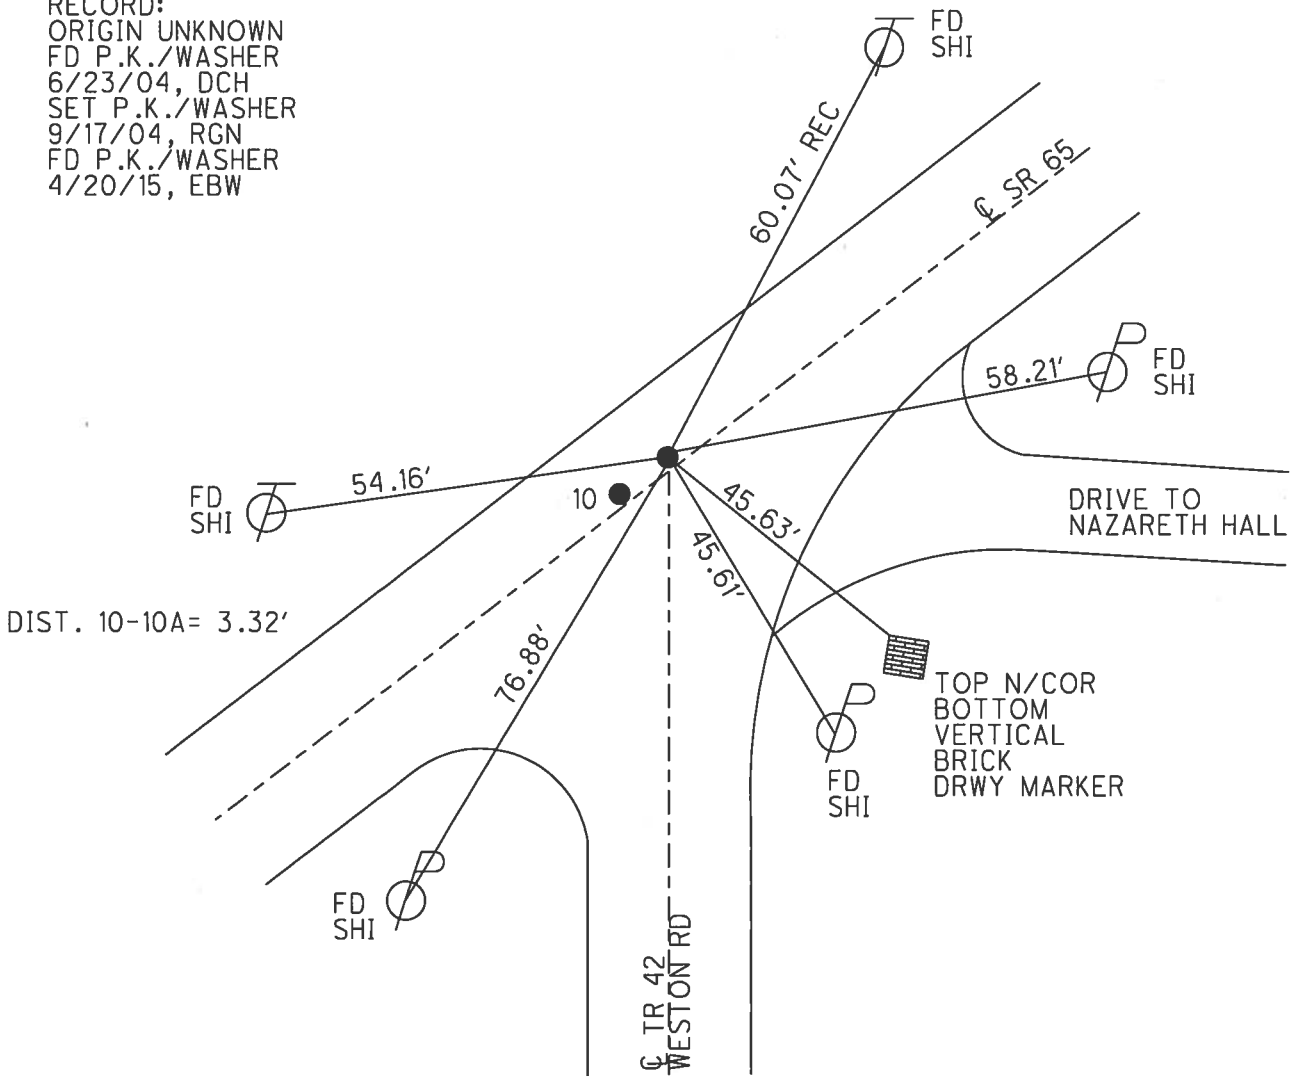

O.D.O.T. DISTRICT 2 SURVEY OFFICE

PERSONNEL _____

REFERENCE NO. 10

SHEET 37 OF 49

NOTES Nuhter

H.C. Homan

R.C. Athins

DATE 6-23-04

WEATHER Sunny

TEMP. +70°F

ROUTE S.R. 65

COUNTY Wood

TOWNSHIP Washington

SECTION 35

T 6 N R 9 E

TYPE MONUMENT Pts (A) + (B) PK/W's


ON (SURFACE) - BELOW Surface Pts (A) + (B)

LEFT - ~~PAV'T~~ - RIGHT 0.8' Lt. Pts (A) + (B)

Both 9.4' TO Lt. EDGE PAVEMENT

S.L.M. Pt (A) - 244+30

3.32' Between Pts.

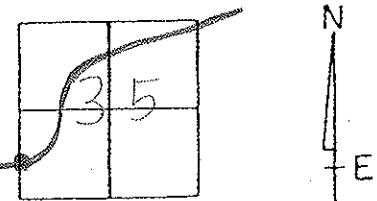

Record: 1923-1924 Plans

P.I. 143+74.4

$\Delta = 1^{\circ}47' Lt$

Δ meas 1972 = $1^{\circ}47' Lt$


Point "A"

Point "B"

origin unknown

Fd RR. spk

Set Mag/W.
9-17-04
RGN

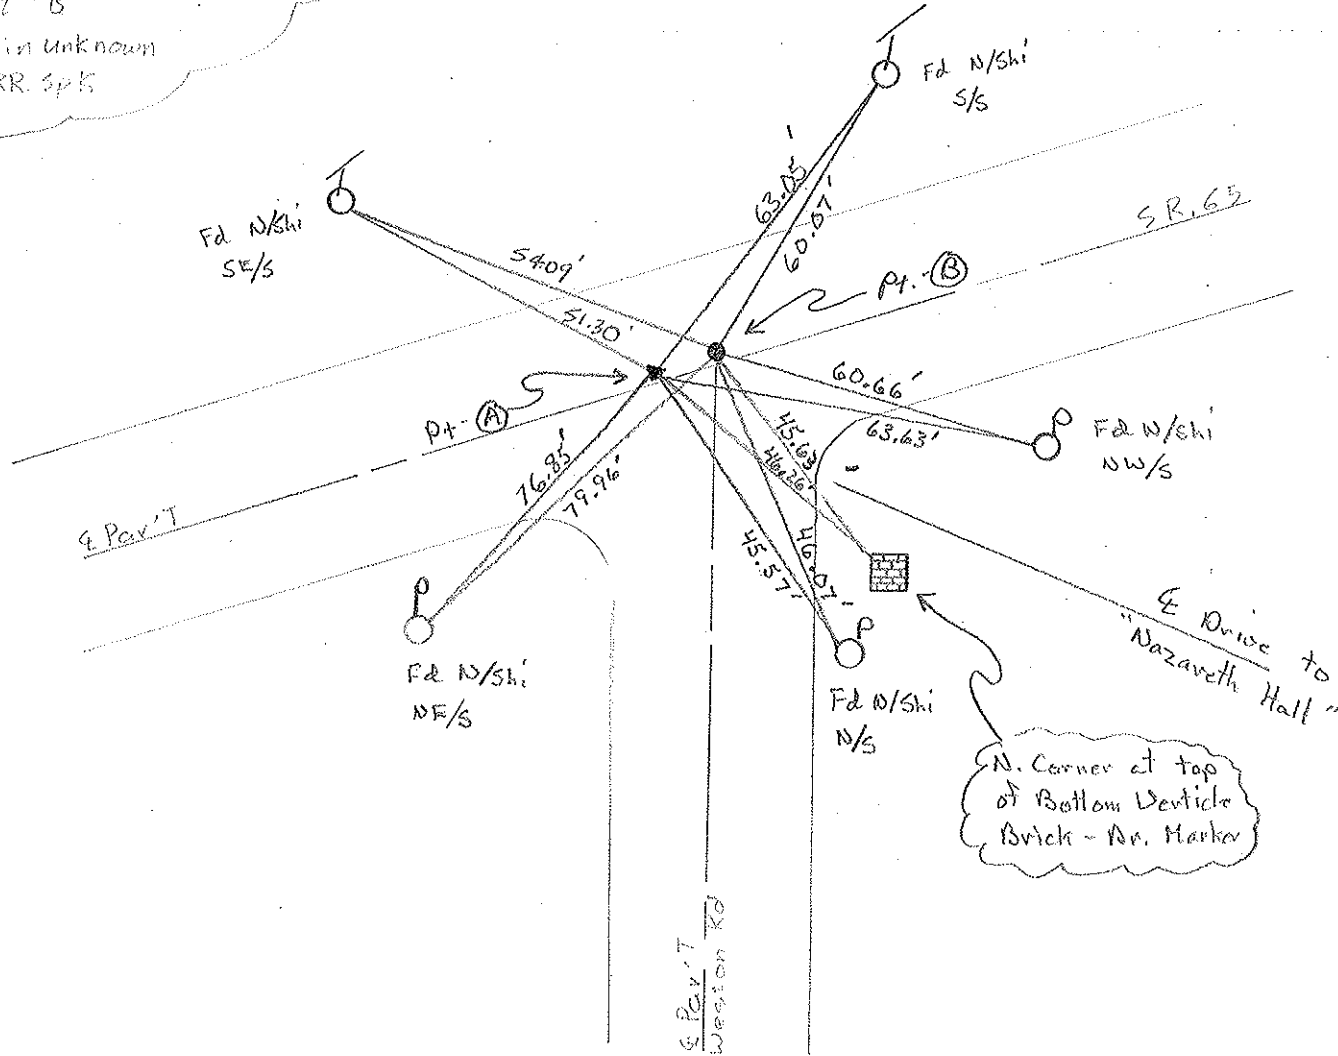

O.D.O.T. DISTRICT 2 SURVEY OFFICE

PERSONNEL _____

REFERENCE NO. 10

SHEET 22 OF 34

NOTES BARNHISEL

H.C. VAN DYSEN

R.C. BARNHISEL

DATE 4-20-92

WEATHER SUNNY

TEMP. +70°

ROUTE SR 65

COUNTY WOOD

TOWNSHIP WASHINGTON

SECTION 35

T6 NR 9 E

TYPE MONUMENT PT "A" & PT "B" PK & WASHER


ON SURFACE - ~~BELOW~~ yes yes

~~LEFT - & PAV'T. - RIGHT~~ yes yes

BOTH B.B.T.O. LT EDGE PAVEMENT

S.L.M. PT "A" 244+26

3.30 BETWEEN PT'S

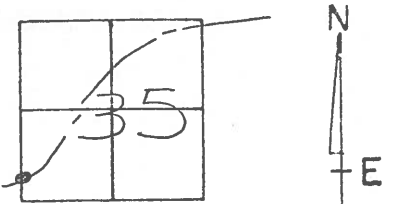

RECORD: 1923-1924 PLANS

P.I. 143+74.4

$\Delta = 10-47' LT$


Δ MEAS. 1972 = 10-47' LT.

Point "A"

SET PK'S & WASHERS
5-1-92
MB

POINT "B"

ORIGIN UNKNOWN
Fd R.R. SPIC

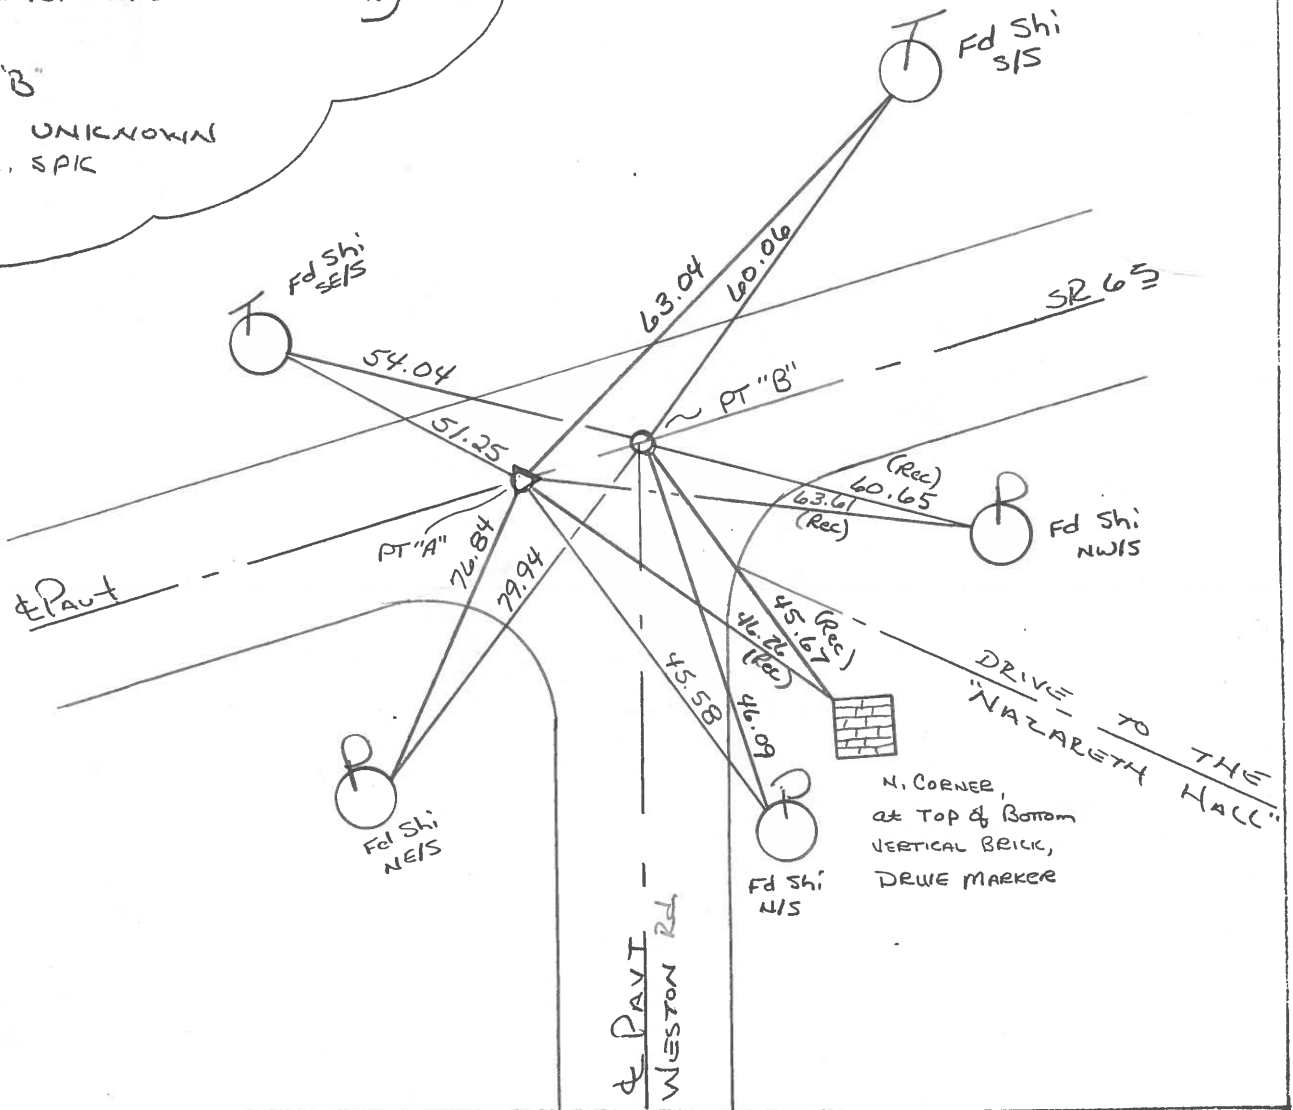

County Wood S.R. 65

Date 6-14-82
12-11-81

Township Washington

Weather clear

Section 35

Temp. +32°


T5N, R9E

Personnel Hoffman

Loehrke


Householder

10

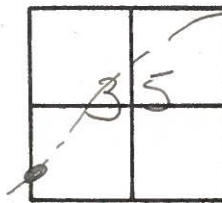

Pt. "A" Fd. Small R.R. spike @ surface @ & PAUT S.R. 65 Project STA ± 244+39
9.3' to N.E.P.

Pt. "B" origin unknown
Fd. Large R.R. spike 3.30 N.E. of Pt. "A"
@ surface, on & PAUT S.R. 65

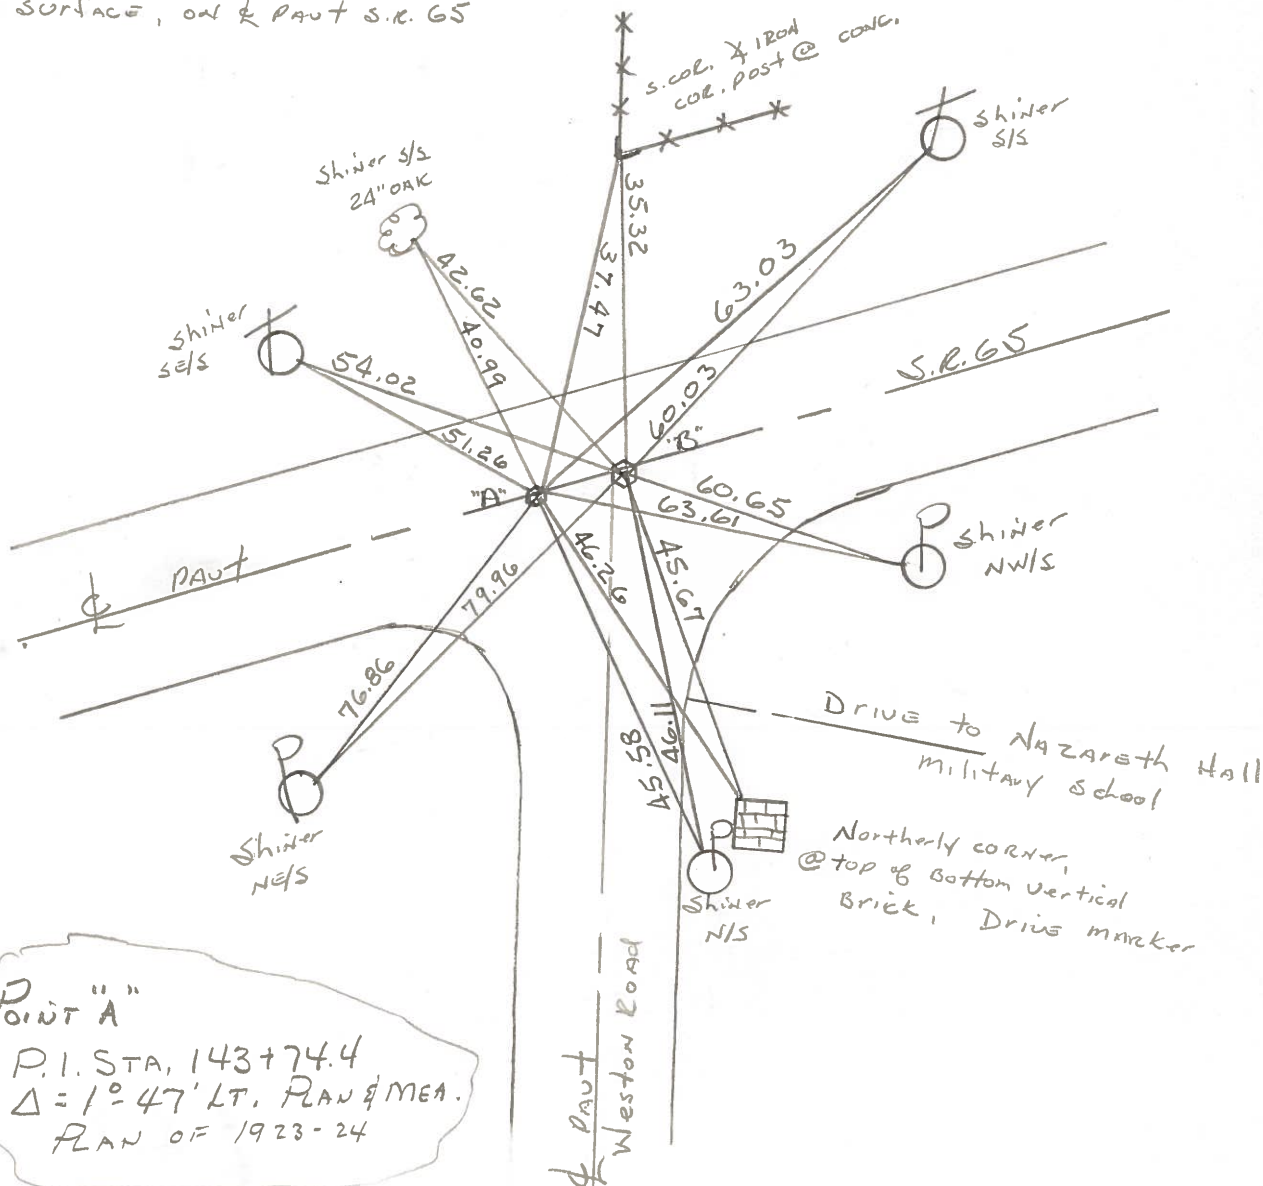


PERSONNEL TITLE PERSONNEL TITLE
 BURNSIDE
 SMITH

COUNTY Wood DATE 10-26-72

S. R. 65 WEATHER CLEAR

SEC. WASHINGTON TWP TEMP. +50°

DESCRIPTION ESTABLISH & REF. CONTROL POINTS JOB NO.

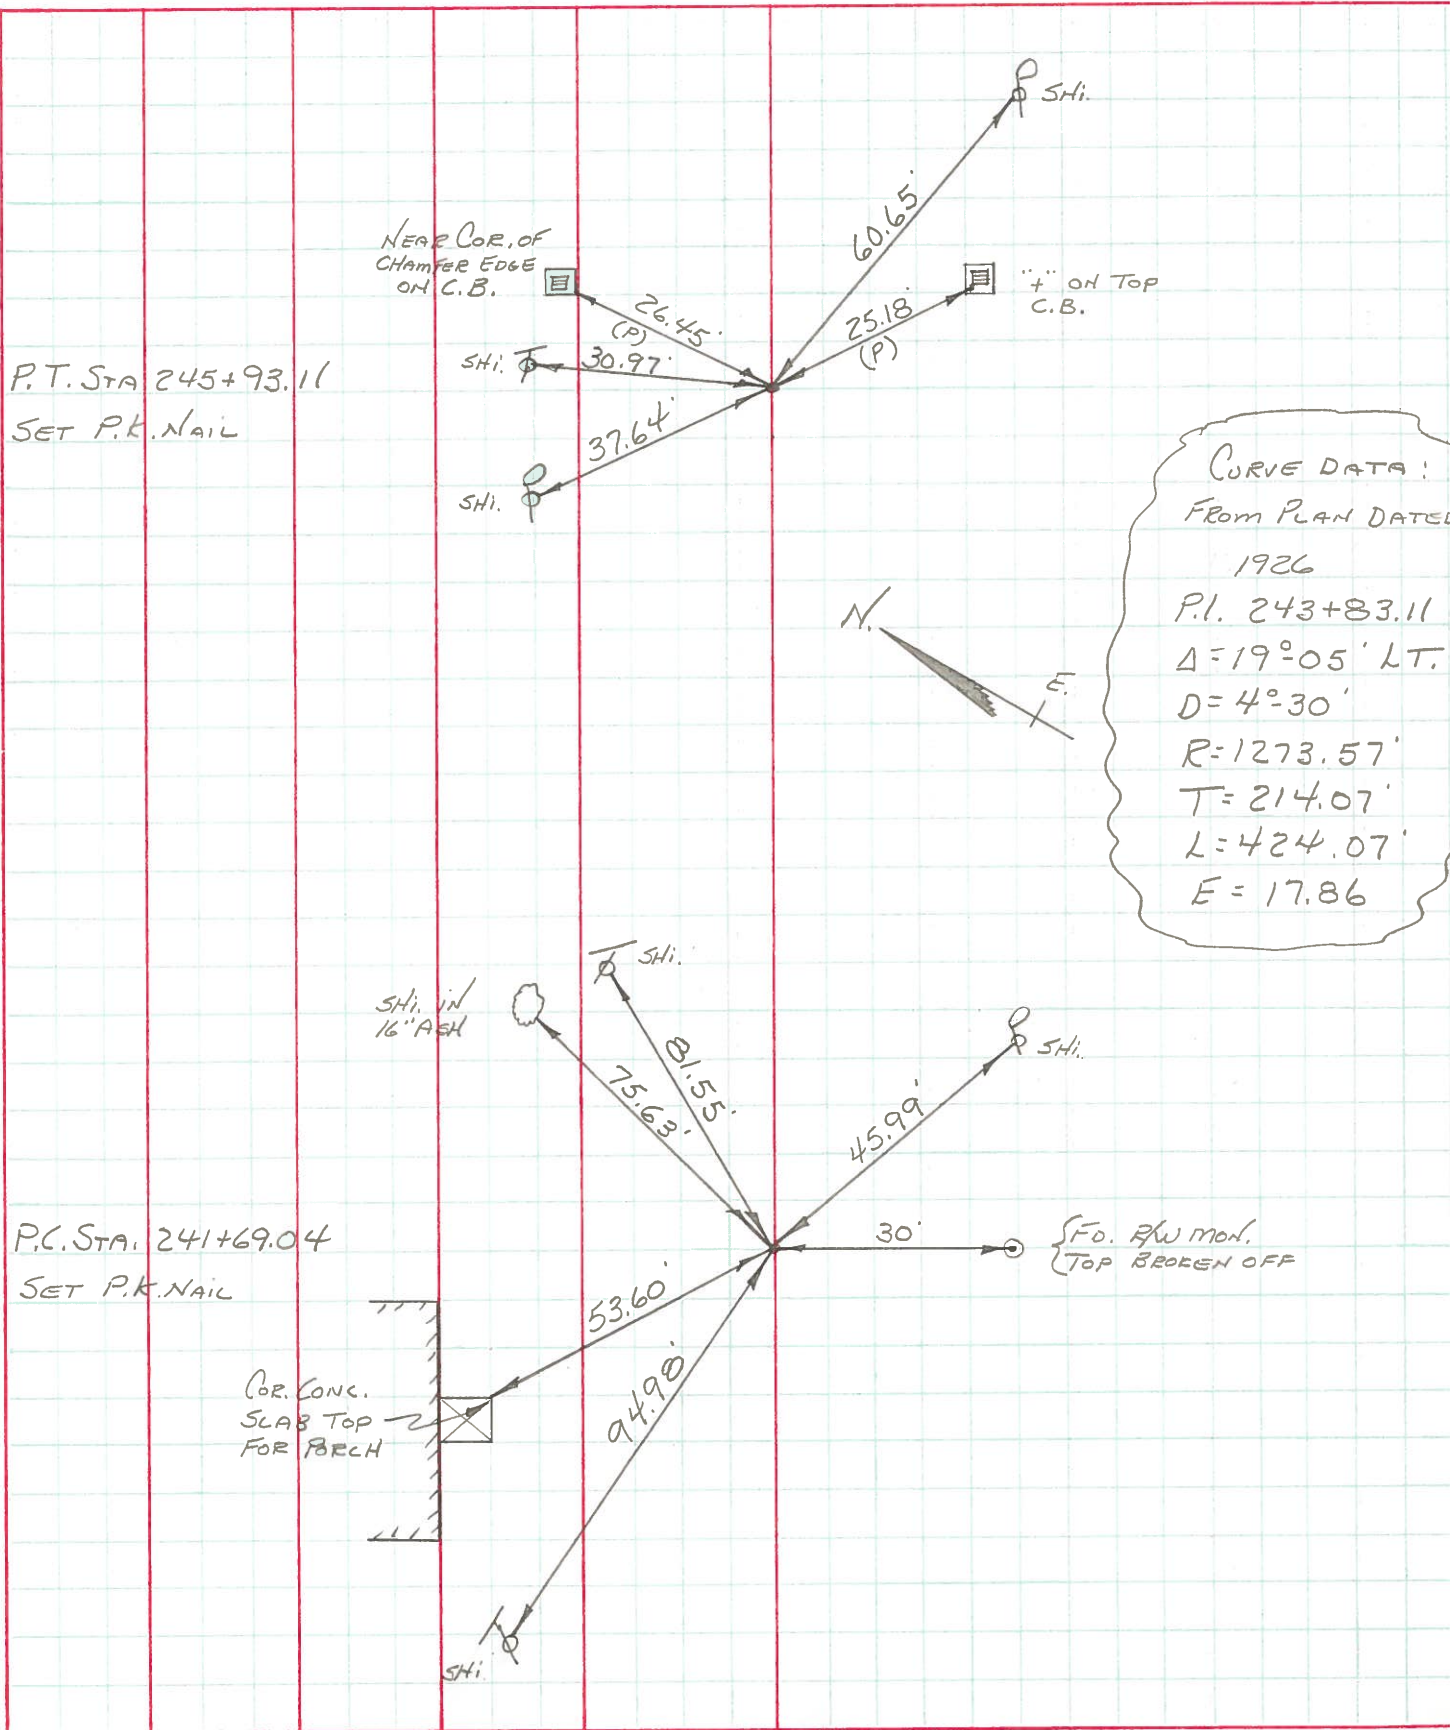

ODOT DISTRICT 2 SURVEY OFFICE

SHEET _____ OF _____

County _____ S.R. 65

Date 10-12-72

Township WASHINGTON

Weather CLOUDY

Section 35


Temp. 56°

T6N, R9E

Personnel BURNSIDE

SMITH

BOWERS

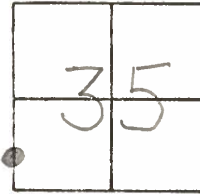

#10 (circled)
11 (circled)

P.I. STA. 150+64.6
 $\Delta = 2^{\circ} 39'$ RT. (PLAN & MEAS.)
 SET SMALL R.R. SPK.
 1.7' LT. OF $\frac{1}{2}$ PAVEMENT.

