

O.D.O.T. DISTRICT 2 SURVEY OFFICE (USE ONLY)

PERSONNEL

REFERENCE NO. 11 A

SHEET 10 OF 22

NOTES RHOADES

DATE 10/6/22

ROUTE SR 65

H.C. NIESE

WEATHER CLOUDY

COUNTY WOOD

R.C. AUBLE

TEMP. 75°

TOWNSHIP WASHINGTON

SECTION 35

DWG BY RHOADES

PID 95796

T 9 N R 9 E

TYPE MONUMENT MAG/WASHER

ON SURFACE - ~~BELOW~~ ON

OFFSET 0.8' LT : RT

10' TO RT EDGE PAVEMENT


STATION: 256+98.27

HORZ.DATUM: NAD83 2011


GEOID: NAVD88 2018

GRID: NORTHING: 647373.718

EASTING: 1611428.421

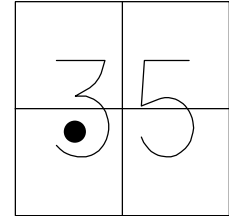

RECORD: P.I.  
 STA. 156+54  
 $\Delta = 0^\circ 56' \text{ LT}$   
 1972  
 FD P.K./WASHER  
 6/23/04, DCH  
 SET P.K./WASHER  
 9/17/04, RGN  
 FD MAG/WASHER  
 REFA11  
 11/4/20, JFO  
 SET MAG/WASHER  
 10/6/22, TDN

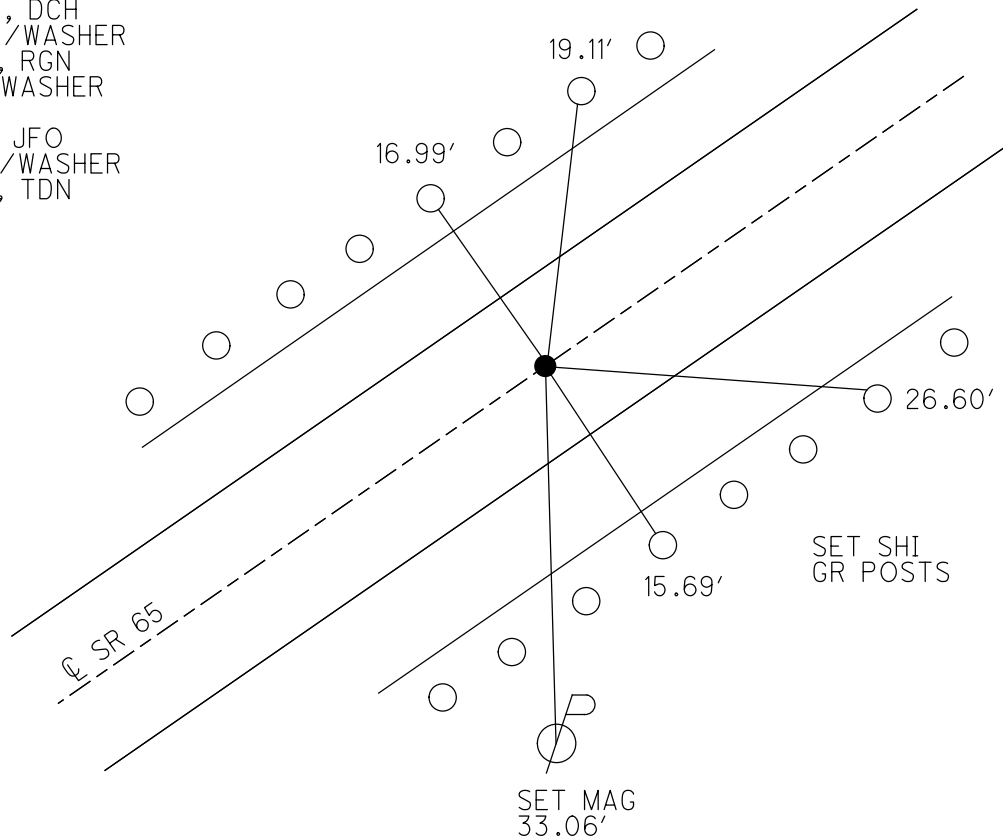

# O.D.O.T. DISTRICT 2 SURVEY OFFICE

PERSONNEL

REFERENCE NO. 11A


SHEET 39 OF 49

NOTES Nahfer  
 H.C. Homan  
 R.C. Atkins

DATE 6-23-04  
 WEATHER Sunny  
 TEMP. +72°F


ROUTE S.R. 65  
 COUNTY Wood  
 TOWNSHIP Washington  
 SECTION 35  
T 6 N R 9 E

TYPE MONUMENT PK/w  
 ON SURFACE - ~~WOOD~~ Surface  
~~PAV'T~~ - Gr. Pav.  
 10" TO Rt. EDGE PAVEMENT  
 S.L.M. 257+01

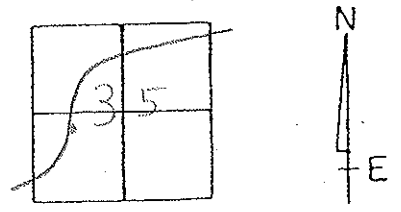

Record:  
 P.I. 156+54.7  
 Δ = 0°-56'LT  
 Δ meas. 1972: 0°-49'LT

Set Mag/w  
 9-17-04  
 RGN

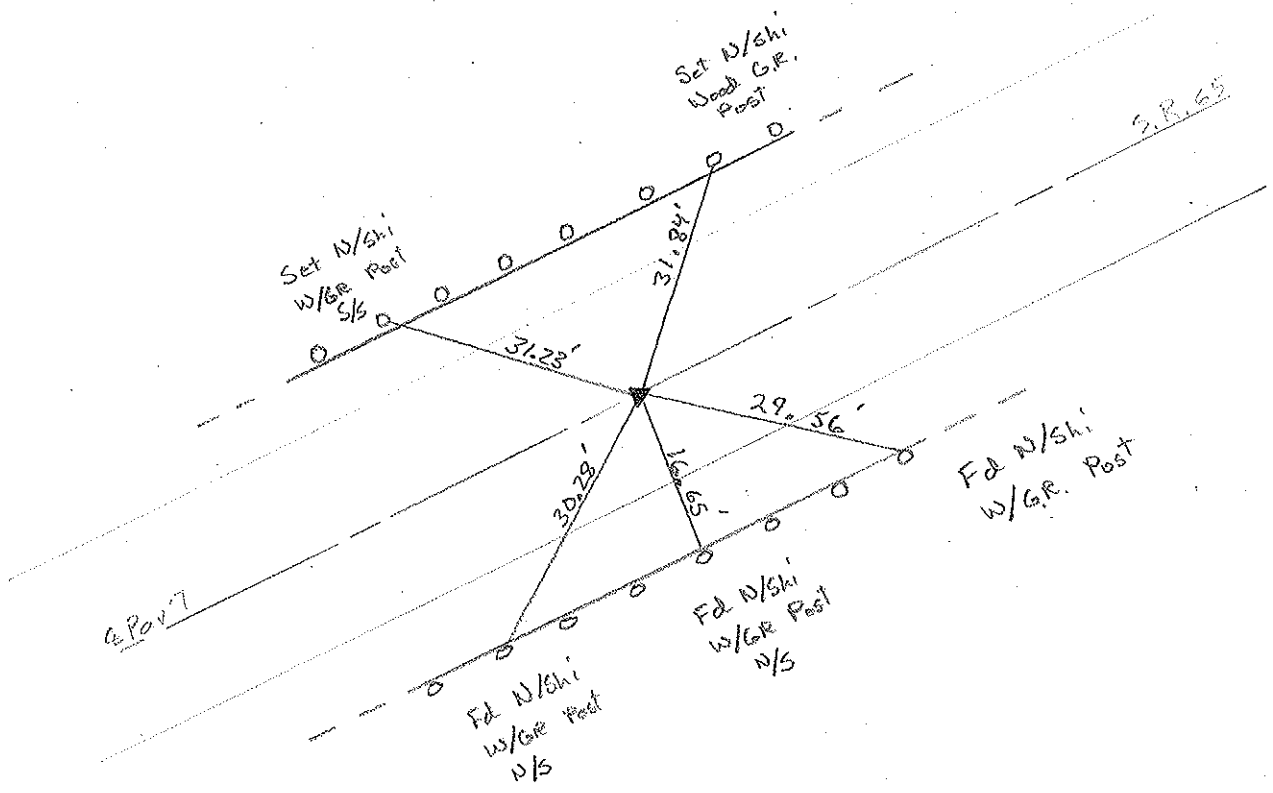

# O.D.O.T. DISTRICT 2 SURVEY OFFICE

PERSONNEL

REFERENCE NO. 11A

SHEET 24 OF 34

NOTES BARNHISEL

H.C. VAN DUSEN

R.C. BARNHISEL

DATE 4-20-92

WEATHER SUNNY

TEMP. +70°

ROUTE SR 65

COUNTY WOOD

TOWNSHIP WASHINGTON

SECTION 35

T 6 N R 9 E


TYPE MONUMENT PK & WASHER

ON SURFACE - BELOW YES

~~LEFT - C. PAV'T.~~ - RIGHT YES

9.3 TO RT. EDGE PAVEMENT

S.L.M. 256+98

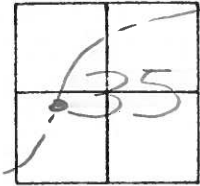

RECORD:

P.I. 156+54.7


$\Delta = 0^\circ - 56' \text{ LT.}$

$\Delta \text{ MEAS. AT } 2 = 0^\circ - 49' \text{ LT.}$

Set PK/WASHER

5-1-92

C.L.

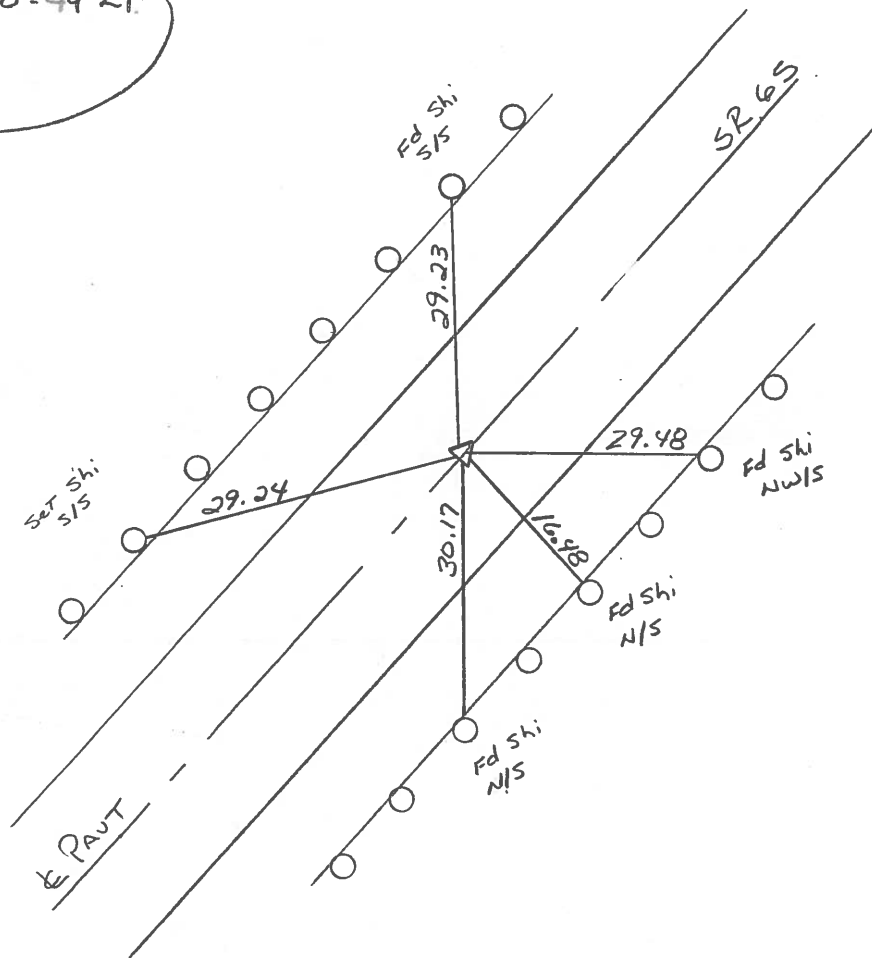

County Wood S.R. 65

Date 6-14-82  
12-11-81

Township Washington

Weather clear


Section 35

Temp. +32°

T, N, R, E

Personnel HOFFMAN  
Loehrke  
Householder

11-A

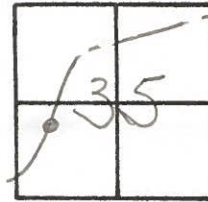

Fd. Small R.R. spk @ surface @ & PAUT.

Project sta ± 257+11


9.5' to N.E.P.

9.3' to S.E.P.

Δ = 0°-56' 24" - PLAN

0°-49' Lt - MEAS  
(1972)


P.I. STA. 156+54.7

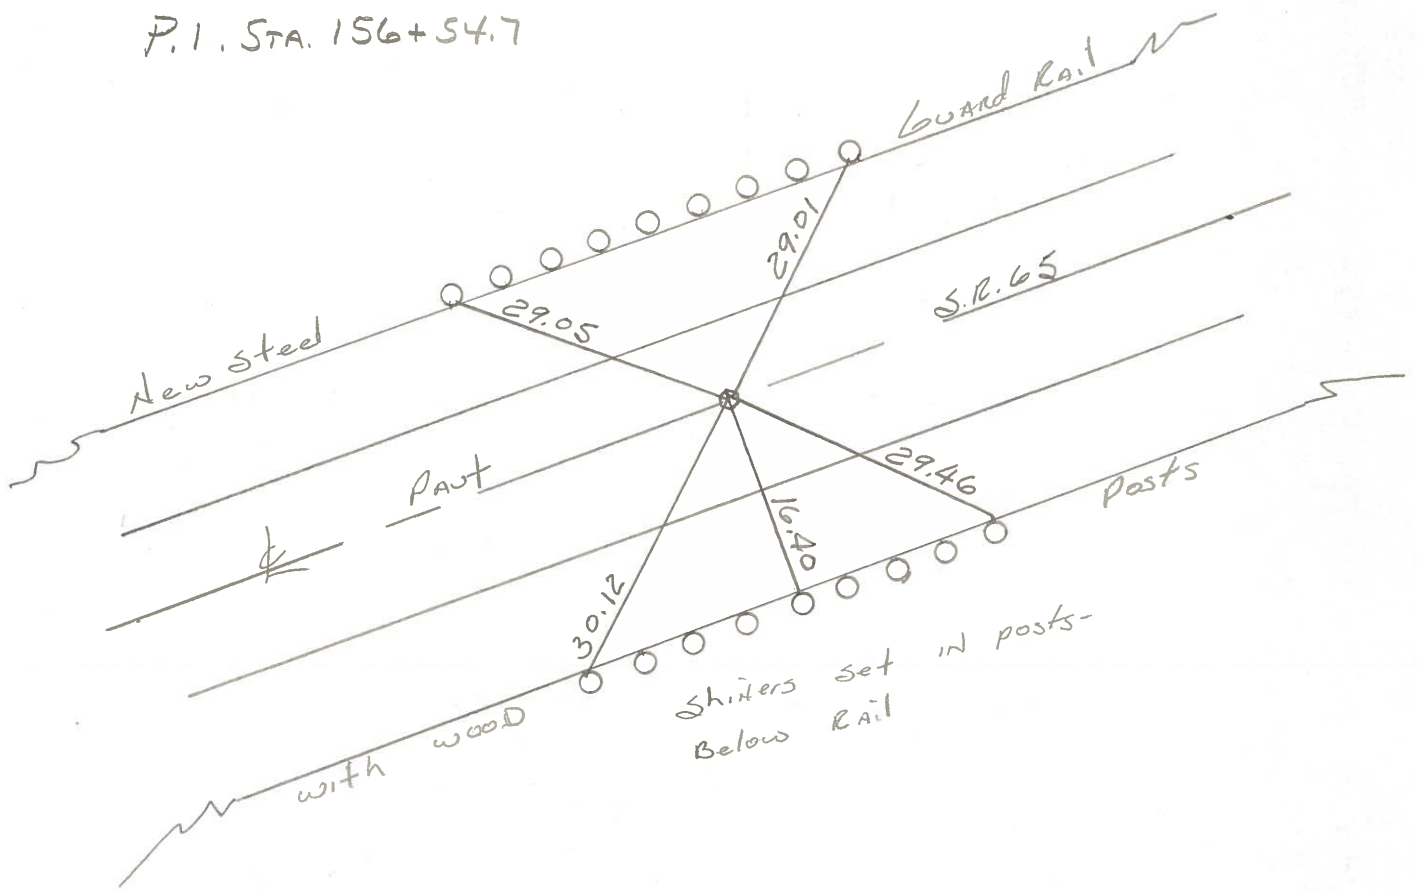

PERSONNEL TITLE PERSONNEL TITLE  
 BURNSIDE \_\_\_\_\_  
 SMITH \_\_\_\_\_  
 BOWERS \_\_\_\_\_

COUNTY WOOD DATE 10-12-72  
 S. R. 65 WEATHER Cloudy  
 SEC. WASHINGTON TWP TEMP. +56°

DESCRIPTION ESTABLISH & REFERENCE P.I.'S JOB NO. \_\_\_\_\_

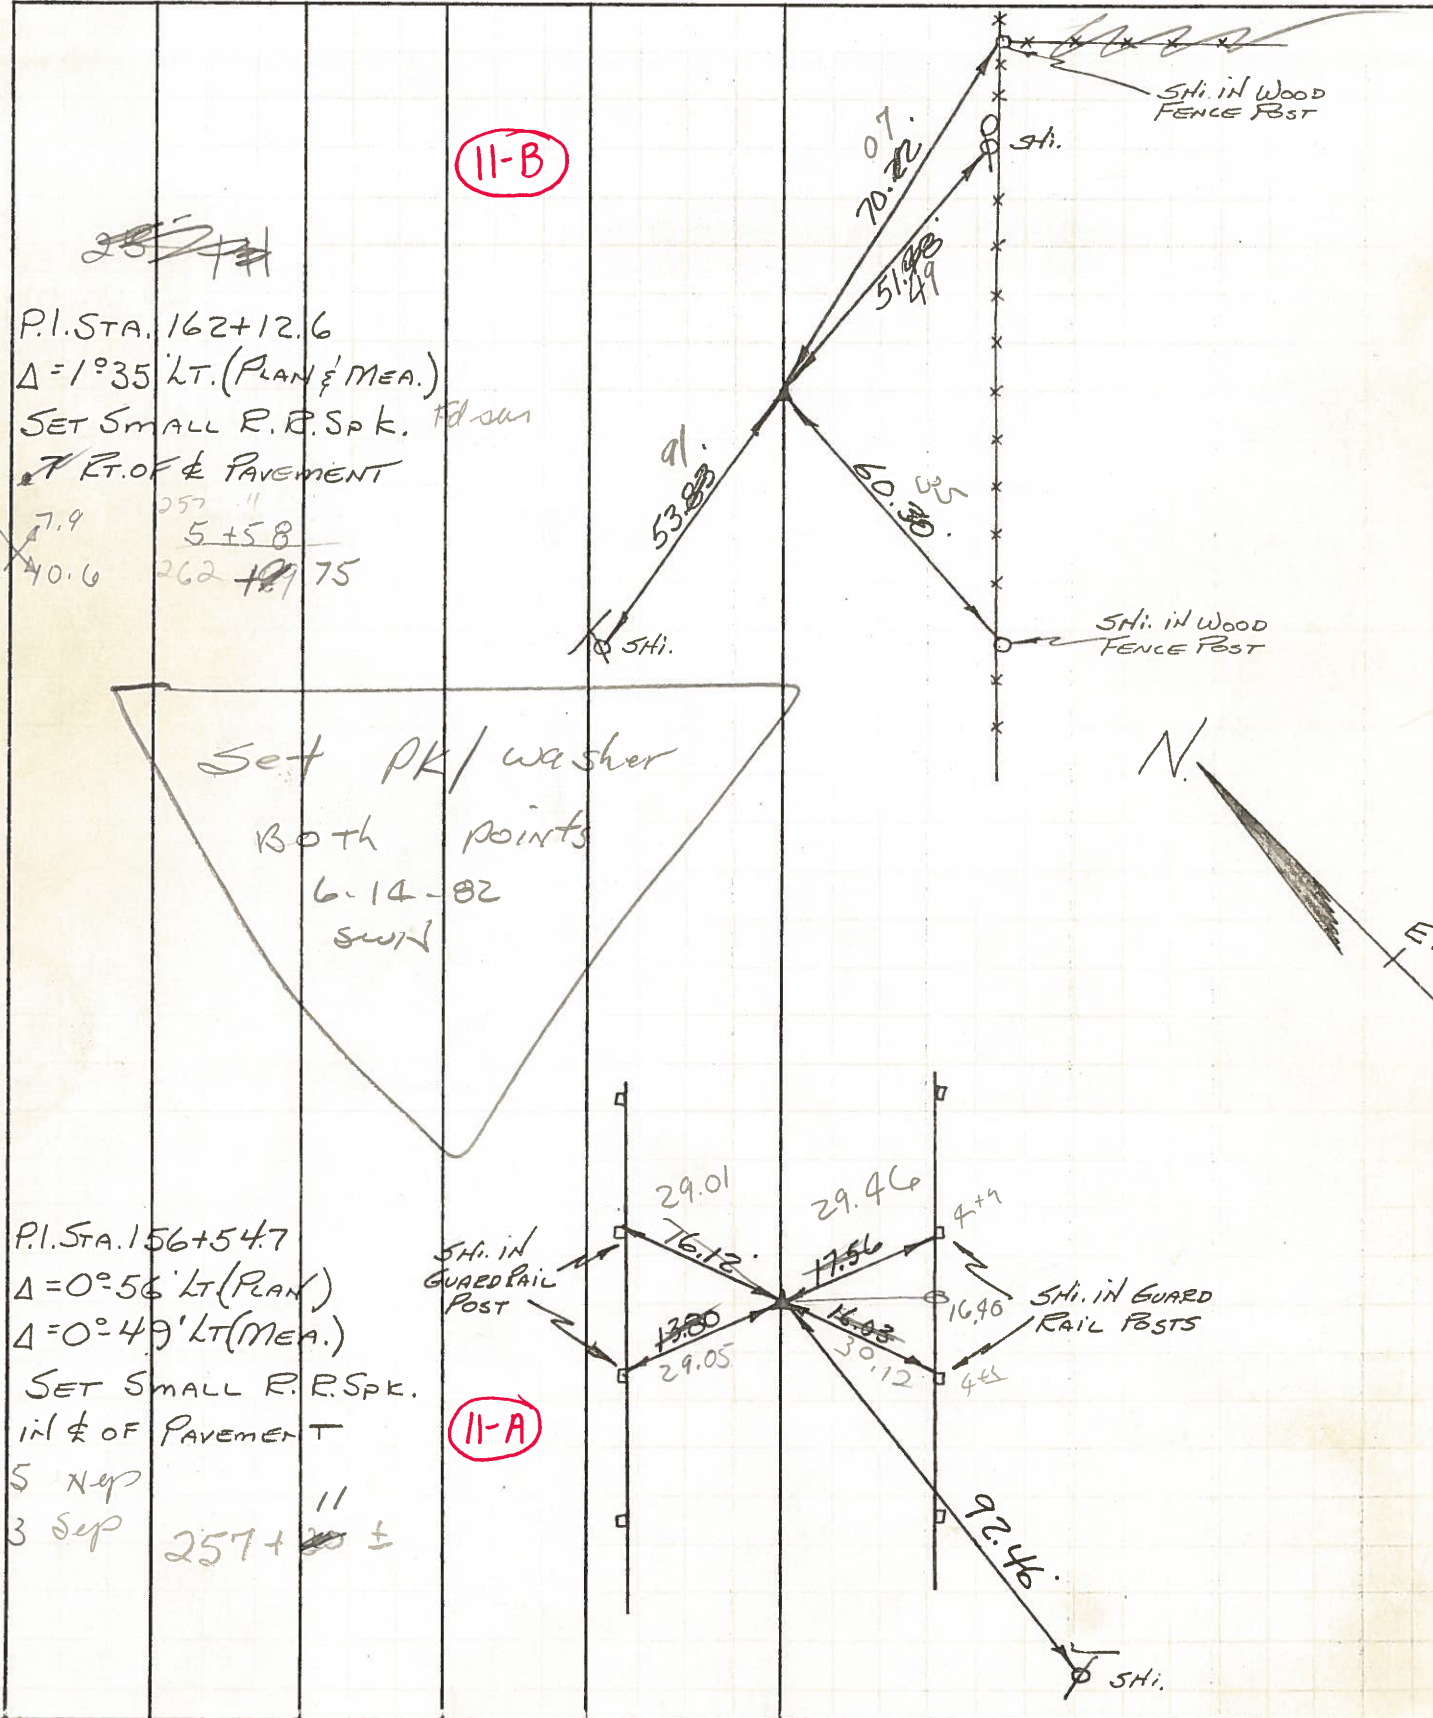



PERSONNEL	TITLE	PERSONNEL	TITLE	COUNTY	WOOD	DATE	10-12-72
BURNSIDE				S. R.	65	WEATHER	Cloudy
SMITH				SEC.	WASHINGTON TWP	TEMP.	+56°
BOWERS							

DESCRIPTION ESTABLISH & REFERENCE P.I.S JOB NO. \_\_\_\_\_

