

O.D.O.T. DISTRICT 2 SURVEY OFFICE (USE ONLY)

PERSONNEL

REFERENCE NO. 12 AA

SHEET 15 OF 22

NOTES RHOADES

DATE 4/11/22

ROUTE SR 65

H.C. NIESE

WEATHER FAIR

COUNTY WOOD

R.C. KETNER
O'DONNELL

TEMP. 63°

TOWNSHIP WASHINGTON

SECTION 35

DWG BY RHOADES PID 95796

T 6 N R 9 E

TYPE MONUMENT MAG NAIL

ON SURFACE - ~~BELOW~~ ON

OFFSET ☑ PAVEMENT ON LT : RT

9.0' TO RT EDGE PAVEMENT


STATION: 278+32.63

HORIZ.DATUM: NAD83 2011


GEOID: NAVD88 2018

GRID: NORTHING: 648714.983

EASTING: 1613085.908

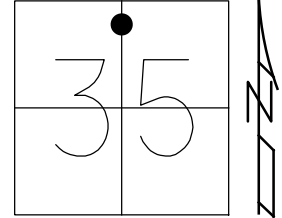

RECORD:
ORIGIN UNKNOWN
FD P.K./WASHER
6/23/04, DCH
SET MAG/WASHER
9/16/04, SAH
FD MAG NAIL
REFAA12
11/4/20, JFO
SET MAG/WASHER
10/6/22, TDN

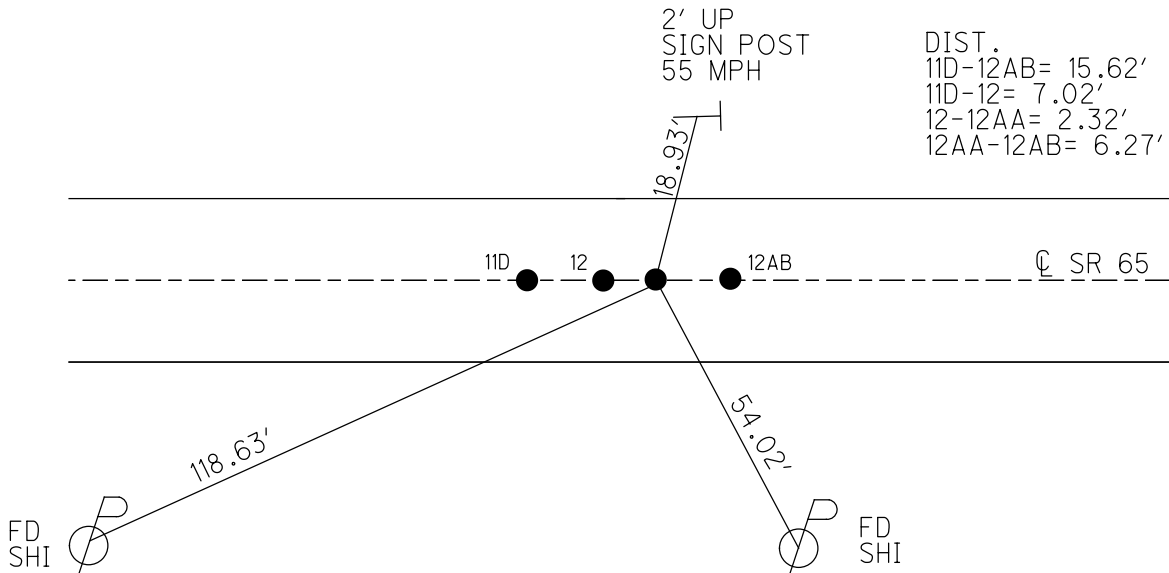

O.D.O.T. DISTRICT 2 SURVEY OFFICE

PERSONNEL

REFERENCE NO. 12

SHEET 27 OF 34

NOTES BARNHISEL

H.C. VAN DUSEN

DATE 4-20-92

ROUTE SR 65

R.C. BARNHISEL

WEATHER SUNNY

COUNTY WOOD

TEMP. +70°

TOWNSHIP WASHINGTON

SECTION 35

T 6 N R 9 E


TYPE MONUMENT ALL PT'S PK & WASHER

ON SURFACE - ~~BELOW~~ YES (ALL)

~~LEFT~~ - & PAVT. - RIGHT 0.5 (ALL)

(ALL) 9.0 TO RT EDGE PAVEMENT


S.L.M. 278+33 PT A 278+26 PT B

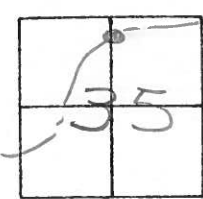

RECORD:

POINT "A" Fd. I. PIPE, AT END OF FENCE, NORTH OF SR 65. USED DISTANCE OF 39.3' AS FOUND IN FIELD BOOK #R-75 WOOD COUNTY COURTHOUSE TO EST. & S.R. 65 (SEPT 20, 1920) (RE-EST. BY R. BURNSIDE 1972)

POINT "B", "C" & "D" = ORIGINAL UNKNOWNIAL. - Set P.K.'s

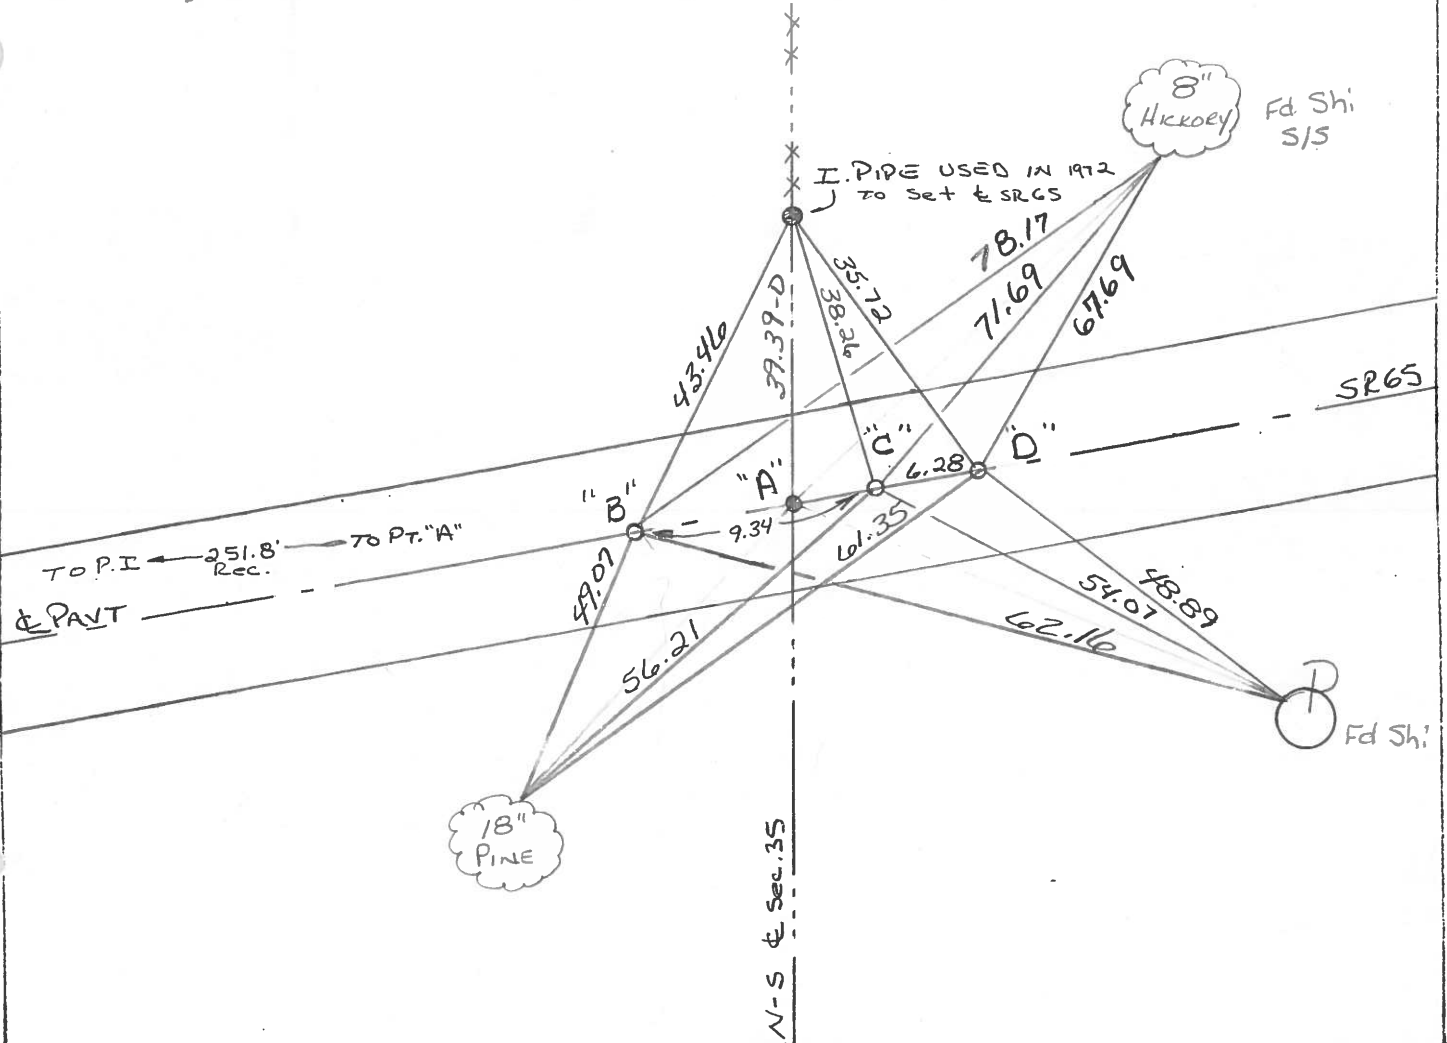

O.D.O.T. DISTRICT 2 SURVEY OFFICE

SHEET 35 OF _____

County Wood S.R. 65

Date 6-14-82
12-11-81

Township Washington

Weather Clear

Section 35

Temp. +33°


C.N, R.E

Personnel Hoffman


Loehrke

Householder

12

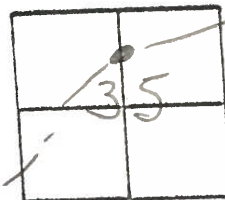


Pt. "A" Established 2-1-72 by Burnside
 Pt. "B" P.K. Nail @ surface - ORIGIN UNKNOWN
 Pt. "C" P.K./Shiner " " "
 Pt. "D" P.K. Nail " " "
 All pts on & PAUT, S.R. 65

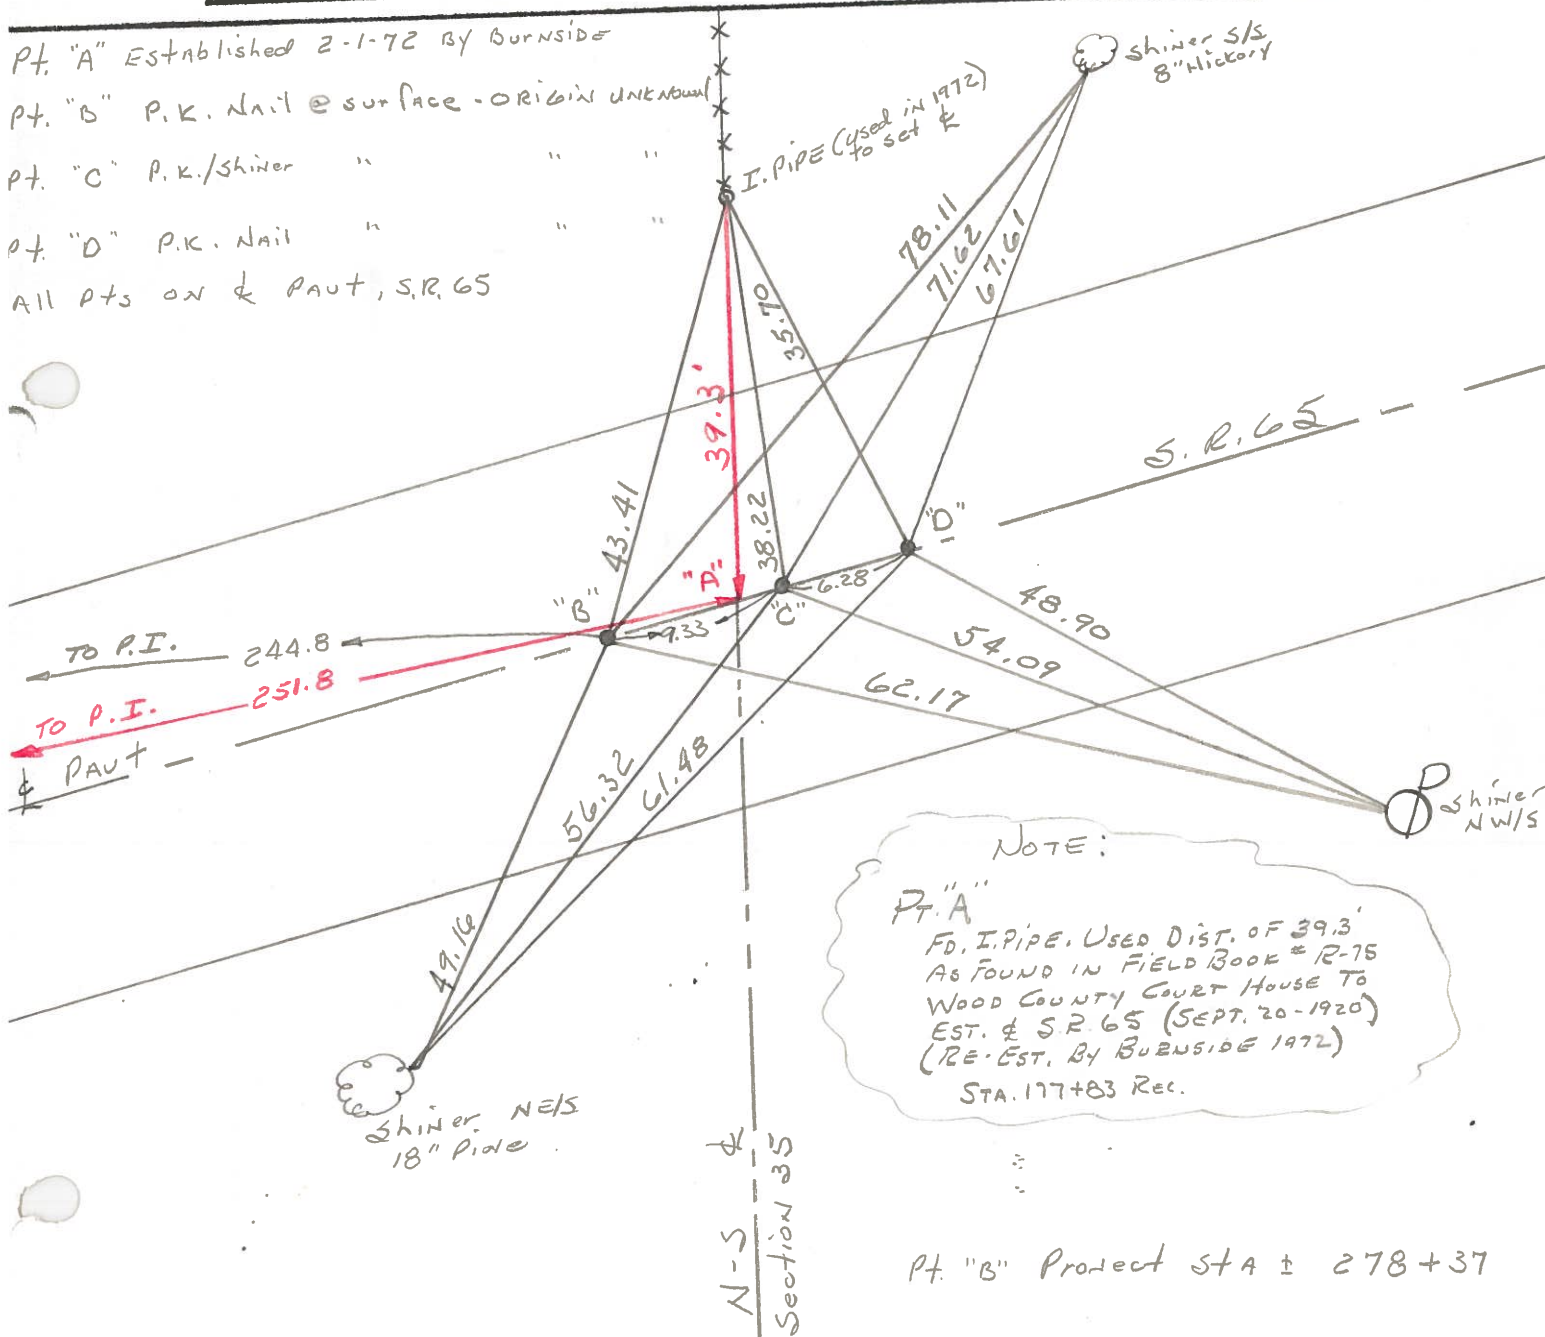

NOTE:
 Pt. "A"
 FD. I. PIPE. USED DIST. OF 39.3'
 AS FOUND IN FIELD BOOK # R-75
 WOOD COUNTY COURT HOUSE TO
 EST. & S.R. 65 (SEPT. 20-1920)
 (RE-EST. BY BURNSIDE 1972)
 STA. 177+83 REC.

Pt. "B" Project STA ± 278+37

12

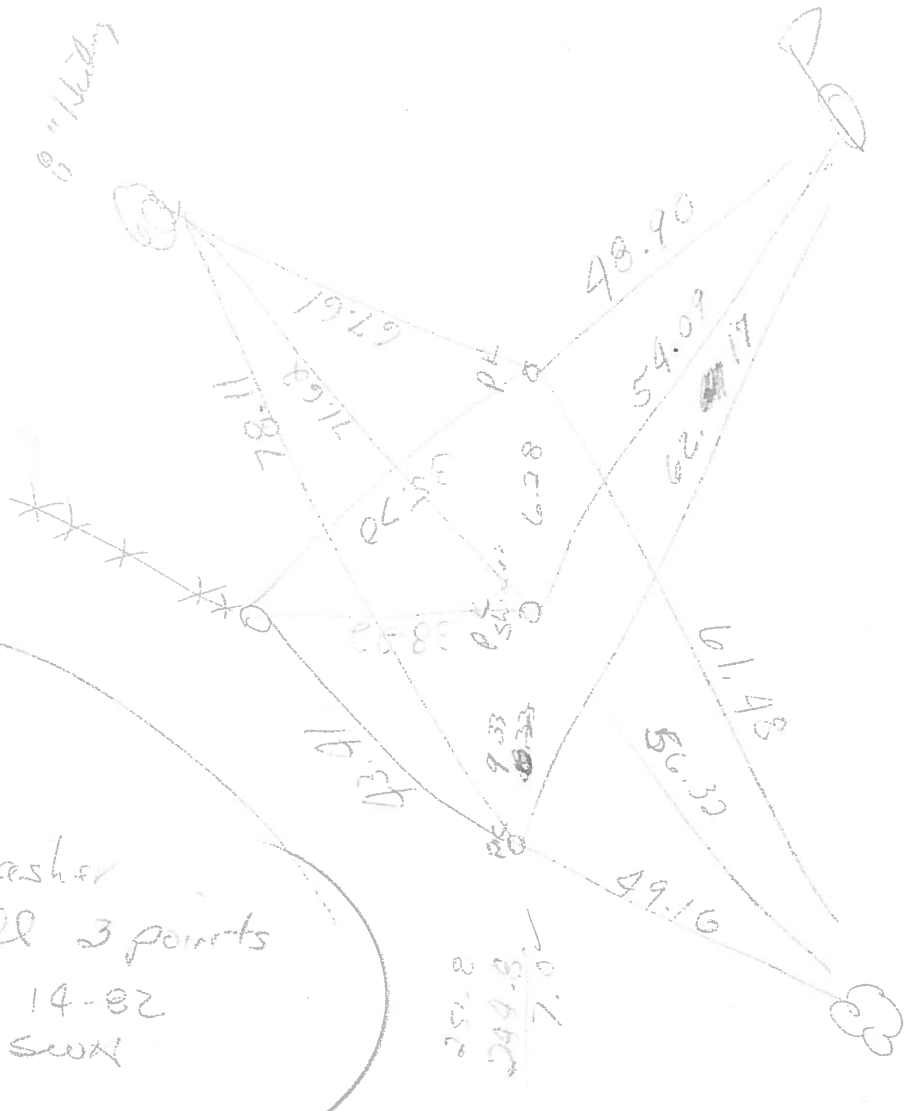

Set
 PK/washer
 @ all 3 points
 6-14-82
 SWM

sta
 278+37
 W.P.K.

@ 251.8

all m &

OD.O.T. DISTRICT 2 SURVEY OFFICE

SHEET OF

County Wood S.R. 65

Date 2-1-72

Township WASHINGTON

Weather CLOUDY

Section 35


Temp. 28°

T6N, R9E

Personnel BURNSIDE


SMITH

BOWER

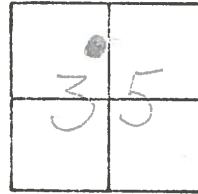

11-6
#12

FO. I. PIPE USED DIST.
OF 39.3' AS FOUND IN
FIELD BOOK # R-75 WOOD
COUNTY COURT HOUSE TA.
EST. E. 65 (SEPT. 20. 1920)

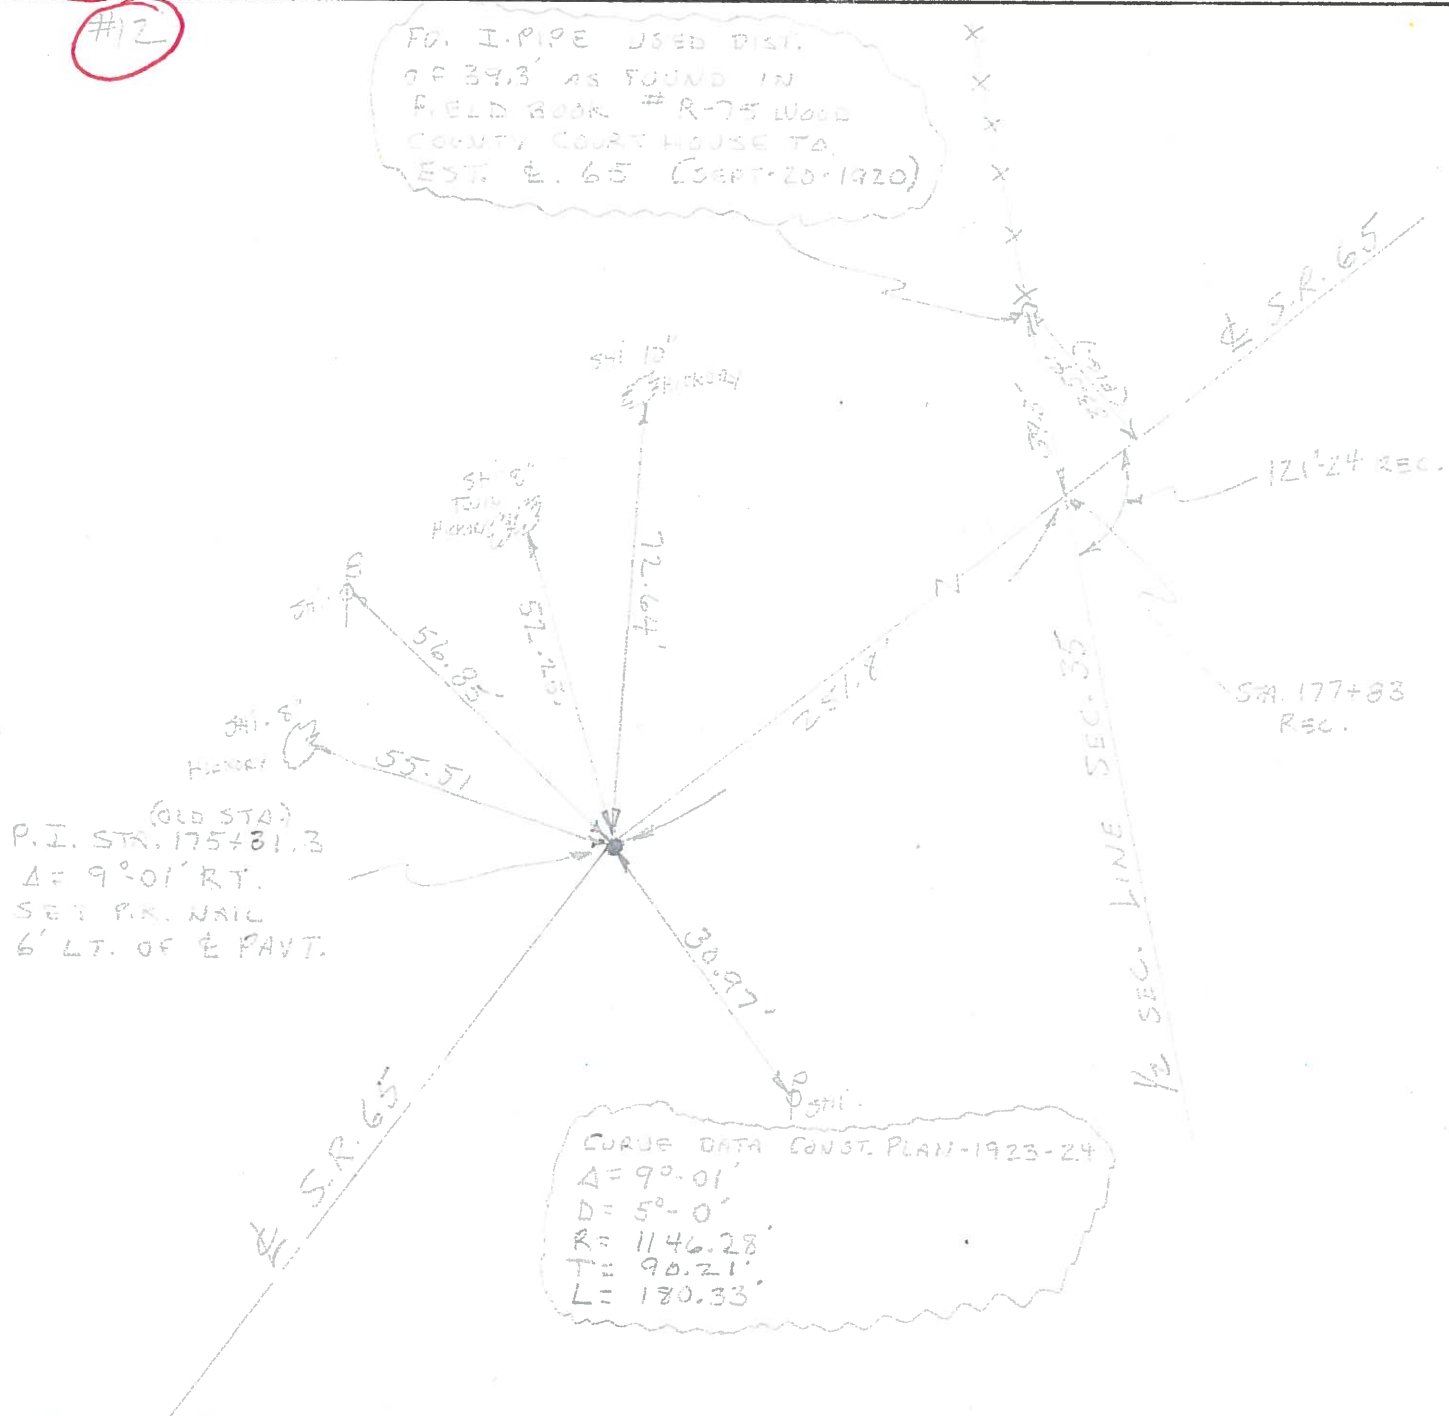

(OLD STA)
P.I. STA. 175+81.3
 $\Delta = 90^{\circ}01'$ RT.
SET P.K. NAIL
6' LT. OF E PAVT.

CURVE DATA CONST. PLAN-1923-24
 $\Delta = 90^{\circ}01'$
 $D = 5^{\circ}0'$
 $R = 1146.28$
 $T = 90.21'$
 $L = 180.33'$