
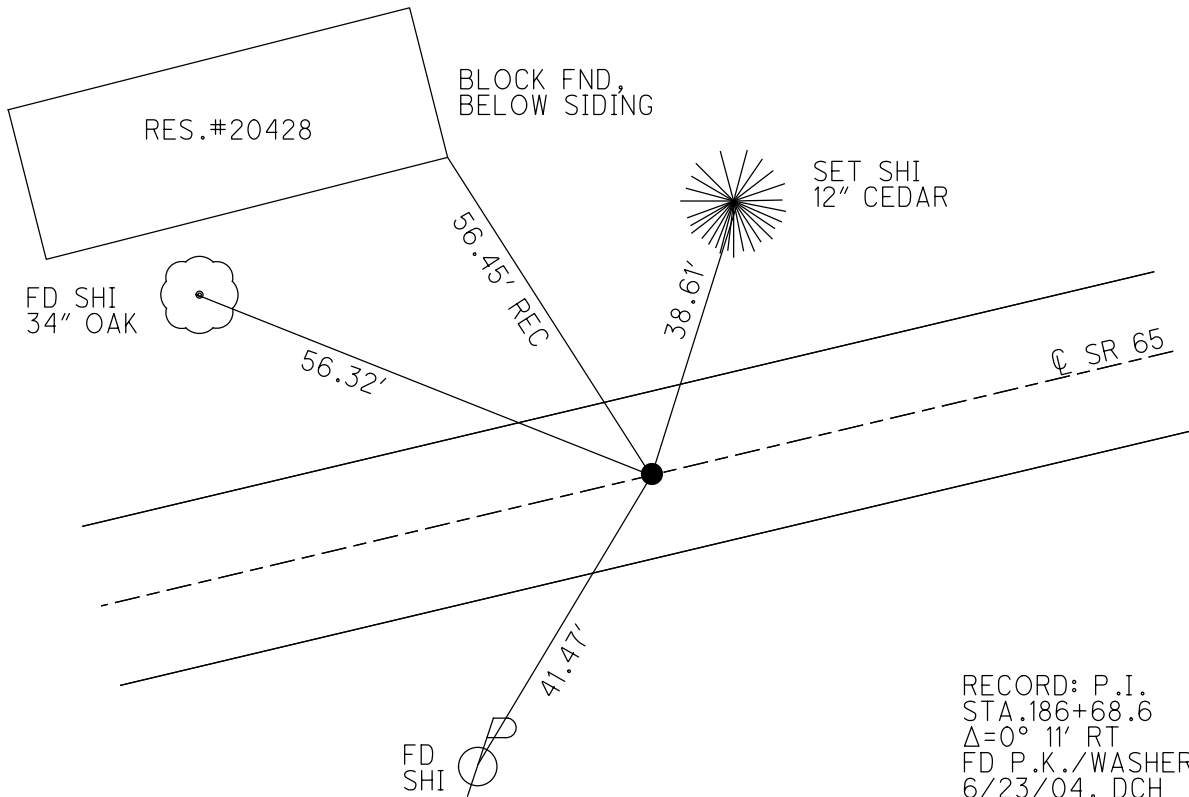


O.D.O.T. DISTRICT 2 SURVEY OFFICE (USE ONLY)

PERSONNEL _____ REFERENCE NO. 12 A SHEET 17 OF 22
 NOTES RHOADES DATE 4/27/21 ROUTE SR 65
 H.C. O'DONNELL WEATHER SUNNY COUNTY WOOD
 R.C. RHOADES TEMP. 70° TOWNSHIP WASHINGTON
 DWG BY RHOADES PID 95796 SECTION 35
 T 6 N R 9 E

TYPE MONUMENT MAG SHANK
 ON SURFACE - ~~BELOW~~ ON _____
 OFFSET ☐ PAVEMENT ON _____ LT : RT
10.2' TO LT EDGE PAVEMENT
 STATION: 287+15.07

HORIZ.DATUM: NAD83 2011 GEOID: NAVD88 2018
 GRID: NORTHING: 649174.860 EASTING: 1613838.925

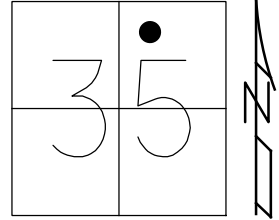

RECORD: P.I.
 STA. 186+68.6
 $\Delta=0^{\circ} 11' RT$
 FD P.K./WASHER
 6/23/04, DCH
 SET MAG/WASHER
 9/16/04, SAH
 FD MAG SHANK
 REFA12
 11/4/20, JFO
 SET MAG/WASHER
 10/6/22, TDN

O.D.O.T. DISTRICT 2 SURVEY OFFICE

PERSONNEL

REFERENCE NO. 17-A

SHEET 43 OF 49

NOTES Duhfer

H.C. Homan

R.C. Atkins

DATE 6-23-04

WEATHER Sunny

TEMP. 75°F

ROUTE S.R. 65

COUNTY Wood

TOWNSHIP Washington

SECTION 35

T6N R9E


TYPE MONUMENT PK/W

ON SURFACE - BELOW Surface

LEFT - & PAV'T. - RIGHT on &


10.2' TO lt. EDGE PAVEMENT

S.L.M. 287+15

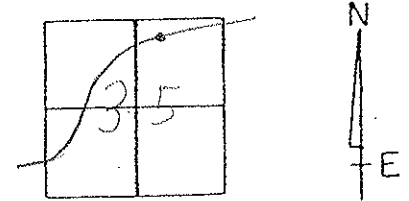

Record:
P.I. 186+68.6
 $\Delta = 0^{\circ} - 11' RT$

Set Mas/W
9-16-04
SAH

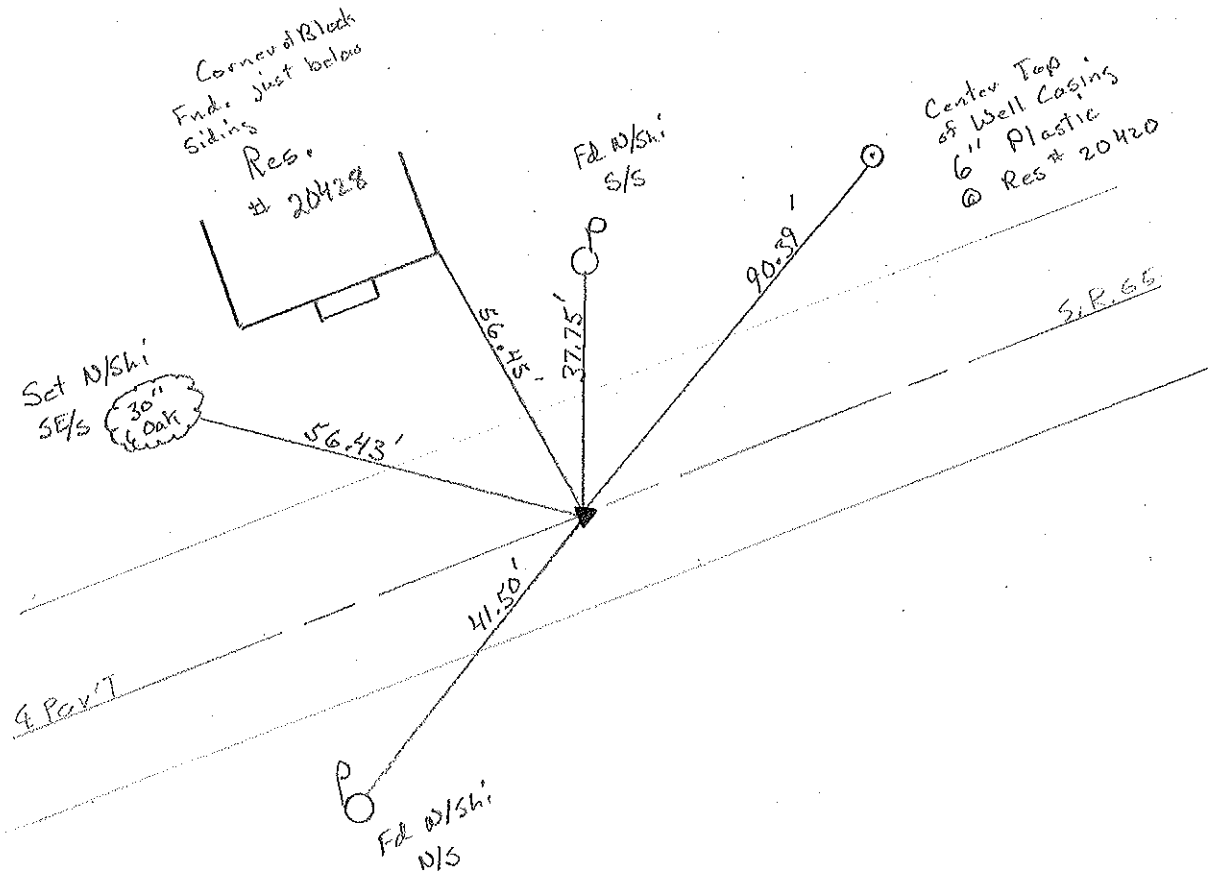

O.D.O.T. DISTRICT 2 SURVEY OFFICE

PERSONNEL

REFERENCE NO. 12 A

SHEET 28 OF 34

NOTES BARNHISEL

H.C. VAN DUSEN

R.C. BARNHISEL

DATE 4-20-92

WEATHER SUNNY

TEMP. +70°

ROUTE SR 65

COUNTY WOOD

TOWNSHIP WASHINGTON

SECTION 35

Set P.K./WASHER

5-1-92

C.L.

T 6 N R 9 E


TYPE MONUMENT Sm RR Spk

ON SURFACE - BELOW 2 1/2"

LEFT - & PAV'T. - RIGHT yes

9.6 TO RT EDGE PAVEMENT


S.L.M. 287 +17

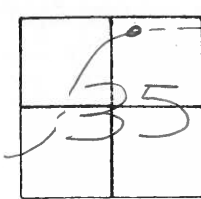

RECORD:

P.I. 186+68.6

$\Delta = 0^\circ - 11' \text{ RT.}$

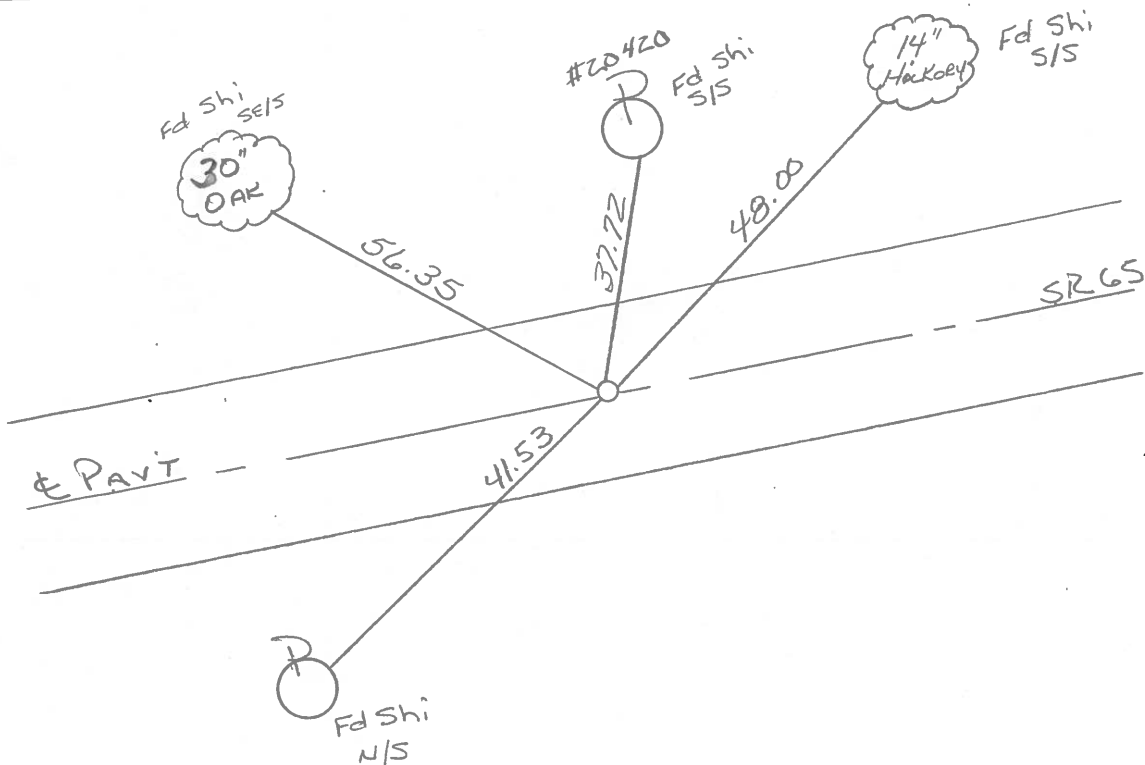

OD.O.T. DISTRICT 2 SURVEY OFFICE

SHEET 36 OF

6-14-82

Date 12-14-81

Weather cloudy

Temp. +34°

township Wood S.R. 65


Section 35

C.N, R.E


Personnel Hoffman

Householder

12-A

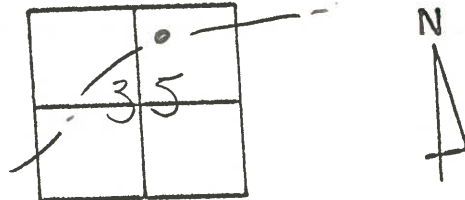

Fd small R.R. spk @ surface @ ctr of PAUT - Project sta ± 287+29
 8.8 to N.E.P.
 9.0 to S.E.P.

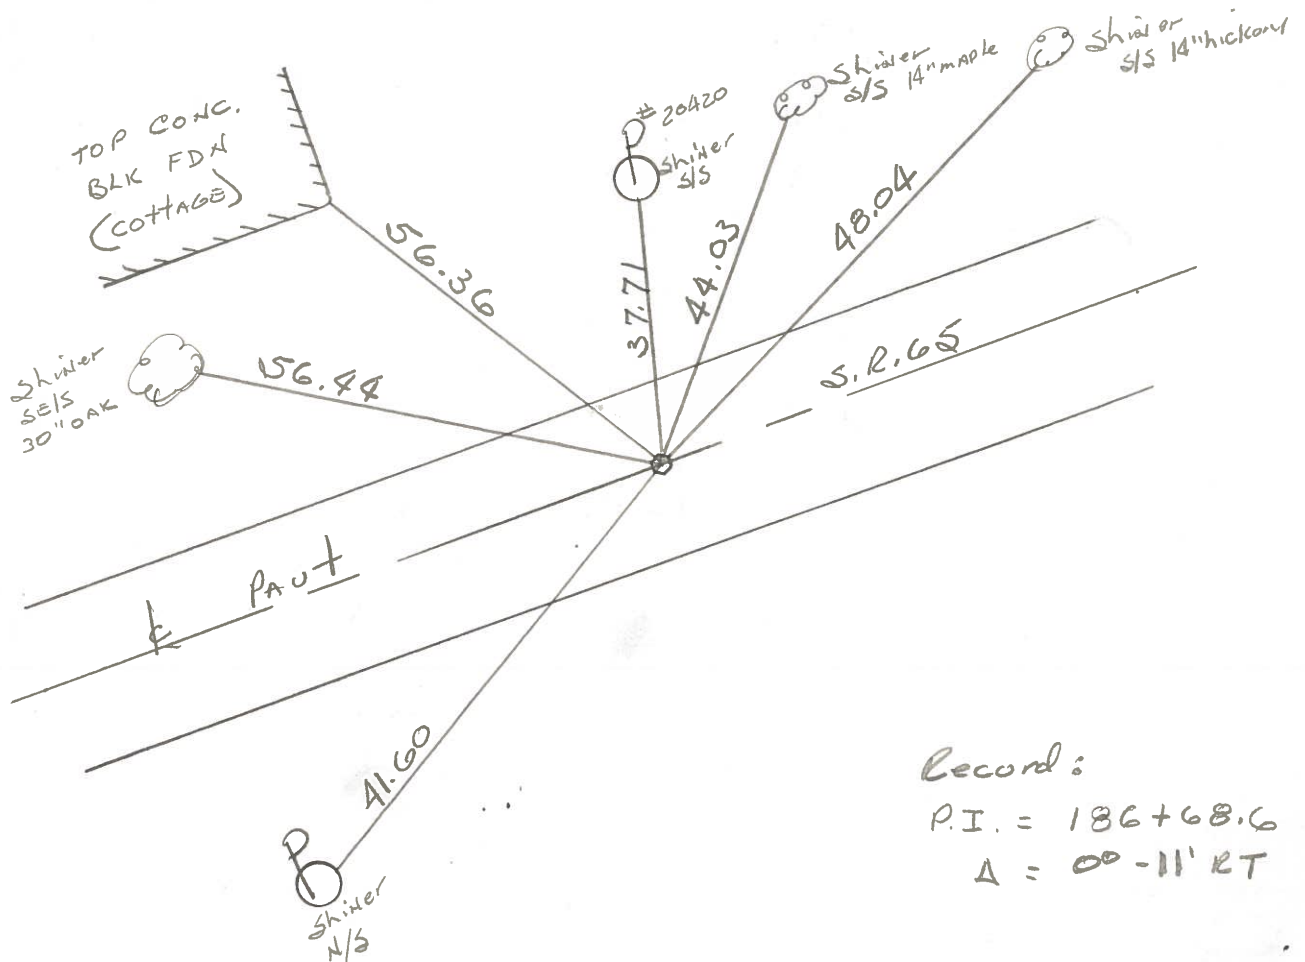


Record:

P.I. = 186+68.6

Δ = 00-11' RT

PERSONNEL	TITLE	PERSONNEL	TITLE	COUNTY	<u>WOOD</u>	DATE	<u>2-1-72</u>
<u>BURNSIDE</u>				S. R.	<u>65</u>	WEATHER	<u>CLOUDY</u>
<u>SMITH</u>				SEC.	<u>WASHINGTON TWP</u>	TEMP.	<u>+28°</u>
<u>BOWERS</u>							

DESCRIPTION _____ LEFT _____ CENTER LINE _____ RIGHT _____ JOB NO. _____

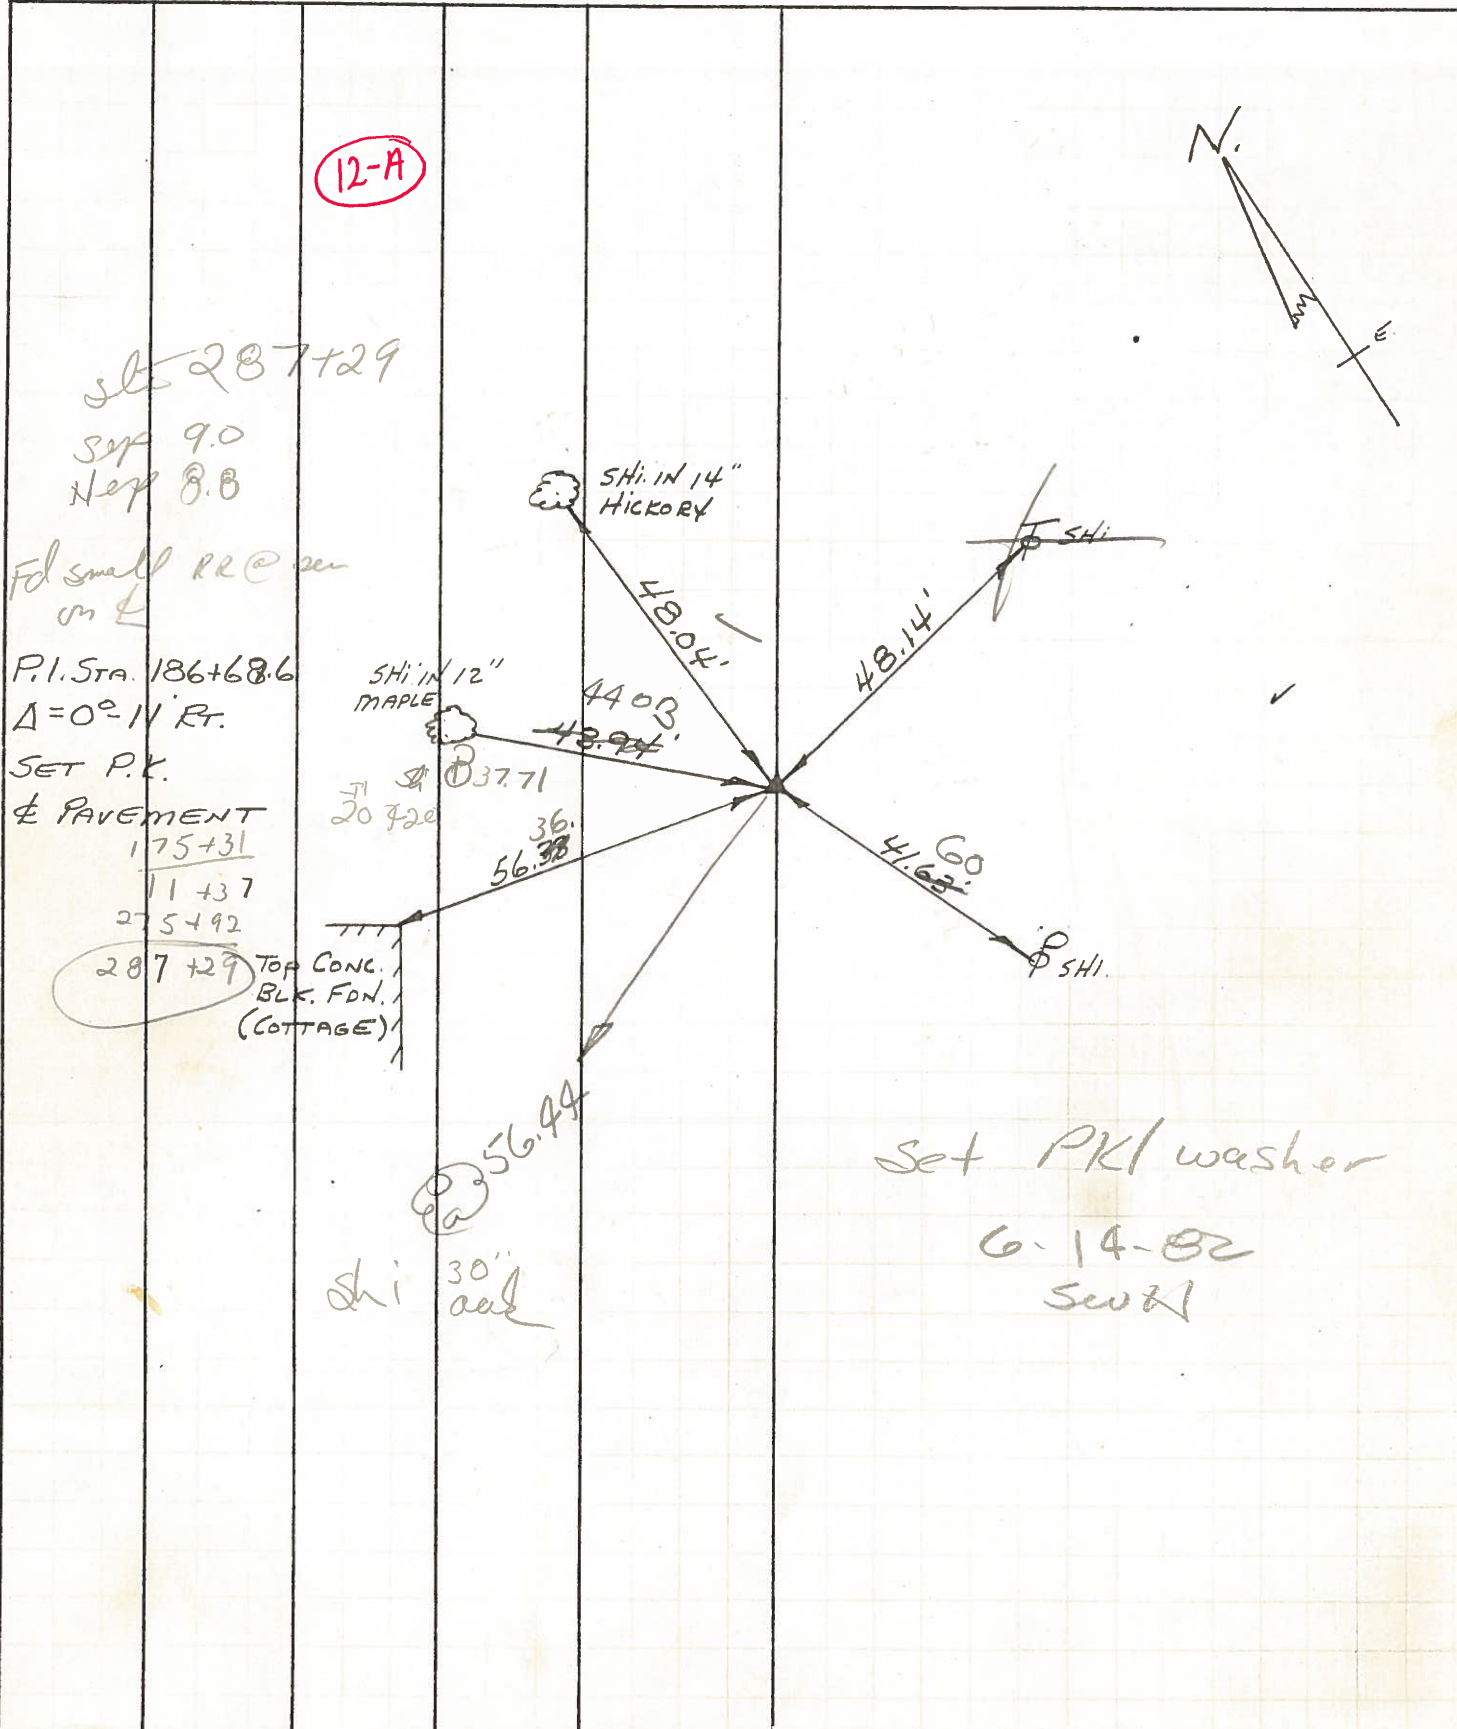

PERSONNEL	TITLE	PERSONNEL	TITLE
BURNSIDE			
SMITH			
BOWERS			

COUNTY Wood DATE 2-1-72

S. R. 65 WEATHER Cloudy

SEC. WASHINGTON TWP TEMP. +28°

DESCRIPTION _____ LEFT _____ CENTER LINE _____ RIGHT _____ JOB NO. _____

