

O.D.O.T. DISTRICT 2 SURVEY OFFICE (USE ONLY)

PERSONNEL _____ REFERENCE NO. 12 D SHEET 20 OF 22
 NOTES NIESE DATE 2/16/24 ROUTE SR 65
 H.C. NIESE WEATHER FAIR COUNTY WOOD
 R.C. ASTON TEMP. 32° TOWNSHIP WASHINGTON
 DWG BY RHOADES PID 93680 SECTION 35
 T 6 N R 9 E


TYPE MONUMENT MAG/WASHER

ON SURFACE - ~~BELOW~~ ON _____


OFFSET \odot PAVEMENT 1.2' LT : ~~RT~~
8.8' TO LT EDGE PAVEMENT

STATION: 301+80.87

HORZ. DATUM: NAD83 2011 GEOID: NAVD88 2018
 GRID: NORTHING: 650027.507 EASTING: 1615026.421

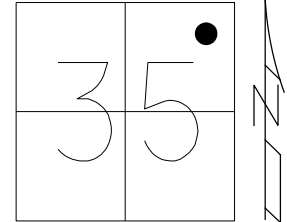


RECORD: P.I.
 $\Delta = 3^\circ 50'$
 $D = 2^\circ 0'$
 $R = 2864.93$
 $T = 25.98$
 $L = 191.66$
 FD P.K./WASHER
 6/23/04, DCH
 SET MAG/WASHER
 9/16/04, SAH
 FD MAG/WASHER
 REFD12
 11/4/20, JFO
 SET MAG/WASHER
 10/7/22, TDN
 FD MAG/WASHER
 REF12D
 2/16/24, TDN

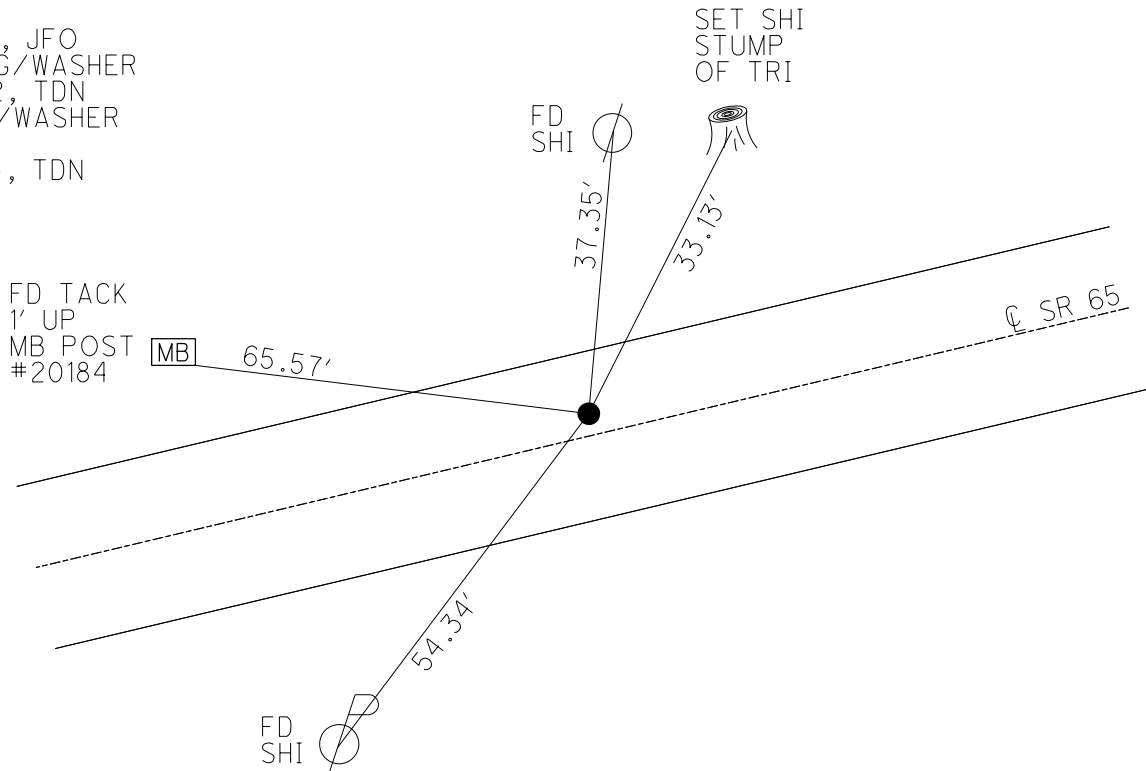

O.D.O.T. DISTRICT 2 SURVEY OFFICE (USE ONLY)


PERSONNEL _____ REFERENCE NO. 12 D SHEET 20 OF 22
 NOTES RHOADES DATE 4/11/22 ROUTE SR 65
 H.C. NIESE WEATHER FAIR COUNTY WOOD
 R.C. KETNER TEMP. 63° TOWNSHIP WASHINGTON
O'DONNELL SECTION 35
 DWG BY RHOADES PID 95796 T 6 N R 9 E

TYPE MONUMENT MAG/WASHER
 ON SURFACE - ~~BELOW~~ ON _____
 OFFSET \odot PAVEMENT 1.2' LT : ~~RT~~
8.8' TO LT EDGE PAVEMENT
 STATION: 301+80.87

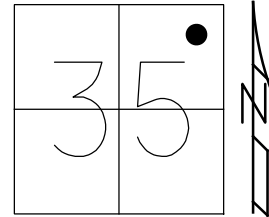

HORZ.DATUM: NAD83 2011 GEOID: NAVD88 2018
 GRID: NORTHING: 650027.542 EASTING: 1615026.429

RECORD: P.I.
 $\Delta = 3^\circ 50'$
 $D = 2^\circ 0'$
 $R = 2864.93$
 $T = 25.98$
 $L = 191.66$
 FD P.K./WASHER
 6/23/04, DCH
 SET MAG/WASHER
 9/16/04, SAH
 FD MAG/WASHER
 REFD12
 11/4/20, JFO
 SET MAG/WASHER
 10/7/22, TDN

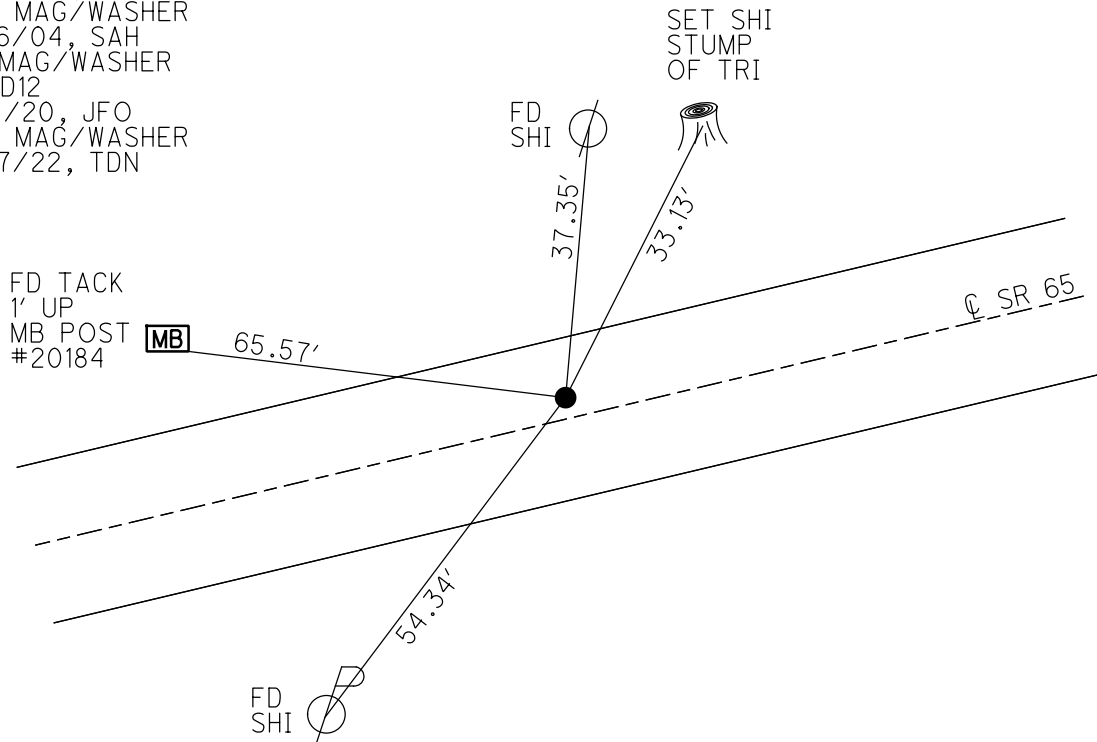

O.D.O.T. DISTRICT 2 SURVEY OFFICE

PERSONNEL

REFERENCE NO. 12 D

SHEET 46 OF 49

NOTES Newton

H.C. Homan

R.C. Atkins

DATE 6-23-04

WEATHER Sunny

TEMP. + 77°F

ROUTE S.R. 65

COUNTY Wood

TOWNSHIP Washington

SECTION 35

T.G.N.R. 9 E



TYPE MONUMENT PK/w

~~ON SURFACE~~ ~~BELOW~~ Surface

~~LEFT~~ ~~RIGHT~~ 1.2' Lt.


8.8' TO Lt. EDGE PAVEMENT

S.L.M. 301+82

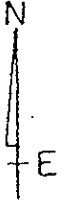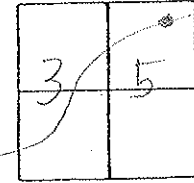

Record:
 P.I. 201+34.6
 $\Delta = 3^{\circ} 50'$
 $D = 20.0'$
 $R = 2864.93$
 $T = 25.98$
 $L = 191.66$

Set Mas/w
9-16-04
SAH.

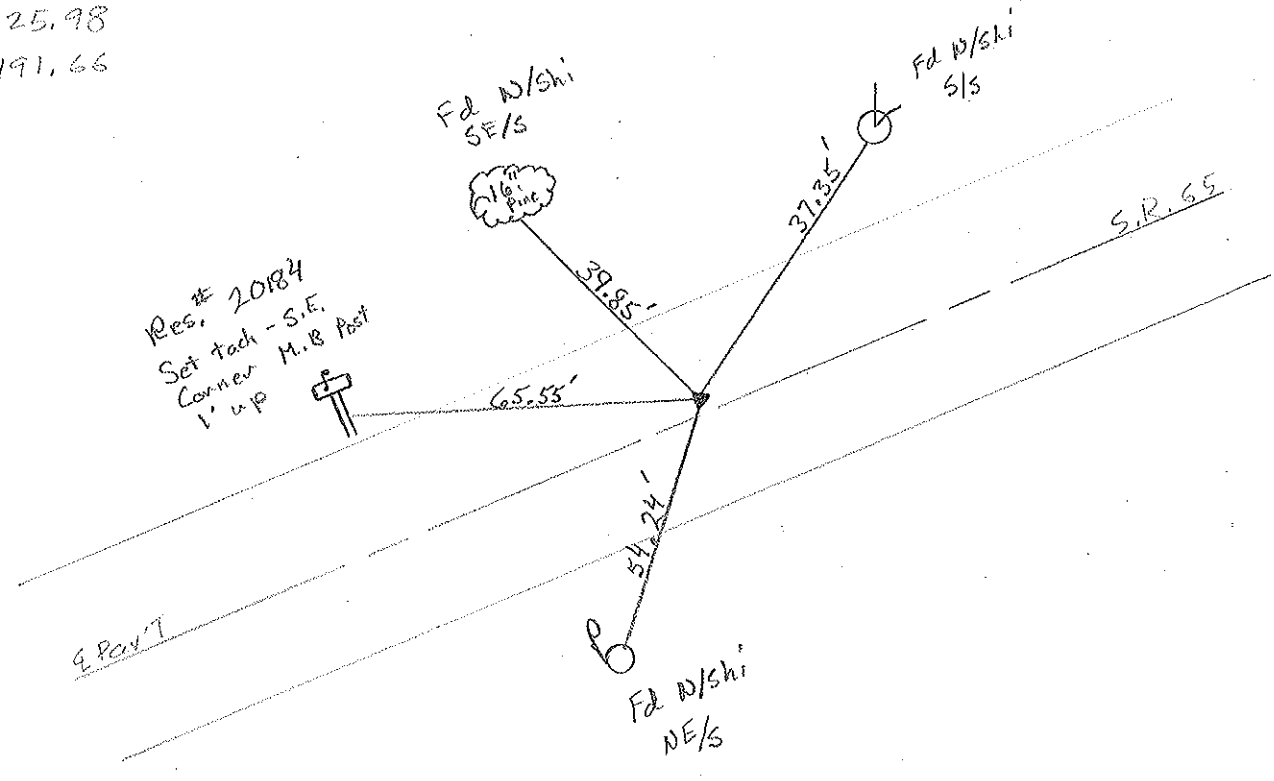

Res. # 2084
 Set tack - S.E.
 Corner M.B. Post
 1' up



O.D.O.T. DISTRICT 2 SURVEY OFFICE

PERSONNEL

REFERENCE NO. 12 D

SHEET 31 OF 34

NOTES BARNHISEL

H.C. CurTIS

DATE 4-17-92

ROUTE 65

R.C. Van DUSEN

WEATHER RAIN

COUNTY WOOD

LoehrKE

TEMP. +50°

TOWNSHIP WASHINGTON

Pometo

Set P.K./WASHER

SECTION 35

5-1-92

T. 6 N. R. 9 E

C.L.


TYPE MONUMENT PK & WASHER

ON SURFACE - ~~BELOW~~ YES

LEFT- & PAV'T. - ~~RIGHT~~ 1.3

8.3 TO LT EDGE PAVEMENT

S.L.M. 301 + 82

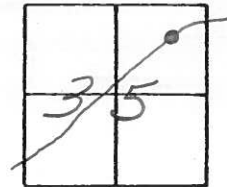

RECORD:

P.I. 201 + 34.6


$\Delta = 3^{\circ} - 50'$

$D = 2^{\circ} - 0'$

$R = 2864.93$

$T = 25.98$

$L = 191.66$

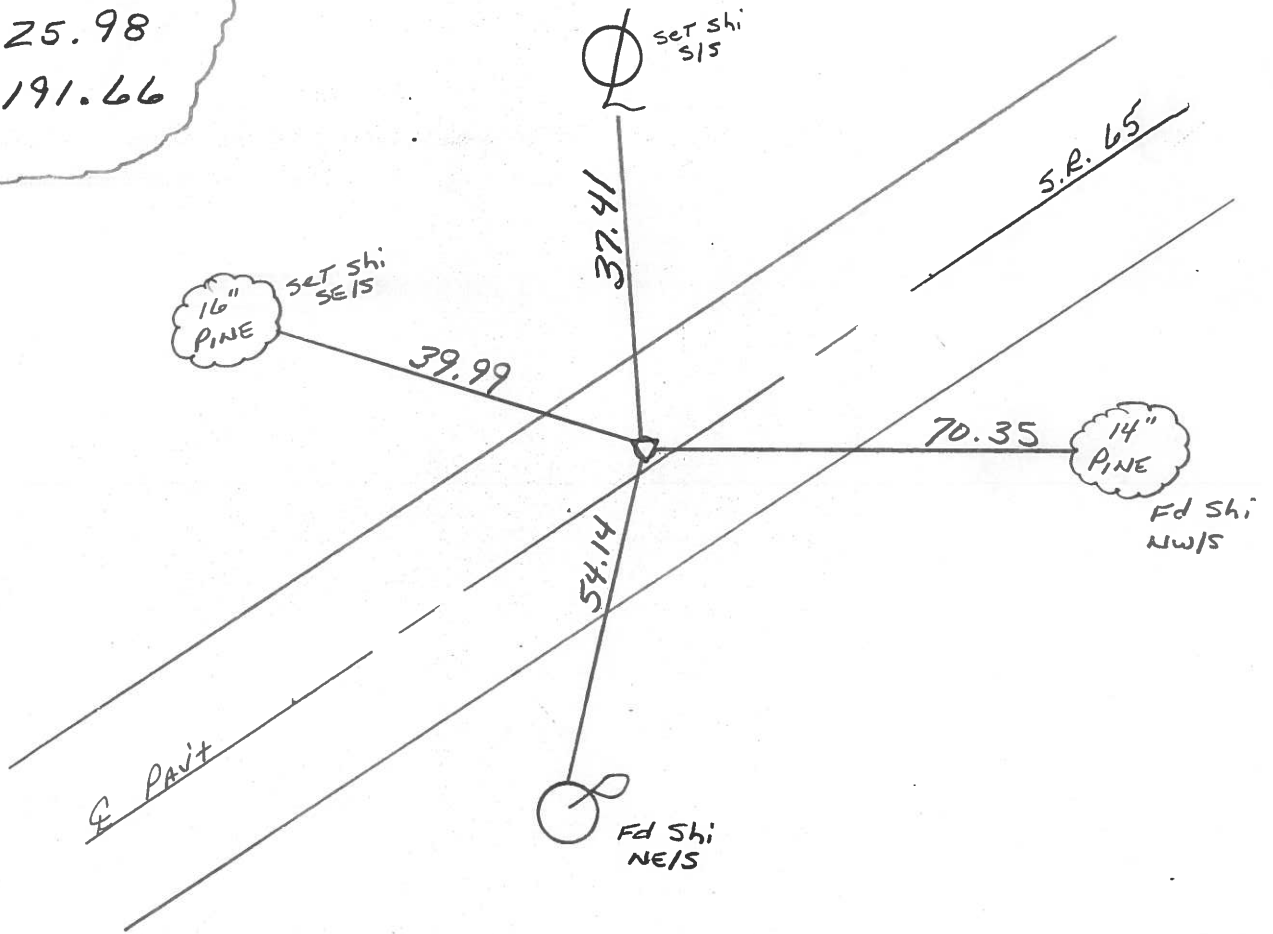

O.D.O.T. DISTRICT 2 SURVEY OFFICE

SHEET 39 OF

County Wood S.R. 65

Date 6-14-82
12-14-81

Township Washington

Weather Partly Clear

Section 35

Temp. +34°

T.N, R.E

Personnel Hoffman


12-D



Householder

Fd. small R.R. spk. @ surface
1.5' Lt. of R PAUT
7.7' TO N.E.P.
10.7' TO S.E.P.


Project Sta ± 301+95

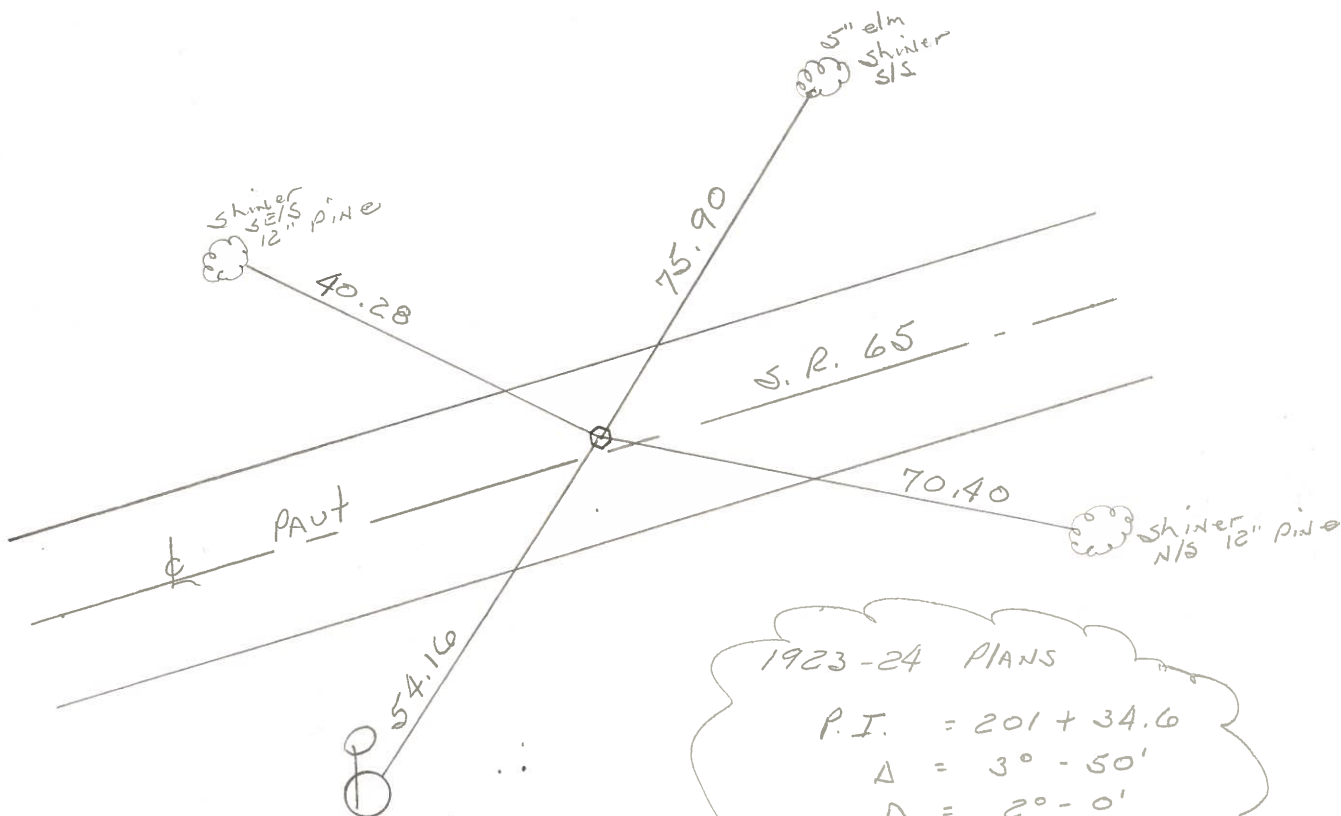

1923-24 PLANS
P.I. = 201+34.6
Δ = 3° - 50'
D = 2° - 0'
R = 2864.93
T = 25.98'
L = 191.66

PERSONNEL	TITLE	PERSONNEL	TITLE	COUNTY	<u>WOOD</u>	DATE	<u>2-2-72</u>
<u>BURNSIDE</u>				S. R.	<u>65</u>	WEATHER	<u>PT. CLOUDY</u>
<u>SMITH</u>				SEC.	<u>WASHINGTON TWP</u>	TEMP.	<u>+30°</u>

DESCRIPTION _____ LEFT _____ CENTER LINE _____ RIGHT _____ JOB NO. _____

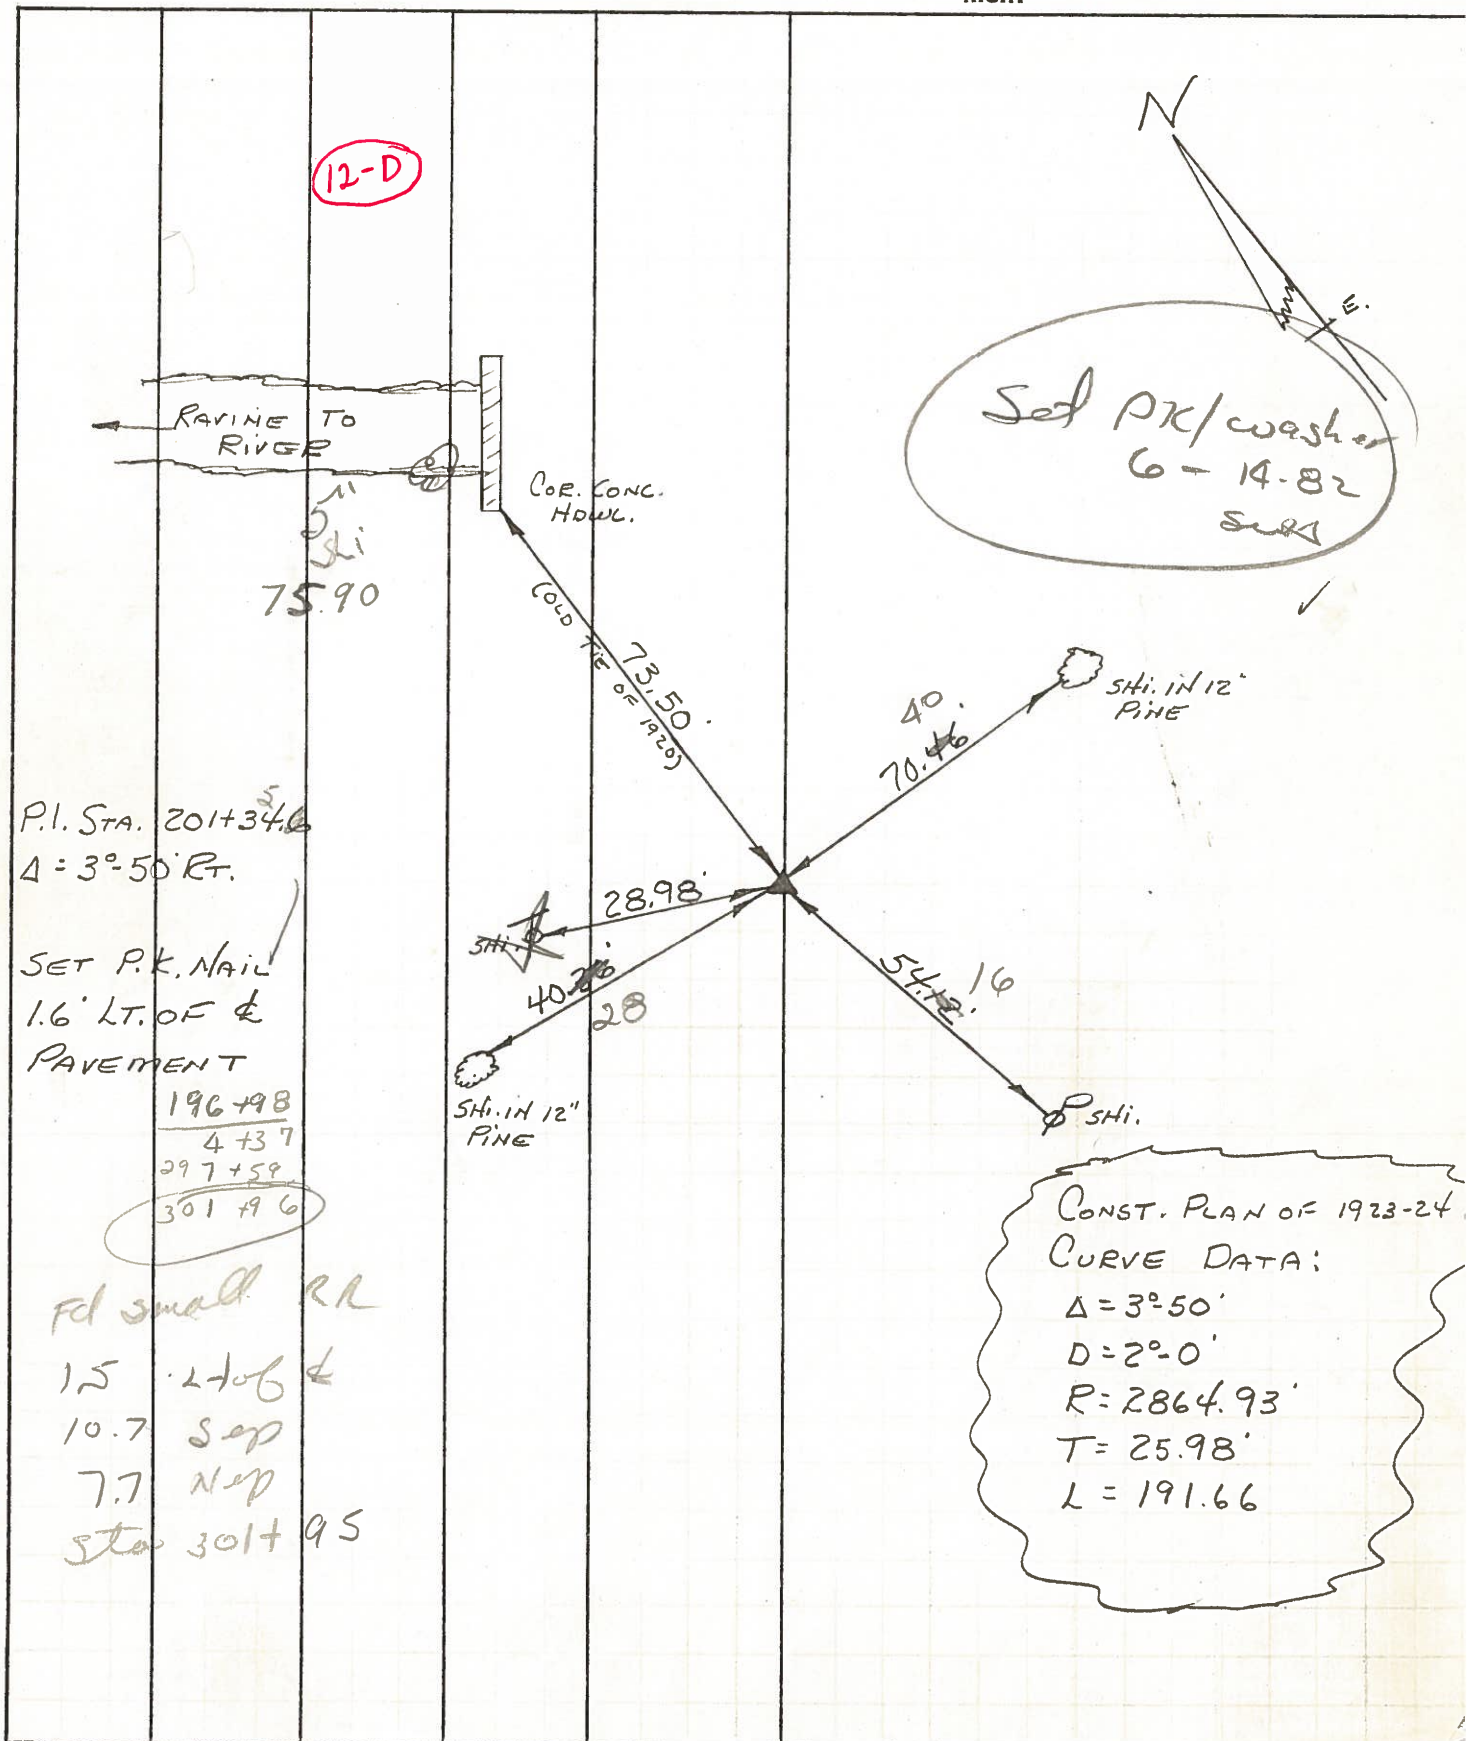

P.I. STA. 201134.6
 $\Delta = 3^\circ 50' \text{ Rt.}$

SET P.K. NAIL
 1.6' LT. OF &
 PAVEMENT

196+98
4+37
297+59
<u>301+96</u>

Fd small RR
 15' 2" top &
 10.7' sup
 7.7' nap
 sta 301+95

CONST. PLAN OF 1923-24
 CURVE DATA:
 $\Delta = 3^\circ 50'$
 $D = 2^\circ 0'$
 $R = 2864.93'$
 $T = 25.98'$
 $L = 191.66'$

PERSONNEL BURNSIDE TITLE _____
 PERSONNEL SMITH TITLE _____

COUNTY Wood DATE 2-2-72

S. R. 65 WEATHER PT CLOUDY

SEC. WASHINGTON TWP TEMP. +30°

DESCRIPTION _____ LEFT _____ CENTER LINE _____ RIGHT _____ JOB NO. _____

