

O.D.O.T. DISTRICT 2 SURVEY OFFICE (USE ONLY)

PERSONNEL

REFERENCE NO. 12 F

SHEET 1 OF 63

NOTES RHOADES

DATE 4/11/22

ROUTE SR 65

H.C. NIESE

WEATHER FAIR

COUNTY WOOD

R.C. KETNER

TEMP. 63°

TOWNSHIP WASHINGTON

O'DONNELL

SECTION 35

DWG BY RHOADES PID 95796

T 6 N R 9 E

TYPE MONUMENT MAG SHANK

ON SURFACE - ~~BELOW~~ ON

OFFSET Q PAVEMENT 4.4' ~~±~~ : RT

6.2' TO RT EDGE PAVEMENT



STATION: 306+71.32

HORZ. DATUM: NAD83 2011

GEOID: NAVD88 2018

GRID: NORTHING: 650328.746

EASTING: 1615413.660

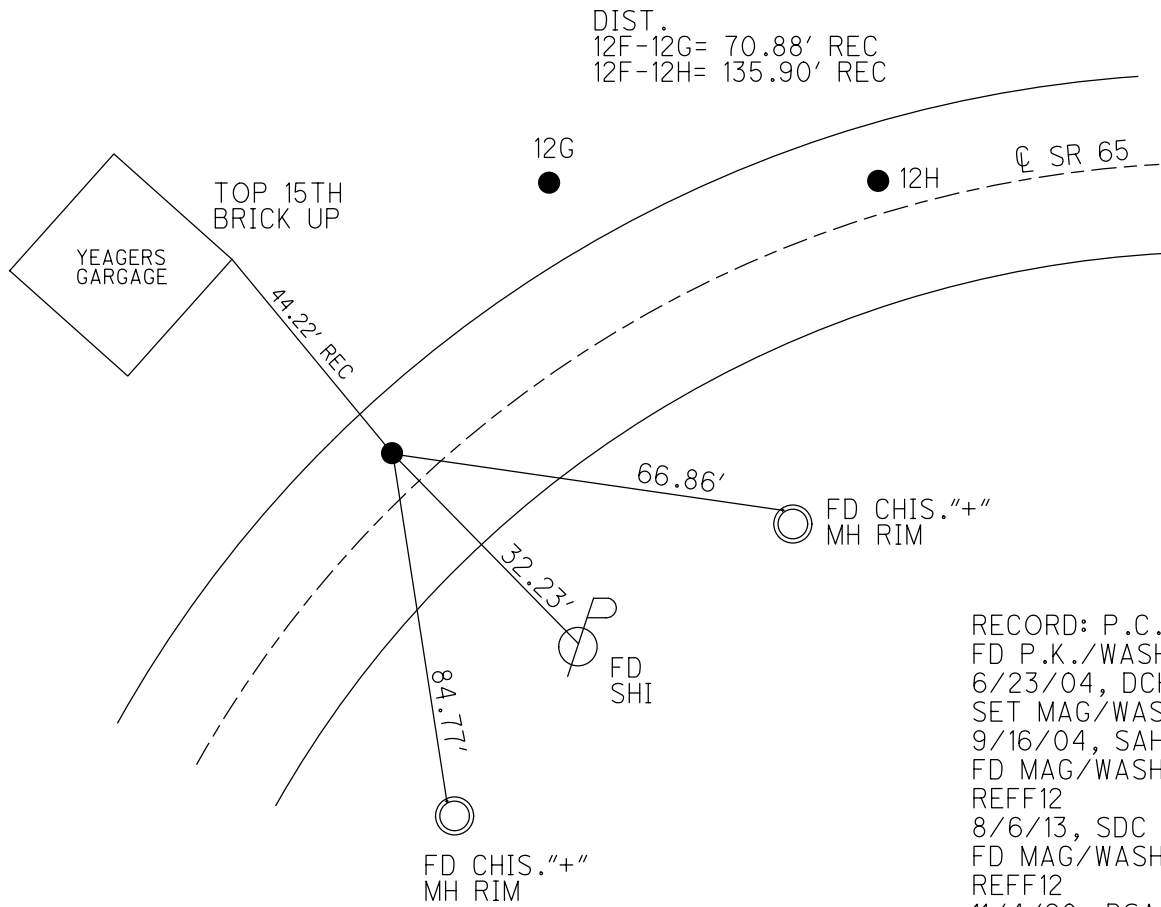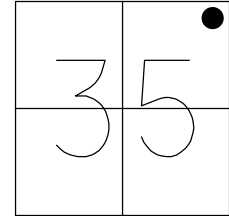

RECORD: P.C.  
 FD P.K./WASHER  
 6/23/04, DCH  
 SET MAG/WASHER  
 9/16/04, SAH  
 FD MAG/WASHER  
 REFF12  
 8/6/13, SDC  
 FD MAG/WASHER  
 REFF12  
 11/4/20, DSA  
 SET MAG/WASHER  
 10/7/22, TDN

O.D.O.T. DISTRICT 2 SURVEY OFFICE (USE ONLY)

PERSONNEL

REFERENCE NO. 12 F

SHEET 1 OF 63

NOTES NUHFER

DATE 6/23/04

ROUTE SR 65

H.C. HOMAN

WEATHER SUNNY

COUNTY WOOD

R.C. ADKINS

TEMP. 78°

TOWNSHIP WASHINGTON

SECTION 35

T 6 N R 9 E

TYPE MONUMENT PK/WASHER


ON SURFACE - ~~BELOW~~ ON

LEFT - PAV'T - ~~RIGHT~~ 4.4'


6.2' TO LT EDGE PAVEMENT

S.L.M. 306+96.30

Grid: Northing: 650328.768 Easting: 1615413.684

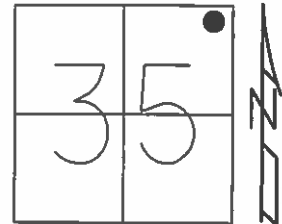

RECORD: P.C.  
 SET MAG/WASHER  
 9/16/04, SAH  
 FD MAG/WASHER  
 8/5/13  
 GPS, REFF12  
 8/6/13, SDC

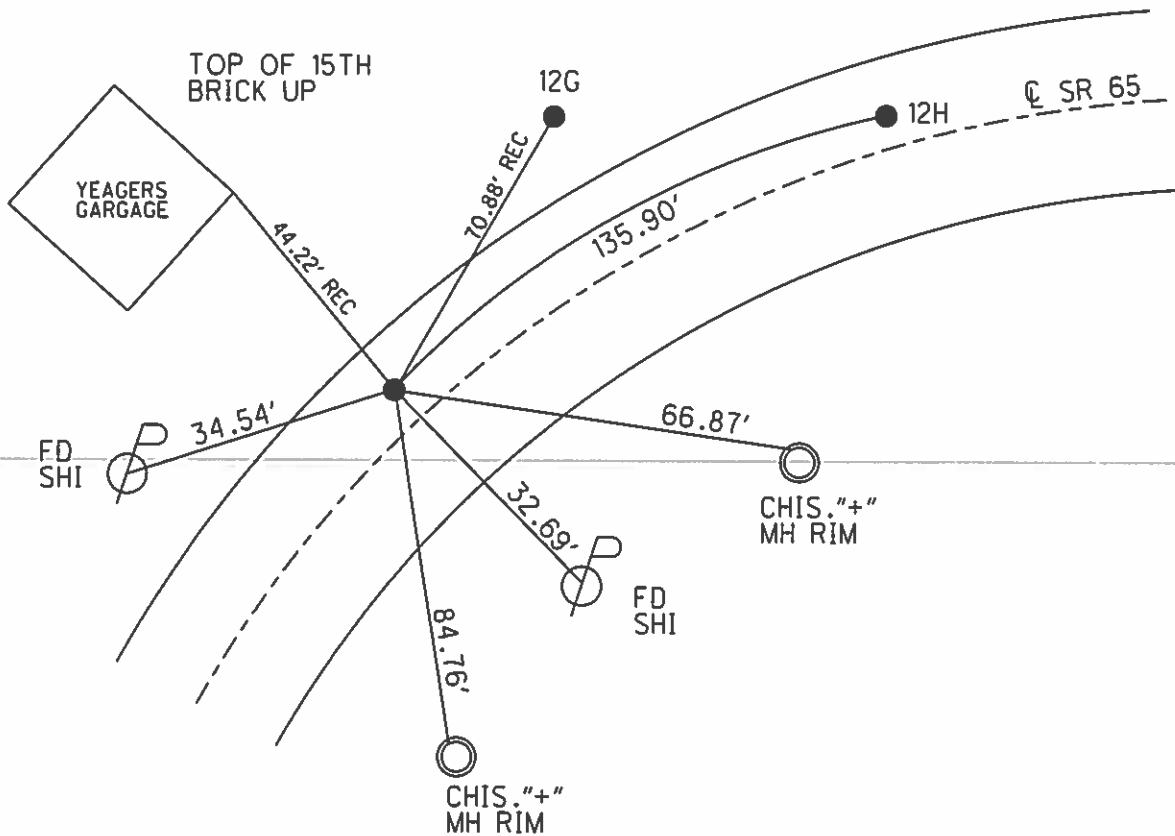

# O.D.O.T. DISTRICT 2 SURVEY OFFICE

PERSONNEL

REFERENCE NO. 12 F

SHEET 48 OF 49

NOTES Nuhter

H.C. Homan

R.C. Atkins

DATE 6-23-04

WEATHER Sunny

TEMP. +78°F

ROUTE S.R. 65

COUNTY Wood

TOWNSHIP Washington

SECTION 35

T6 N R 9 E


TYPE MONUMENT Pts B+C PK/W

ON SURFACE - ~~REASON~~ Surface

LEFT - ~~RIGHT~~ B - 4.4' Lt. - C - 4.7' Lt.

B - 6.2' Lt.  
C - 5.7' TO Lt. EDGE PAVEMENT


S.L.M. B - 306+73 C - 308+07

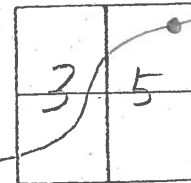

Record: A  
P.I. 206+90.4  
Const Plans 1923-24  
 $\Delta = 32^\circ - 24' \text{ Rec}$   
 $32^\circ - 52' \text{ RT} \sim \text{meas in 1972}$   
 $D = 24^\circ - 0'$   
 $R = 240.49$   
 $T = 69.87$   
 $L = 135.00$

(135.90' between Pts)

Set Mag/w  
Pts B+C  
9-16-04  
SAH

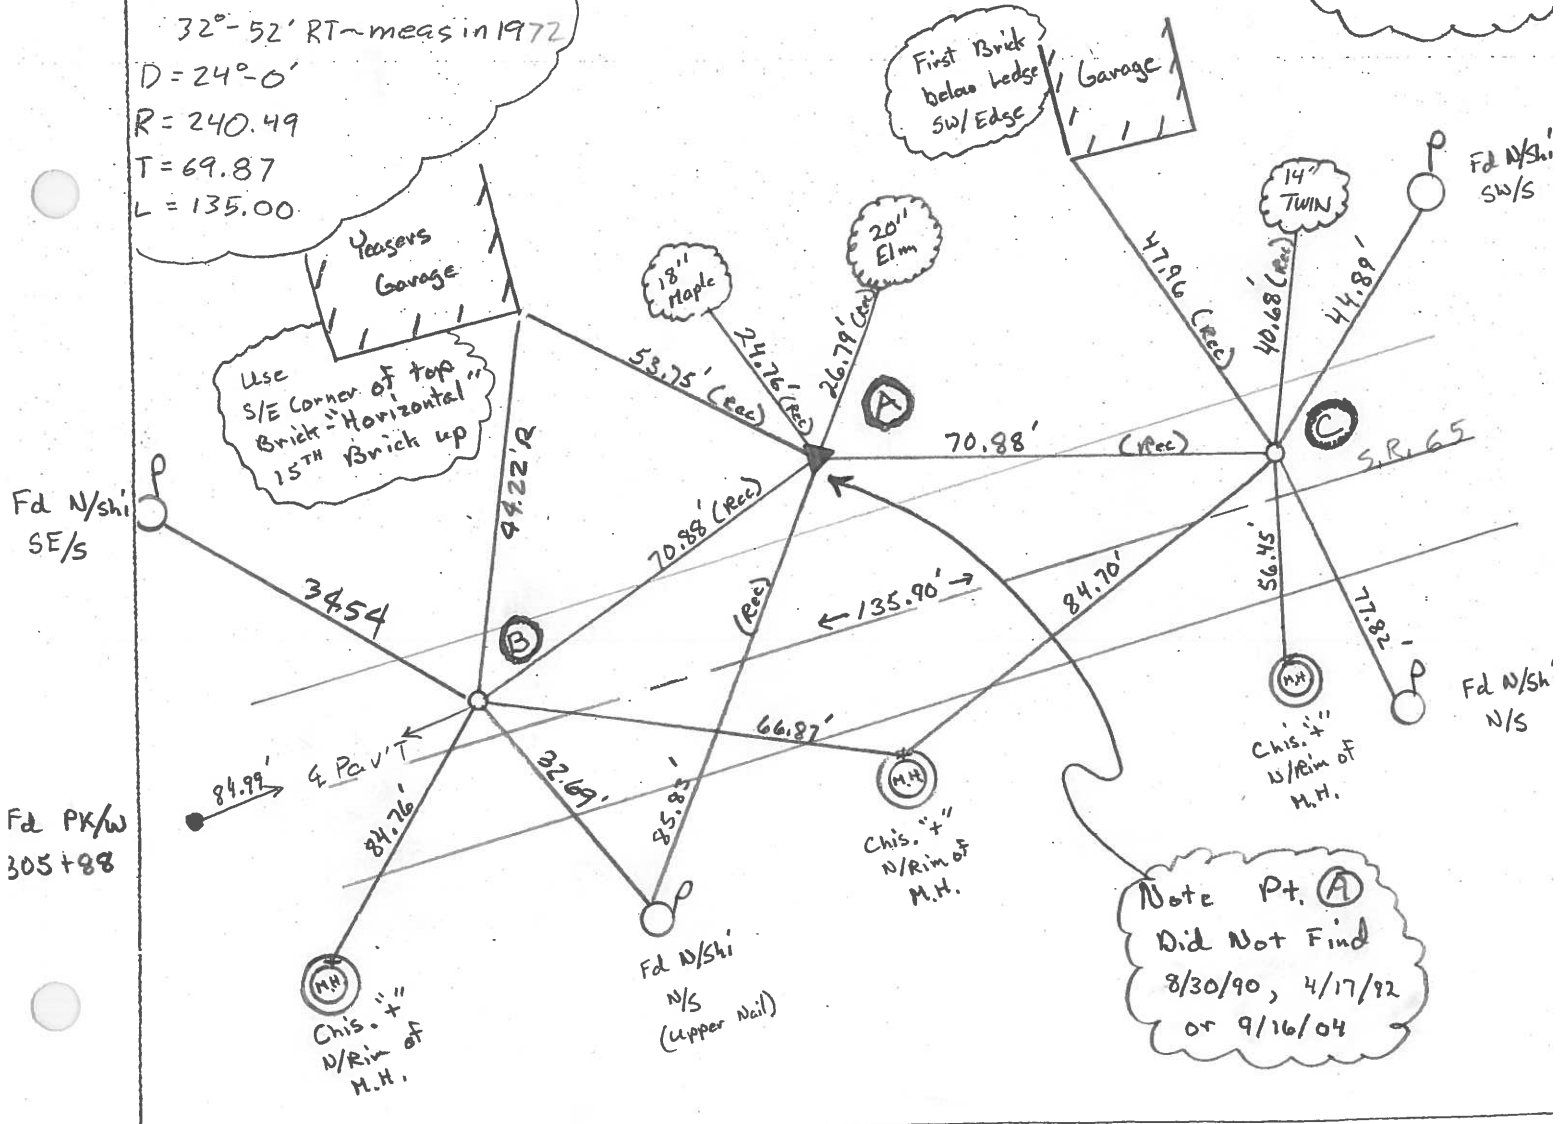

Note Pt. A  
Did Not Find  
8/30/90, 4/17/92  
or 9/16/04

# O.D.O.T. DISTRICT 2 SURVEY OFFICE

PERSONNEL

REFERENCE NO. 12 F

SHEET 33 OF 34


NOTES BARNHISEL  
 H.C. CURTIS  
 R.C. VAN DUZEN  
Lochake  
Romero

DATE 4-17-92  
 WEATHER RAIN  
 TEMP. +50°

ROUTE 65  
 COUNTY WOOD  
 TOWNSHIP WASHINGTON  
 SECTION 35  
T6 N R 9 E


TYPE MONUMENT PT "B" PT. "C"  
 ON SURFACE - ~~BELOW~~ P.K. WASHER / SHANK  
 LEFT - PAV'T. - RIGHT 4.7 / 4.6  
<sup>BOTH</sup> 4.6 TO LT EDGE PAVEMENT  
 S.L.M. 306776 308411

Set P.K's  
 WASHERS  
 5-1-92  
 C.L.

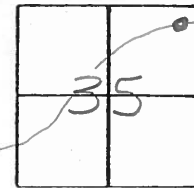

RECORD:

P.I. 206+90.4  
 CONST. PLANS 1923-24  
 $\Delta = 32^\circ - 24'$  Rec.  
 $32^\circ - 52'$  RT ~ MEAS IN 1972  
 $D = 24^\circ - 01'$   
 $R = 240.49$   
 $T = 69.87$   
 $L = 135.00$

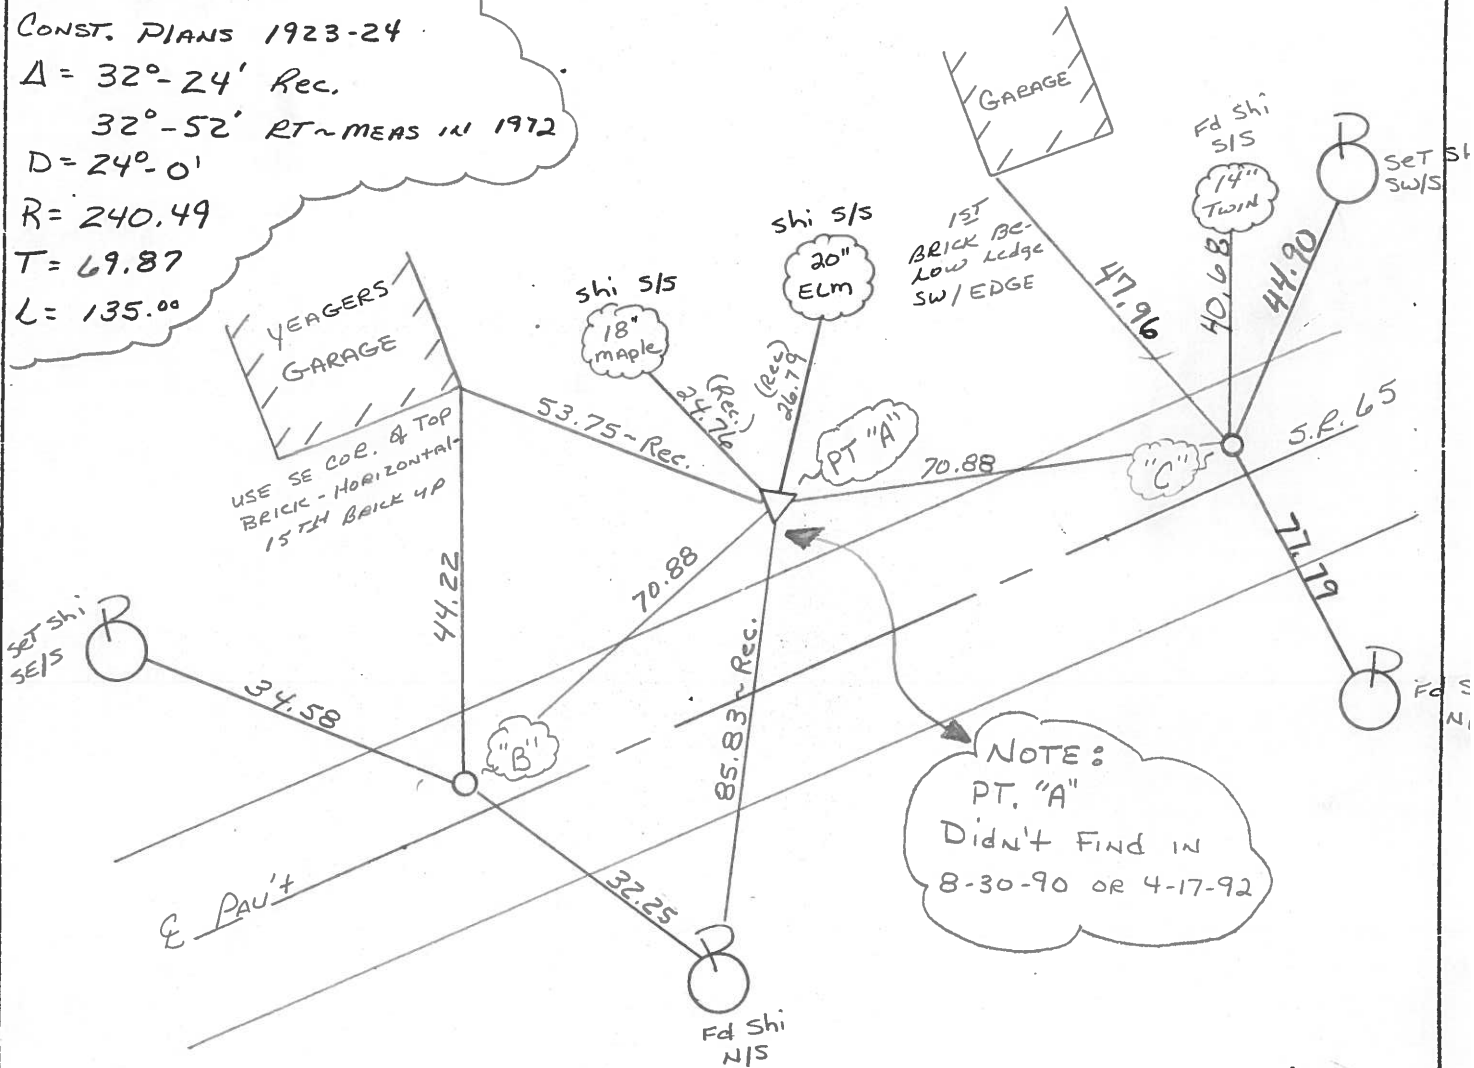

OD.O.T. DISTRICT 2 SURVEY OFFICE

SHEET 41 OF

County Wood S.R. 65

Date 6-14-82  
12-14-81

Township Washington

Weather Partly Clear


Section 35

Temp. +34°


T<sub>N</sub>, R<sub>E</sub>

Personnel Hoffman  
Householder

12-F

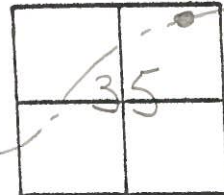

pt. "A" = P.I. = 1/2" IRON pipe Fd @ SURFACE ~ Project sta ± 307+54  
19.2' Lt. of & PAUT  
8.1' N. of N. EP,

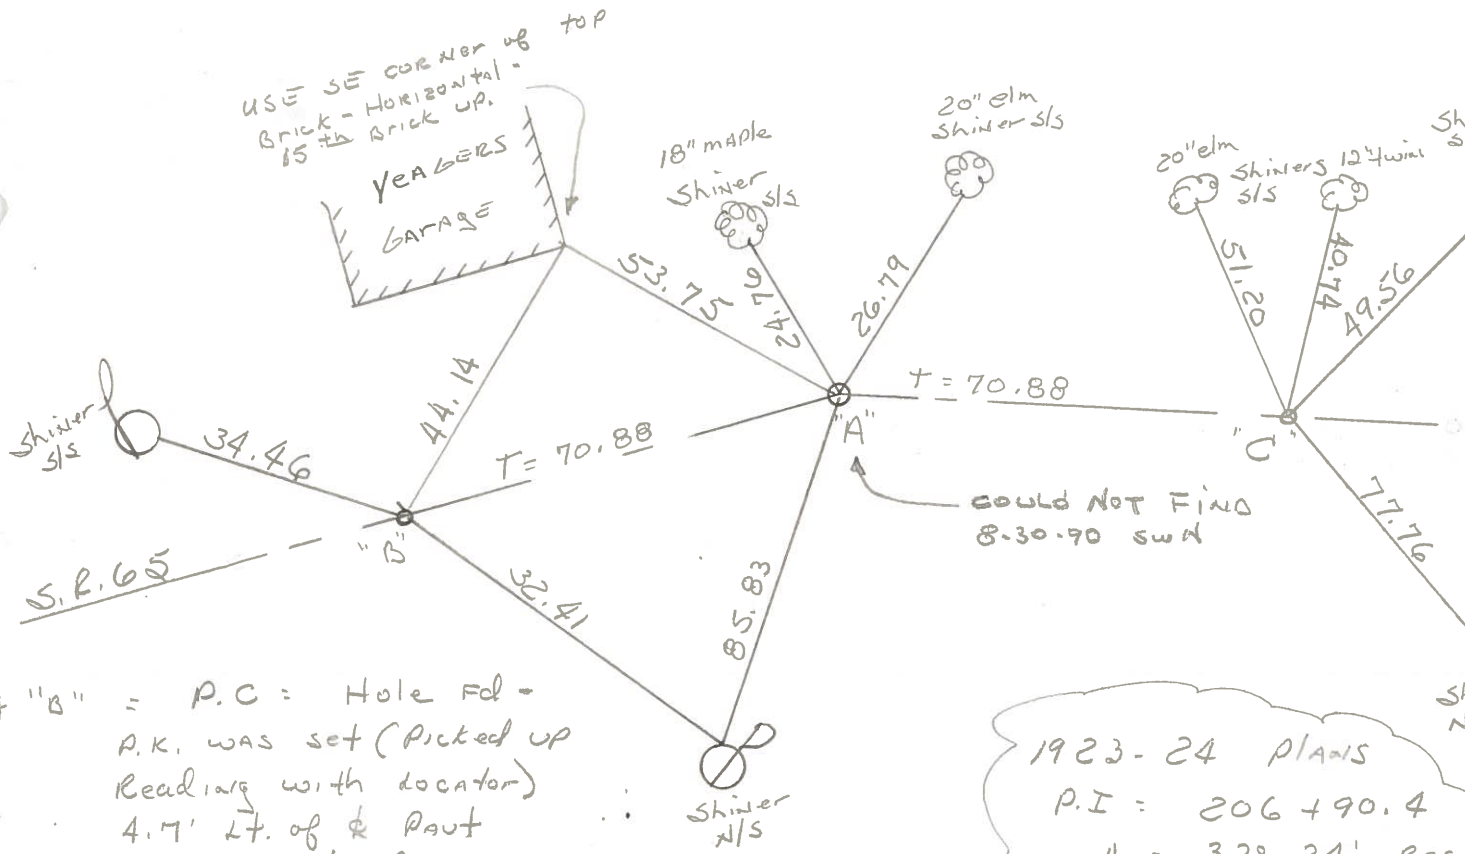

pt "B" = P.C. = Hole Fd -  
P.K. WAS set (Picked up  
Reading with locator)  
4.7' Lt. of & PAUT  
4.00 to N. EP.  
14.3 to S. EP.

pt "C" = P.T. = Hole Fd -  
P.K. WAS set - No Reading  
with locator  
4.6' Lt. of & PAUT  
4.5' to N. EP,  
14.5' to S. EP.

1923-24 PLANS  
P.I. = 206+90.4  
Δ = 32°-24' - Rec  
32°-52' Rt-mi  
19'  
D = 240-0'  
R = 240.49  
T = 69.87  
h = 135.00