


O.D.O.T. DISTRICT 2 SURVEY OFFICE (USE ONLY)

PERSONNEL \_\_\_\_\_ REFERENCE NO. 13 B SHEET 8 OF 63  
 NOTES RHOADES DATE 4/20/15 ROUTE SR 65  
 H.C. WESTFALL WEATHER WINDY COUNTY WOOD  
 R.C. O'DONNELL TEMP. 59° TOWNSHIP WASHINGTON  
 \_\_\_\_\_ SECTION 25  
 \_\_\_\_\_ T 6 N R 9 E


TYPE MONUMENT P.K.SHANK  
 ON SURFACE - ~~BELOW~~ \_\_\_\_\_ ON \_\_\_\_\_  
~~LEFT~~ - PAV'T - RIGHT 2.8'  
7.0' ~~TORT~~ EDGE PAVEMENT  
 S.L.M. 318+59.38

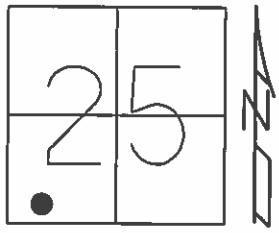

Grid: Northing: 650399.038 Easting: 1616560.667

RECORD: P.C.  
 STA. 318+1

FD P.K./WASHER  
 5/14/04  
 SET P.K./WASHER  
 8/31/92, CL  
 FD P.K.SHANK  
 GPS, REFB13  
 8/6/13, SDC  
 SET MAG/WASHER  
 GPS, NEWREFB13  
 7/20/15, JFO

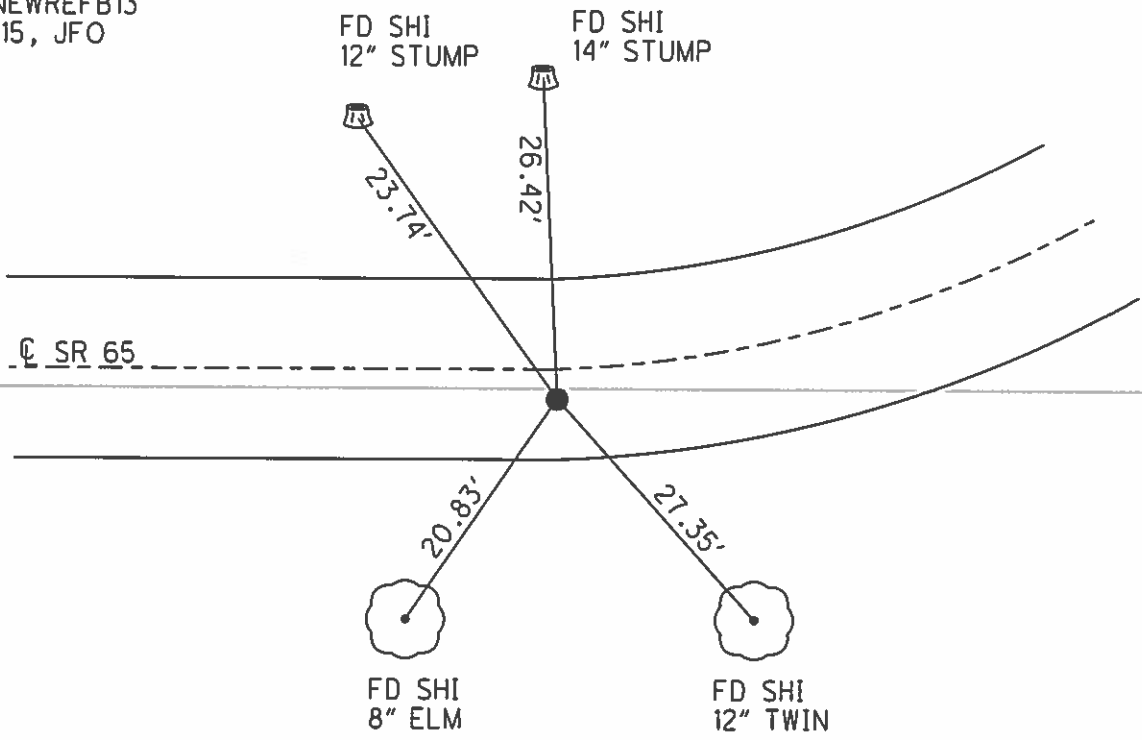


# O.D.O.T. DISTRICT 2 SURVEY OFFICE

PERSONNEL \_\_\_\_\_ REFERENCE NO. 13-B SHEET 2 OF 34  
 NOTES BARNHISEL  
 H.C. Loehrke DATE 5-14-04  
 R.C. CURTIS WEATHER Cloudy ROUTE 65  
 \_\_\_\_\_ TEMP. +72° COUNTY WOOD  
 \_\_\_\_\_ TOWNSHIP WASHINGTON  
 \_\_\_\_\_ SECTION 25  
 \_\_\_\_\_ T 6 N R 9 E

P.C.  P.I. \_\_\_\_\_  
 TYPE MONUMENT PK+WASHER 1" I-PIPE  
 ON SURFACE - ~~BELOW~~ yes yes  
~~LEFT~~ - PAV'T. - RIGHT 2.8 24.5  
NO TO RT EDGE PAVEMENT 13.2 RT of RT Edge  
 S.L.M. 318+10 319+32


13-BC

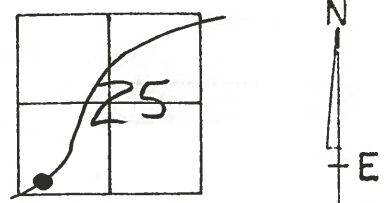

RECORD  
 1923-24 CURVE DATA  
 PI ~ 219+13.8  
 A = 32°-34' Lt  
 D = 13°-0'  
 R = 441.68  
 T = 129.01  
 L = 250.51

SET PK+WASHER  
 at P.C.  
 8-31-92  
 C.L.

Preventive Maintenance  
 Microsurfaced 2004  
 Existing Point Uncovered  
 Date 08/09/04 MC

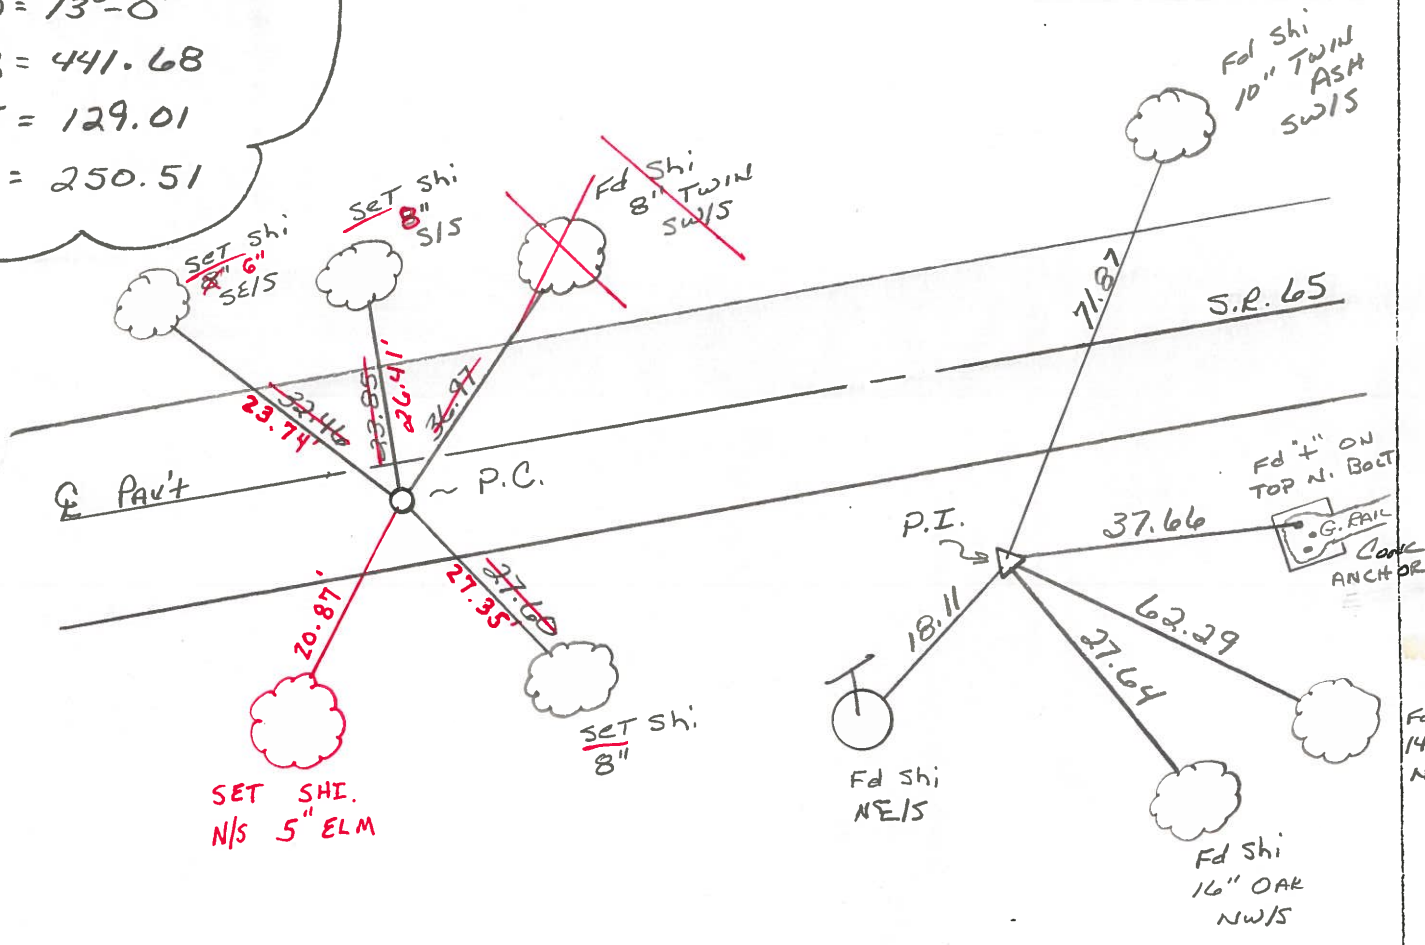

F 14 N

County Wood S.R. 65

Date 4-2-84

Township WASHINGTON

Weather P. Clear

Section 25

Temp. 40°


T6N, R9E

Personnel HOFFMAN

LOHRKE

HOUSEHOLDER H.C.

BARNHISEL R.C.

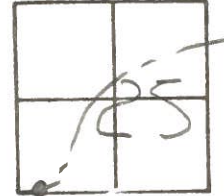

Fd. 1" I. Pipe @ surface FOR P.I.  
24.5' RT. of ♀ Pavt  
13.2' RT. of RT. EP


S.L.M. = 319 + 32

**13-B**

**13-BC**

P.C. Fd P.K. @ surf  
3.5' RT of ♀ Pavt  
6.5' TO RT. EP  
13.4' TO Lt. EP  
S.L.M. = 318 + 10

SET PK/WASHER  
10-4-84  
S.W.H.

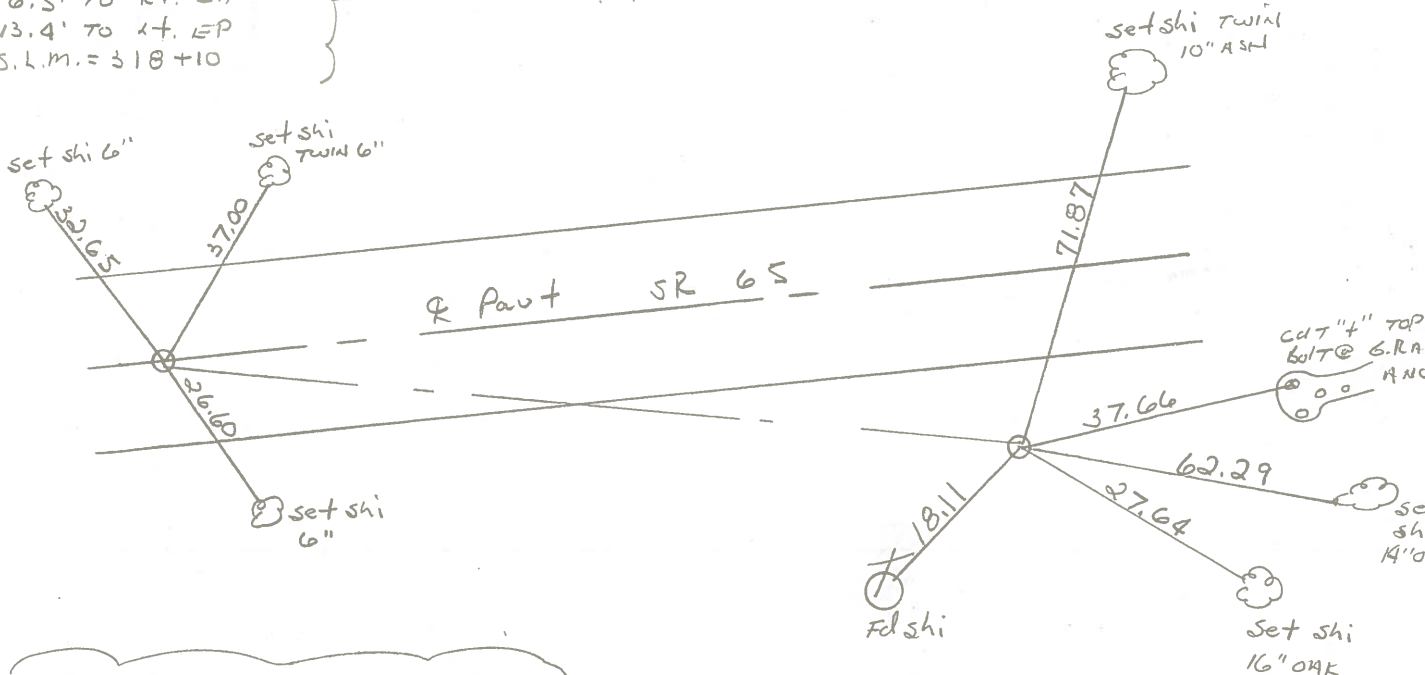

1923-1924 PLAN CURVE DATA

P.I. 219 + 13.8  
Δ = 32° - 34' Lt.  
D = 13° - 0'  
R = 441.68  
T = 129.01  
L = 250.51