


O.D.O.T. DISTRICT 2 SURVEY OFFICE (USE ONLY)

PERSONNEL	REFERENCE NO. <u>13 BC</u>	SHEET <u>9</u> OF <u>63</u>
NOTES <u>RHOADES</u>	DATE <u>4/20/15</u>	ROUTE <u>SR 65</u>
H.C. <u>WESTFALL</u>	WEATHER <u>WINDY</u>	COUNTY <u>WOOD</u>
R.C. <u>O'DONNELL</u>	TEMP. <u>59°</u>	TOWNSHIP <u>WASHINGTON</u>
		SECTION <u>25</u>
		T <u>6</u> N R <u>9</u> E


TYPE MONUMENT 1" IPIPE
 ON SURFACE - ~~BELOW~~ ON
~~LEFT~~ - PAV'T - RIGHT 24.5'
13.2' RT TORT EDGE PAVEMENT
 S.L.M. 319+88.03
 Grid: Northing: 650400.236 Easting: 1616673.399

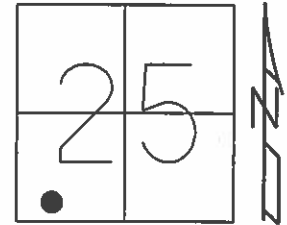

RECORD: P.I.
 STA. 219+13.8
 CURVE DATA FROM
 CONSTR.PLAN 1923-24
 $\Delta = 32^\circ 34' LT$
 $D = 13^\circ 0'$
 $R = 441.68$
 $T = 129.01$
 $L = 250.51$

FD 1" IPIPE
 5/14/04, MB
 8/6/13, SDC
 GPS, REFBC13

FD SHI
 10" TWIN
 ASH

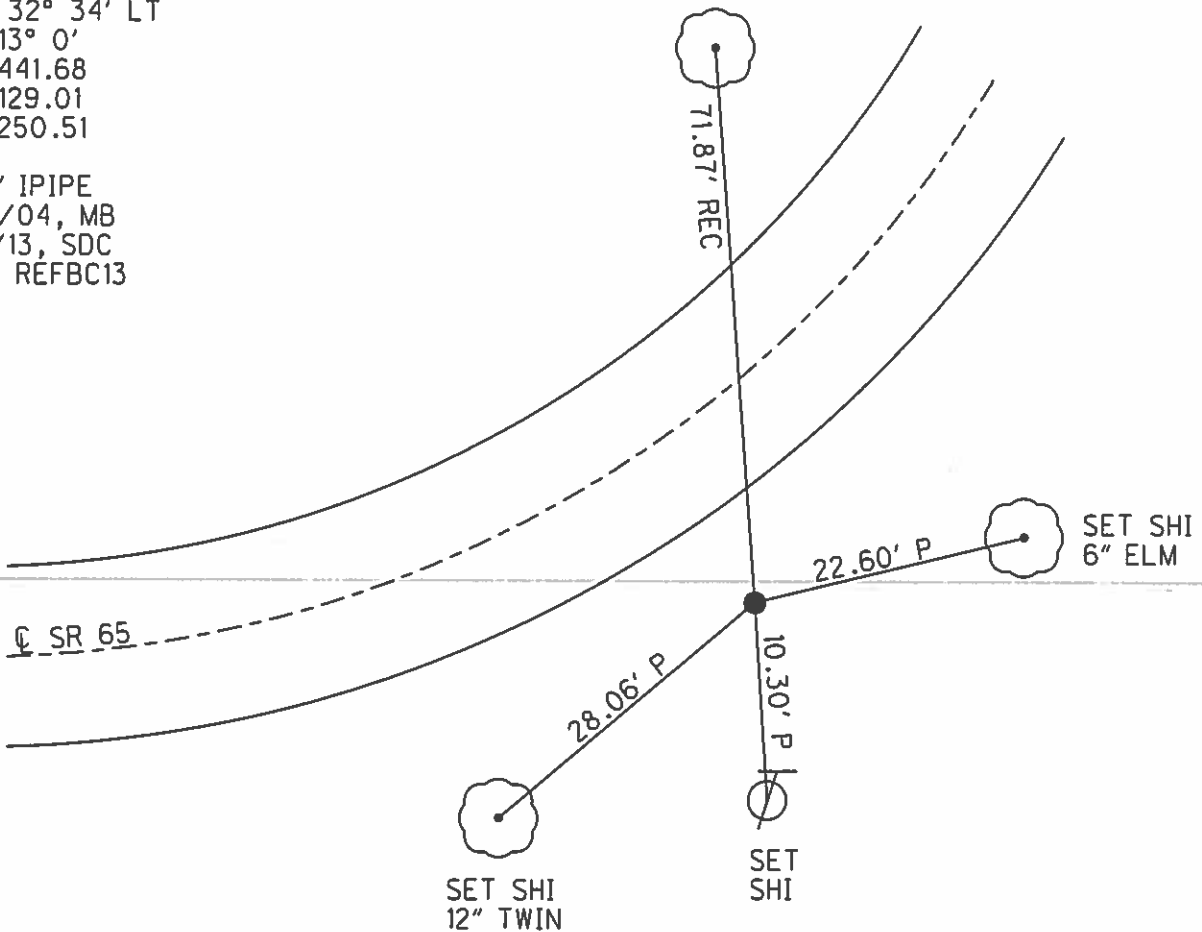

O.D.O.T. DISTRICT 2 SURVEY OFFICE

PERSONNEL

REFERENCE NO. 13-B

SHEET 2 OF 34

NOTES BARNHISEL

H.C. Loehrke

R.C. CURTIS

DATE 5-14-04
~~7-13-72~~

WEATHER Cloudy

TEMP. +72°

ROUTE 65

COUNTY WOOD

TOWNSHIP WASHINGTON

SECTION 25

T. 6 N. R. 9 E

13-BC

P.C. ✓

P.I.


TYPE MONUMENT PK + WASHER 1" I-PIPE

ON SURFACE - ~~BELOW~~ YES YES

LEFT - C. PAV'T. - RIGHT 2.8 24.5

7.0 TO RT EDGE PAVEMENT 13.2 RT OF RT Edge


S.L.M. 318+10 319+32

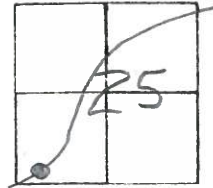

RECORD
1923-24 CURVE DATA
PI ~ 219+13.8
A = 32°-34' Lt
D = 13°-0'
R = 441.68
T = 129.01
L = 250.51

SET PK + WASHER
at P.C.
8-31-92
C.L.

Preventive Maintenance
Microsurfaced 2004
Existing Point Uncovered
Date 08/09/04 MC

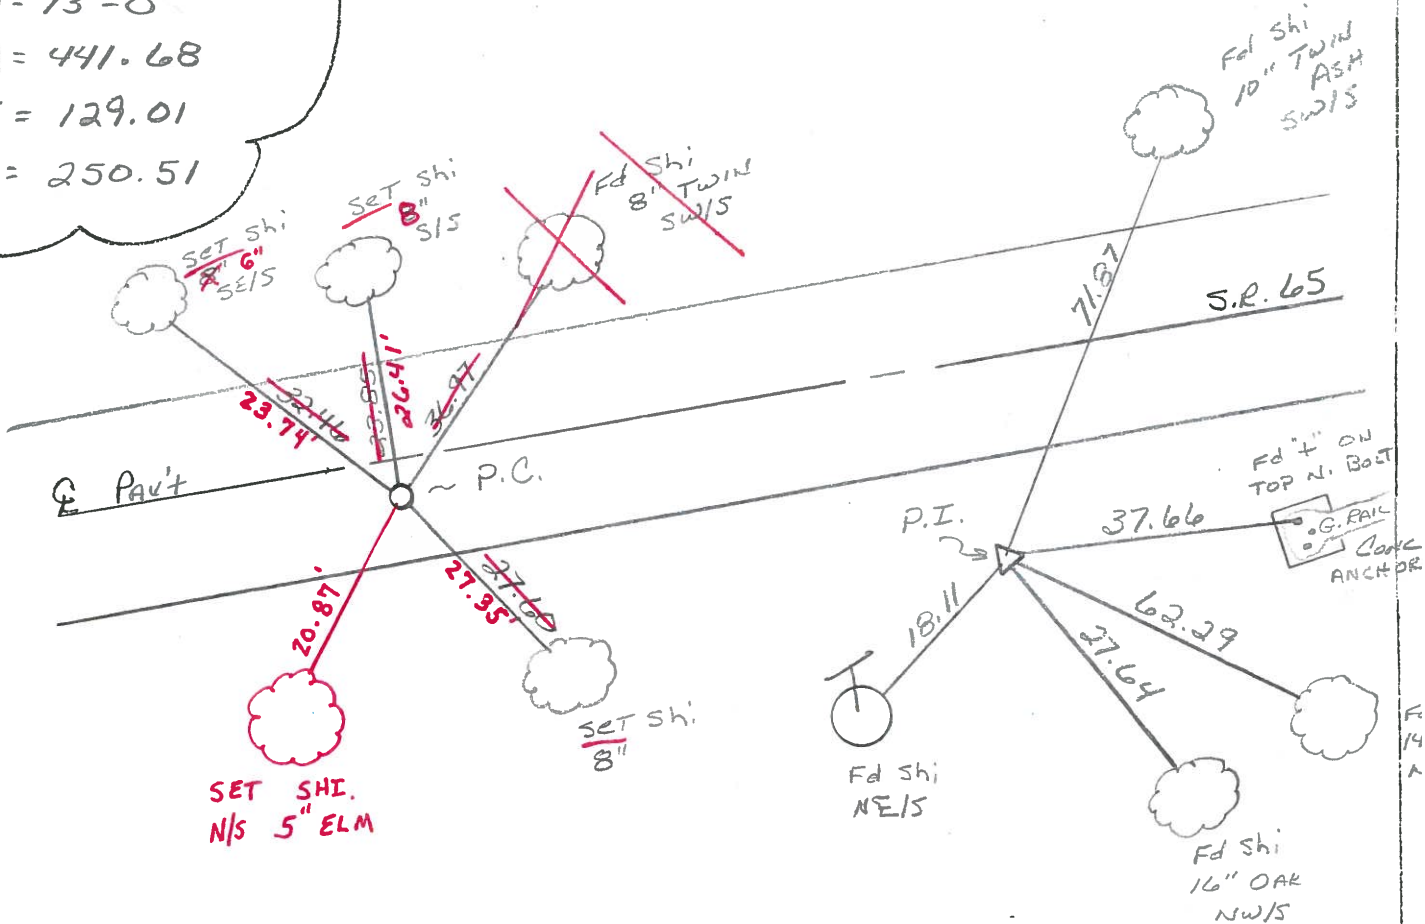

County Wood S.R. 65

Date 4-2-84

Township WASHINGTON

Weather P. clear

Section 25

Temp. 40°


T6N, R9E

Personnel HOFFMAN

LOEHRKE

HOUSEHOLDER HC

BARNHISEL R.C.

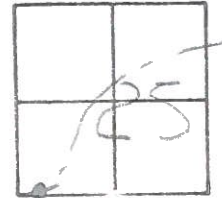

Fd. 1" I. Pipe @ surface FOR P.I.
24.5' RT. of & Fault
13.2' RT. of RT. EP


S.L.M. = 319 + 32

13-B

13-BC

P.C. Fd. PK. @ surf
3.5' RT. of & Fault
6.5' TO RT. EP
13.4' TO 1st. EP
S.L.M. = 319 + 10

SET PK/WASHER
10-4-84
SWH

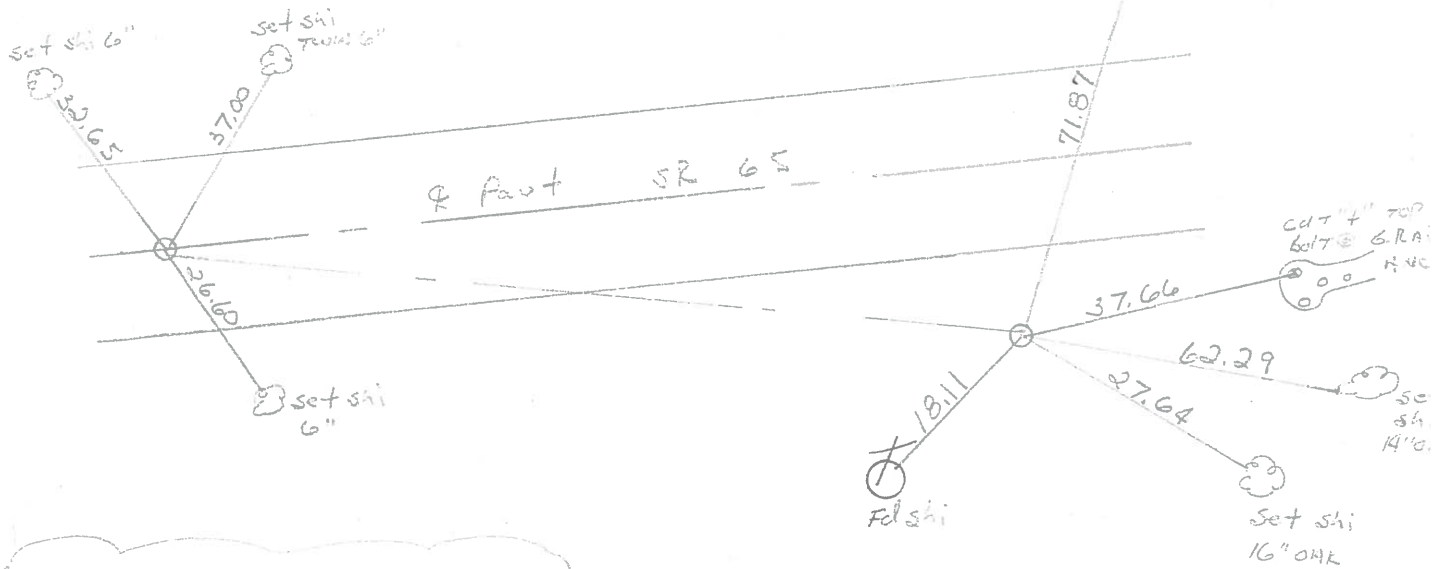

1923-1924 PLAN CURVE DATA

P.I. 219 + 13.8

Δ = 32° - 34' Lt.

D = 13° - 0'

R = 441.68

T = 129.01

L = 250.51

PERSONNEL	TITLE	PERSONNEL	TITLE	COUNTY	<u>WOOD</u>	DATE	<u>8-29-72</u>
<u>BURNSIDE</u>				S. R.	<u>65</u>	WEATHER	<u>CLEAR</u>
<u>SMITH</u>				SEC	<u>WASHINGTON TWP</u>	TEMP.	<u>+78°</u>
<u>BOWERS</u>				DESCRIPTION <u>ESTABLISH P.I.</u>			
<u>KIOWSKI</u>				LEFT	CENTER LINE	RIGHT	JOB NO.

