

O.D.O.T. DISTRICT 2 SURVEY OFFICE

PERSONNEL

REFERENCE NO. PI = #14

SHEET 1 OF 11

NOTES BARNHISEL

H.C. MOSEER

R.C. CANTERBURY (DRAWN)

DATE 9-25-00

WEATHER CLOUDY

TEMP. +55°

ROUTE S.R. #65

COUNTY WOOD

TOWNSHIP WASHINGTON

SECTION 25


T 6 N R 9 E

	P.C.	P.I.	P.T.
TYPE MONUMENT	P.K.+WASHER	SM. R.R. SPR.	P.K.+WASHER
ON SURFACE - BELOW	SURFACE	1" DOWN	SURFACE
LEFT - & PAV'T. - RIGHT	SEE BELOW		
TO - EDGE PAVEMENT			

~~LEFT - & PAV'T.~~ - RIGHT SEE BELOW

~~TO~~ - EDGE PAVEMENT

S.L.M. P.C. = 330+02.71 P.I. = 330+52.8 P.T. = 330+99.23

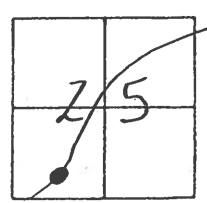

NEW: CURVE DATA

P.I. STA = 330 + 52.80

Δ = 37° - 49' - 15"

D = 39° - 11' - 14"

R = 146.21'

T = 50.09'


L = 96.52'

E = 8.34'

P.I. = 330 + 52.8 1" DOWN
SM. R.R. SPR. Fd., 17.4' RT &
19' W. OF & BRILLHART RD.

P.T. = 330 + 99.23
SET PK+WASHER 6.4' RT &
3.1' TO RT. E.O.P.

P.C. = 330 + 02.71
SET P.K. + WASHER 6.4' RT &
2.7' TO RT. E.O.P.

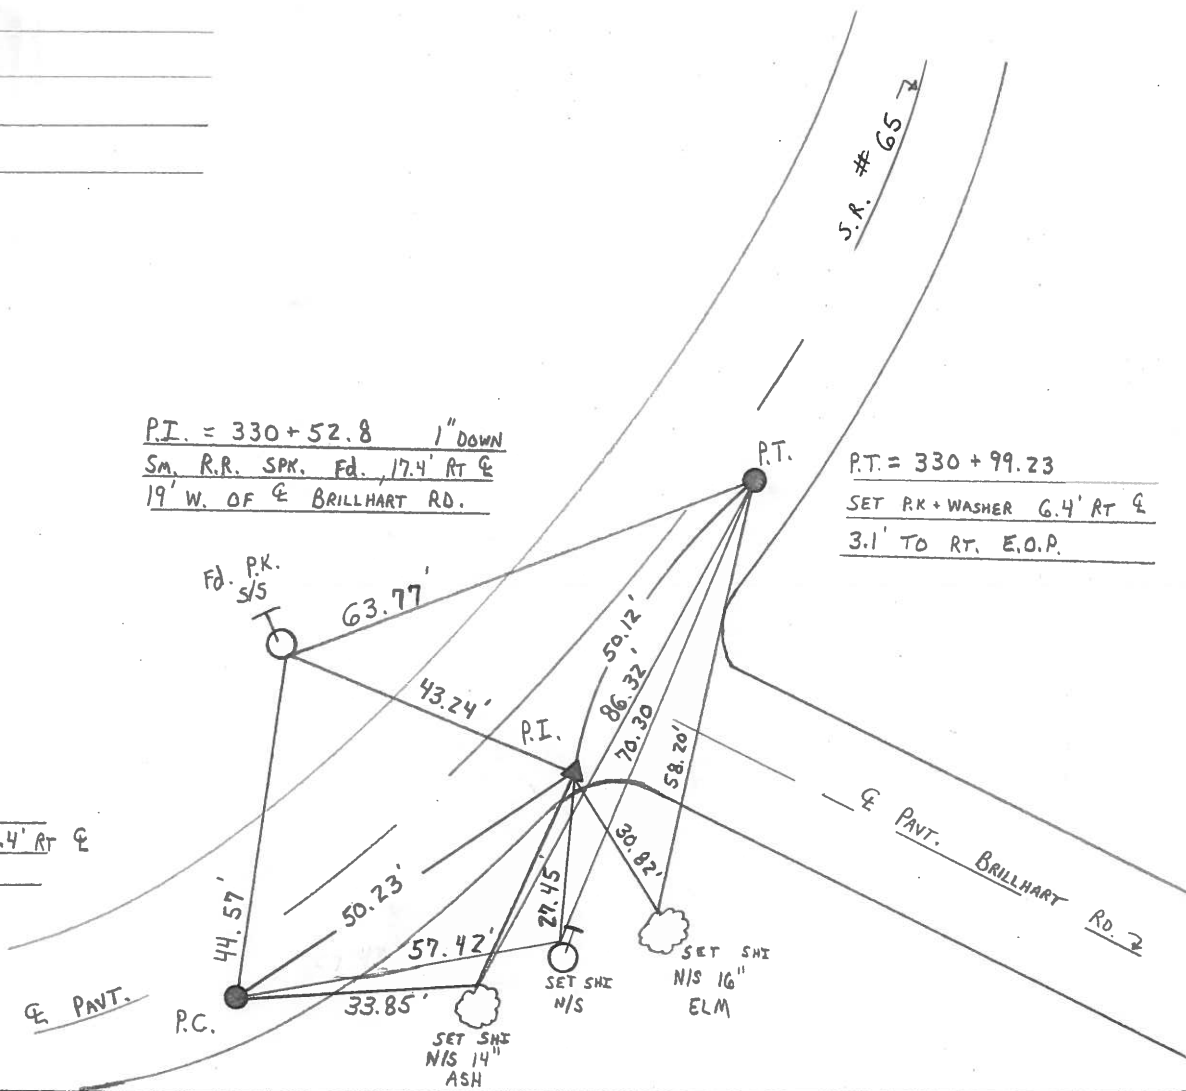

O.D.O.T. DISTRICT 2 SURVEY OFFICE

PERSONNEL

REFERENCE NO. 14

SHEET 5 OF 34

NOTES BARNHISEL

H.C. Loehrke

R.C. CURTIS

DATE 7-13-92

WEATHER cloudy

TEMP. +65°

ROUTE 65

COUNTY WOOD

TOWNSHIP WASHINGTON

SECTION 25

T6 NR 9 E


TYPE MONUMENT Sm. RR. Spk

ON SURFACE - ~~NO~~ yes

~~SET~~ - PAV'T. - RIGHT 18.5

- TO - EDGE PAVEMENT 7.2 RT OF RT Edge

S.L.M. 329 +86

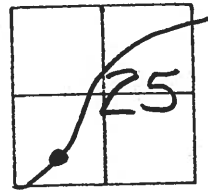

RECORD

1926 CURVE DATA

PI 230+67.50


$\Delta = 37^{\circ}-50'$

$D = 40^{\circ}-0'$

$R = 146.19$

$L = 94.58$

$T = 50.09$

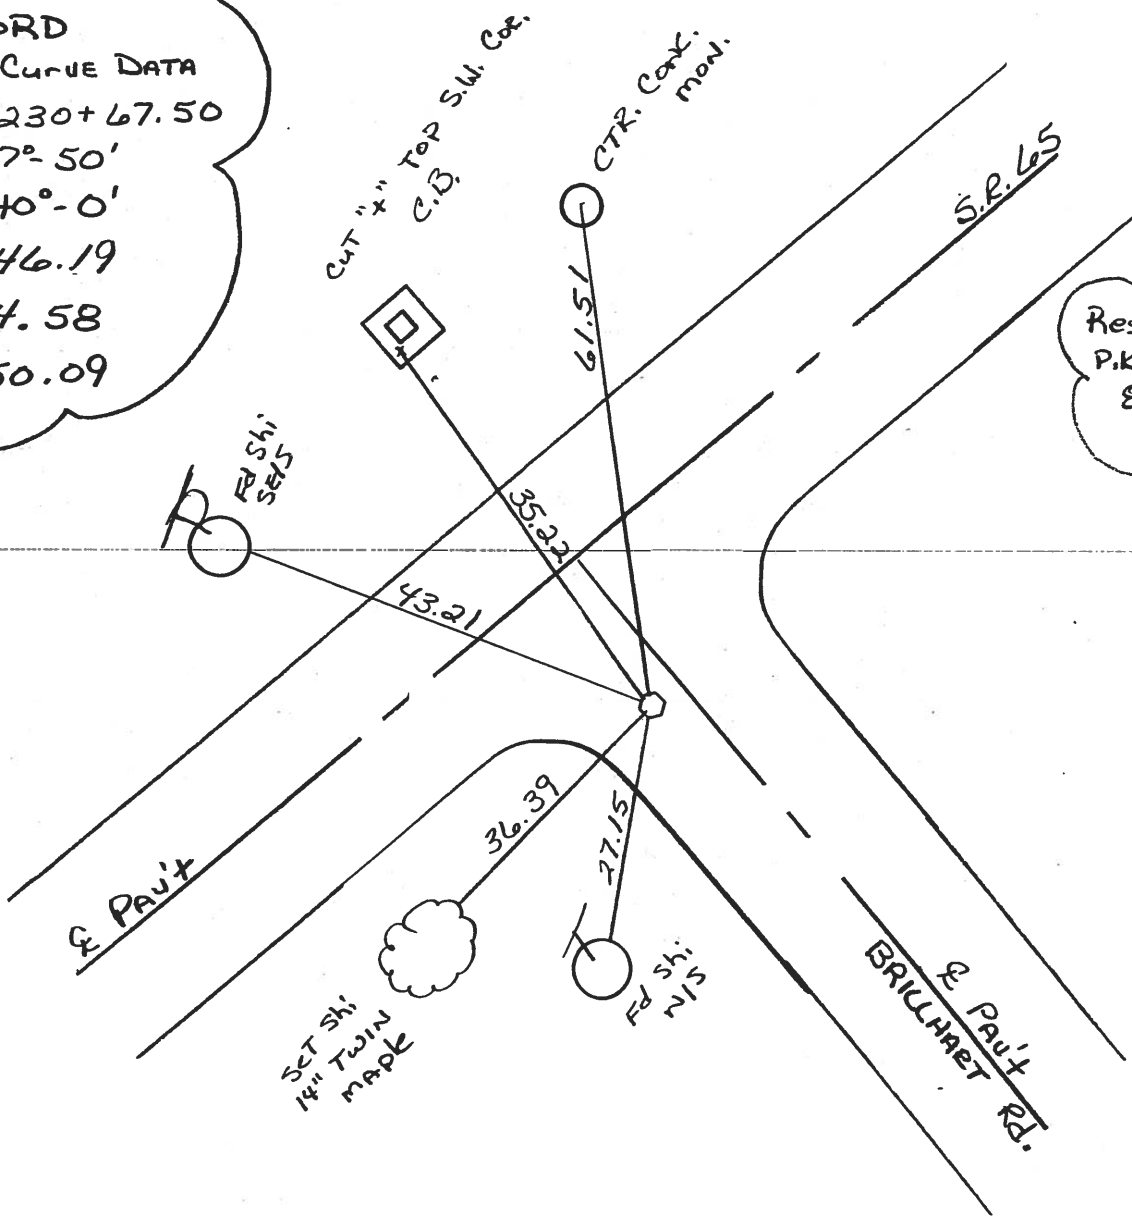

Reset
P.K. + WASHER
8-31-92
C.L.

County Wood S.R. 65

Date 4-2-84

Township WASHINGTON

Weather cloudy

Section 25

Temp. 40°


T6N, R9E

Personnel HOFFMAN

LOERKE

HOUSEHOLDER H.C.

BARNHISEL R.C.

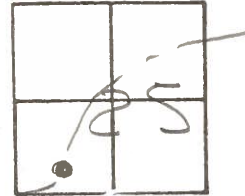

#14

Fd IRON BOAT 2" Below surface

S&M = 329+85


18.5' RT. of R PAUT SR65

SET SMALL RR SPIKE

7.2' RT. of RT. CP

10-4-84

SW.H.

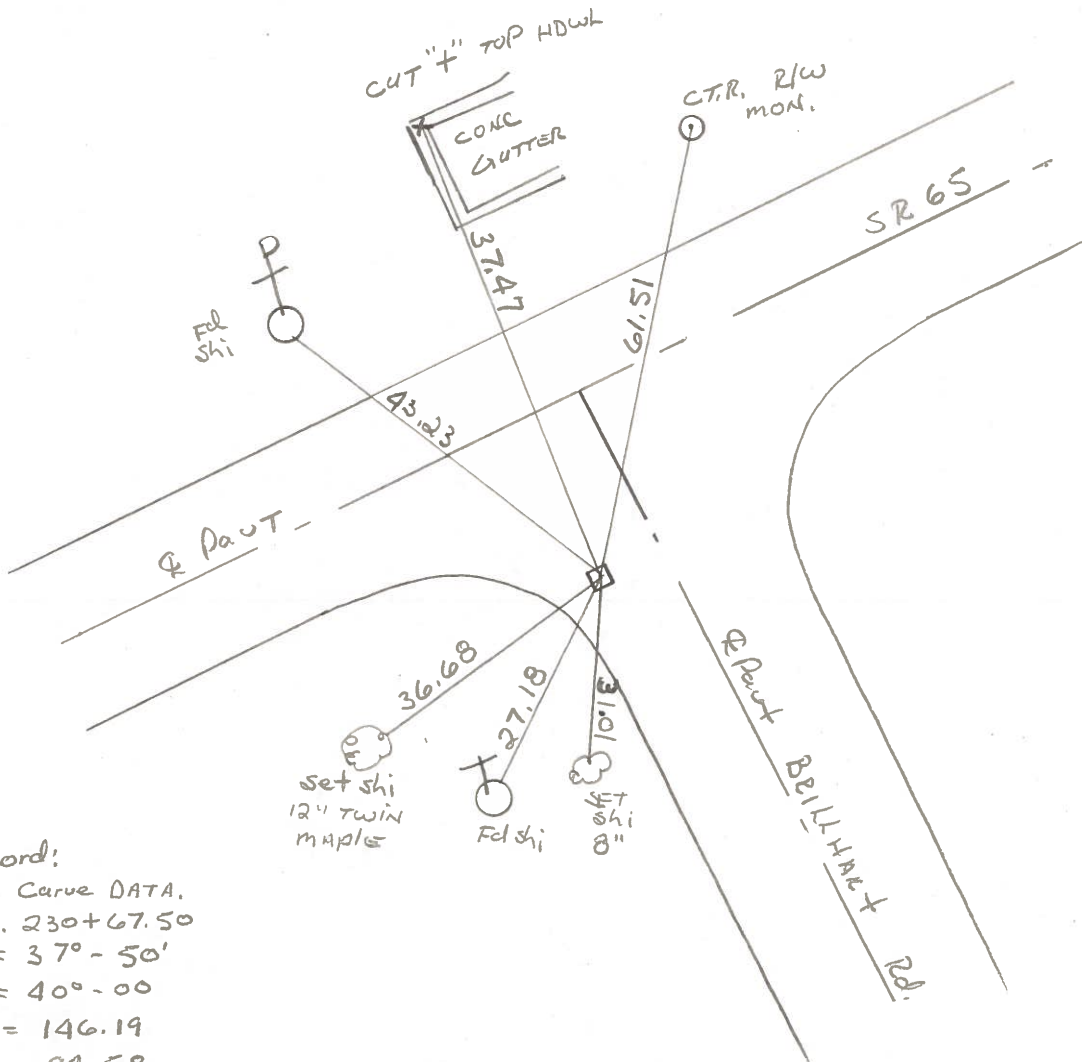

Record:

- 1926 Curve DATA.
- P.I. 230+67.50
- $\Delta = 37^\circ - 50'$
- $D = 40^\circ - 00'$
- $R = 146.19$
- $L = 94.58$
- $\gamma = 50.09$

O.D.O.T. DISTRICT 2 SURVEY OFFICE

SHEET _____ OF _____

County WOOD S.R. 65

Date 10-26-72

Township WASHINGTON


Weather CLEAR

Section 25

Temp. 35°

T6N, R9E

Personnel BURNSIDE
SMITH

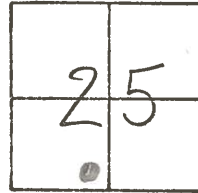

#14

P.I. STA. 230+67.50
FD. 3/4" IRON BOLT
18.5' ± S. OF ϕ
PAVT. (2" DEEP)

"F" ON TOP
CONC. HDWL.

CTR. R/W
MON.



COR. OLD
CONC. LIGHT
BASE

S.R. 65

S.R. 65

BRILLHART ROAD

CURVE DATA:
FROM PLAN - 1926
P.I. 230+67.50
 $\Delta = 37^\circ - 50'$
 $D = 40^\circ - 00'$
 $R = 146.19$
 $L = 94.58$
 $T = 50.09$

43.33

34.53

61.49'

67.10'

27.16'

30.00'



PERSONNEL TITLE PERSONNEL TITLE

COUNTY Wood. DATE May 2, 1968

S. R. #65 WEATHER Clear.

SEC. SR#235 to SR#582 TEMP. 55°

DESCRIPTION Ties to Control points (State & Private) JOB NO. _____

LEFT CENTER LINE RIGHT

