

O.D.O.T. DISTRICT 2 SURVEY OFFICE

PERSONNEL

REFERENCE NO. P.I. = 14-A SHEET 3 OF 11

NOTES BARNHISEL

H.C. MOSEER

DATE 9-25-00

ROUTE S.R. #65

R.C. CANTERBURY (DRAWN)

WEATHER CLOUDY

COUNTY WOOD

TEMP. +55°

TOWNSHIP WASHINGTON

SECTION 25

T 6 N R 9 E

(SET)


TYPE MONUMENT LG. R.R. SPK. W/CNT. PUNCH HOLE

ON SURFACE - ~~BELOW~~ SURFACE

~~LEFT - & PAV'T. - RIGHT~~ 10.1' RT &

0.9' RT TO OF RT. EDGE PAVEMENT

S.L.M. P.I. = 335+98.81

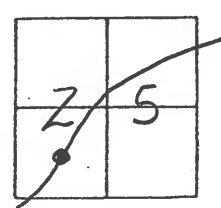

NEW: CURVE DATA

P.I. STA = 335+98.81

Δ = 09°-52'-00"


D = 02°-00'-00"

R = 2864.93'

T = 247.29'

L = 493.36'

E = 10.65'

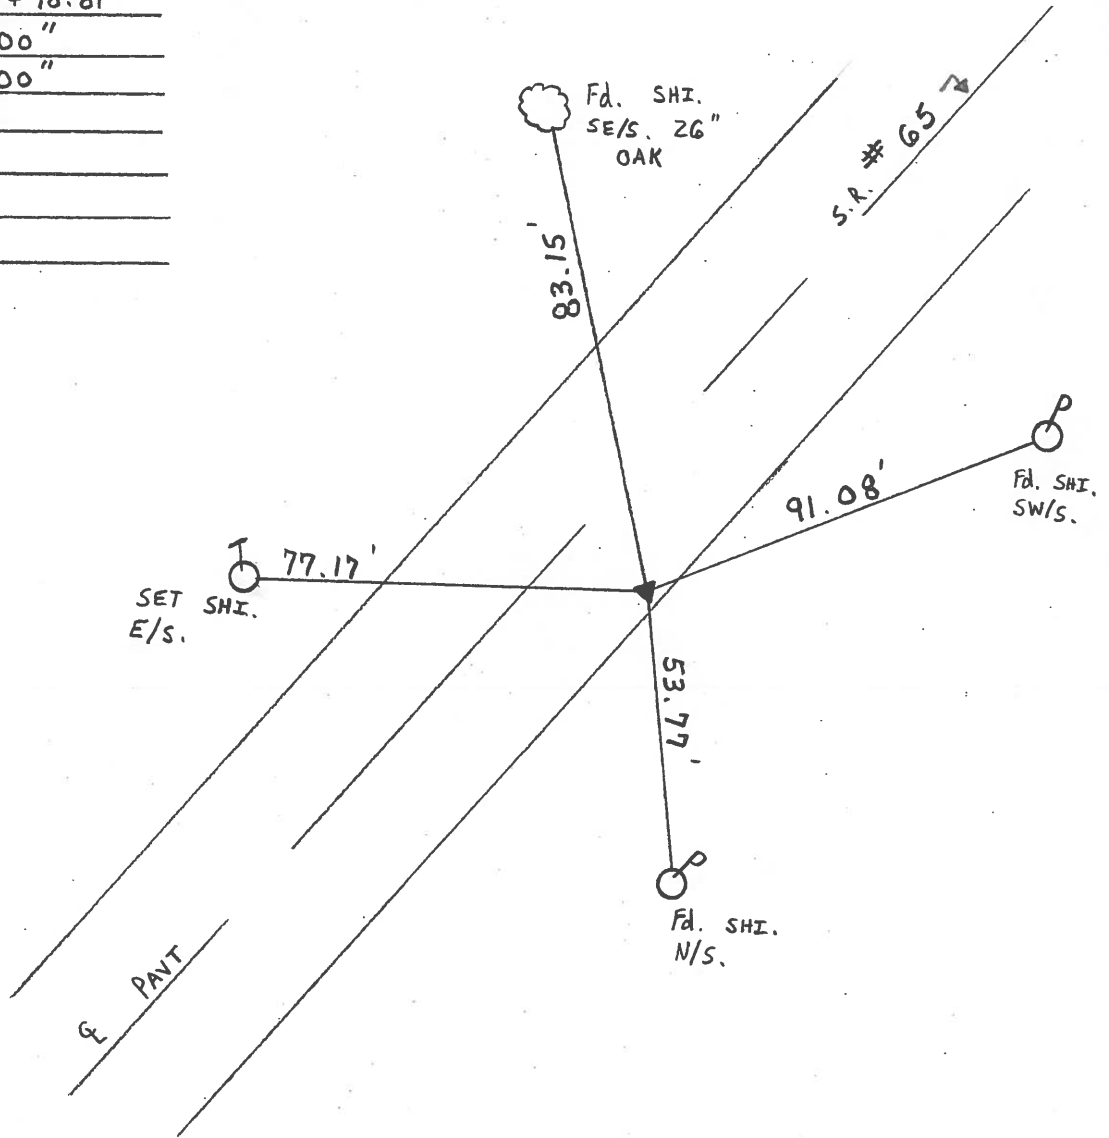

O.D.O.T. DISTRICT 2 SURVEY OFFICE

PERSONNEL


REFERENCE NO. P.I.=14-A SHEET 6 OF 36

NOTES BARNHISEL
 H.C. CURTIS
 R.C. Romero
Loehreke

DATE 7-15-92
 WEATHER RAIN
 TEMP. +70°


ROUTE 65
 COUNTY WOOD
 TOWNSHIP WASHINGTON
 SECTION 25
T.6 N R.9 E

TYPE MONUMENT Sm RR Spk
 ON SURFACE - ~~WOOD~~ YES
~~PAV'T.~~ - PAV'T. - RIGHT 10.0
 ON ~~TO~~ RT EDGE PAVEMENT
 S.L.M. 335+30

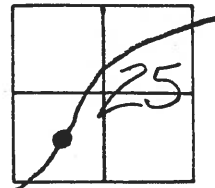

Record:
 1926 CURVE DATA
 PI 236+15.88
 $\Delta = 9^{\circ}52'$
 $D = 2^{\circ}00'$
 $T = 247.30$
 $R = 2864.93$
 $L = 493.33$
 $E = 10.657$

Set PK + WASHER
 8-27-92
 C.L.

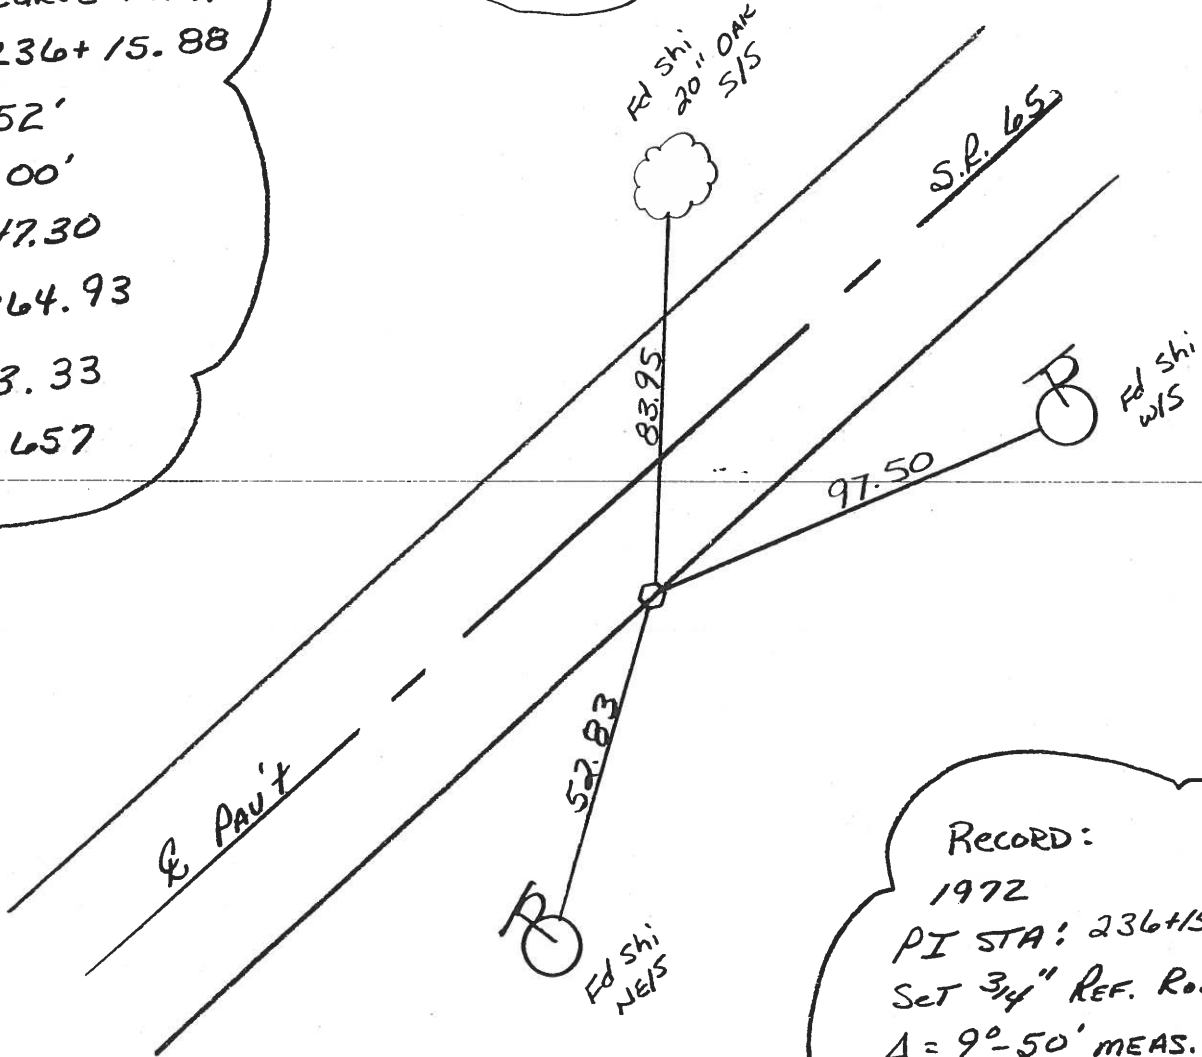

Record:
 1972
 PI STA: 236+15.88
 Set 3/4" REF. Rod
 $\Delta = 9^{\circ}50'$ MEAS.

S.M.T.-1,

O.D.O.T. DISTRICT 2 SURVEY OFFICE

SHEET 6 OF 91

County Wood S.R. 65

Date 4-2-84

Township WASHINGTON

Weather Cloudy

Section 25

Temp. 40°

T6N, R9E


Personnel HOFFMAN

LOSHRKE

HOUSEHOLDER H.C.

BARWISSEL R.C.

14-A

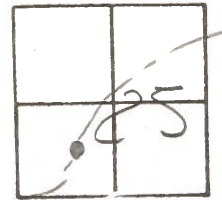


Fd 3/4" Ref. Rod - Bent
10.2' RT. of & PAWT
1.5' RT. of RT. EP

SLM = 335 + 30

SET SMALL RR SPIKE
10-4-84
S.W.H.

Record 1972:
P.I. STA 236 + 15.88
SET 3/4" Ref. Rod
A = 90-50' MEAS

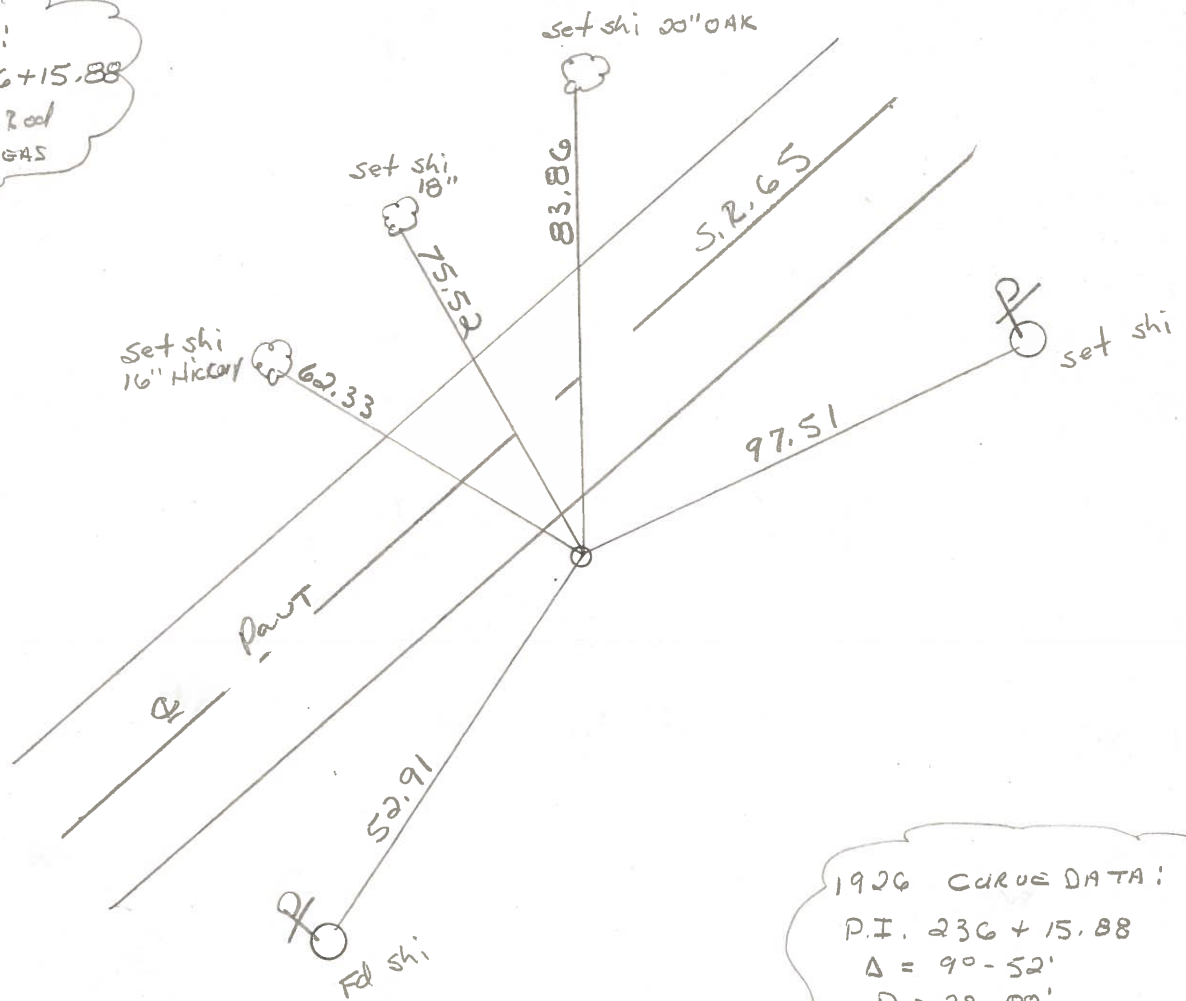

1926 CURVE DATA:
P.I. 236 + 15.88
A = 90-52'
D = 20-00'
T = 247.30'
R = 2864.93
L = 493.33
E = 10.657