

# O.D.O.T. DISTRICT 2 SURVEY OFFICE

**PERSONNEL**


NOTES BARNHISEL  
 H.C. CURTIS  
 R.C. Romero  
Lochrke

REFERENCE NO. P.I. = 14-B SHEET 7 OF 36

DATE 7-15-92  
 WEATHER RAIN  
 TEMP. +70°


ROUTE 65  
 COUNTY WOOD  
 TOWNSHIP WASHINGTON  
 SECTION 25  
T 6 N R 9 E

	P.C.	P.T.
TYPE MONUMENT	<u>P.K. + WASHER</u>	<u>P.K. + WASHER</u>
ON SURFACE - <del>BELOW</del>	<u>YES</u>	<u>YES</u>
<del>TO</del> - <u>PAV'T.</u> - <del>RIGHT</del>	<u>YES</u>	<u>YES</u>
- TO <u>LT</u> EDGE PAVEMENT	<u>9.4</u>	<u>9.8</u>
S.L.M.	<u>340+85</u>	<u>345+09</u>

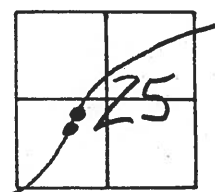

RECORD:  
 CURVE DATA 1926 PLAN  
 P.I. 243+83.11  
 $\Delta = 19^{\circ} - 05' \text{ Lt.}$   
 $D = 4^{\circ} - 30'$   
 $R = 1273.57'$   
 $T = 214.07$   
 $L = 424.07$   
 $E = 17.86$

RECORD:  
 P.T. STA: 245+93.11  
 SET PK. 1972

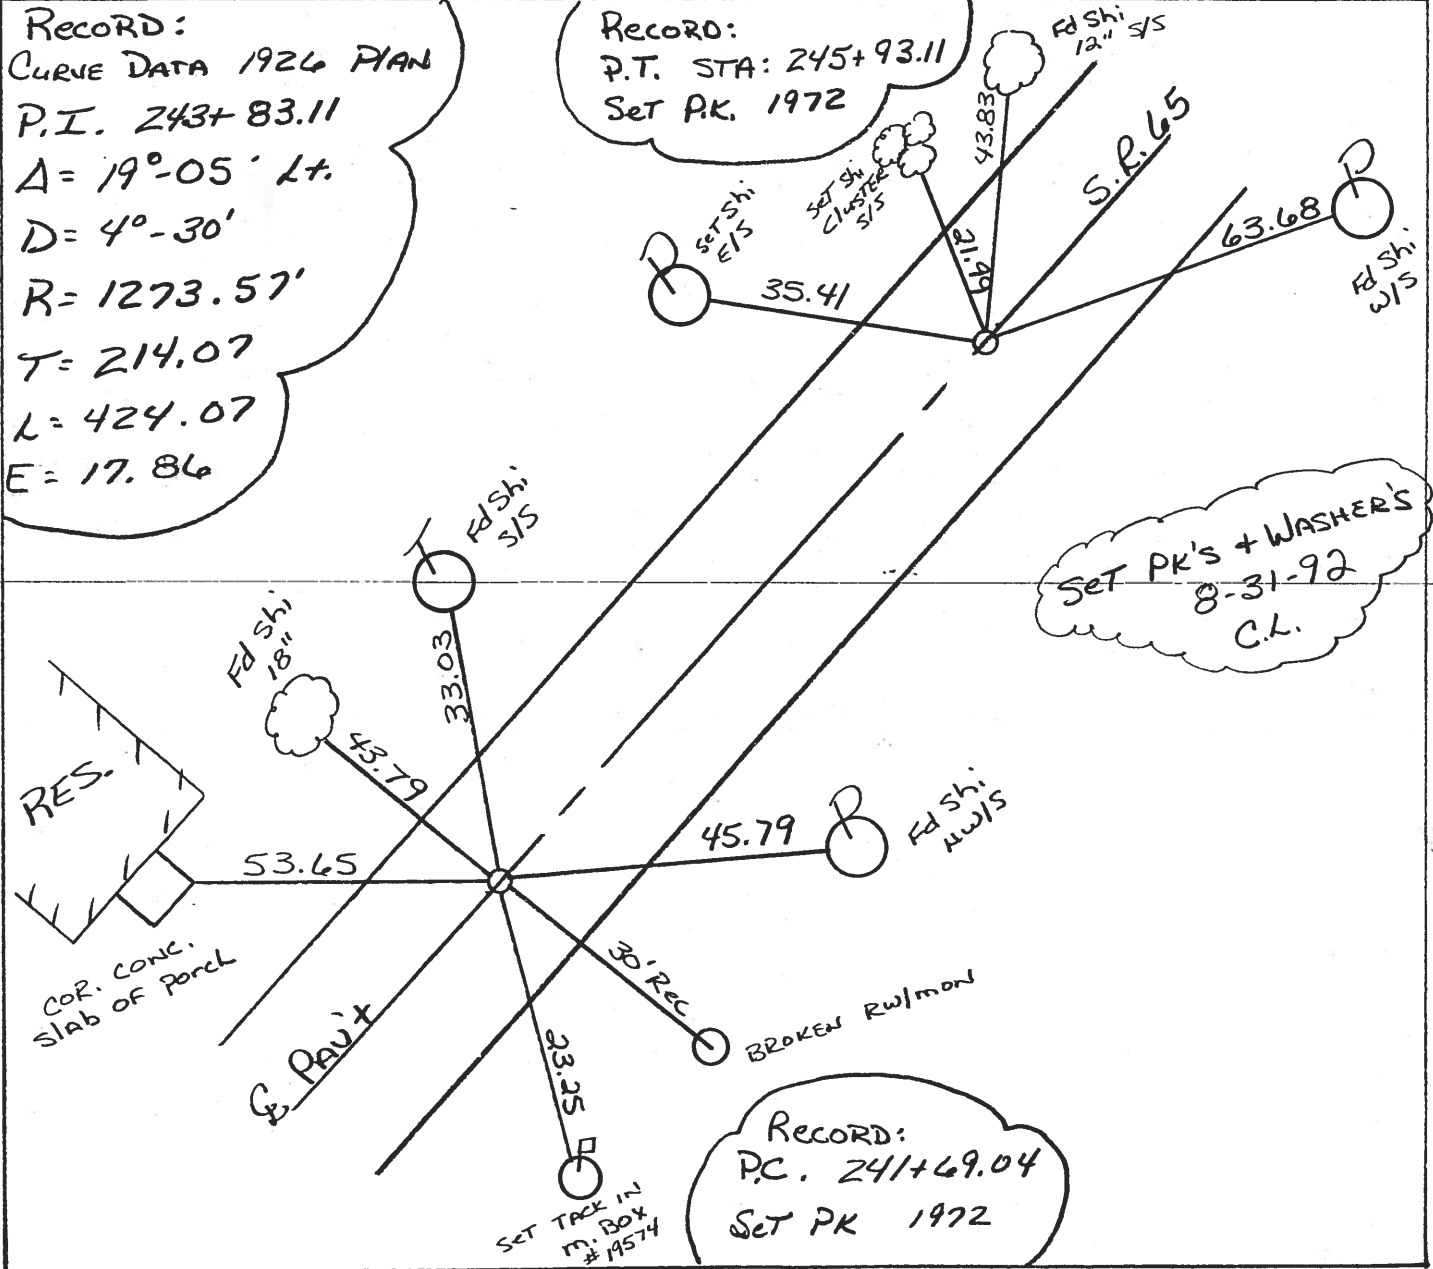

County WOOD S.R. 65

Date 4-9-84

Township WASHINGTON

Weather Clear

Section 25

Temp. 40°

T6N, R9E


Personnel HOFFMAN

LOEHRKE

HOUSEHOLDER H.C.


BARNHISEL R.C.

14-B

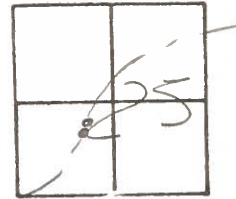


Fd P.K. Nail @ surface SLM = 345 + 09  
ON & PAUT  
8.9' TO RT. EP  
9.4' TO LT. EP

Record:  
P.T. STA 245 + 93.11  
set P.K. 1972

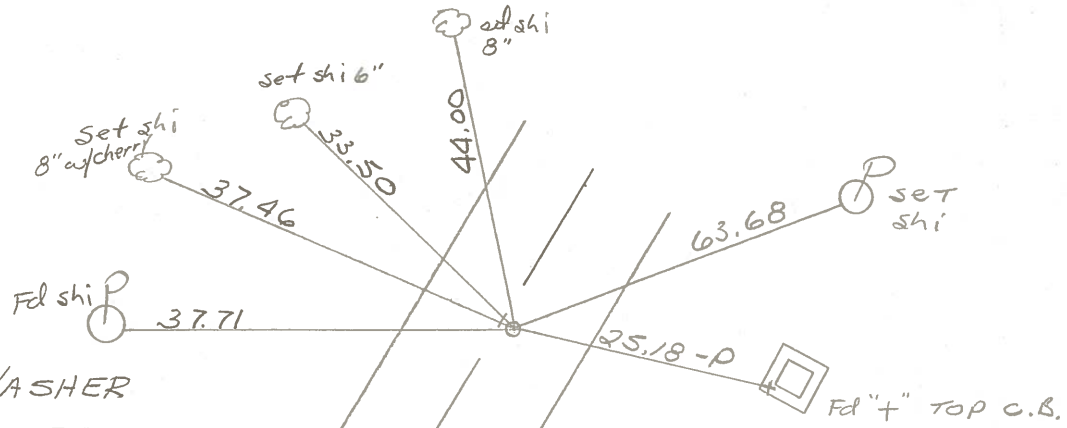

SET PK/WASHER  
@ BOTH POINTS  
10-4-84  
S.W.H.

CURVE DATA 1926 PLAXI!  
P.I. 243 + 83.11  
 $\Delta = 190-05' LT.$   
 $D = 40-30'$   
 $R = 1273.57'$   
 $T = 214.07'$   
 $L = 424.07'$   
 $E = 17.86'$

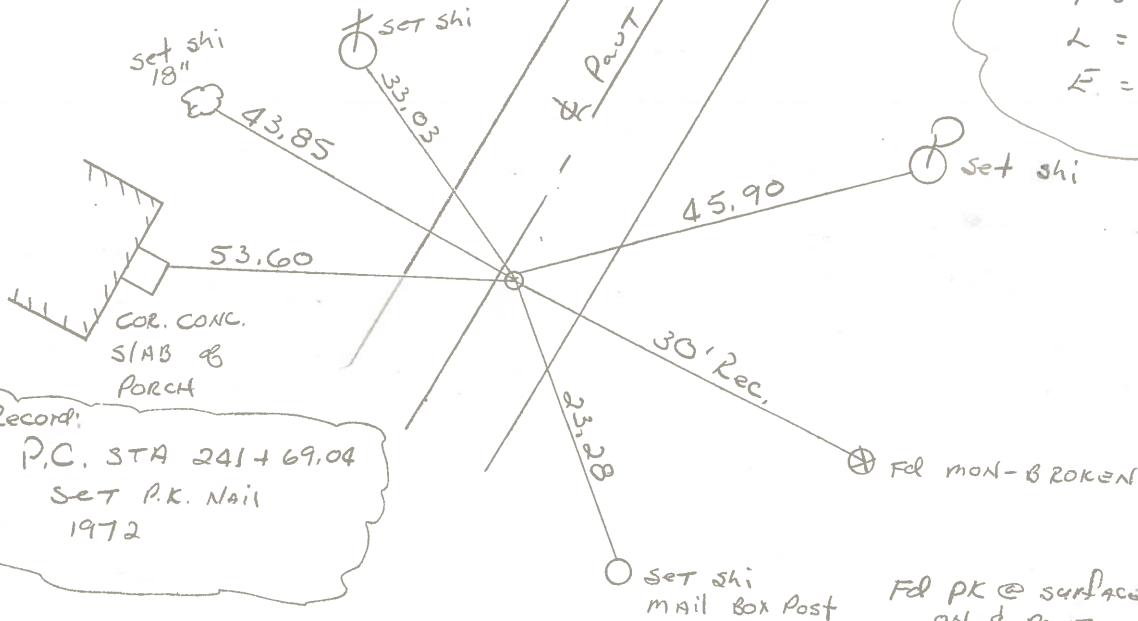

Record:  
P.C. STA 241 + 69.04  
SET P.K. Nail  
1972

Fd PK @ surface SLM = 340 + 85  
ON & PAUT  
8.3' RT EP  
9.4' LT EP