

O.D.O.T. DISTRICT 2 SURVEY OFFICE

PERSONNEL

REFERENCE NO. 14-B-PC

SHEET 5 OF 11

NOTES BARNHISEL

H.C. MOSEY

R.C. CANTERBURY (DRAWN)

DATE 9-25-00

WEATHER CLOUDY

TEMP. +55°

ROUTE S.R. #65

COUNTY WOOD

TOWNSHIP Washington

SECTION 25

T6 N R 9 E


TYPE MONUMENT P.C. = P.K. + WASHER

ON SURFACE - ~~BELOW~~ SURFACE


~~LEFT - & PAV'T. - RIGHT~~ ON &

9.2' TO RT. EDGE PAVEMENT

S.L.M. P.C. = 341 + 51.50

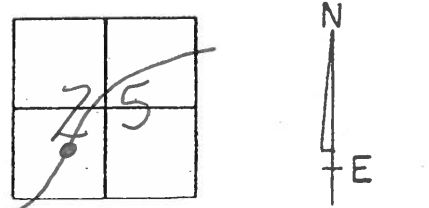

PC

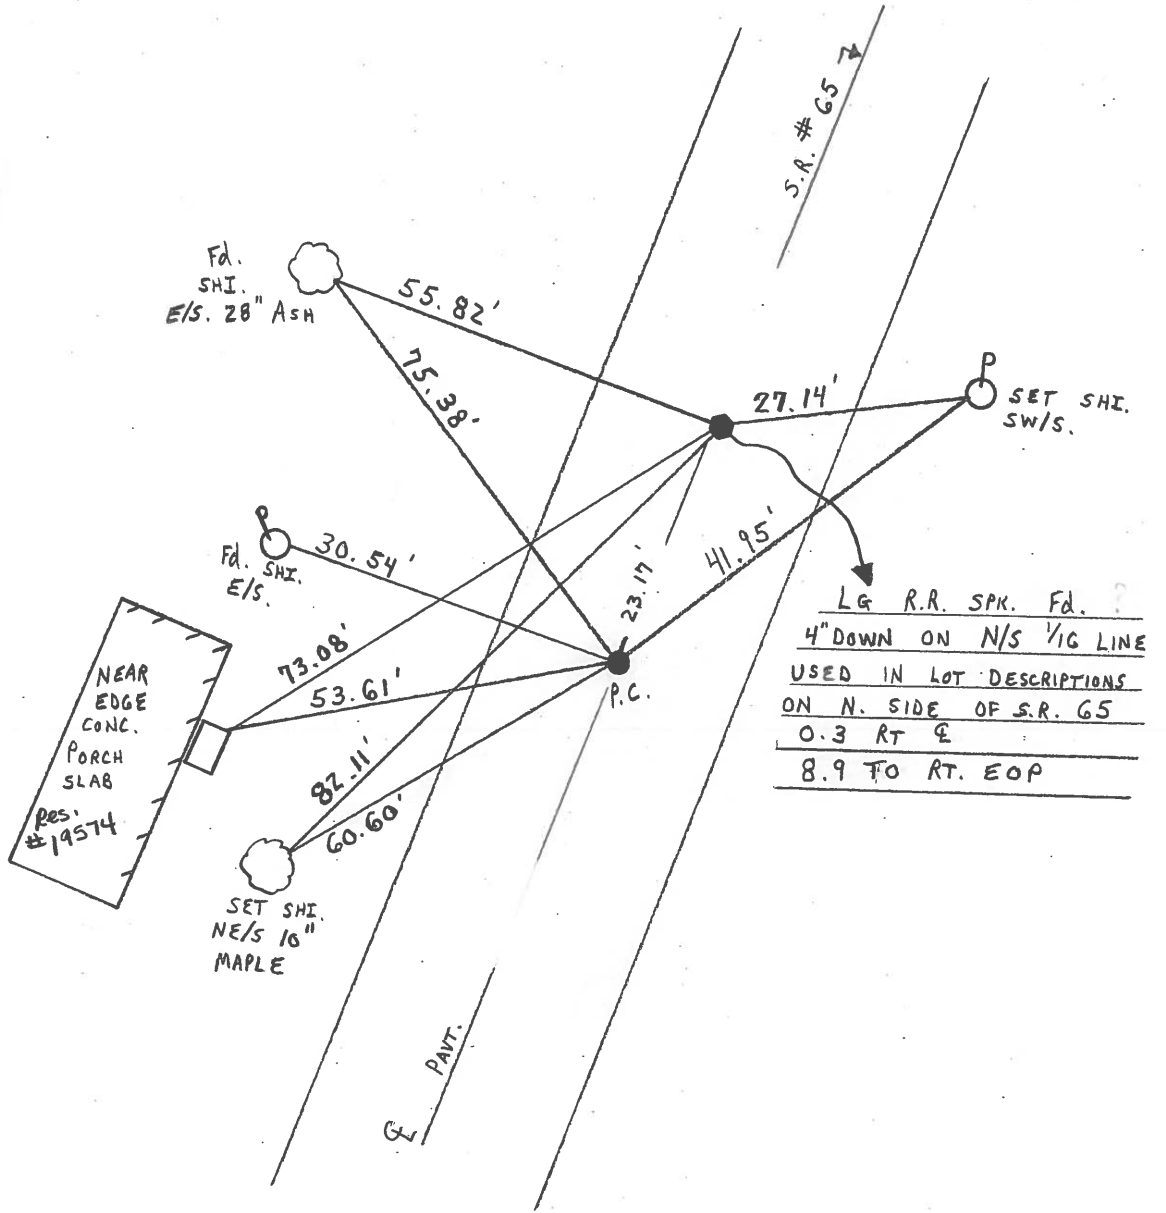

LG R.R. SPK. Fd. ?
 4" DOWN ON N/S 1/4 LINE
 USED IN LOT DESCRIPTIONS
 ON N. SIDE OF S.R. 65
 0.3 RT &
 8.9 TO RT. EOP