

# O.D.O.T. DISTRICT 2 SURVEY OFFICE

PERSONNEL

REFERENCE NO. 14-B-PT SHEET 7 OF 11

NOTES BARNHISEL

H.C. MOSEK

R.C. CANTERBURY

DATE 9-25-00

WEATHER cloudy

TEMP. +55°

ROUTE 65

COUNTY WOOD

TOWNSHIP WASHINGTON

SECTION 25

T6 N R 9 E


TYPE MONUMENT "SET" PK/Washer MON Box

ON SURFACE - BELOW yes


~~LEFT~~ - E PAV'T. - RIGHT 0.5' ON E

8.9' TO RT EDGE PAVEMENT

S.L.M. PT = 345+76.32

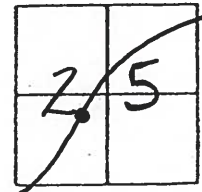

PT.

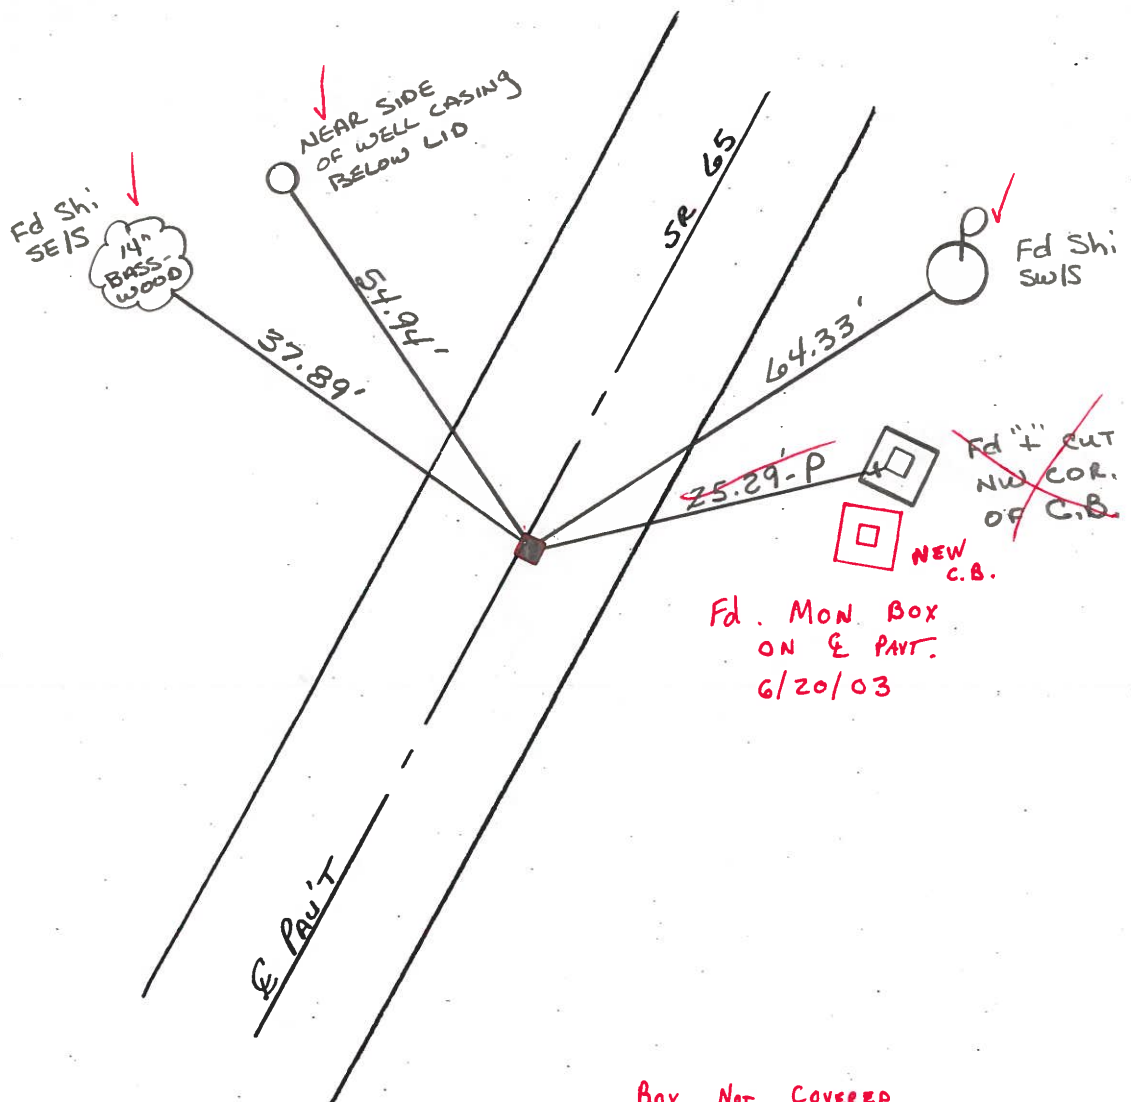

Fd. MON. BOX  
ON E PAV'T.  
6/20/03

Box NOT COVERED  
8/9/04  
M.C.

O.D.O.T. DISTRICT 2 SURVEY OFFICE

PERSONNEL

REFERENCE NO. 14-B-PT SHEET 7 OF 11

NOTES BARNHISE

H.C. MOSEK

R.C. CANTERBURY

DATE 9-25-00

WEATHER cloudy

TEMP. +55°

ROUTE 65

COUNTY WOOD

TOWNSHIP WASHINGTON

SECTION 25

T6 N R 9 E


TYPE MONUMENT "SET" PK/Washer

ON SURFACE - ~~BELOW~~ YES


~~LEFT~~ - & PAV'T. - RIGHT 0.5'

8.9' TO RT EDGE PAVEMENT

S.L.M. PT = 345+76.32

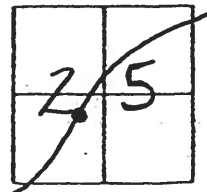

PT.

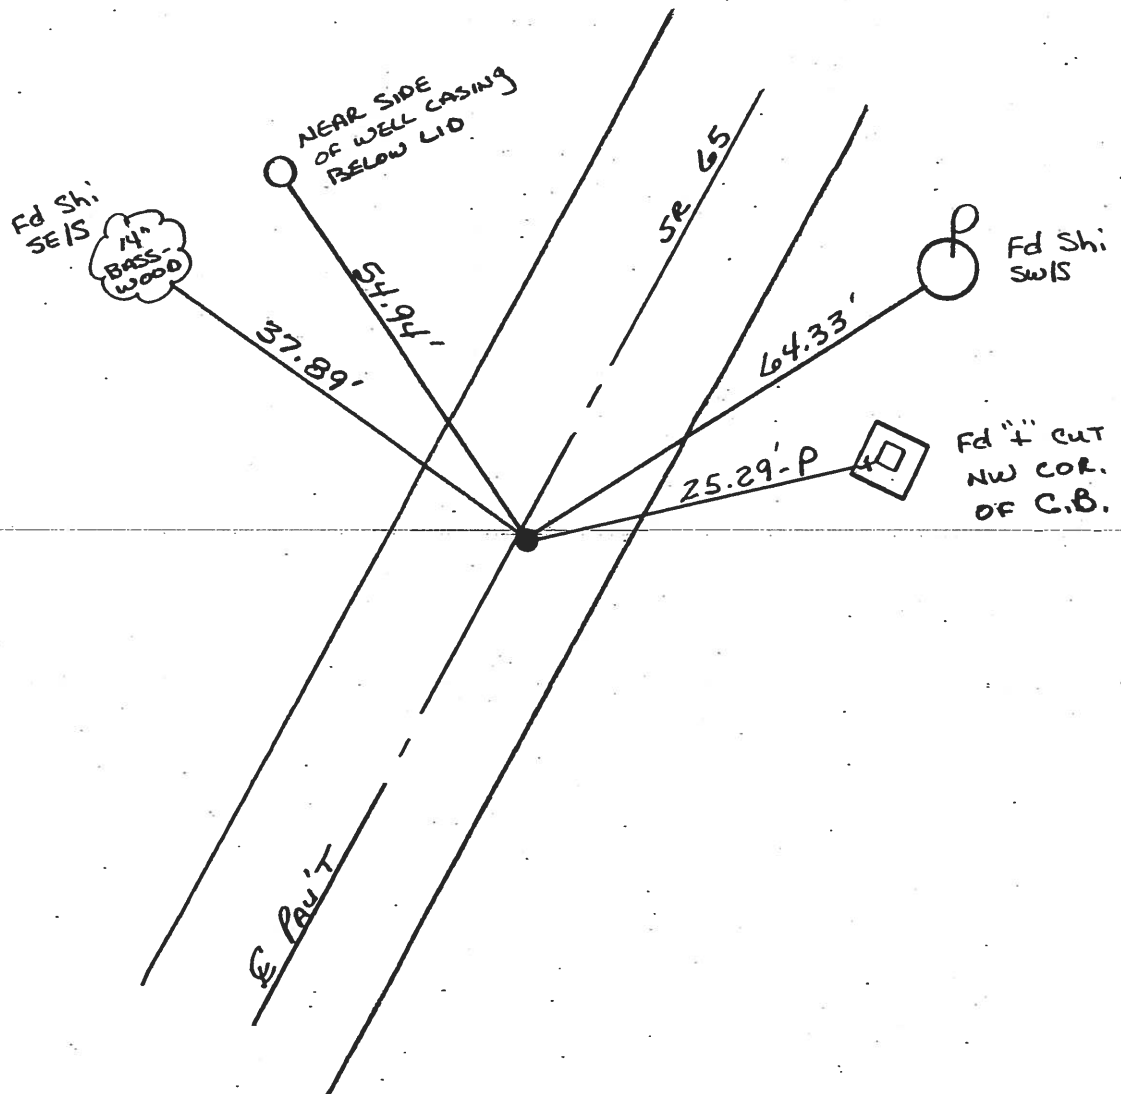

## O.D.O.T. DISTRICT 2 SURVEY OFFICE

**PERSONNEL**


NOTES BARNHISEL  
 H.C. CURTIS  
 R.C. Romero  
Lochrke

REFERENCE NO. P.I.=14-B SHEET 7 OF 36

DATE 7-15-92  
 WEATHER RAIN  
 TEMP. +70°


ROUTE 65  
 COUNTY WOOD  
 TOWNSHIP WASHINGTON  
 SECTION 25  
T 6 N R 9 E

	P.C.	P.T.
TYPE MONUMENT	P.K.+WASHER	P.K.+WASHER
ON SURFACE - <del>BELOW</del>	YES	YES
<del>TO</del> - <u>PAV'T.</u> - <del>RIGHT</del>	YES	YES
- TO <u>LT</u> EDGE PAVEMENT	9.4	9.8
S.L.M.	340+85	345+09

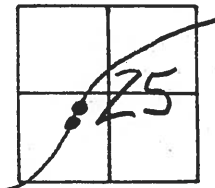

RECORD:  
 CURVE DATA 1926 PLAN  
 P.I. 243+83.11  
 $\Delta = 19^{\circ} - 05' Lt.$   
 $D = 4^{\circ} - 30'$   
 $R = 1273.57'$   
 $T = 214.07$   
 $L = 424.07$   
 $E = 17.86$

RECORD:  
 P.T. STA: 245+93.11  
 SET PK. 1972

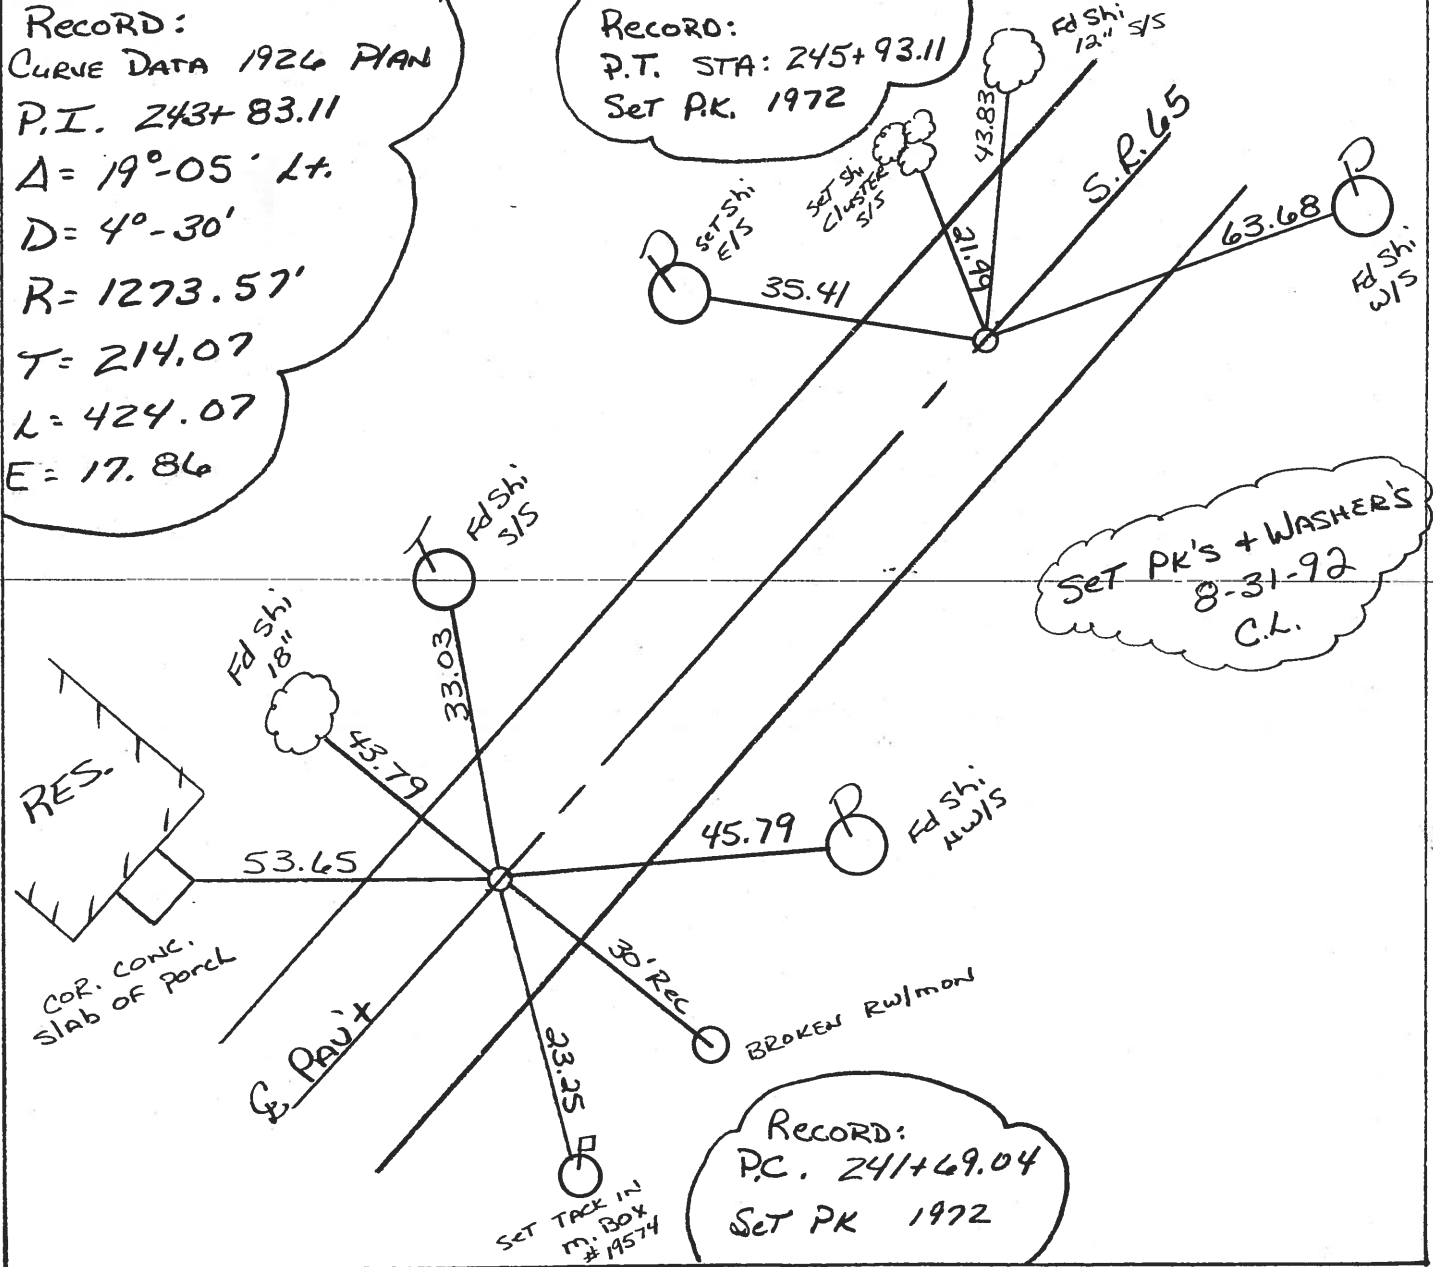

S.M.T.-1

Q.D.O.T. DISTRICT 2 SURVEY OFFICE

SHEET 7 OF 91

County WOOD S.R. 65

Date 4-9-84

Township WASHINGTON

Weather Clear

Section 25

Temp. 40°

T6N, R9E


Personnel HOFFMAN

LOEHRKE

HOUSEHOLDER H.C.


BARNHISEL R.C.

14-B

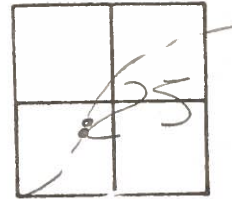


Fd P.K. Nail @ surface SLM = 345 + 09  
ON & PAUT  
8.9' TO RT. EP  
9.4' TO LT. EP

Record:  
P.T. STA 245 + 93.11  
set P.K. 1972

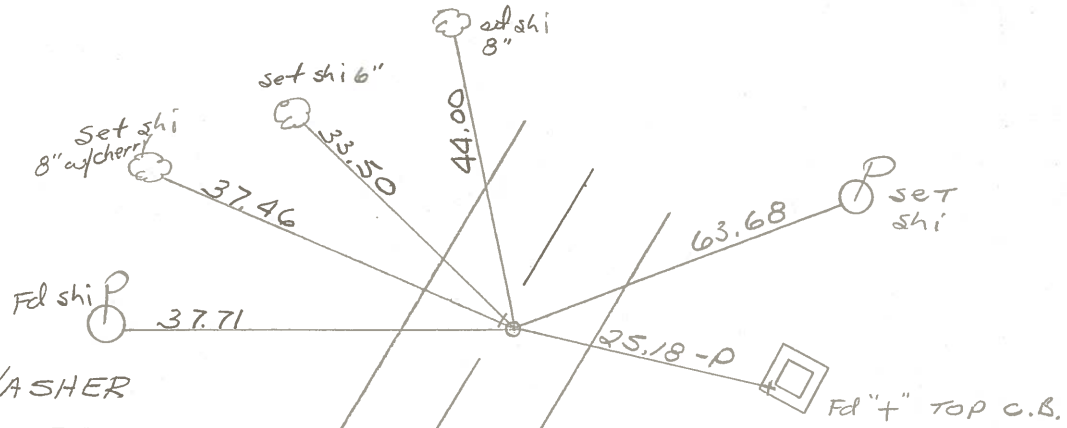

SET PK/WASHER  
@ BOTH POINTS  
10-4-84  
S.W.H.

CURVE DATA 1926 PLAXI!  
P.I. 243 + 83.11  
 $\Delta = 190-05' LT.$   
 $D = 40-30'$   
 $R = 1273.57'$   
 $T = 214.07'$   
 $L = 424.07'$   
 $E = 17.86'$

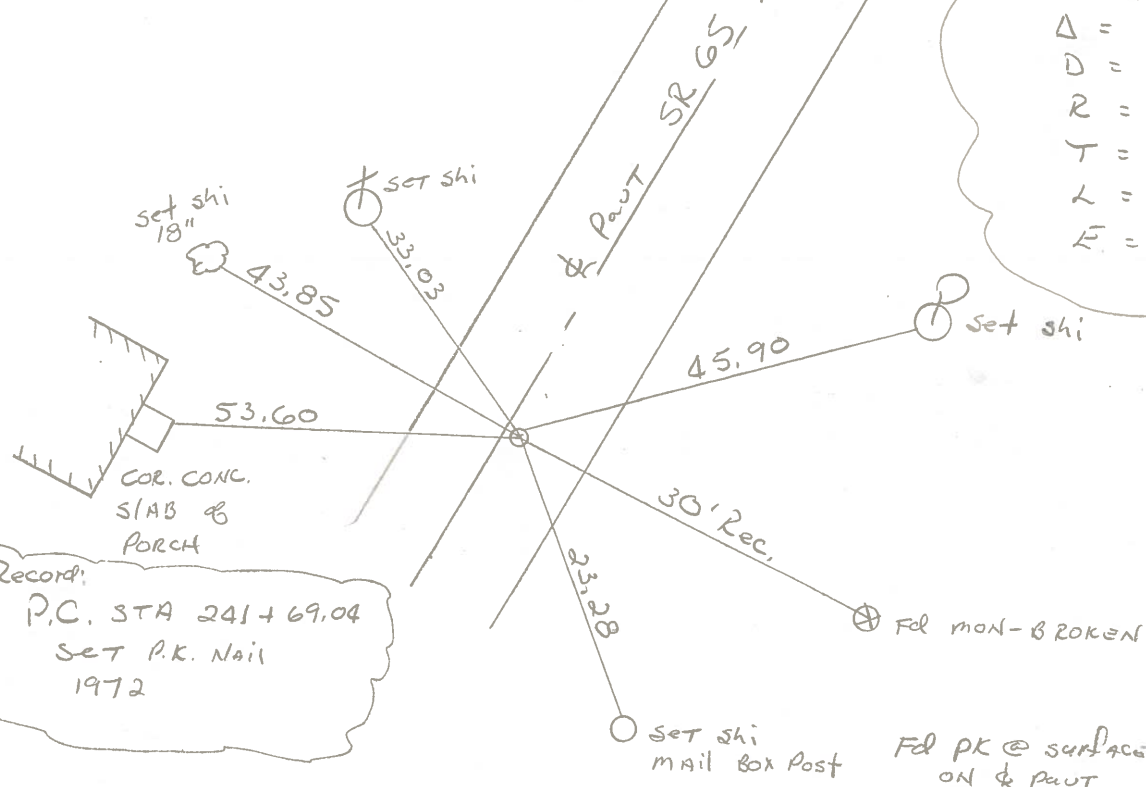

Record:  
P.C. STA 241 + 69.04  
SET P.K. Nail  
1972

Fd PK @ surface SLM = 340 + 85  
ON & PAUT  
8.3' RT EP  
9.4' LT EP