

O.D.O.T. DISTRICT 2 SURVEY OFFICE (USE ONLY)

PERSONNEL

REFERENCE NO. 14 DB

SHEET 14 OF 63

NOTES RHOADES

DATE 4/20/15

ROUTE SR 65

H.C. WESTFALL

WEATHER WINDY

COUNTY WOOD

R.C. O'CONNELL

TEMP. 55°

TOWNSHIP WASHINGTON

SECTION 25

T 6 N R 9 E

TYPE MONUMENT LG.R.R.SPIKE


ON SURFACE - ~~BELOW~~ ON

LEFT - PAV'T - ~~RIGHT~~ 3.6'

6.0' TOLT EDGE PAVEMENT

S.L.M. 351+25.97

Grid: Northing: 652637.185 Easting: 1618459.437

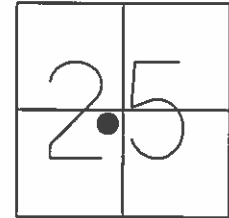

FD SHI
18" MAPLE



42.32'

21.83'

20.12'

SET BARN SPK.
2.5' FR/EP

MB

SET TACK
4X4" MB POST
1.7' UP

RECORD: P.I.
STA. 350+83.97
CURVE DATA 1992
 $\Delta = 6^\circ 14' 01''$ RT
D = $2^\circ 55' 03''$
R = 1963.91'
T = 106.94'
L = 213.67'
E = 2.91'

FD LG.R.R.SPIKE
9/25/00, MB
FD LG.R.R.SPIKE
TS, REFDB14
8/6/13, SDC
SET MAG/WASHER
GPS, NEWREFDB14
7/20/15, JFO

SR 65

O.D.O.T. DISTRICT 2 SURVEY OFFICE

PERSONNEL _____

REFERENCE NO. P.I. = 14-C SHEET 9 OF 11

NOTES BARNHISEL

6-20-03

H.C. MOSEK

DATE 9-25-00

ROUTE 65

R.C. CANTERBURY

WEATHER cloudy

COUNTY WOOD

TEMP. +55°

TOWNSHIP WASHINGTON

SECTION 25

T6 N R 9 E


TYPE MONUMENT ~~SET~~ ^{Fd.} Lg. RR Spk w/ent punch

ON SURFACE - ~~BELOW~~ yes

LEFT- & PAV'T. - ~~RIGHT~~ 3.6'

6.0' TO LT EDGE PAVEMENT

S.L.M. PI = 350+83.97

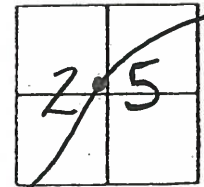

NEW: CURVE DATA

$\Delta = 6^{\circ} 14' 01''$


$D = 2^{\circ} 55' 03''$

$R = 1963.91'$

$T = 106.94'$

$L = 213.67'$

$E = 2.91'$

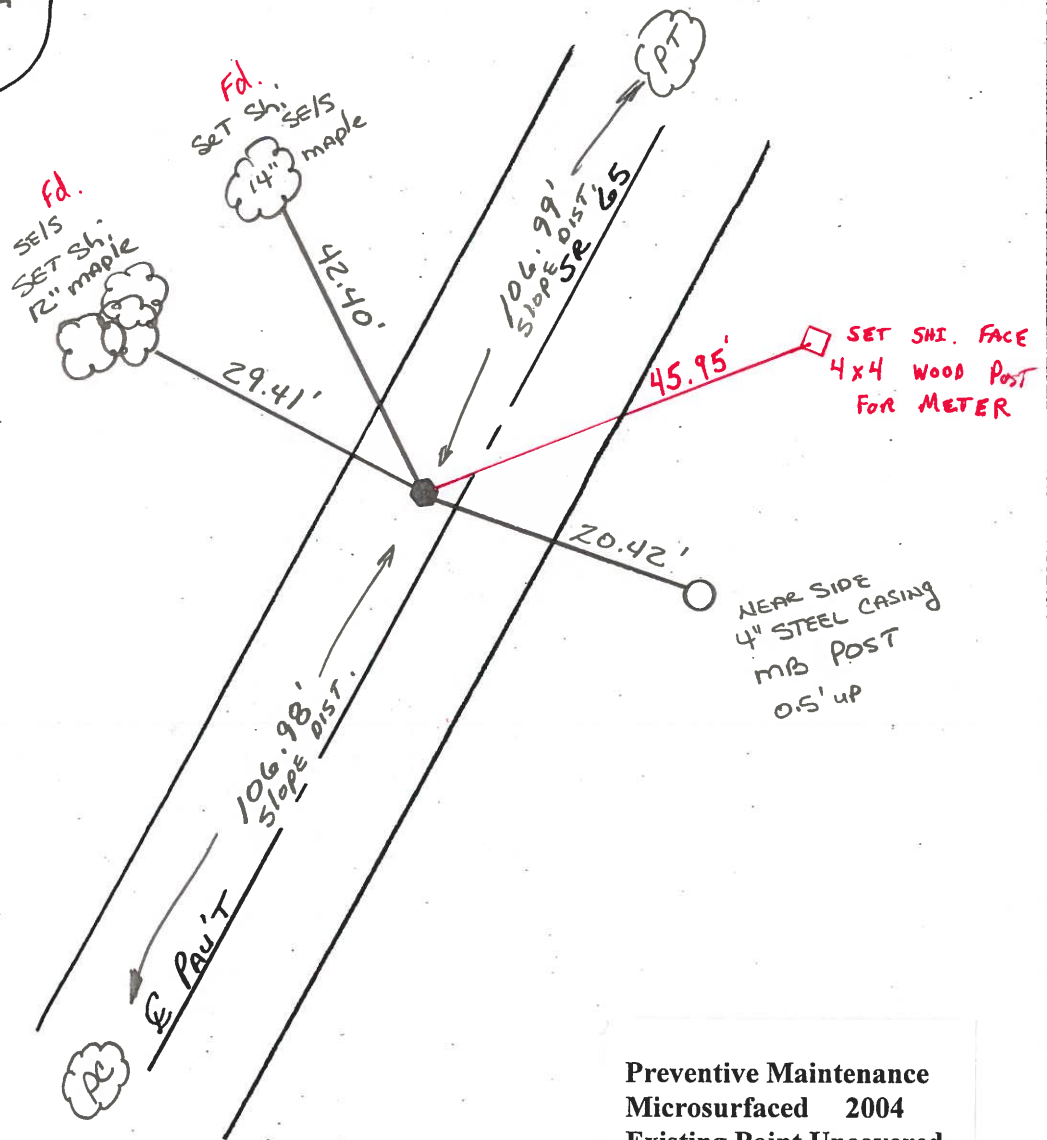

Preventive Maintenance
 Microsurfaced 2004
 Existing Point Uncovered
 Date 8/9/04 MC

O.D.O.T. DISTRICT 2 SURVEY OFFICE

PERSONNEL


REFERENCE NO. PI=14-C SHEET 9 OF 11

NOTES Barnhiser
 H.C. Moser
 R.C. CANTERBURY

DATE 9-25-00
 WEATHER cloudy
 TEMP. +55°



ROUTE 65
 COUNTY WOOD
 TOWNSHIP WASHINGTON
 SECTION 25
 T6 N R 9 E

TYPE MONUMENT "SET" Lg RR Spk w/ent punch
 ON SURFACE - BELOW yes
 LEFT - E PAV'T. - RIGHT 3.6'
6.0' TO LT EDGE PAVEMENT
 S.L.M. PI = 350+83.97

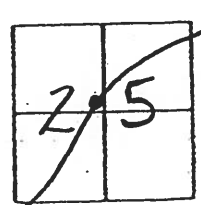

NEW: CURVE DATA

$\Delta = 6^{\circ} 14' 01''$
 $D = 2^{\circ} 55' 03''$
 $R = 1963.91'$
 $T = 106.94'$
 $L = 213.67'$
 $E = 2.91'$

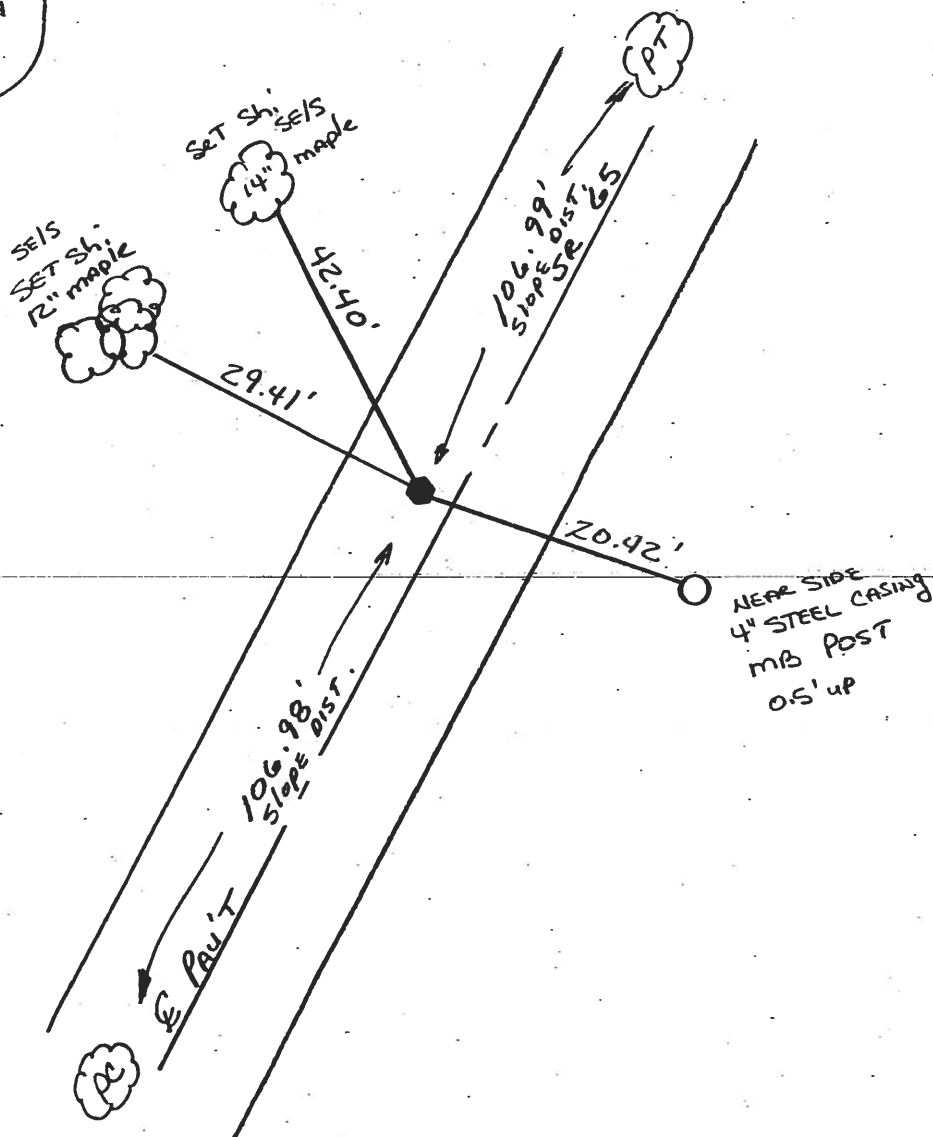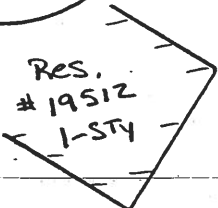

O.D.O.T. DISTRICT 2 SURVEY OFFICE

PERSONNEL

REFERENCE NO. PI=14-C SHEET 8 OF 34

NOTES BARNHISEL

H.C. CURTIS

R.C. RomeTO

LochrKE

DATE 7-15-92

WEATHER RAIN

TEMP. +70°

ROUTE 65


COUNTY WOOD

TOWNSHIP WASHINGTON

SECTION 25


T 6 N R 9 E

	P.C.	P.T.
TYPE MONUMENT	<u>PK+WASHER</u>	<u>PK+WASHER</u>
ON SURFACE - PK+WASHER	<u>YES</u>	<u>YES</u>
LEFT- Q PAV'T. - PK+WASHER	<u>Q</u>	<u>0.4 LT</u>
- TO RT EDGE PAVEMENT	<u>10.0</u>	<u>10.1</u>
S.L.M.	<u>349+10</u>	<u>351+25</u>

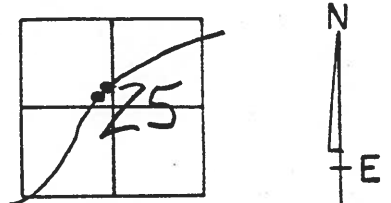

RECORD:
 CURVE DATA 1926 PLAN
 PI STA: 251+00
 A = 6°-24' RT
 D = 3°-00'
 R = 1910.08
 T = 106.77
 L = 213.33
 E = 3.079

RECORD:
 PT STA 252+60.56
 SET PK 1972

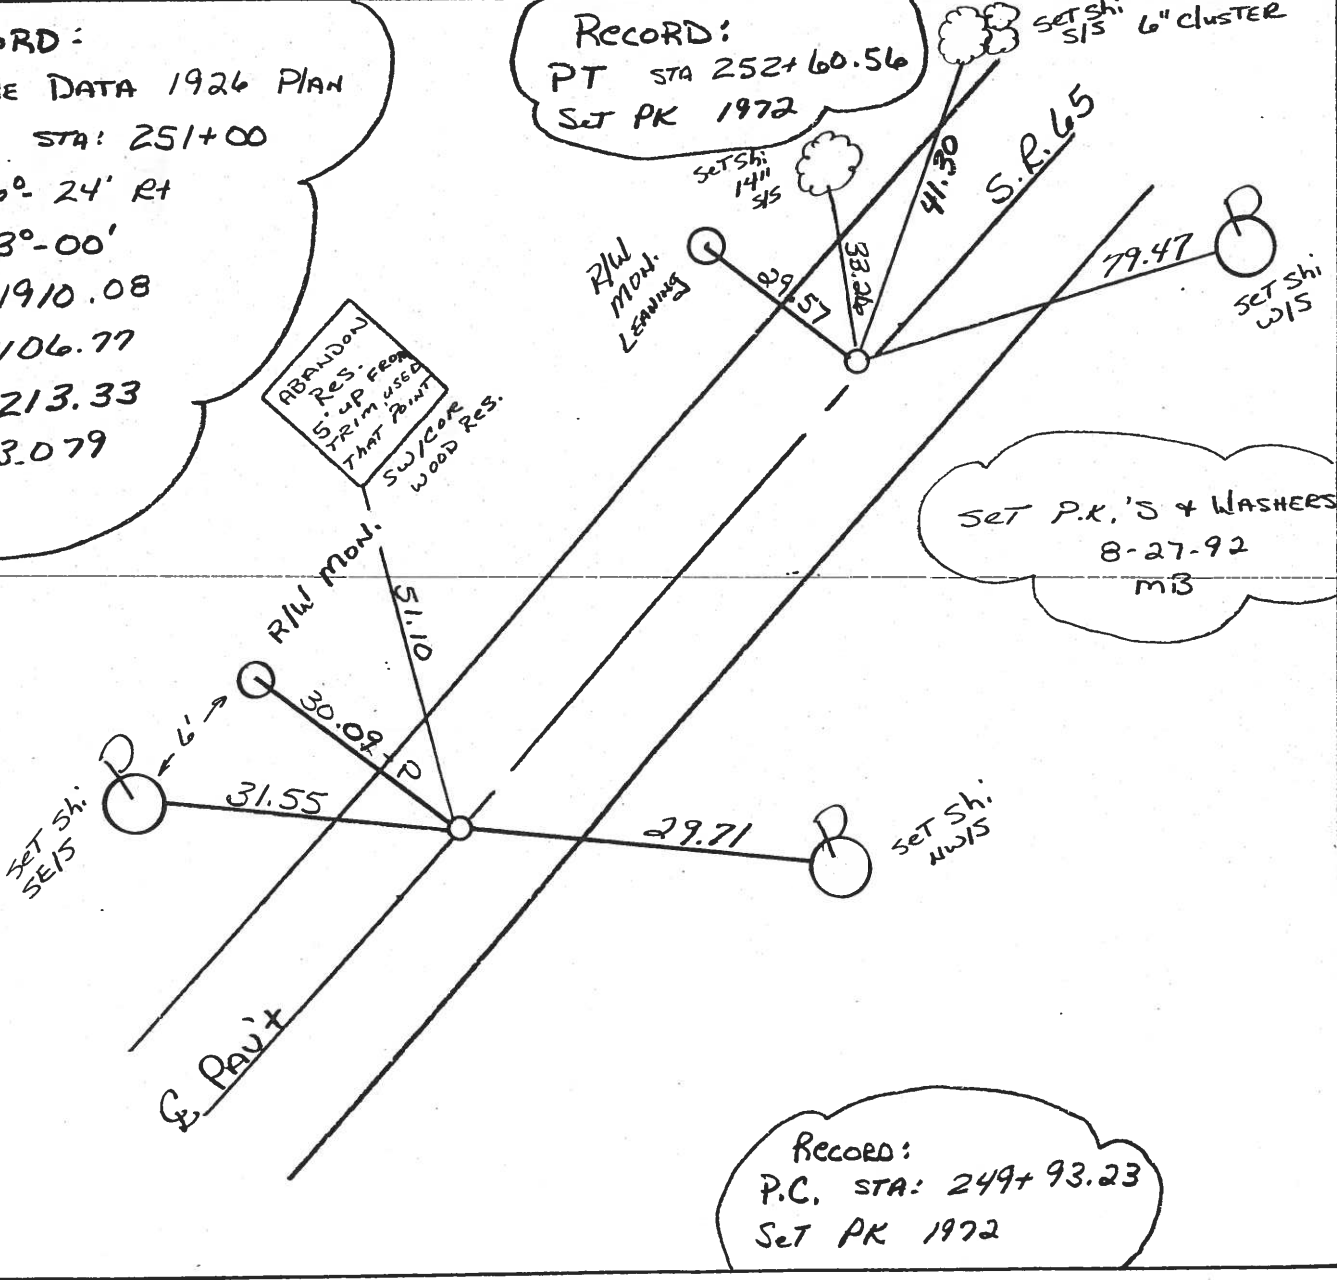

SET P.K.'S + WASHERS
 8-27-92
 MB

RECORD:
 P.C. STA: 249+93.23
 SET PK 1972

ABANDON
 RES. FROM
 STRIP USED
 THAT POINT
 SW/COR
 WOOD RES.

County Wood S.R. 65

Date 4-9-84

Township WASHINGTON

Weather Clear

Section 25

Temp. 45°

T6N, R9E

Personnel HOFFMAN

LOEHKE

Householder H.C.

BARWISSEL R.C.





14-C


SET P.K./WASHEI
@ BOTH POINTS
10-4-84
S.W.H.

Record:
P.T. STA. 252+60.56
Set P.K. 1972

Fd. P.K. @ surface
on & part
9.0' TO LT. EP.
10.1' TO RT. EP.
SLM = 351+26

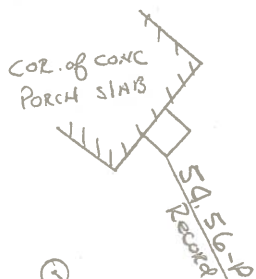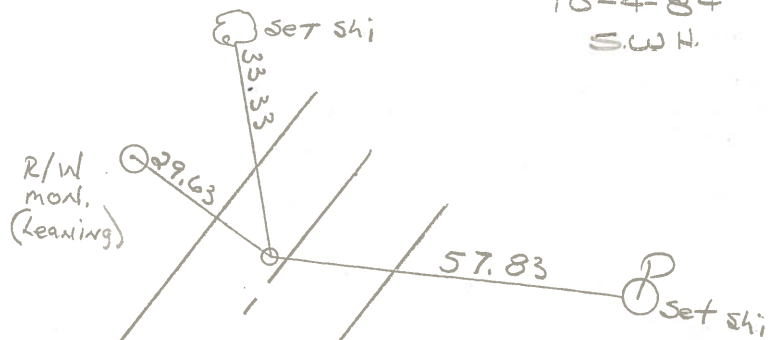

Curve DATA 1926 PLAD
P.I. STA = 251+00
 $\Delta = 6^{\circ}-24' RT.$
 $D = 3^{\circ}-00'$
 $R = 1910.08$
 $T = 106.77$
 $L = 213.33$
 $E = 3.079$

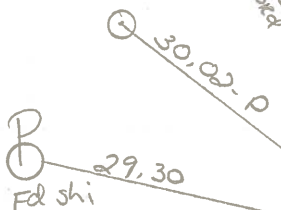

Record:
P.C. STA 249+93.23
Set P.K. 1972

Fd. P.K. @ surface on & part
9.0' TO RT EP
9.4' TO LT EP
SLM 349+12

