

O.D.O.T. DISTRICT 2 SURVEY OFFICE

PERSONNEL _____

REFERENCE NO. 14-C-PT SHEET 10 OF 11

NOTES BARNHISEL

6-20-03

H.C. MOSEK

DATE 9-25-00

ROUTE 65

R.C. CANTERBURY

WEATHER cloudy

COUNTY WOOD

TEMP. +55°

TOWNSHIP WASHINGTON

SECTION 25

T6 N R 9 E


TYPE MONUMENT ~~"SET"~~ PK/Washer ✓

ON SURFACE - ~~BELOW~~ yes


LEFT - 0.3' PAV'T. - ~~RIGHT~~ 0.4'

9.3' TO LT EDGE PAVEMENT

S.L.M. PT = 351 + 90.70

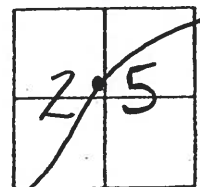

PT.

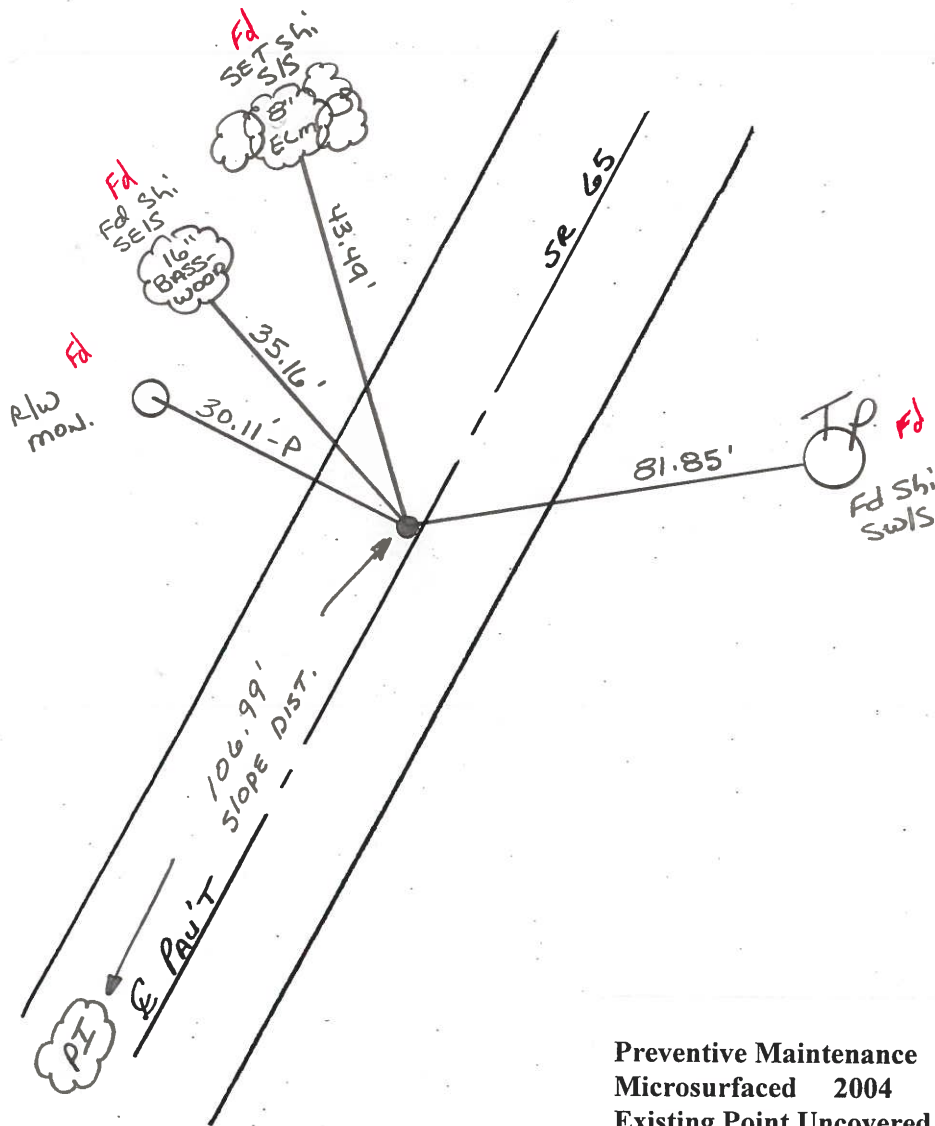

Preventive Maintenance
 Microsurfaced 2004
 Existing Point Uncovered
 Date 8/9/04 MC

O.D.O.T. DISTRICT 2 SURVEY OFFICE

PERSONNEL _____


REFERENCE NO. 14-C-PT SHEET 10 OF 11

NOTES BarnHise
 H.C. Mosee
 R.C. CANTERBURY

DATE 9-25-00
 WEATHER cloudy
 TEMP. +55°

ROUTE 65
 COUNTY WOOD
 TOWNSHIP WASHINGTON
 SECTION 25
 T6 N R 9 E

TYPE MONUMENT "SET" PK/Washer
 ON SURFACE - ~~BELOW~~ yes
 LEFT - & PAV'T. - ~~RIGHT~~ 0.4'
9.3' TO LT EDGE PAVEMENT
 S.L.M. PT = 351 + 90.70

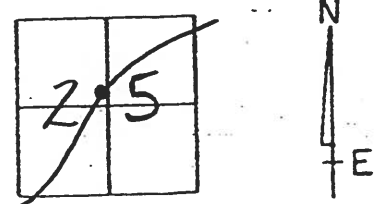

PT.

